


| FED. ROAD DIST. NO. | STATE | FED. AID PROJ. NO. | FISCAL YEAR | SHEET NO. | TOTAL SHEETS |
|---------------------|-------|--------------------|-------------|-----------|--------------|
| HAWAII              | HAW.  | NH-032-1(010)      | 2014        | ADD.18    | 51           |

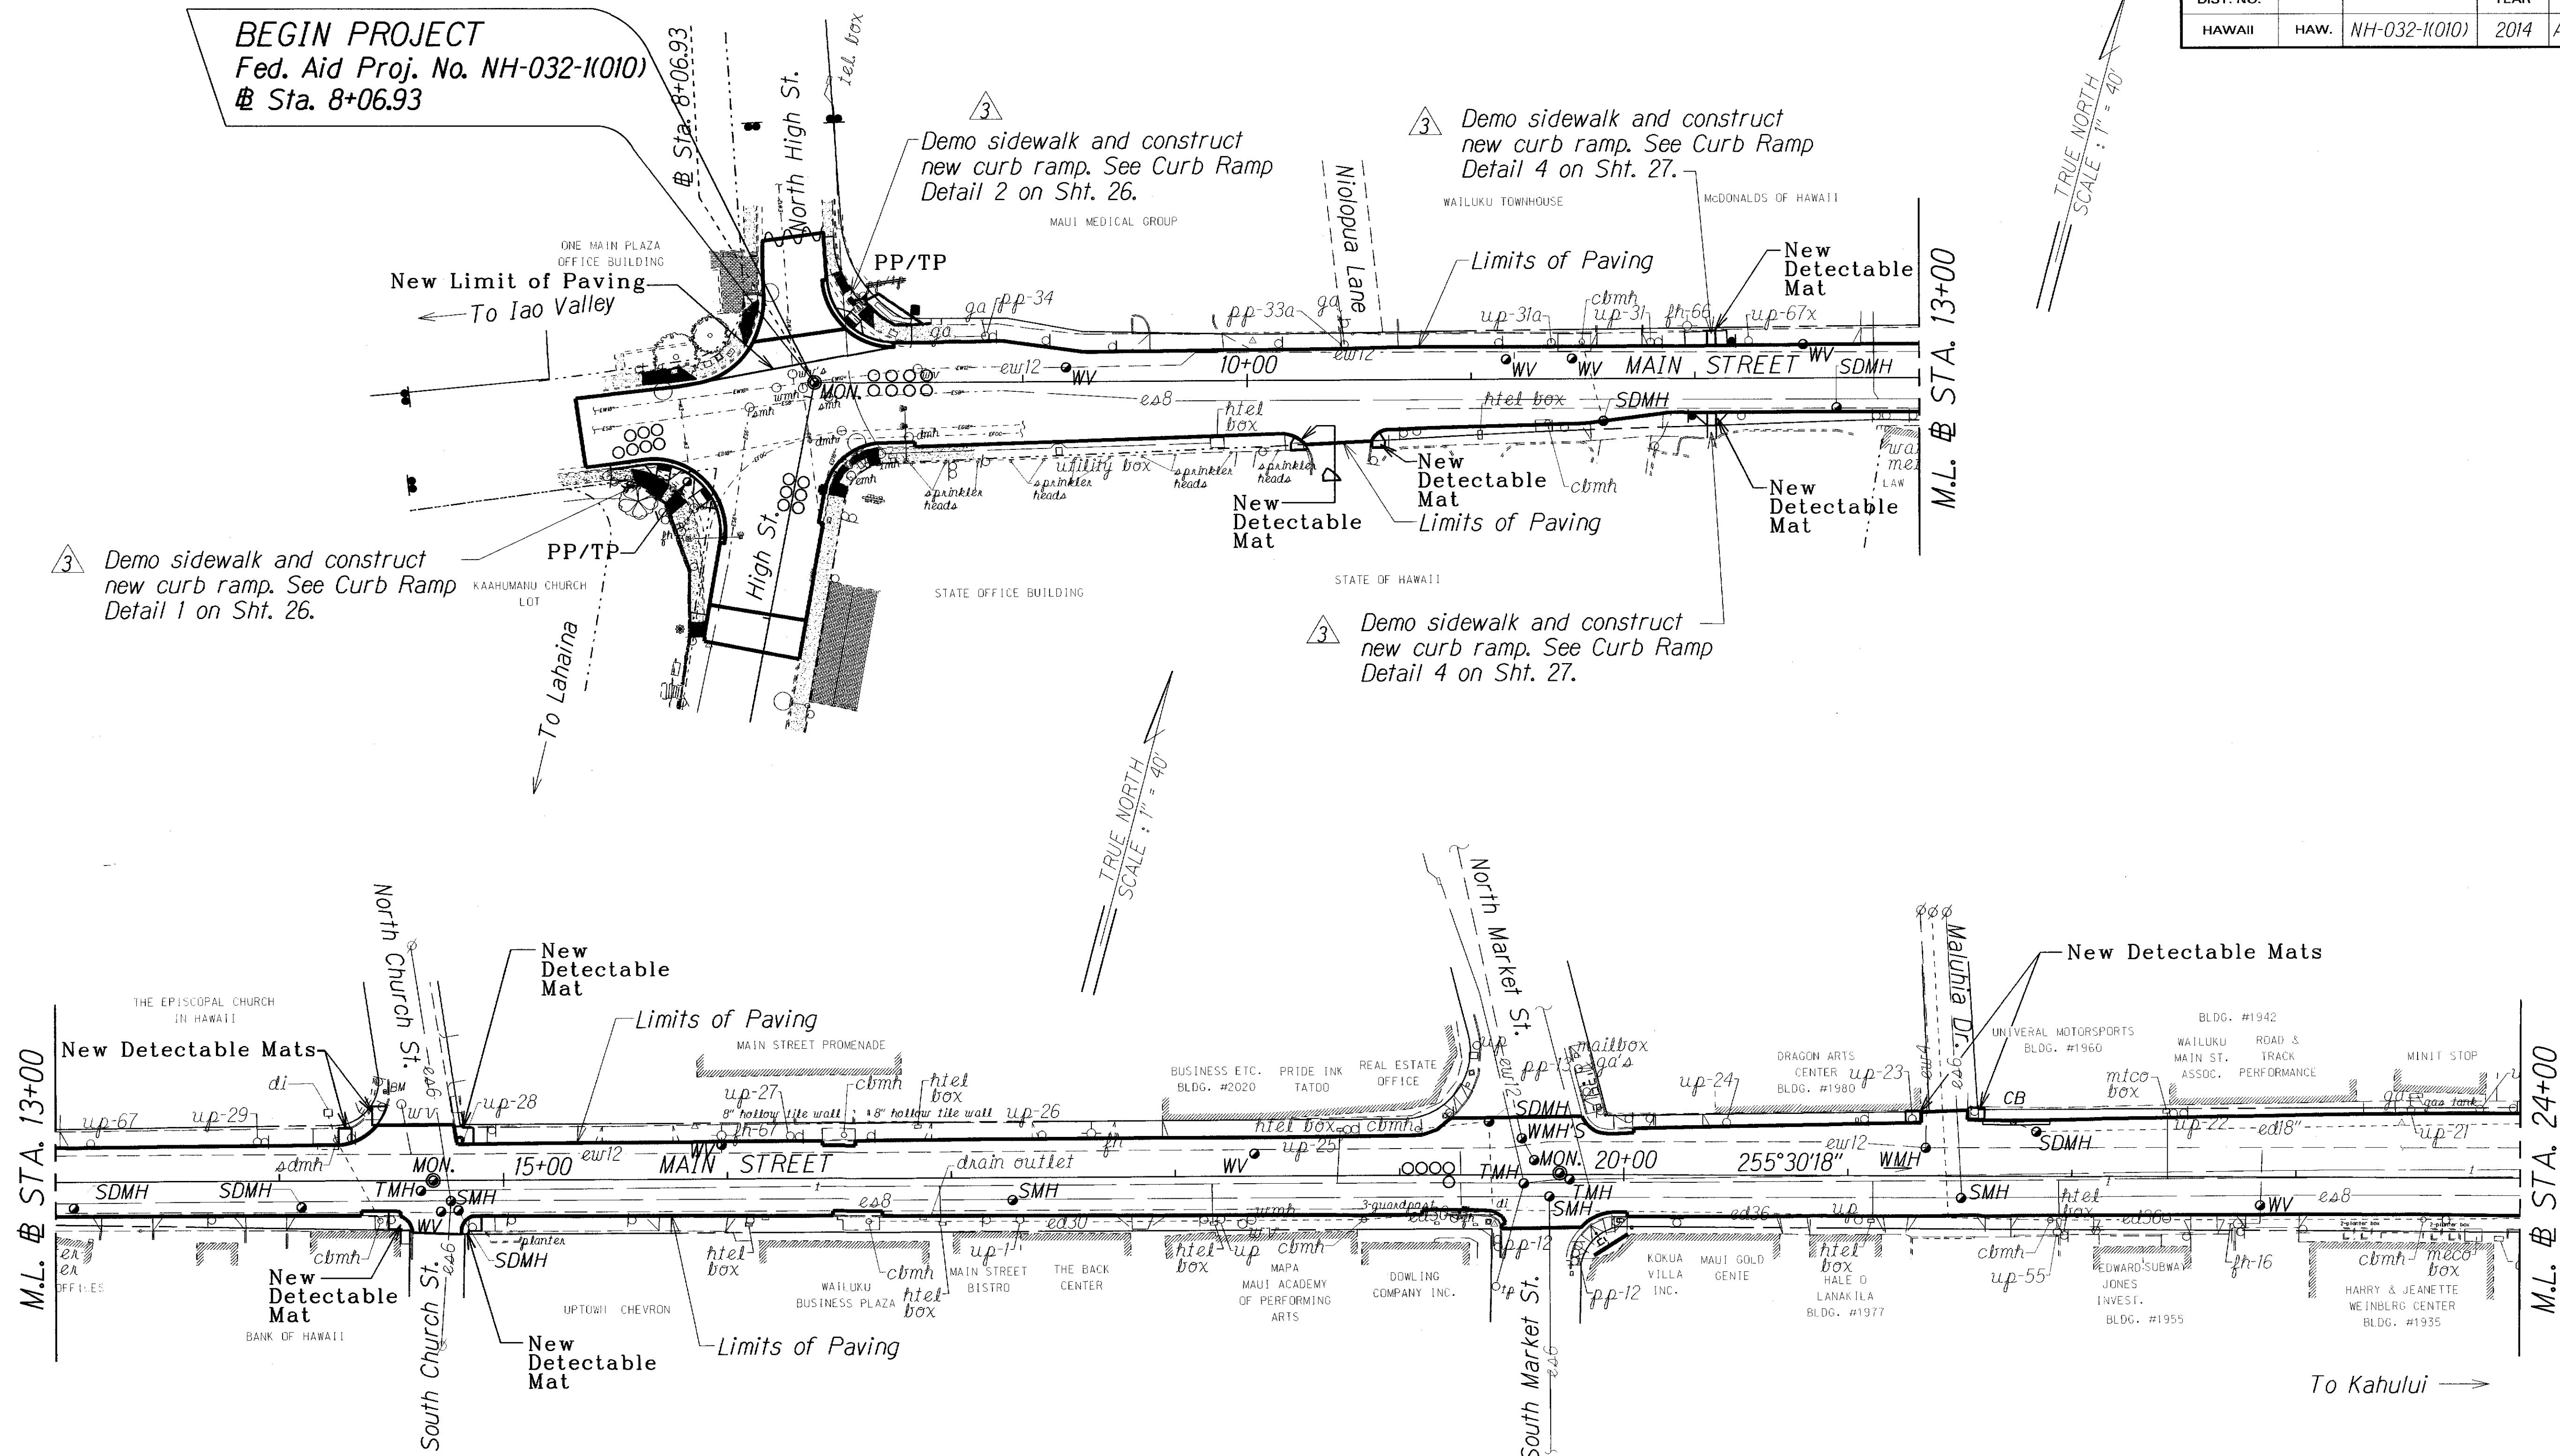

|               |                   |      |
|---------------|-------------------|------|
| ORIGINAL PLAN | SURVEY PLOTTED BY | DATE |
| NOTE BOOK     | DRAWN BY          |      |
| DESIGNED BY   | QUANTITIES BY     |      |
| CHECKED BY    |                   |      |

| LEGEND FOR AS-BUILT POSTINGS |                                     |
|------------------------------|-------------------------------------|
|                              | Squiggly line for as-built deletion |
|                              | Double line for as-built deletion   |
| Roadway                      | Text for as-built posting           |

12/8/14 Added curb ramp reference sheet no.

DATE REVISION

STATE OF HAWAII  
DEPARTMENT OF TRANSPORTATION  
HIGHWAYS DIVISION  
**ROADWAY PLAN**  
MAIN STREET RESURFACING  
High Street to Kaahumanu Avenue and  
KAAHUMANU AVENUE RESURFACING  
Main Street to Hobron Avenue  
Federal-Aid Project No. NH-032-1(010)  
Scale: 1" = 40' Date: July, 2014


SHEET No. 1 OF 8 SHEETS

"AS-BUILT"

ADD. 18



| FED. ROAD DIST. NO. | STATE | FED. AID PROJ. NO. | FISCAL YEAR | SHEET NO. | TOTAL SHEETS |
|---------------------|-------|--------------------|-------------|-----------|--------------|
| HAWAII              | HAW.  | NH-032-1(010)      | 2014        | 19        | 51           |

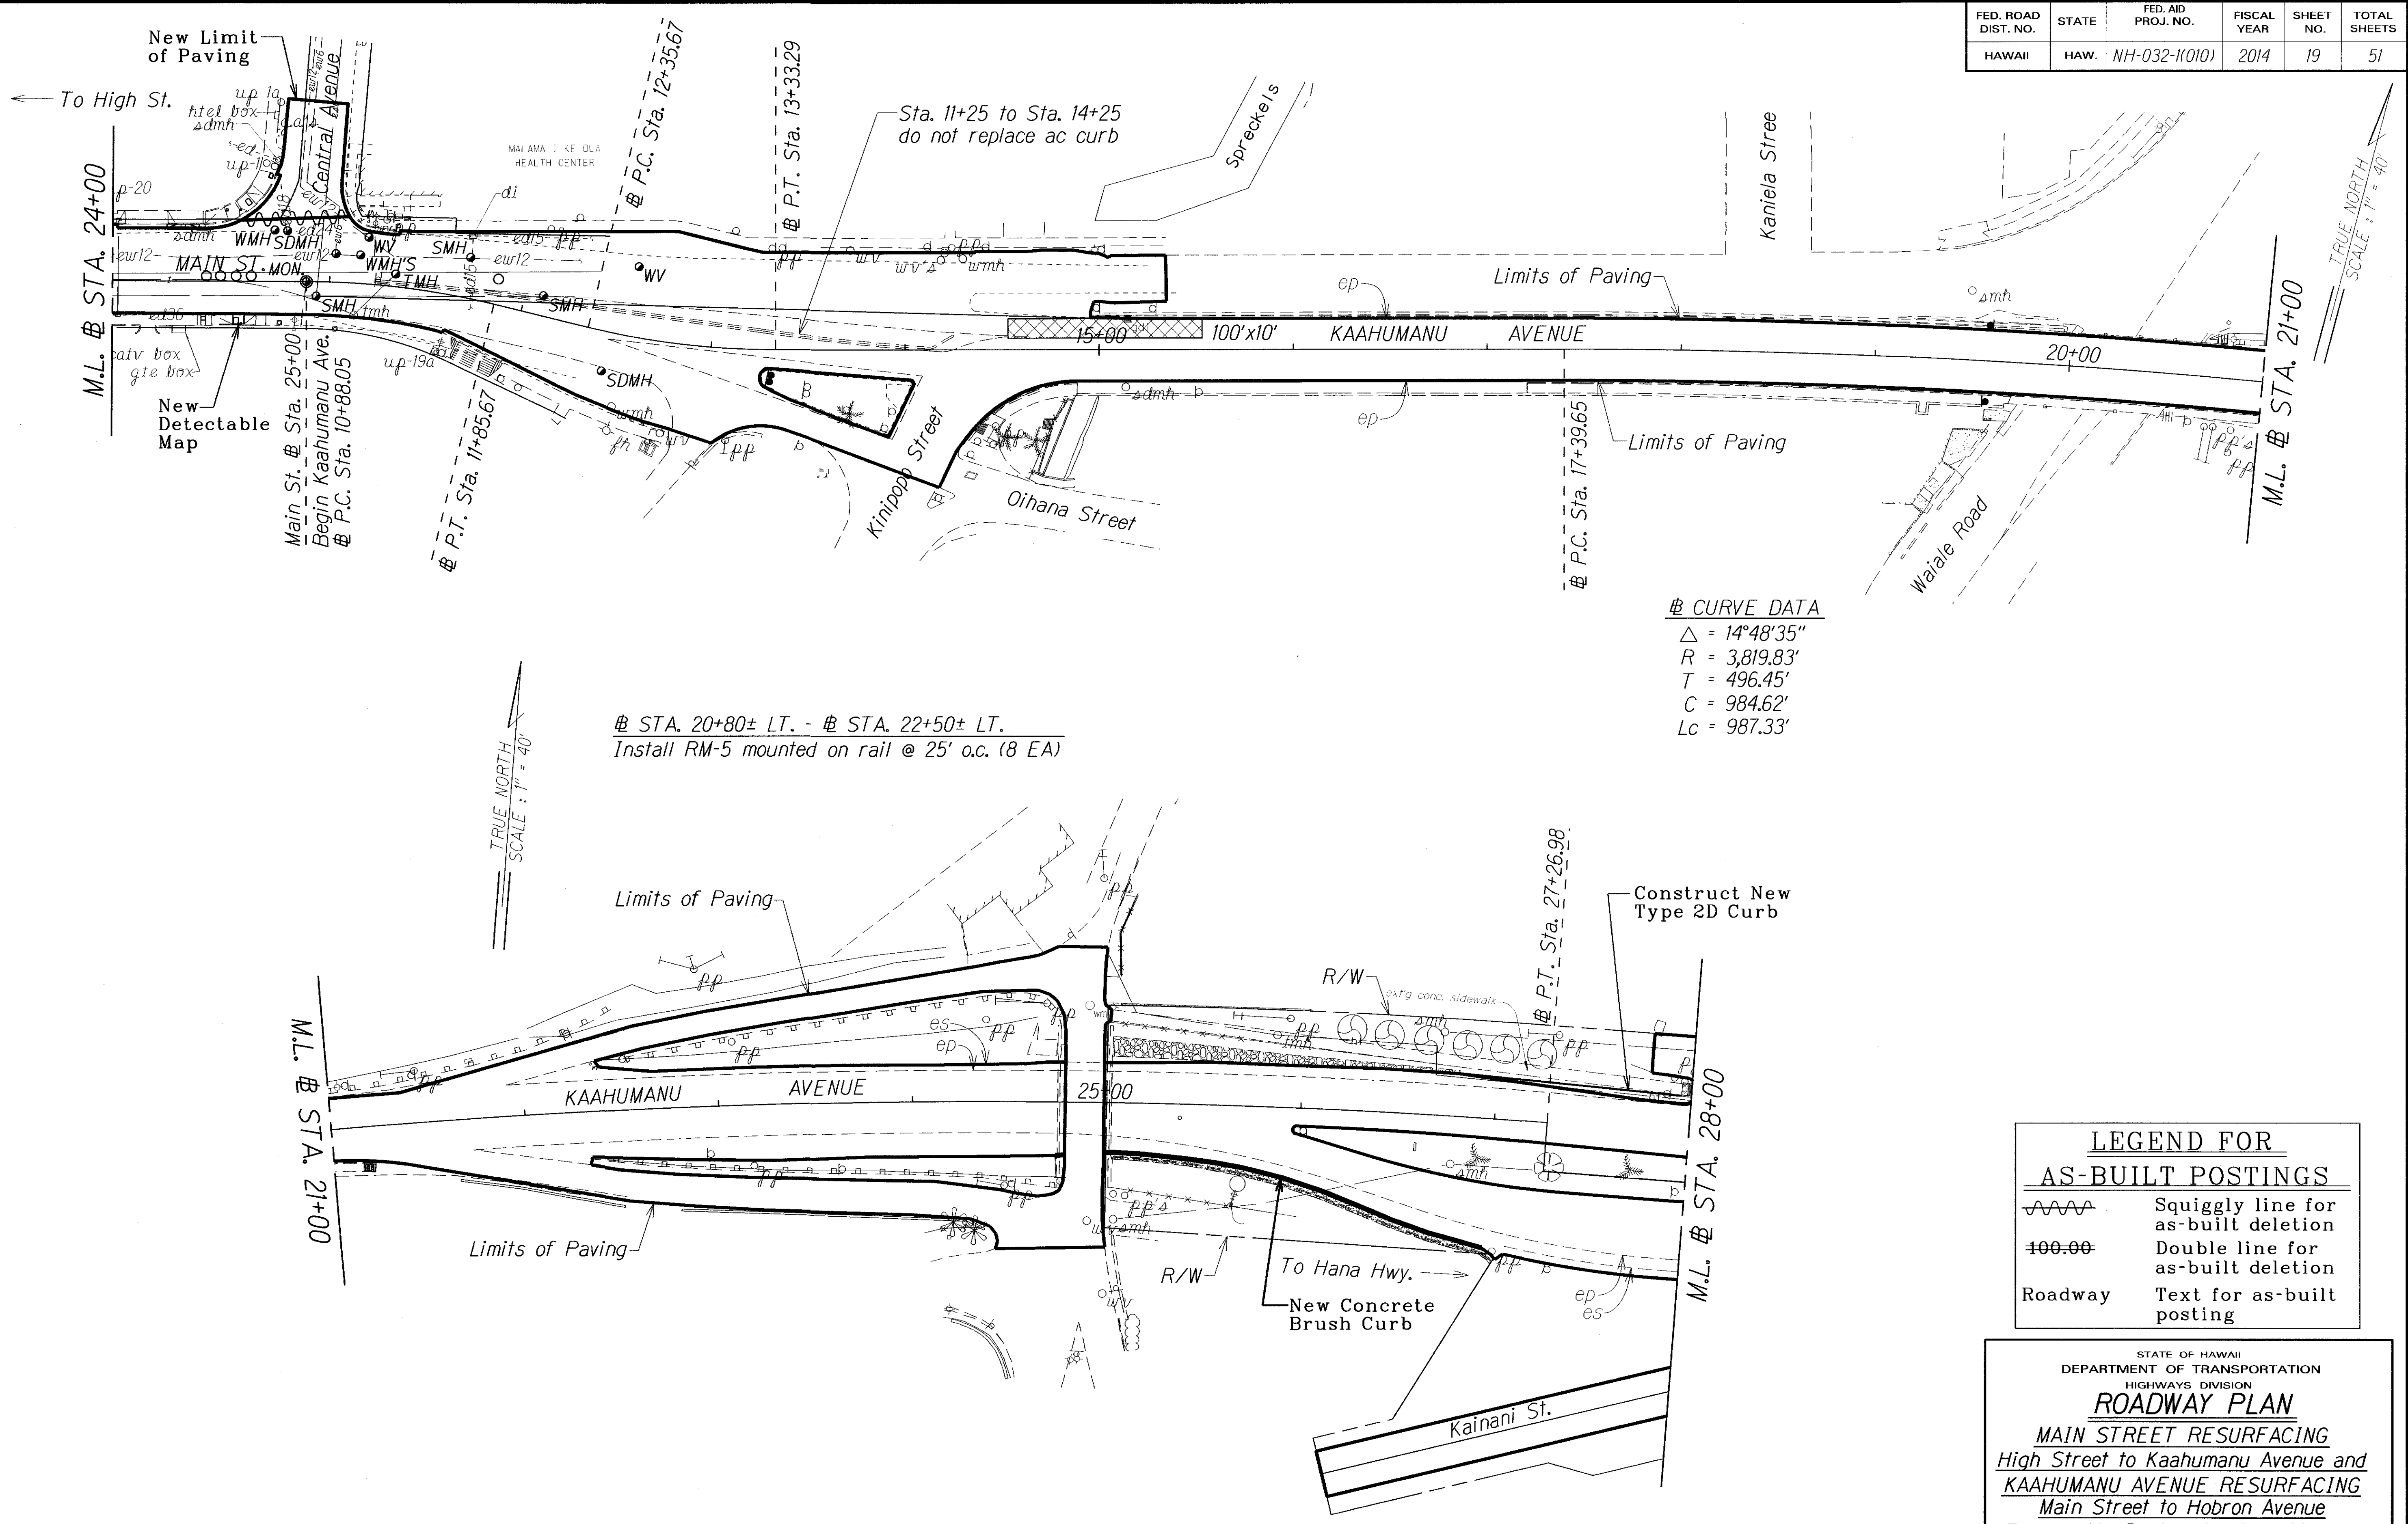

|               |                   |      |
|---------------|-------------------|------|
| ORIGINAL PLAN | SURVEY PLOTTED BY | DATE |
| NOTE BOOK     | DRAWN BY          |      |
|               | TRACED BY         |      |
|               | DESIGNED BY       |      |
|               | CHECKED BY        |      |

| LEGEND FOR AS-BUILT POSTINGS |                                     |
|------------------------------|-------------------------------------|
|                              | Squiggly line for as-built deletion |
|                              | Double line for as-built deletion   |
| Roadway                      | Text for as-built posting           |

STATE OF HAWAII  
DEPARTMENT OF TRANSPORTATION  
HIGHWAYS DIVISION


ROADWAY PLAN  
MAIN STREET RESURFACING  
High Street to Kaahumanu Avenue and  
KAAHUMANU AVENUE RESURFACING  
Main Street to Hobron Avenue  
Federal-Aid Project No. NH-032-1(010)  
Scale: 1" = 40'      Date: July, 2014







| FED. ROAD DIST. NO. | STATE | FED. AID PROJ. NO. | FISCAL YEAR | SHEET NO. | TOTAL SHEETS |
|---------------------|-------|--------------------|-------------|-----------|--------------|
| HAWAII              | HAW.  | NH-032-1(010)      | 2014        | ADD.21    | 51           |

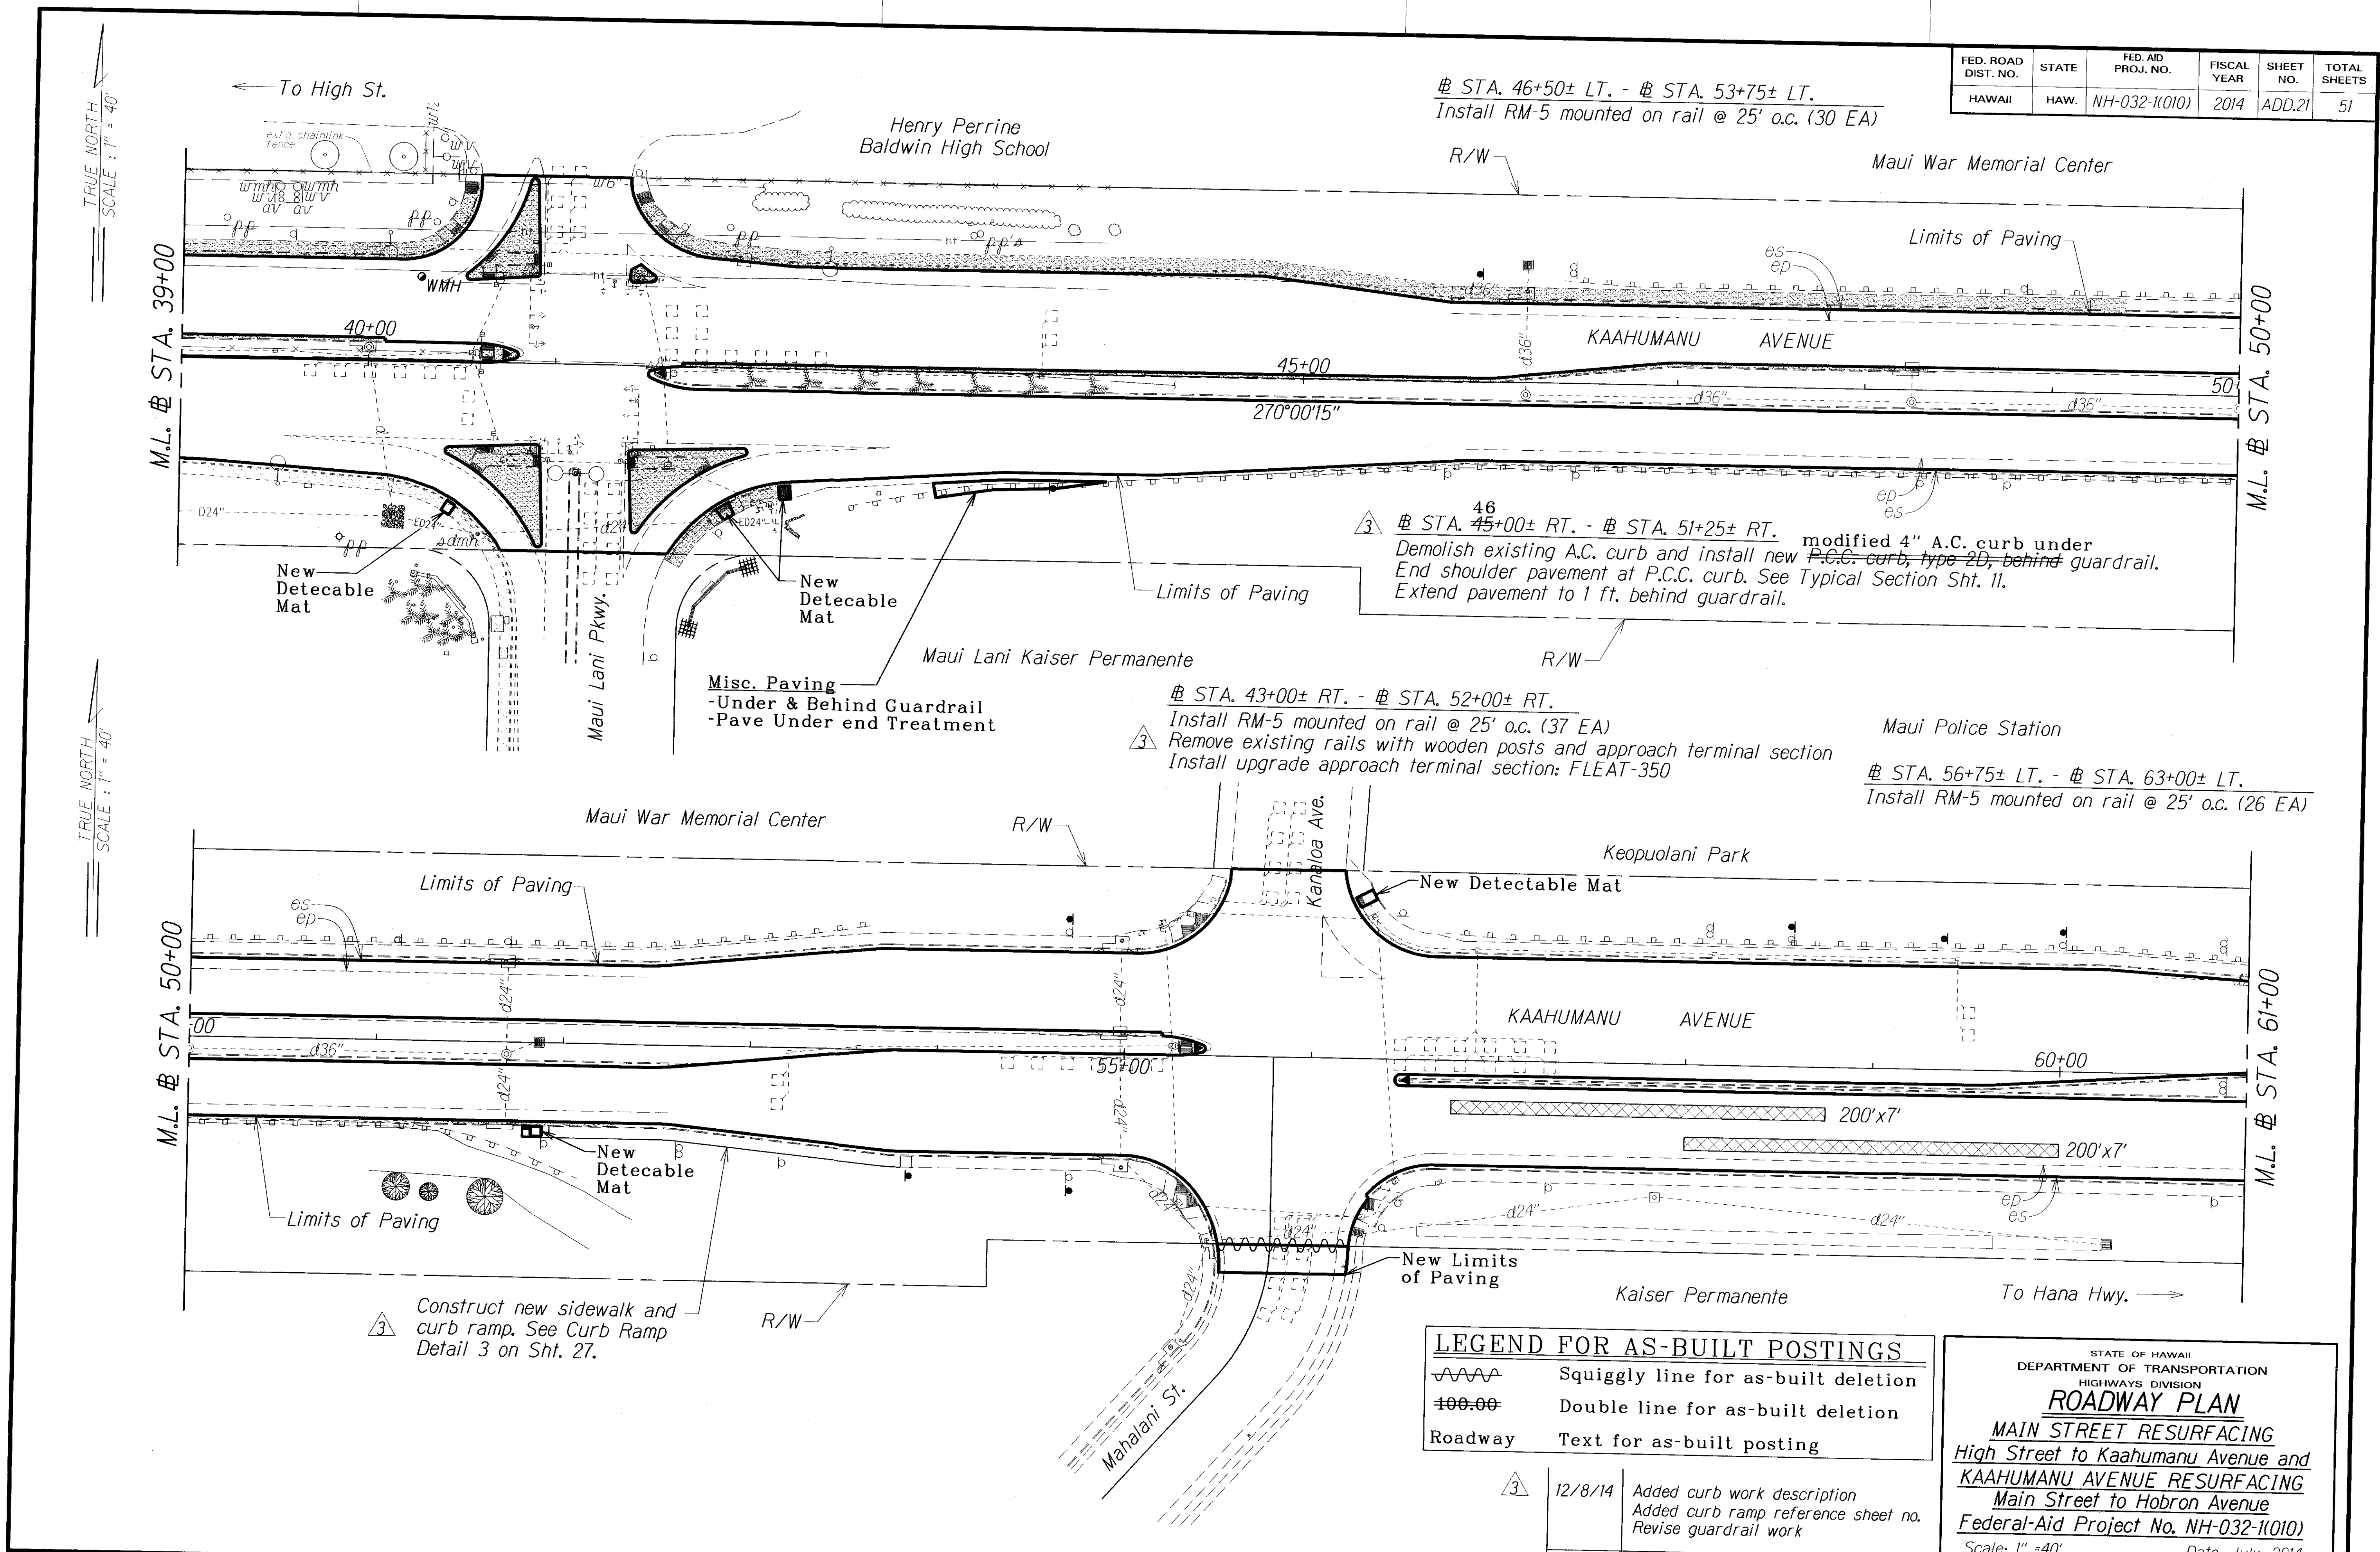

|                   |      |
|-------------------|------|
| ORIGINAL PLAN     | DATE |
| SURVEY PLOTTED BY |      |
| DRAWN BY          |      |
| DESIGNED BY       |      |
| CHECKED BY        |      |
| NOTED BY          |      |
| DATE              |      |

| LEGEND FOR AS-BUILT POSTINGS |                                     |
|------------------------------|-------------------------------------|
|                              | Squiggly line for as-built deletion |
|                              | Double line for as-built deletion   |
| Roadway                      | Text for as-built posting           |

| 12/8/14 | Added curb work description<br>Added curb ramp reference sheet no.<br>Revise guardrail work |
|---------|---------------------------------------------------------------------------------------------|
| DATE    | REVISION                                                                                    |

STATE OF HAWAII  
DEPARTMENT OF TRANSPORTATION  
HIGHWAYS DIVISION


**ROADWAY PLAN**

MAIN STREET RESURFACING  
High Street to Kaahumanu Avenue and  
KAAHUMANU AVENUE RESURFACING  
Main Street to Hobron Avenue  
Federal-Aid Project No. NH-032-1(010)  
Scale: 1" = 40' Date: July, 2014

SHEET No. 4 OF 8 SHEETS



| FED. ROAD DIST. NO. | STATE | FED. AID PROJ. NO. | FISCAL YEAR | SHEET NO. | TOTAL SHEETS |
|---------------------|-------|--------------------|-------------|-----------|--------------|
| HAWAII              | HAW.  | NH-032-1(010)      | 2014        | 22        | 51           |

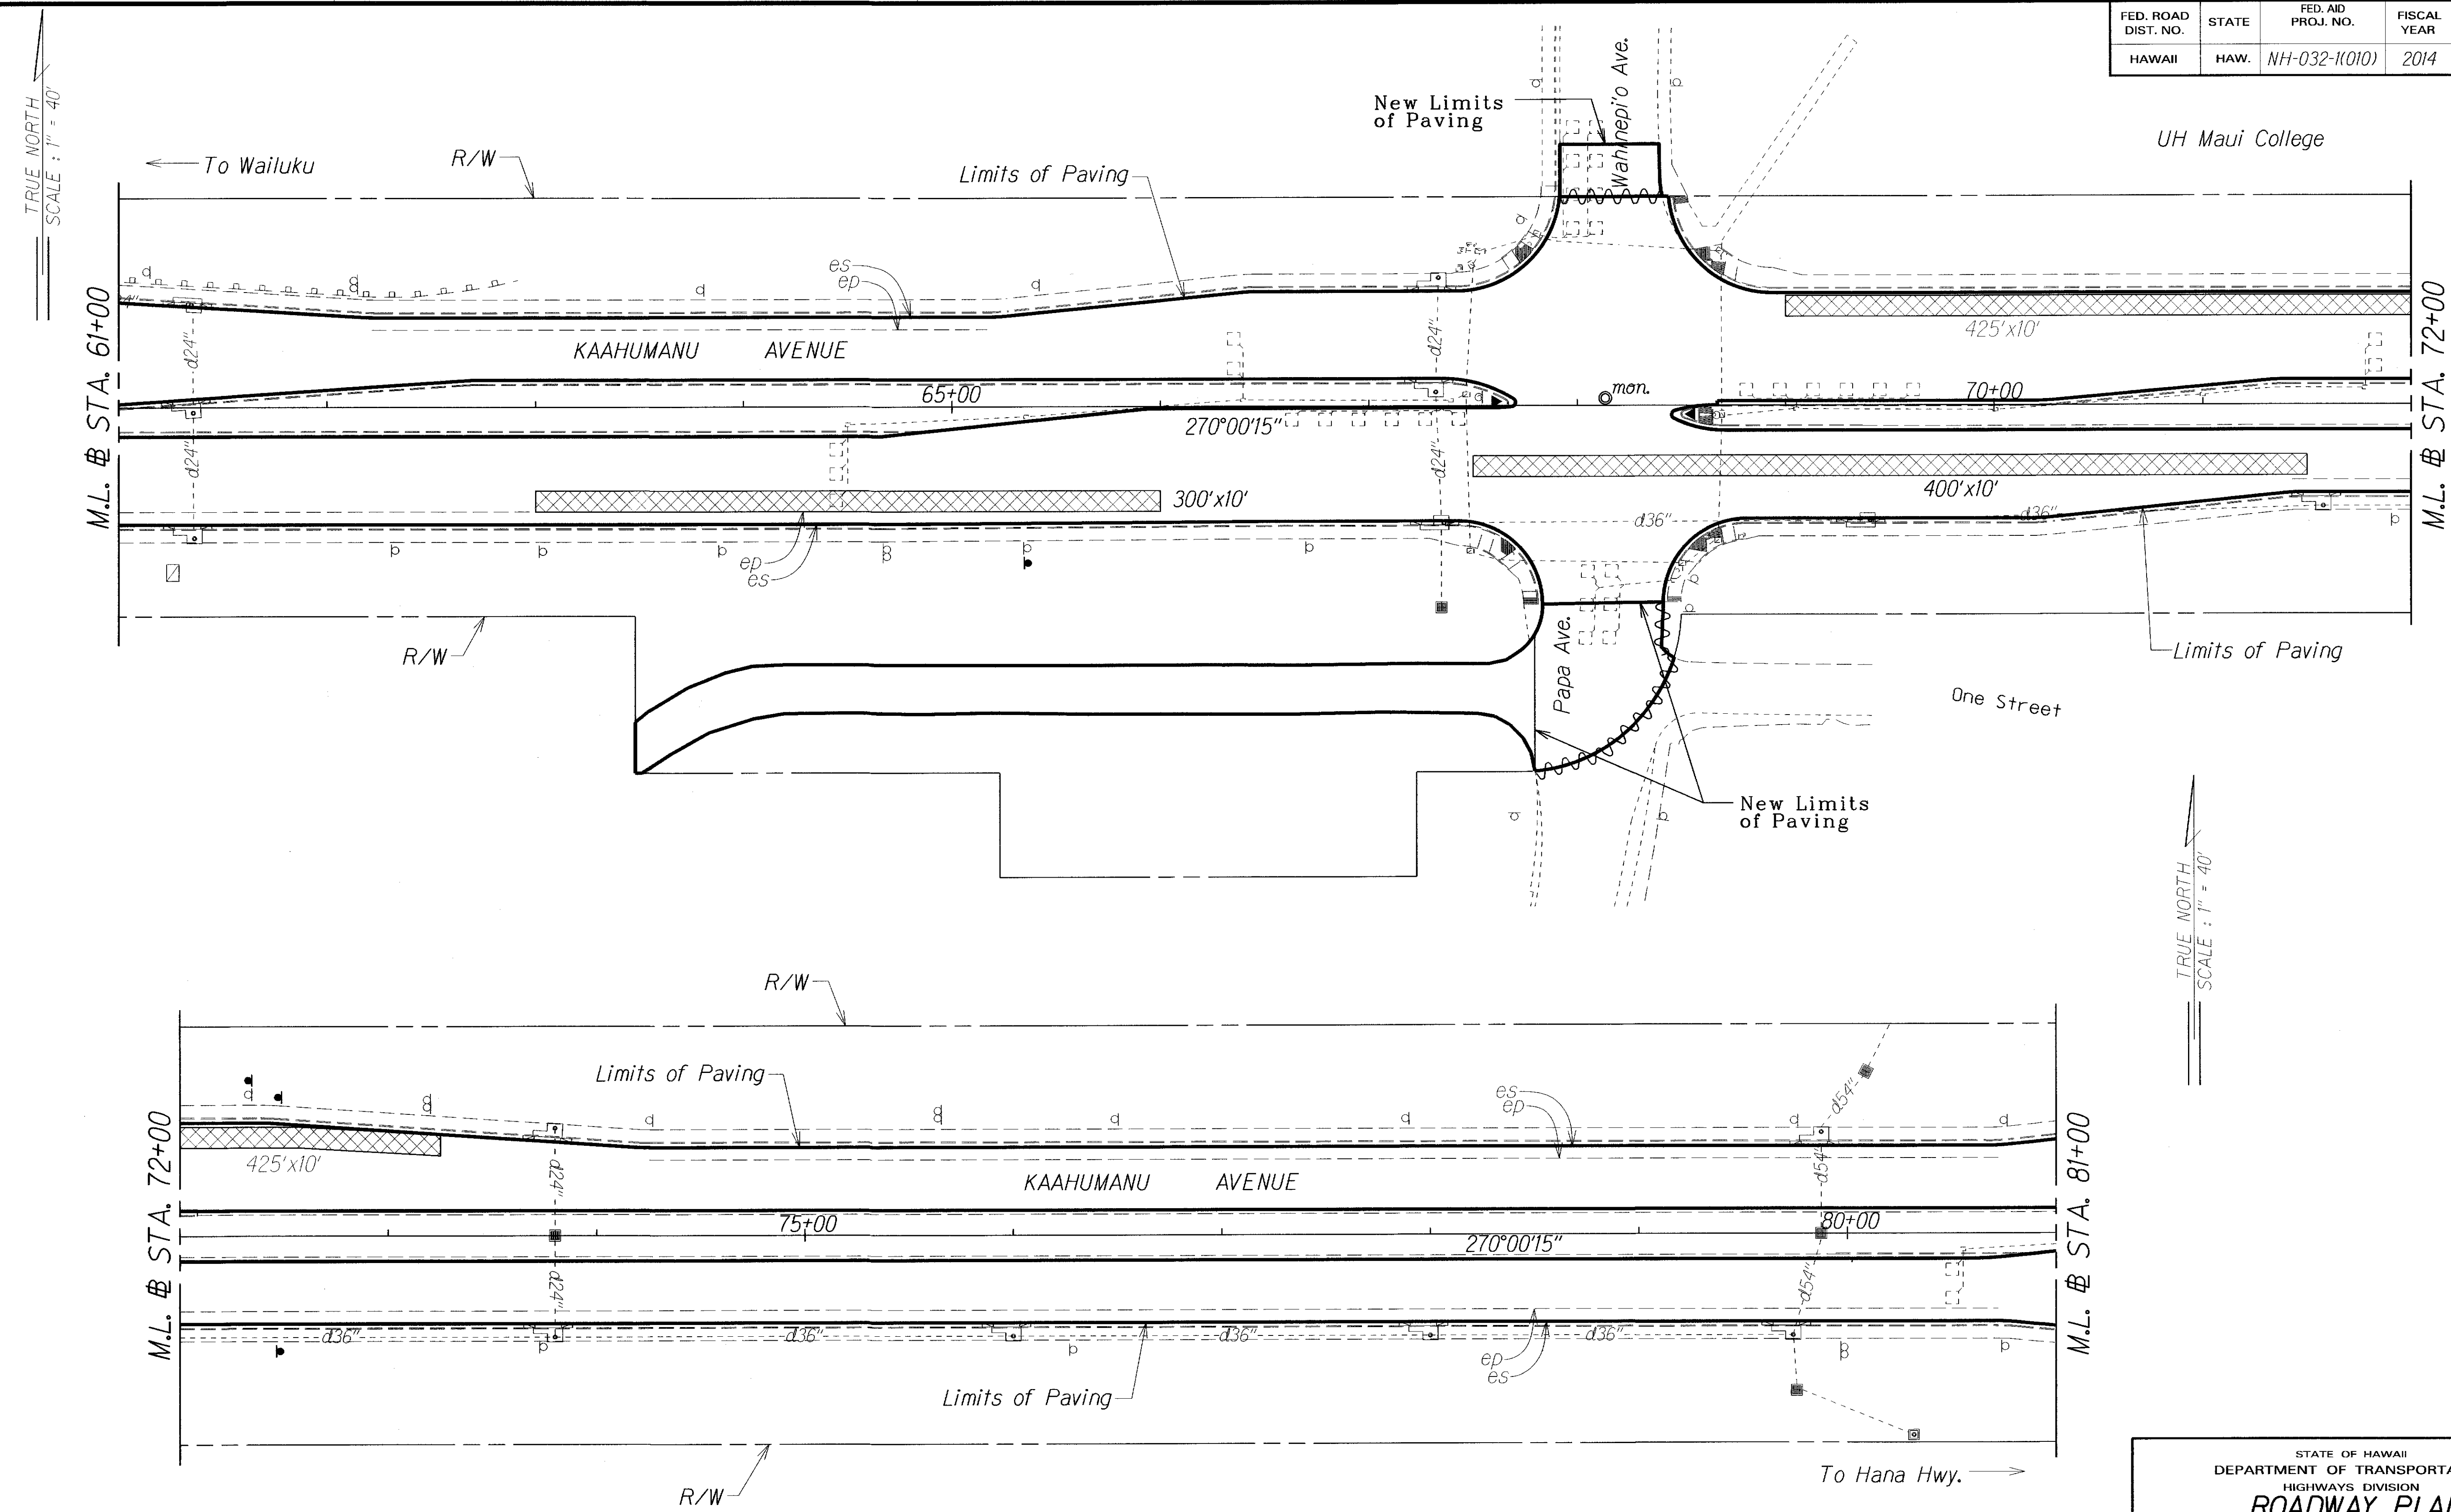

|               |                   |      |
|---------------|-------------------|------|
| ORIGINAL PLAN | SURVEY PLOTTED BY | DATE |
| NOTE BOOK     | DRAWN BY          |      |
|               | DESIGNED BY       |      |
|               | CHECKED BY        |      |


| LEGEND FOR AS-BUILT POSTINGS |                                     |
|------------------------------|-------------------------------------|
|                              | Squiggly line for as-built deletion |
|                              | Double line for as-built deletion   |
| Roadway                      | Text for as-built posting           |

STATE OF HAWAII  
DEPARTMENT OF TRANSPORTATION  
HIGHWAYS DIVISION  
**ROADWAY PLAN**  
MAIN STREET RESURFACING  
High Street to Kaahumanu Avenue and  
KAAHUMANU AVENUE RESURFACING  
Main Street to Hobron Avenue  
Federal-Aid Project No. NH-032-1(010)  
Scale: 1" = 40' Date: July, 2014  
SHEET No. 5 OF 8 SHEETS

"AS-BUILT"



| FED. ROAD DIST. NO. | STATE | FED. AID PROJ. NO. | FISCAL YEAR | SHEET NO. | TOTAL SHEETS |
|---------------------|-------|--------------------|-------------|-----------|--------------|
| HAWAII              | HAW.  | NH-032-1(010)      | 2014        | 23        | 51           |

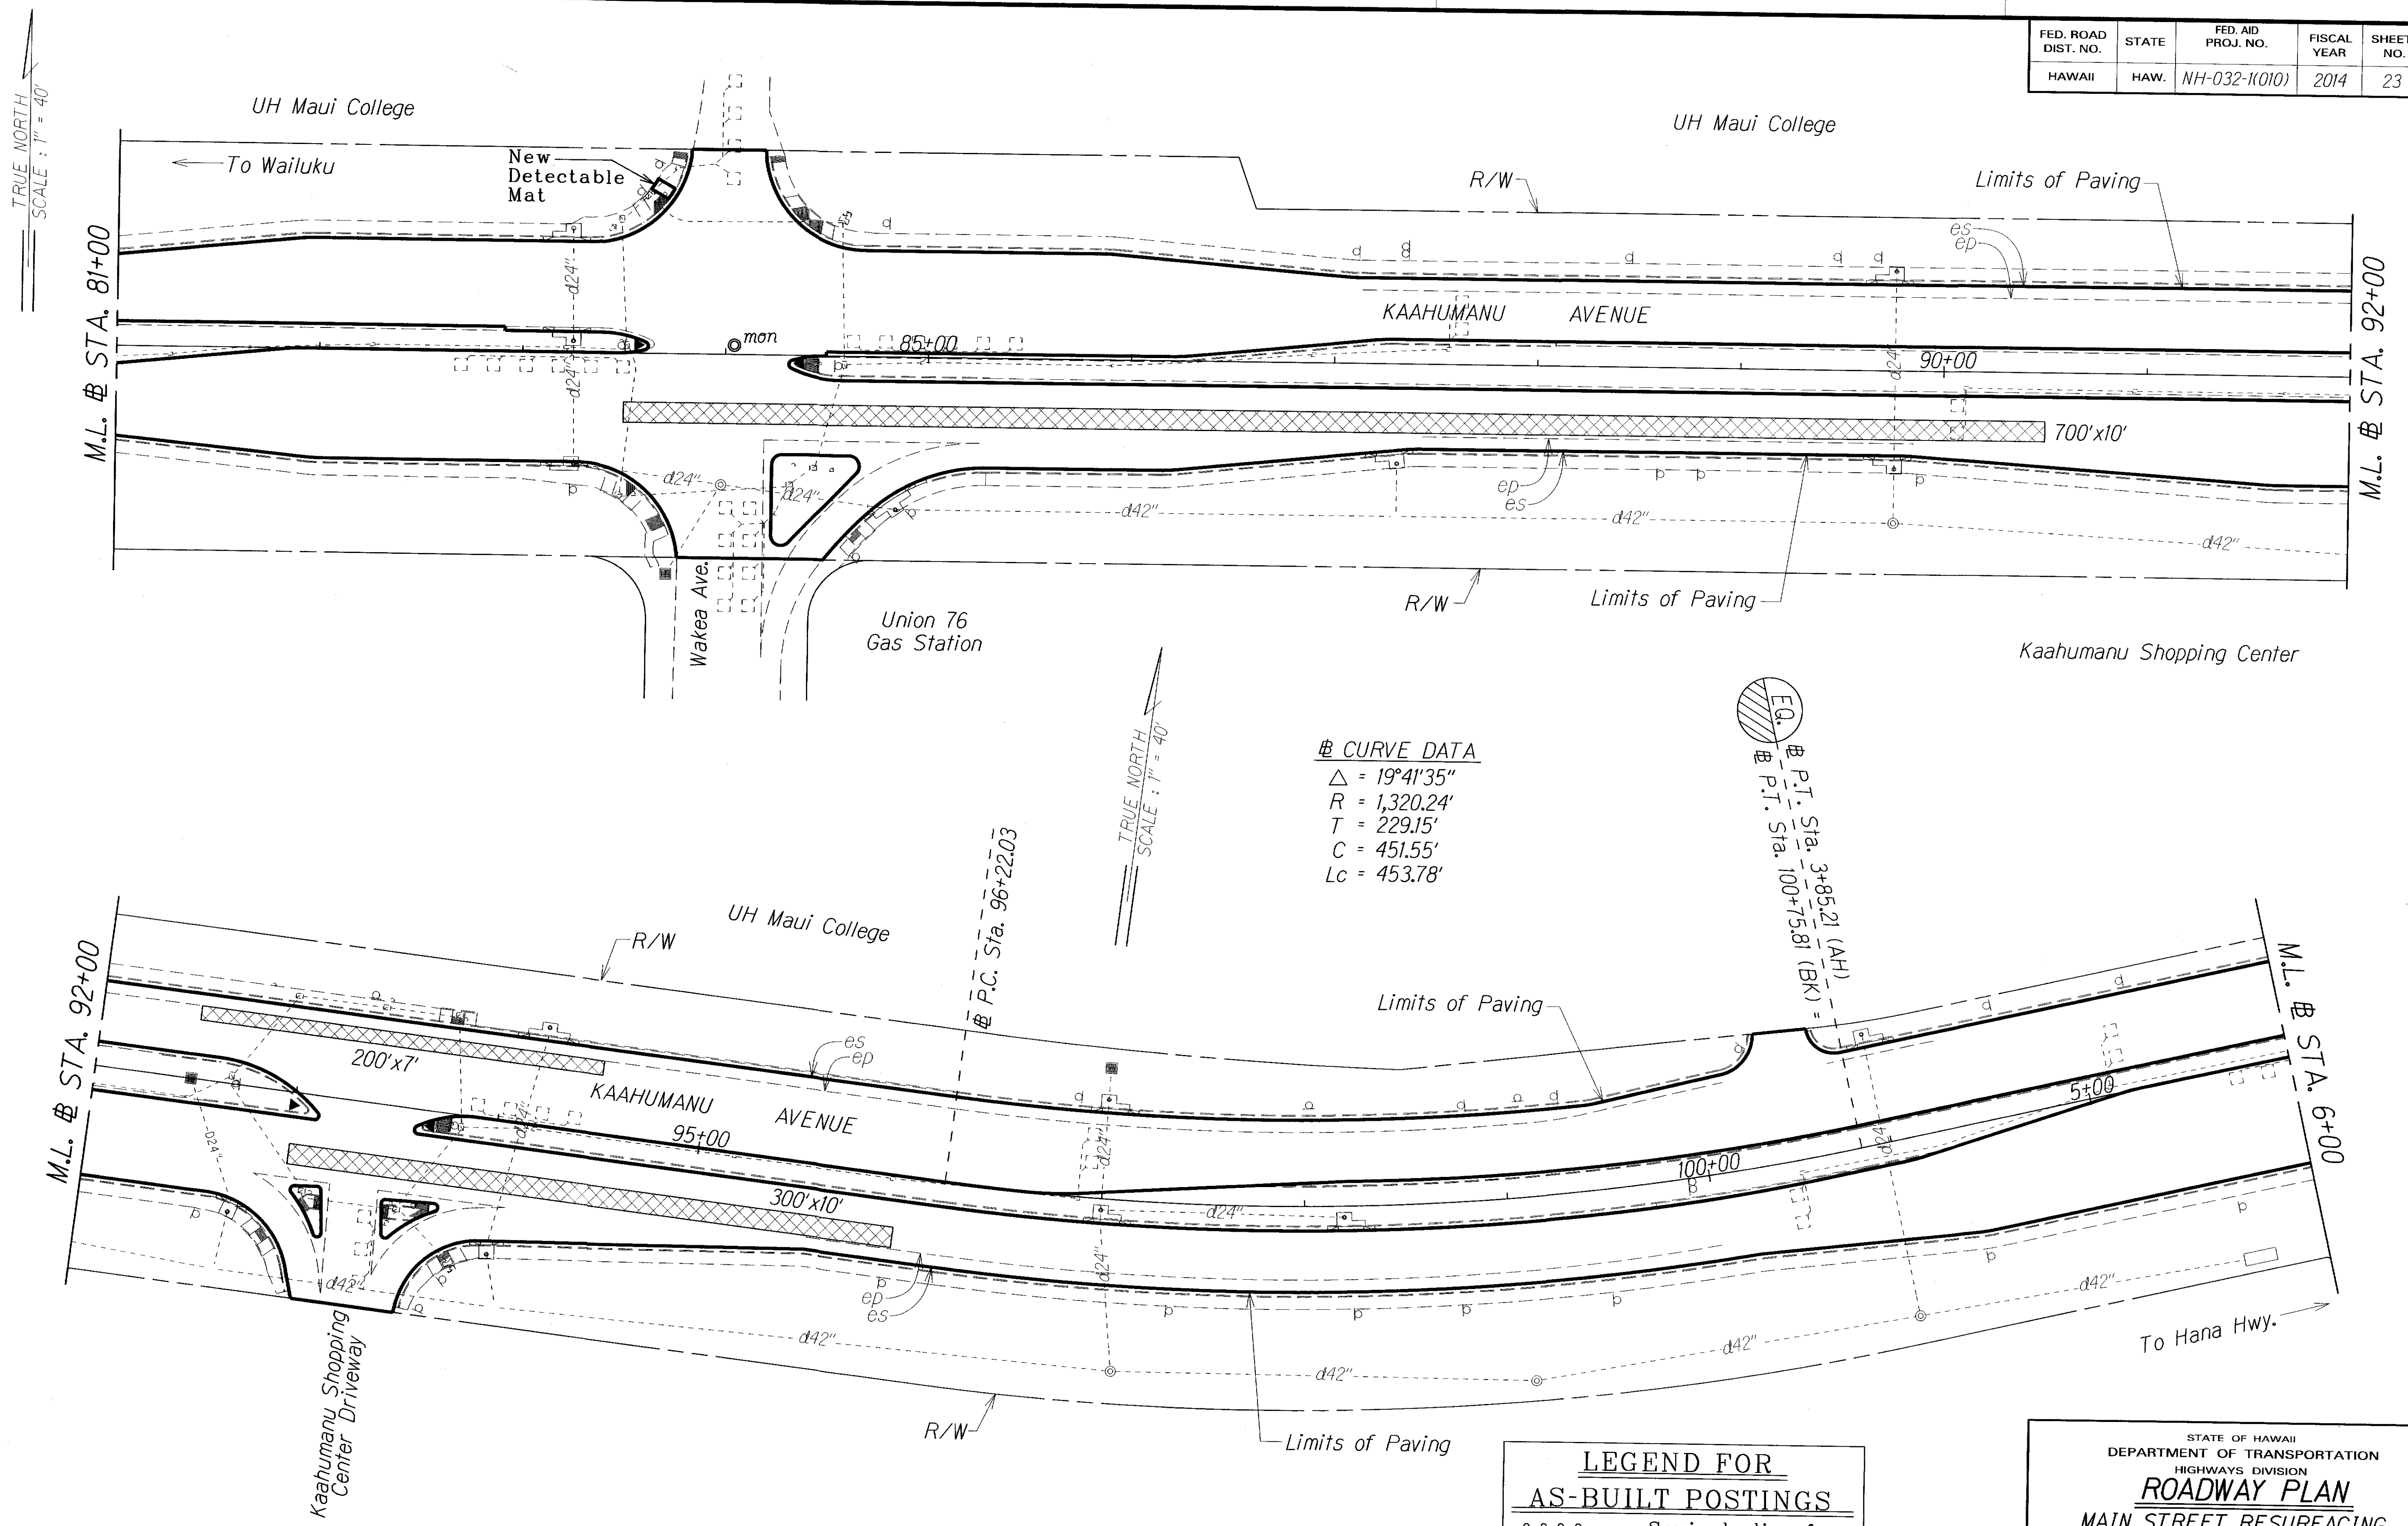

|               |                   |      |
|---------------|-------------------|------|
| ORIGINAL PLAN | SURVEY PLOTTED BY | DATE |
| DESIGNED BY   |                   |      |
| NOTE BOOK     |                   |      |
| QUANTITIES BY |                   |      |
| CHECKED BY    |                   |      |
| N.            |                   |      |

| LEGEND FOR AS-BUILT POSTINGS |                                     |
|------------------------------|-------------------------------------|
| ~~~~~                        | Squiggly line for as-built deletion |
| ==                           | Double line for as-built deletion   |
| Roadway                      | Text for as-built posting           |

STATE OF HAWAII  
DEPARTMENT OF TRANSPORTATION  
HIGHWAYS DIVISION

**ROADWAY PLAN**

MAIN STREET RESURFACING  
High Street to Kaahumanu Avenue and  
KAAHUMANU AVENUE RESURFACING  
Main Street to Hobron Avenue  
Federal-Aid Project No. NH-032-1(010)


Scale: 1" = 40' Date: July, 2014

SHEET No. 6 OF 8 SHEETS

"AS-BUILT"



| FED. ROAD DIST. NO. | STATE | FED. AID PROJ. NO. | FISCAL YEAR | SHEET NO. | TOTAL SHEETS |
|---------------------|-------|--------------------|-------------|-----------|--------------|
| HAWAII              | HAW.  | NH-032-1(010)      | 2014        | 24        | 51           |

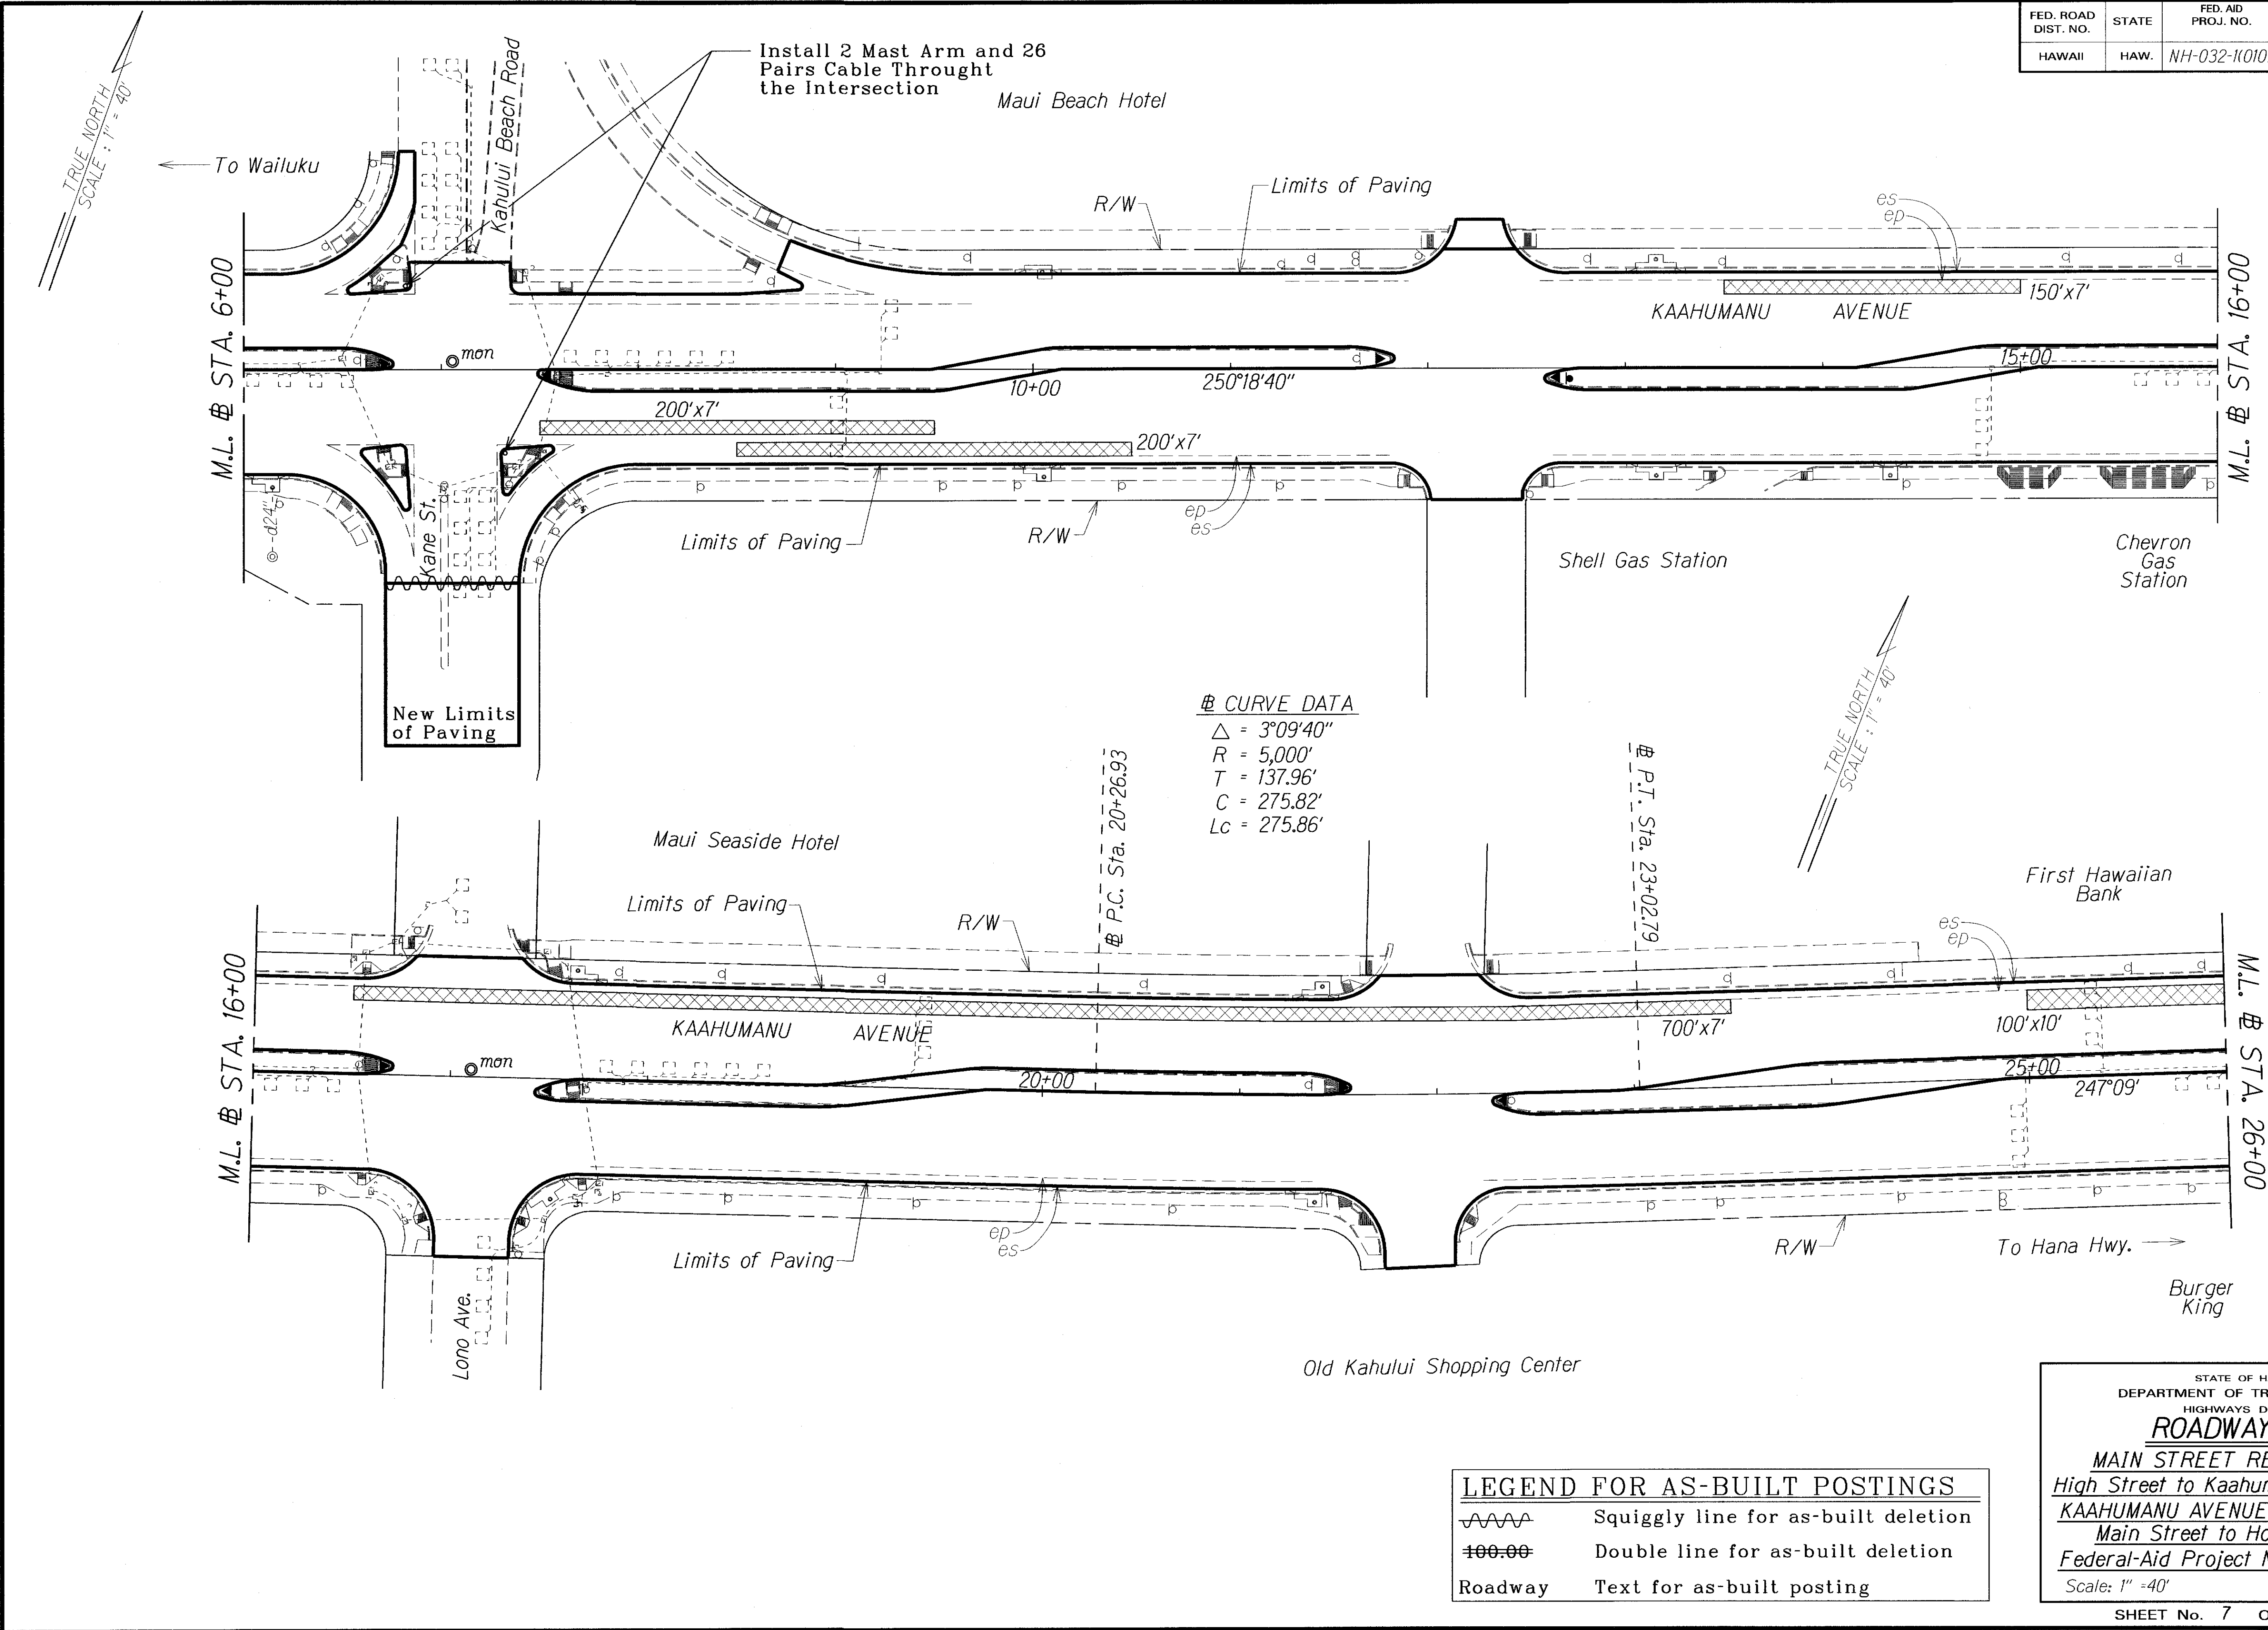

|               |                   |      |
|---------------|-------------------|------|
| ORIGINAL PLAN | SURVEY PLOTTED BY | DATE |
| NOTE BOOK     | DRAWN BY          |      |
|               | DESIGNED BY       |      |
|               | CHECKED BY        |      |
|               |                   |      |

| LEGEND FOR AS-BUILT POSTINGS |                                     |
|------------------------------|-------------------------------------|
|                              | Squiggly line for as-built deletion |
|                              | Double line for as-built deletion   |
| Roadway                      | Text for as-built posting           |

STATE OF HAWAII  
DEPARTMENT OF TRANSPORTATION  
HIGHWAYS DIVISION

ROADWAY PLAN

MAIN STREET RESURFACING

High Street to Kaahumanu Avenue and  
KAAHUMANU AVENUE RESURFACING


Main Street to Hobron Avenue

Federal-Aid Project No. NH-032-1(010)

Scale: 1" = 40'      Date: July, 2014



| FED. ROAD DIST. NO. | STATE | FED. AID PROJ. NO. | FISCAL YEAR | SHEET NO. | TOTAL SHEETS |
|---------------------|-------|--------------------|-------------|-----------|--------------|
| HAWAII              | HAW.  | NH-032-1(010)      | 2014        | 25        | 51           |

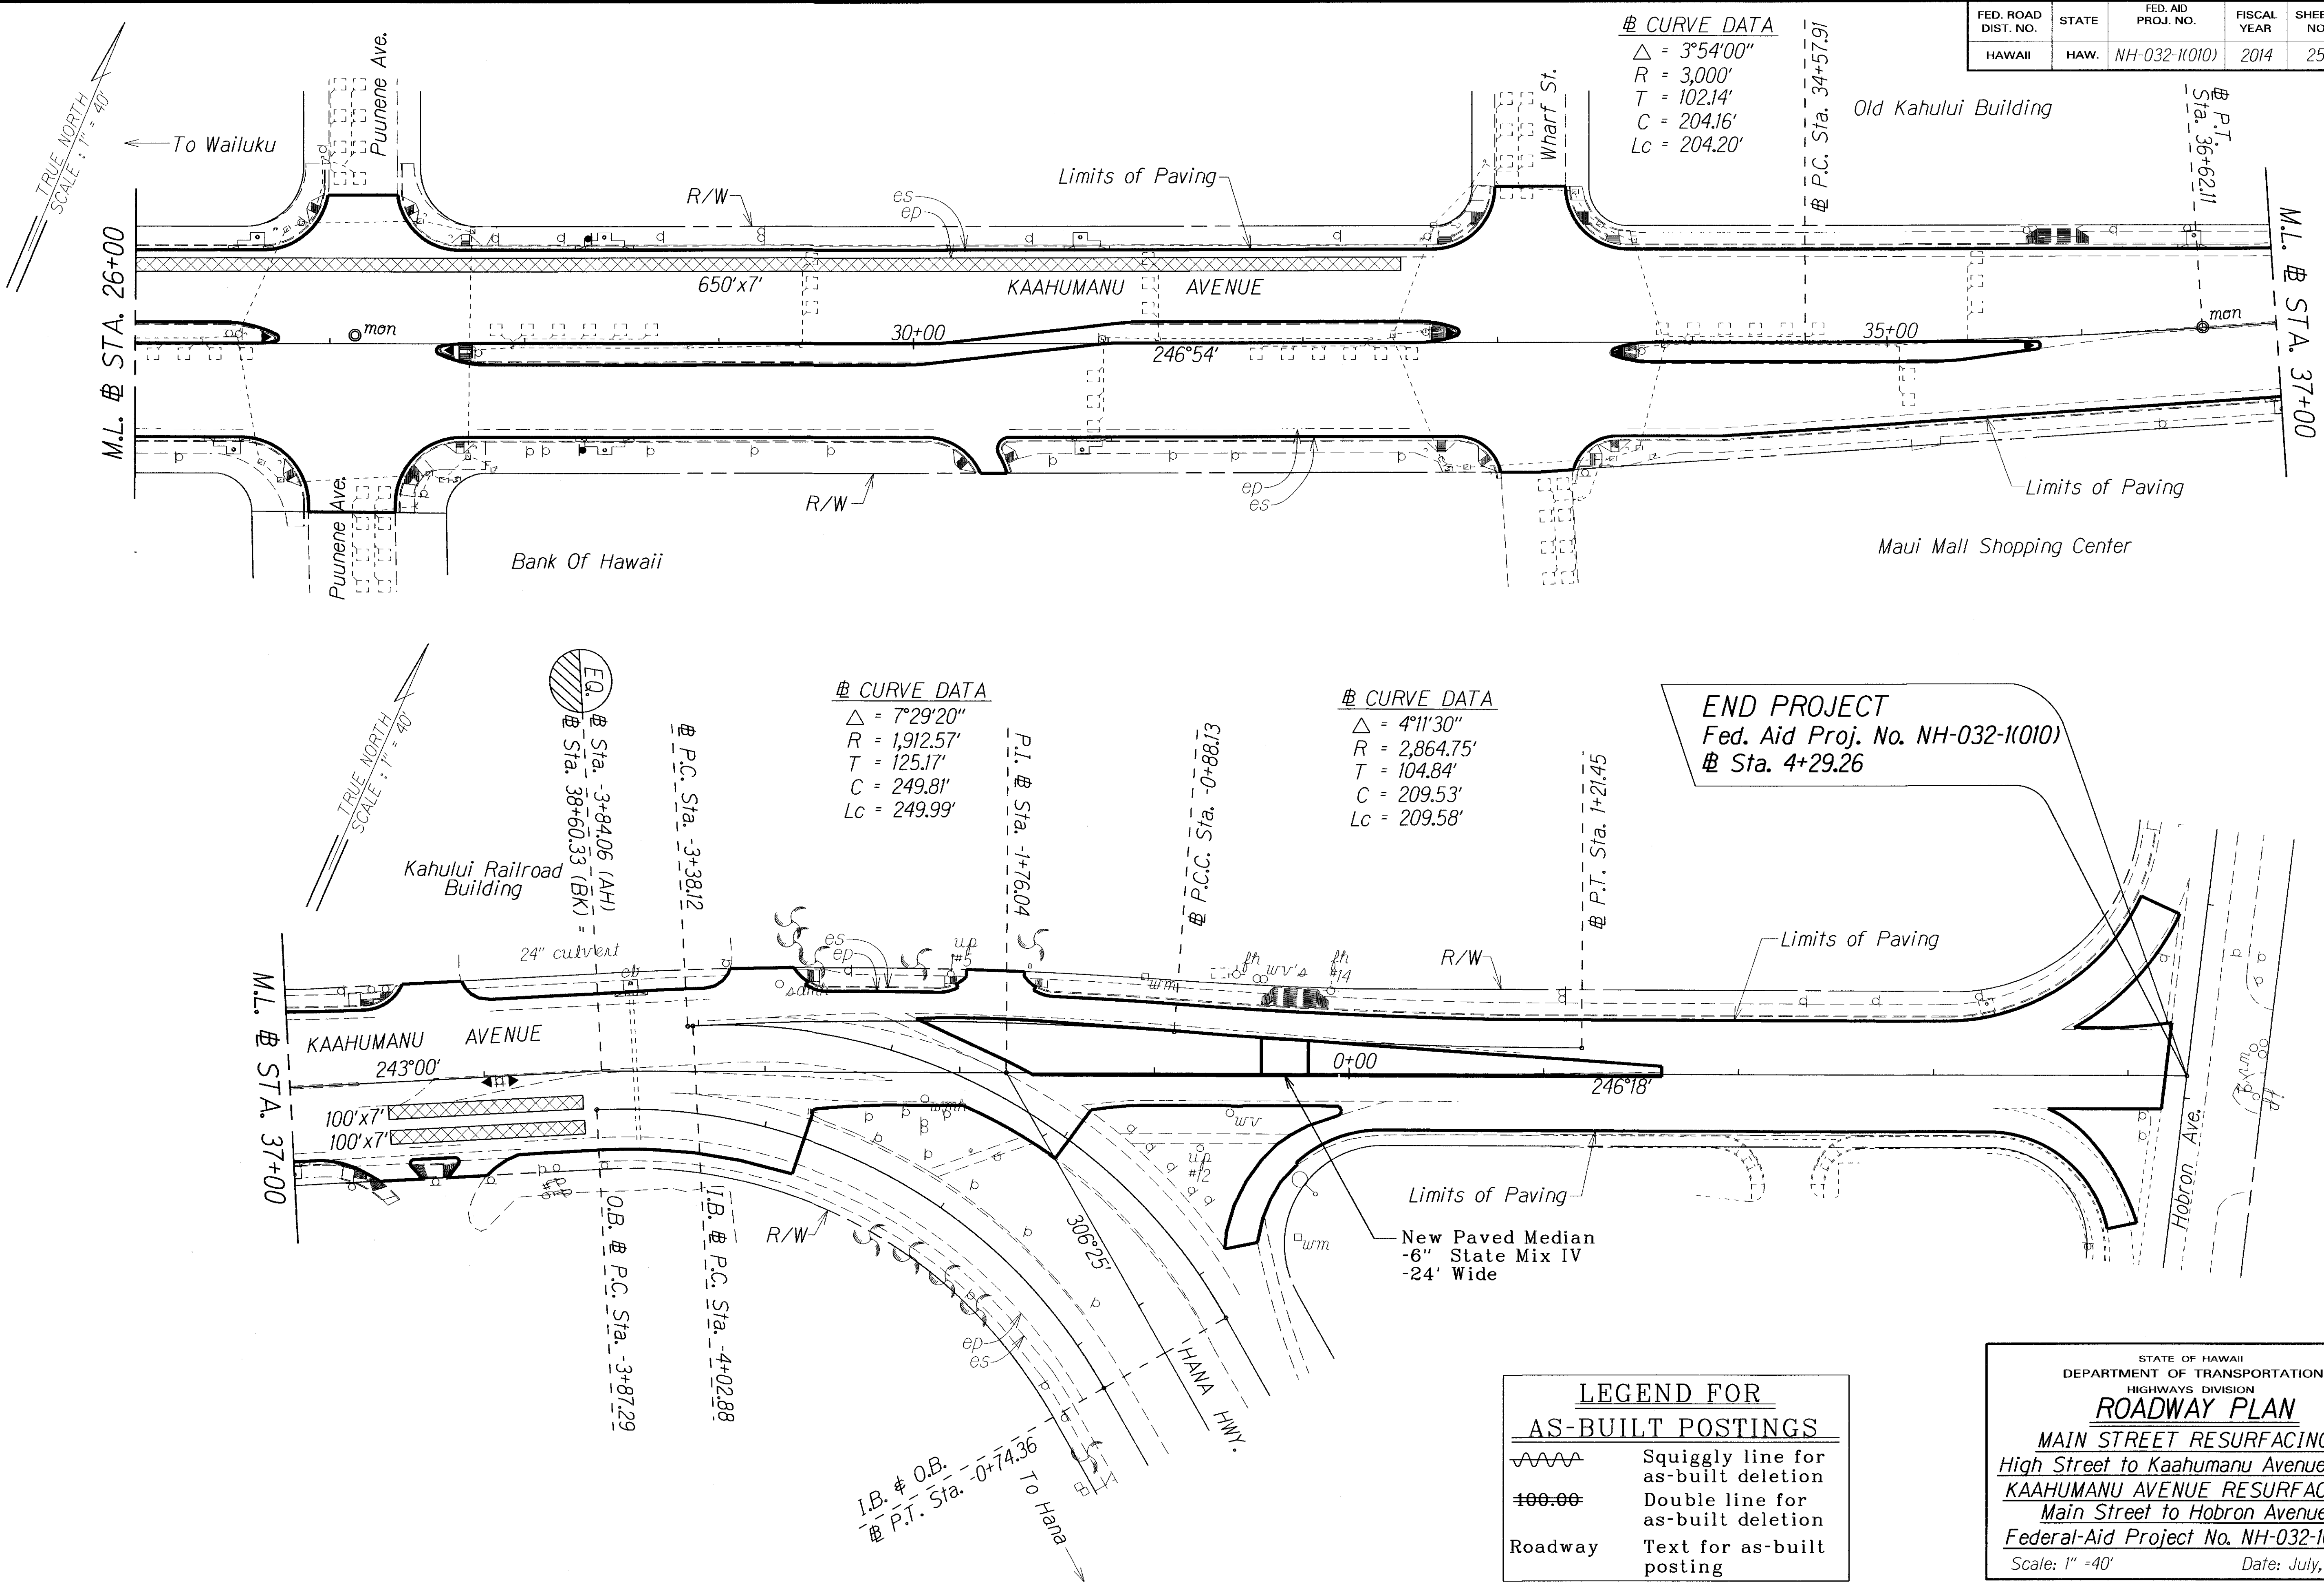

"AS-BUILT"