

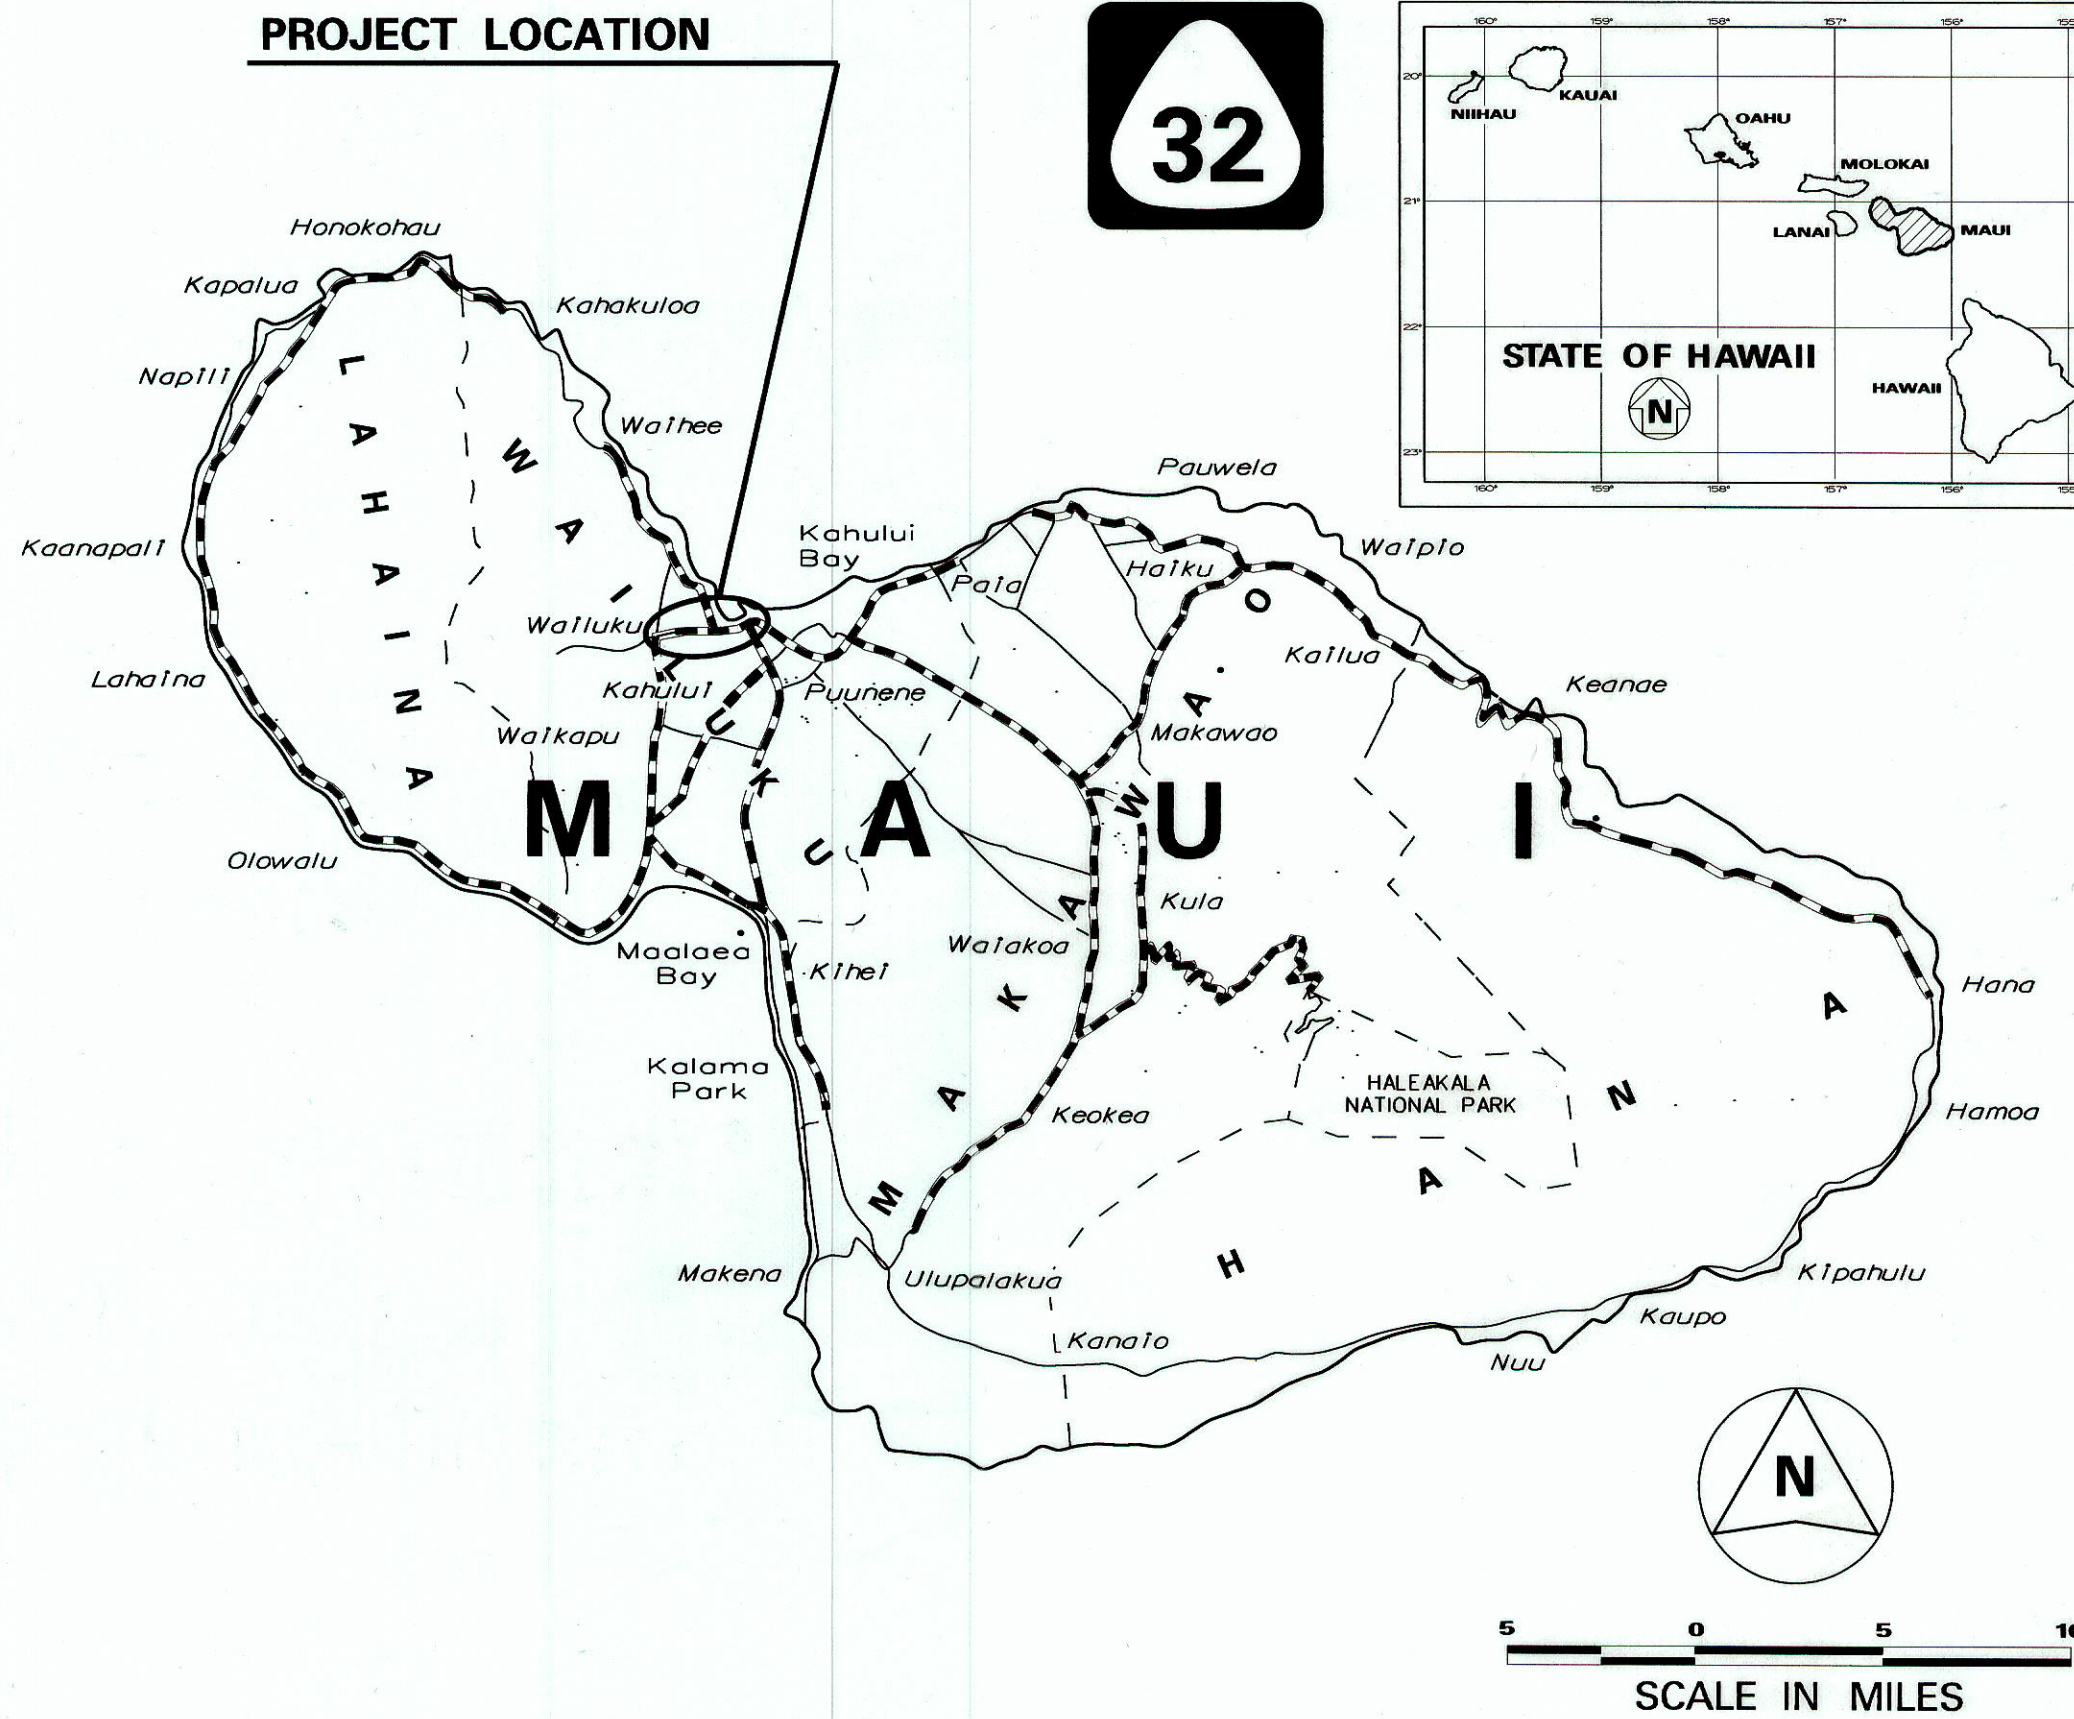


INDEX TO DRAWINGS	
SHEET NO.	DESCRIPTION
1	TITLE SHEET
2	STANDARD PLANS SUMMARY
3	GENERAL NOTES AND LEGEND
4 - 6	WATER POLLUTION & EROSION CONTROL NOTES
7 - 14	TYPICAL SECTIONS AND DETAILS
15	GUARDRAIL DETAILS
16 - 17	CURB RAMP DETAILS
18 - 25	ROADWAY PLANS
26 - 27	CURB RAMP PLANS
28	PAVEMENT MARKING LEGEND, DETAILS AND NOTES
29 - 30	SIGN PANEL LAYOUTS
31 - 38	SIGNING AND PAVEMENT MARKING PLANS
39 - 51	INTERSECTION STRIPING AND SIGNAGE PLANS

STATE OF HAWAII
DEPARTMENT OF TRANSPORTATION
HIGHWAYS DIVISION
HONOLULU, HAWAII
"AS-BUILT"
PLANS FOR
**MAIN STREET RESURFACING
HIGH STREET TO KAAHUMANU AVENUE
AND
KAAHUMANU AVENUE RESURFACING
MAIN STREET TO HOBRON AVENUE
FEDERAL-AID PROJECT NO. NH-032-1(010)**
DISTRICT OF WAILUKU
ISLAND OF MAUI

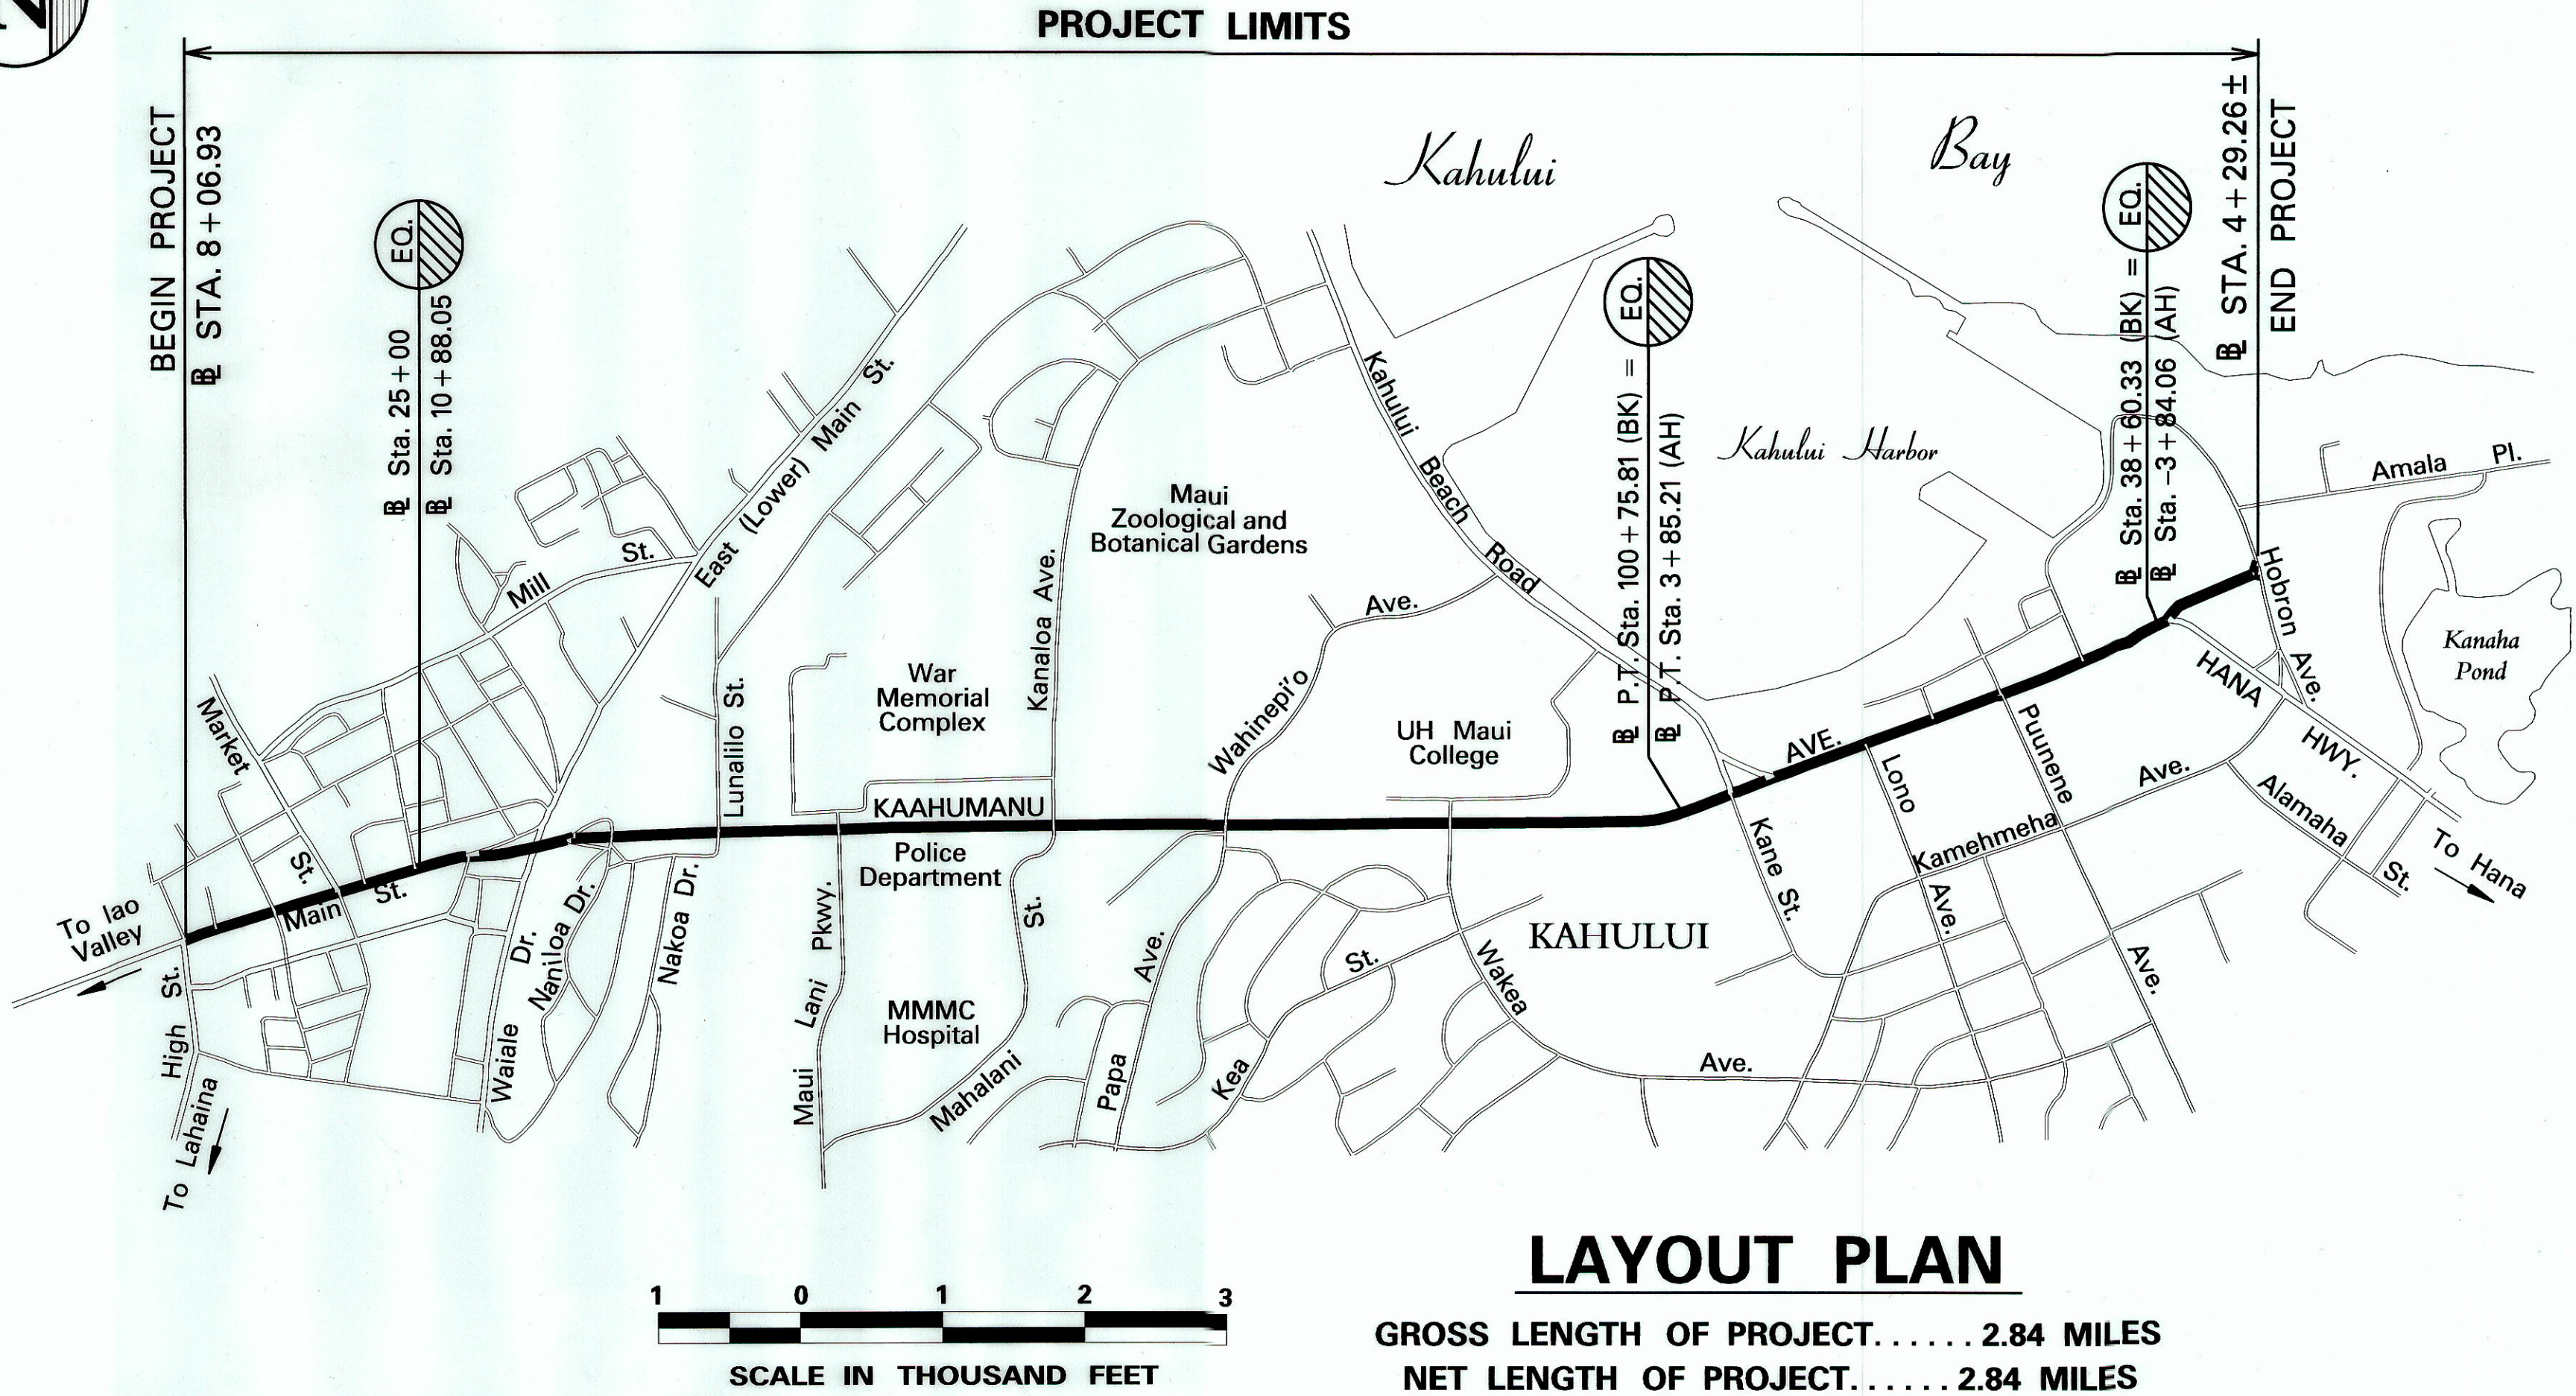

FED. ROAD DIST. NO.	STATE	FED. AID PROJ. NO.	FISCAL YEAR	SHEET NO.	TOTAL SHEETS
HAWAII	HAW.	NH-032-1(010)	2014	1	51

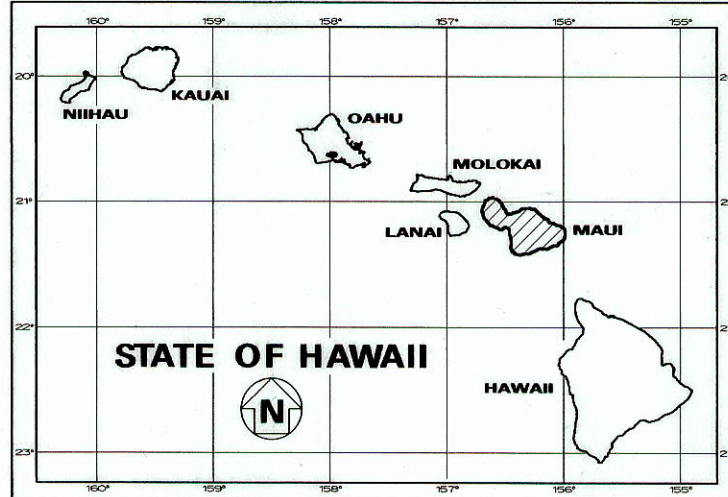

FEDERAL AID PROJECTS PREVIOUSLY CONSTRUCTED OR UNDER CONSTRUCTION

MILE POST 0.00 TO MILE POST 2.84

DESIGN DESIGNATION				
DESIGN DESIGNATION	MAIN ST. TO HIGH ST. TO CENTRAL AVE. RTE. 32 (M.P. 0.00 - 0.37)	KAAHUMANU AVE. CENTRAL AVE. TO KINIPOPO ST. RTE. 32 (M.P. 0.37 - 0.40)	KAAHUMANU AVE. KANIPOPO ST. TO KANALOA AVE. RTE. 32 (M.P. 0.40 - 1.18)	KAAHUMANU AVE. KANALOA AVE. TO PAPA AVE. RTE. 32 (M.P. 1.18 - 1.41)
ADT (2013)	12,700	26,200	34,500	38,300
ADT (2023)	15,100	30,000	39,600	43,900
DHV	1,280	2,550	3,370	3,730
DESIGN K	8.5	8.5	8.5	8.5
DESIGN D	55/45	55/45	55/45	55/45
DESIGN T	5.5	2.0	3.5	3.0
T24	3.0	2.5	2.5	3.0

DESIGN DESIGNATION	KAAHUMANU AVE. PAPA AVE. TO KAHULUI BCH. RD. RTE. 32 (M.P. 1.41 - 2.10)	KAAHUMANU AVE. KAHULUI BCH. RD. TO PUUNENE AVE. RTE. 32 (M.P. 2.10 - 2.49)	KAAHUMANU AVE. PUUNENE AVE. TO HANA HWY. RTE. 32 (M.P. 2.49 - 2.74)	KAAHUMANU AVE. HANA HWY. TO HOBRON AVE. RTE. 32 (M.P. 2.74 - 2.84)
ADT (2013)	26,700	57,100	36,800	4,100
ADT (2023)	30,600	65,500	42,200	4,600
DHV	2,600	5,240	3,380	410
DESIGN K	8.5	8.0	8.0	9.0
DESIGN D	55/45	55/45	55/45	55/45
DESIGN T	2.0	3.5	4.0	8.0
T24	2.5	4.0	5.0	8.0

CHANGES MADE DURING CONSTRUCTION HAVE BEEN INCORPORATED ON THESE PLANS EXCEPT CHANGES IN THE ORIGINAL THEORETICAL QUANTITIES. FOR ACTUAL QUANTITIES, REFER TO PROJECT LEDGER AND/OR COMPUTATION BOOK.

[Signature] 7/3/17
for RESIDENT ENGINEER DATE

DEPARTMENT OF TRANSPORTATION
STATE OF HAWAII

APPROVED:
[Signature] 10/14/14
for DIR. OF TRANSPORTATION DATE

LAYOUT PLAN

GROSS LENGTH OF PROJECT.....2.84 MILES
NET LENGTH OF PROJECT.....2.84 MILES