




FED. ROAD DIST. NO.	STATE	FED. AID PROJ. NO.	FISCAL YEAR	SHEET NO.	TOTAL SHEETS
HAWAII	HAW.	NH-032-1(010)	2014	7	51

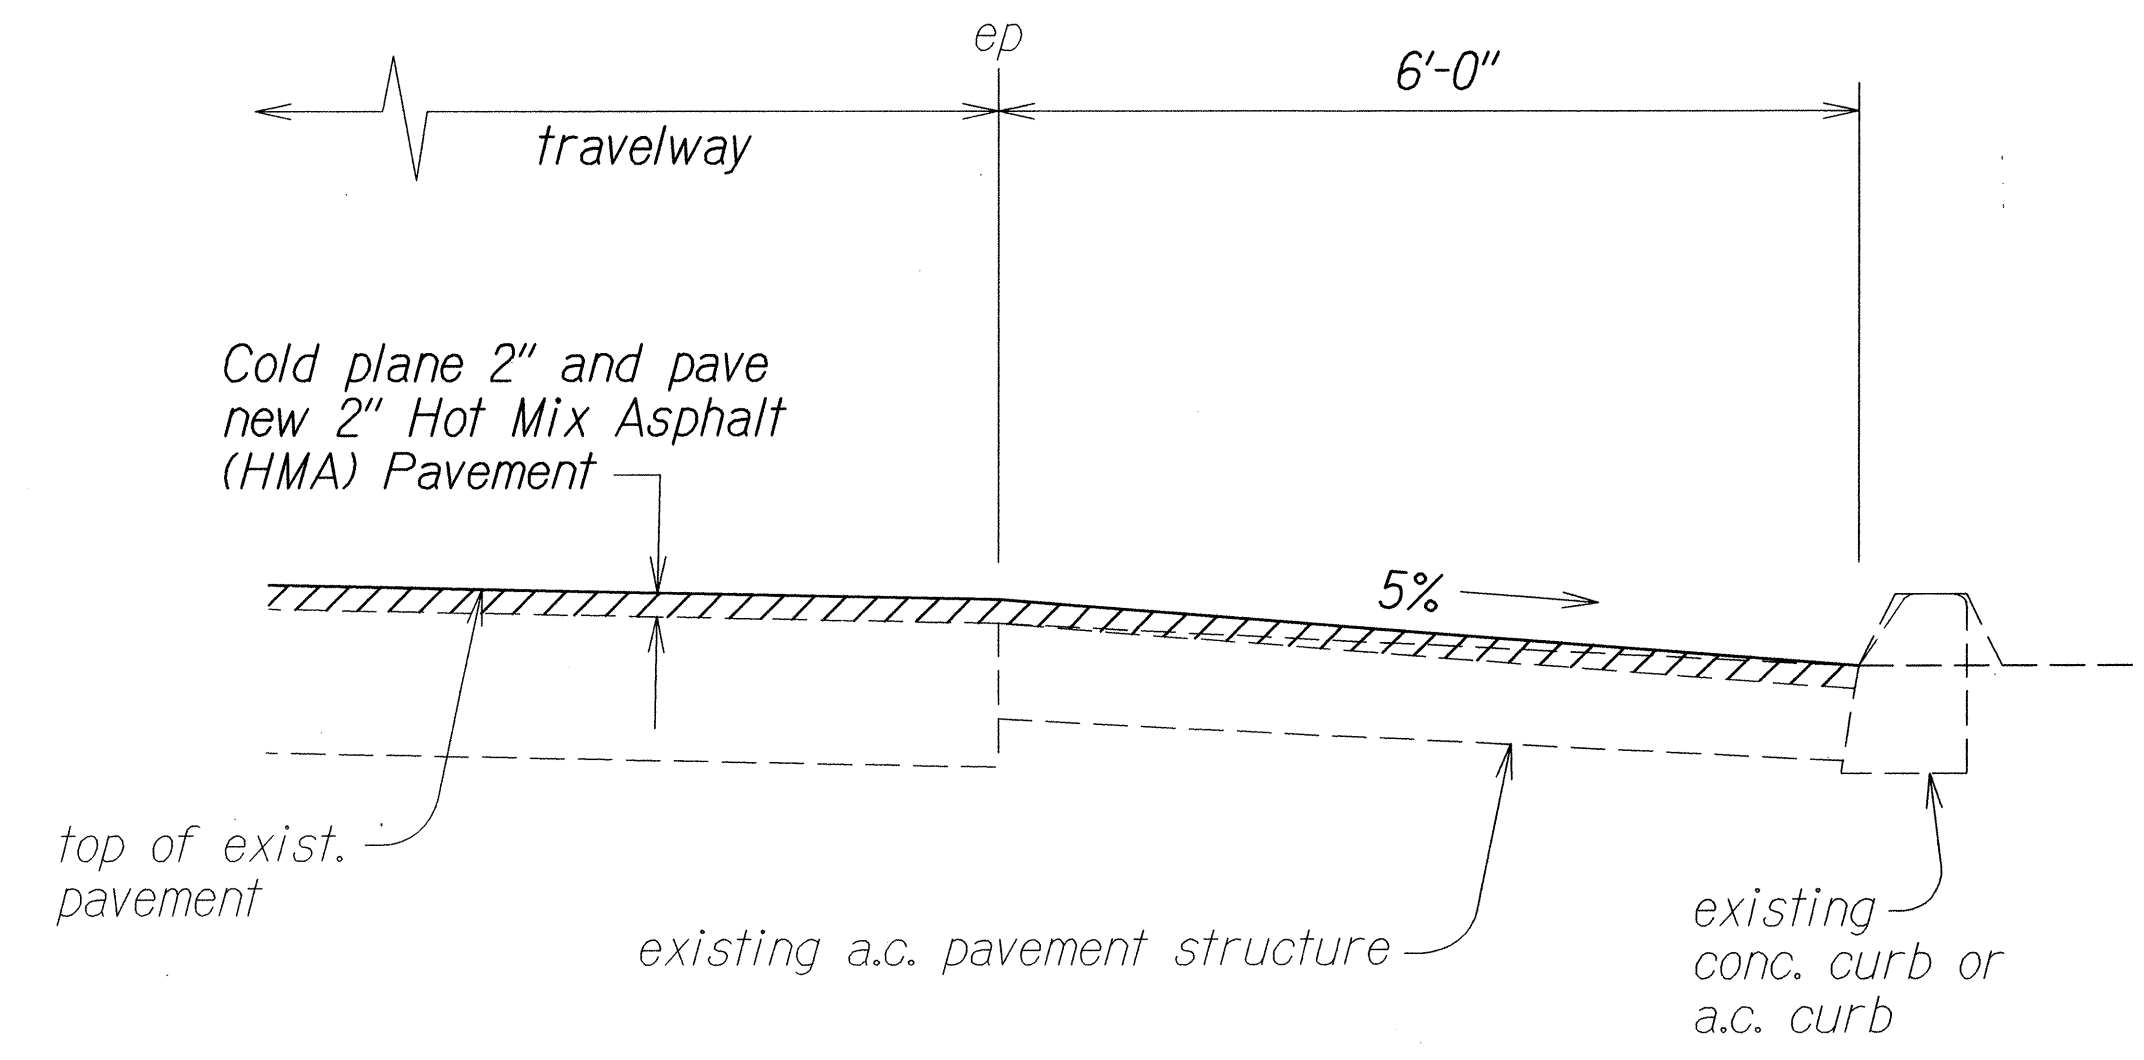


TYPICAL DETAIL COLD PLANING OF EXISTING A.C. PAVEMENT @ CONC. CURB, A.C. CURB, OR HEADER ROCK  
Scale:  $\frac{3}{4}$ " = 1'-0"

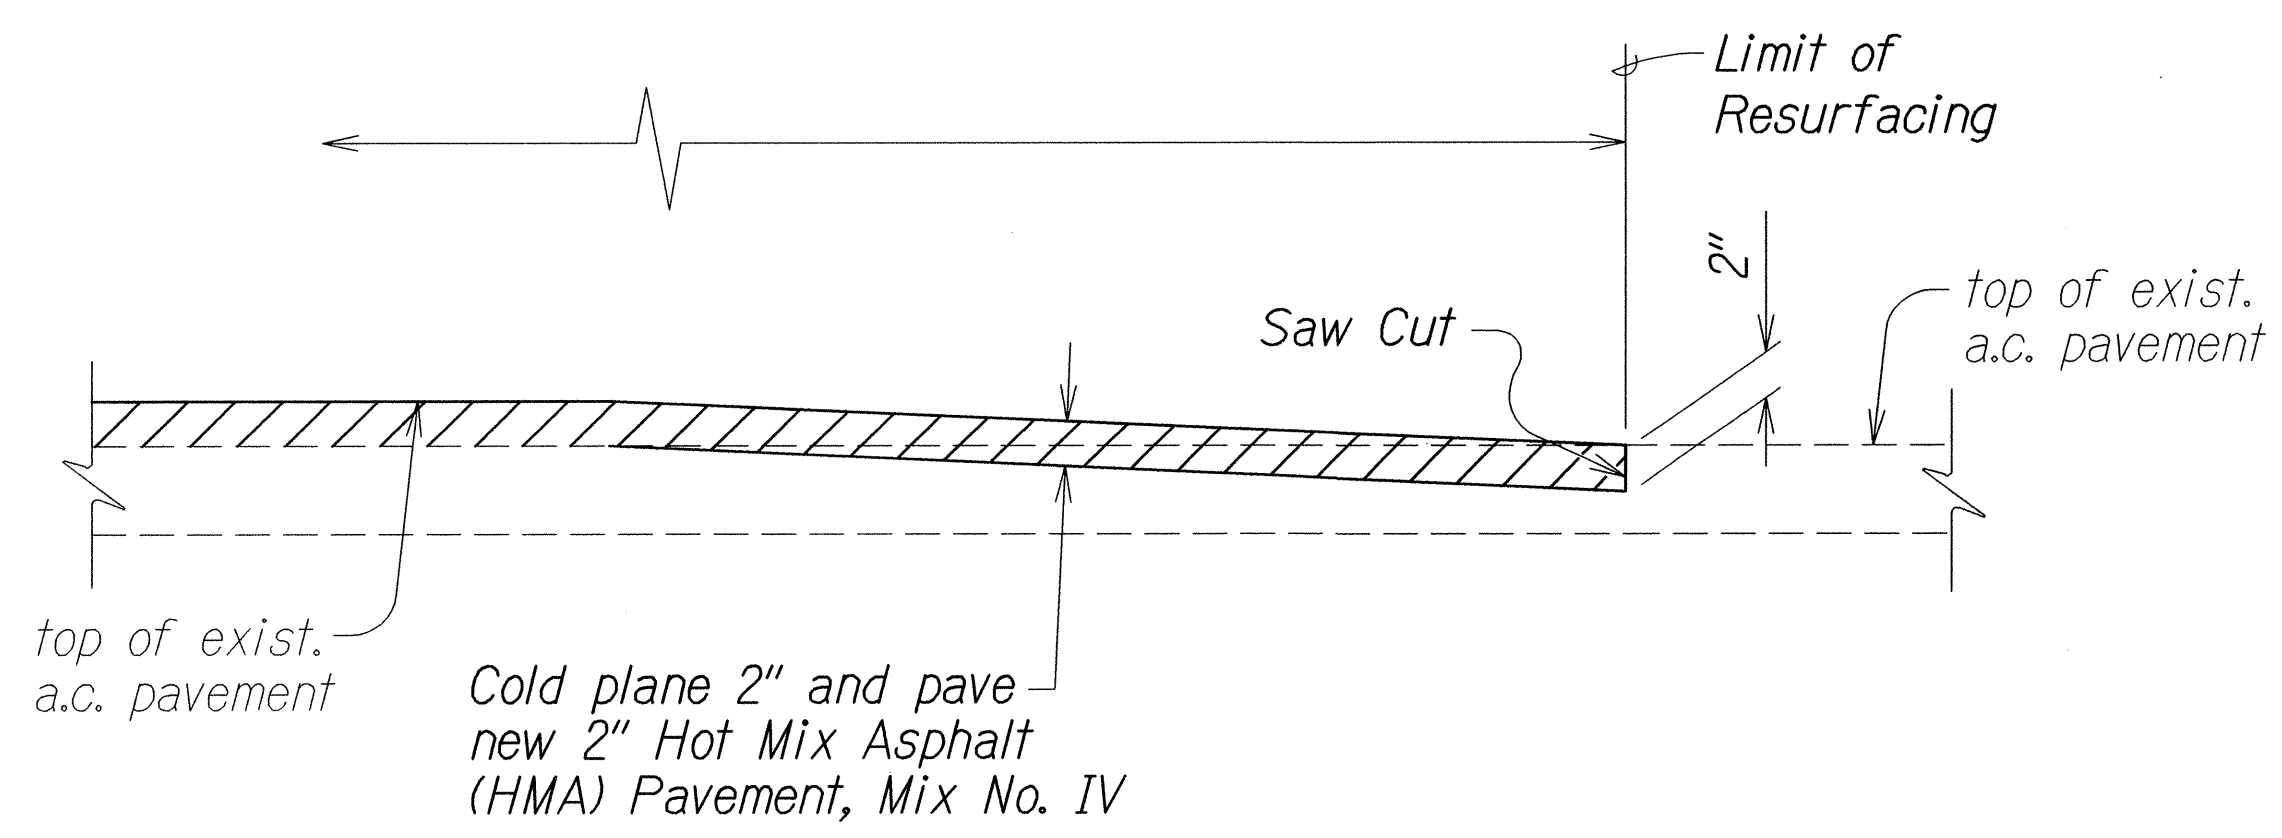

COLD PLANED LONGITUDINAL TRANSITION AT BEGIN AND END OF PROJECT  
Not to Scale

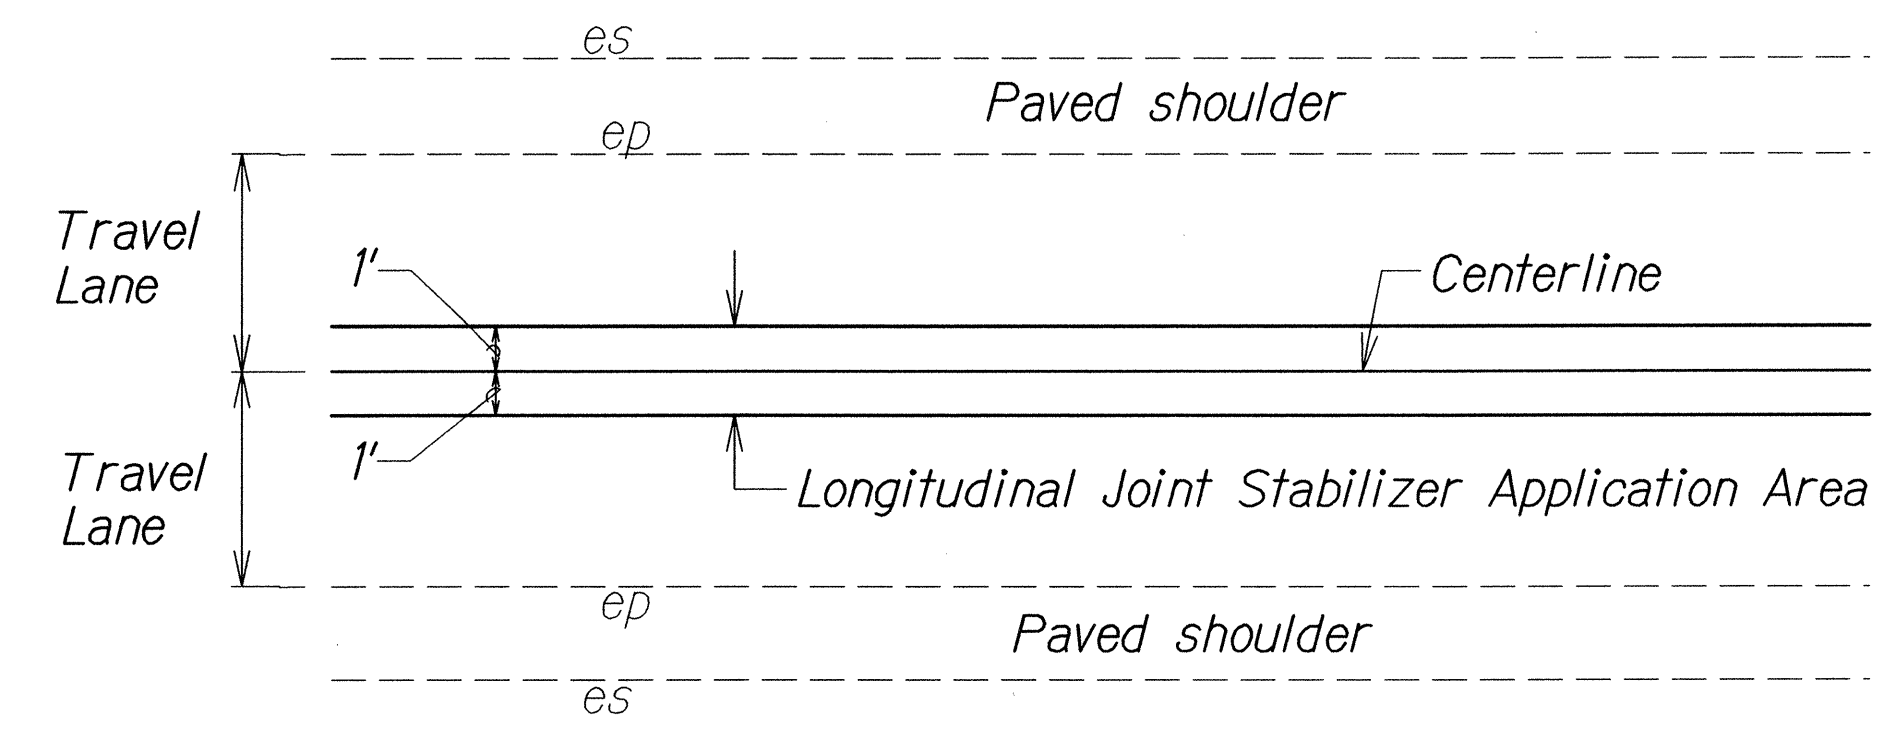

TYPICAL SECTION FOR LONGITUDINAL JOINT STABILIZER  
Not To Scale

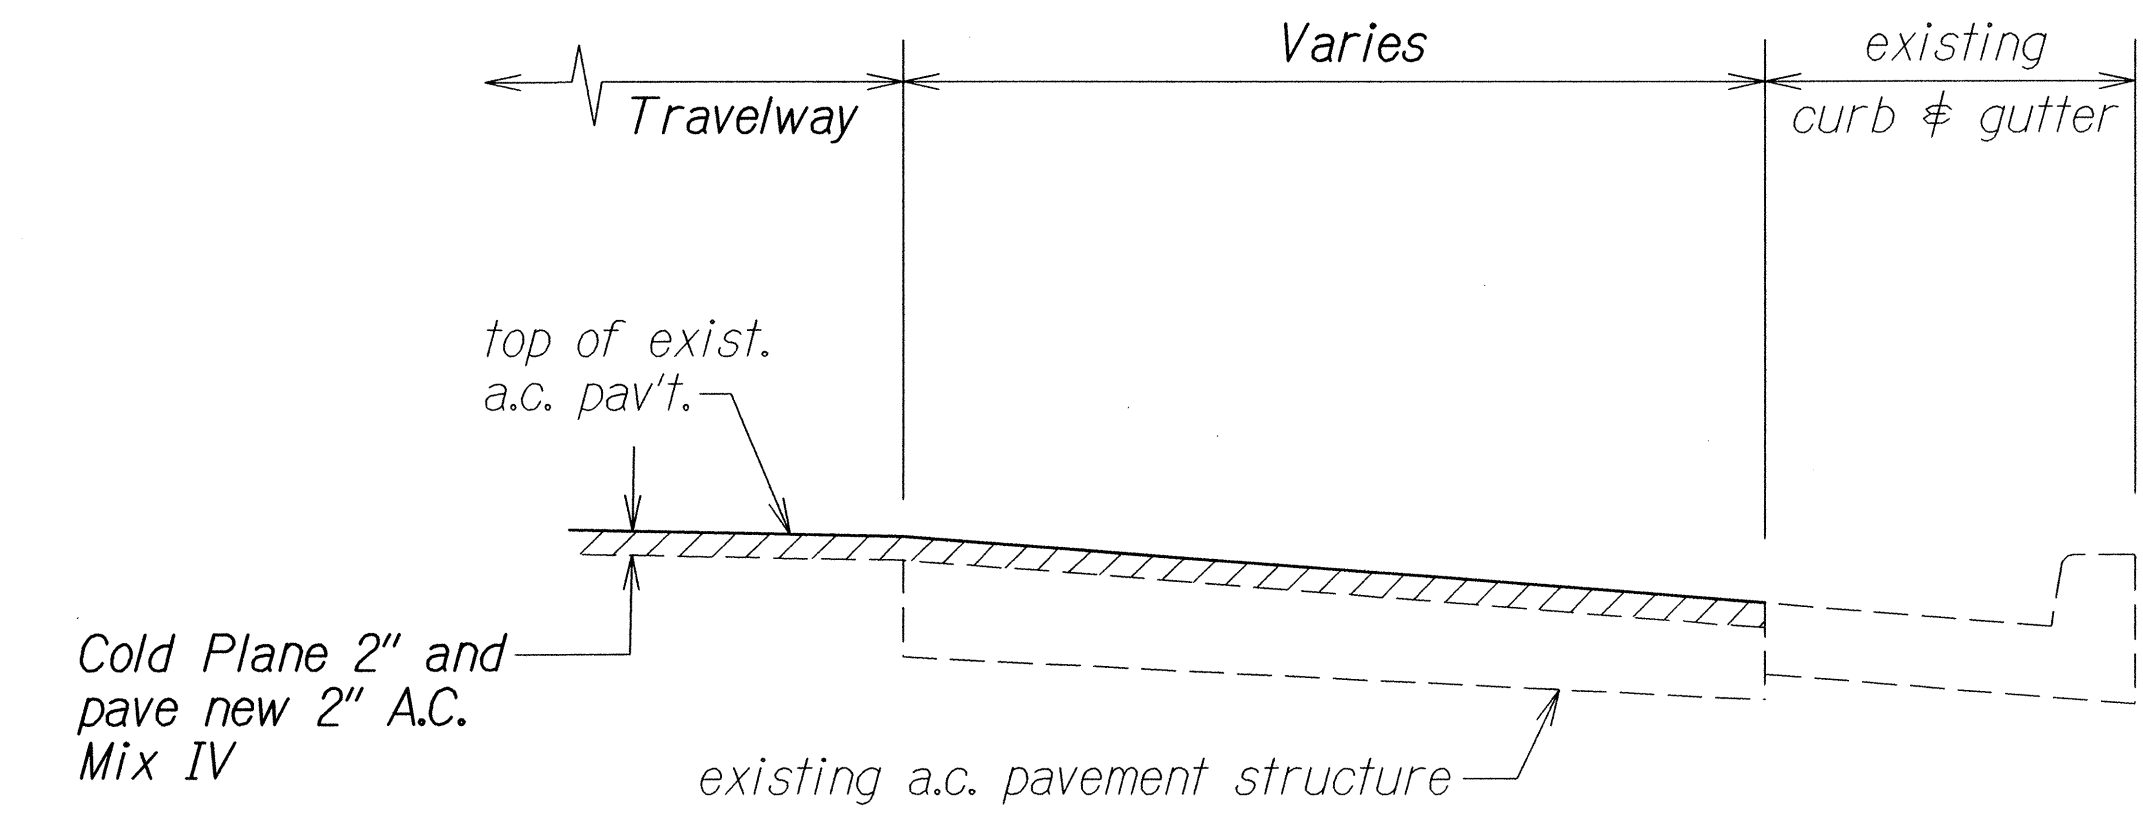

TYPICAL DETAIL - COLD PLANING OF EXISTING A.C. PAVEMENT @ CURB & GUTTER  
Scale:  $\frac{3}{4}$ " = 1'-0"

ORIGINAL PLAN	SURVEY PLOTTED BY	DATE
NOTE BOOK	DRAWN BY	
	DESIGNED BY	
	QUANTITIES BY	
	CHECKED BY	



STATE OF HAWAII  
DEPARTMENT OF TRANSPORTATION  
HIGHWAYS DIVISION

**TYPICAL SECTIONS & DETAILS**

MAIN STREET RESURFACING  
High Street to Kaahumanu Avenue and  
KAAHUMANU AVENUE RESURFACING  
Main Street to Hobron Avenue  
Federal-Aid Project No. NH-032-1(010)  
Scale: As Shown Date: July, 2014


SHEET No. 1 OF 8 SHEETS

FED. ROAD DIST. NO.	STATE	FED. AID PROJ. NO.	FISCAL YEAR	SHEET NO.	TOTAL SHEETS
HAWAII	HAW.	NH-032-1(010)	2014	ADD.8	51

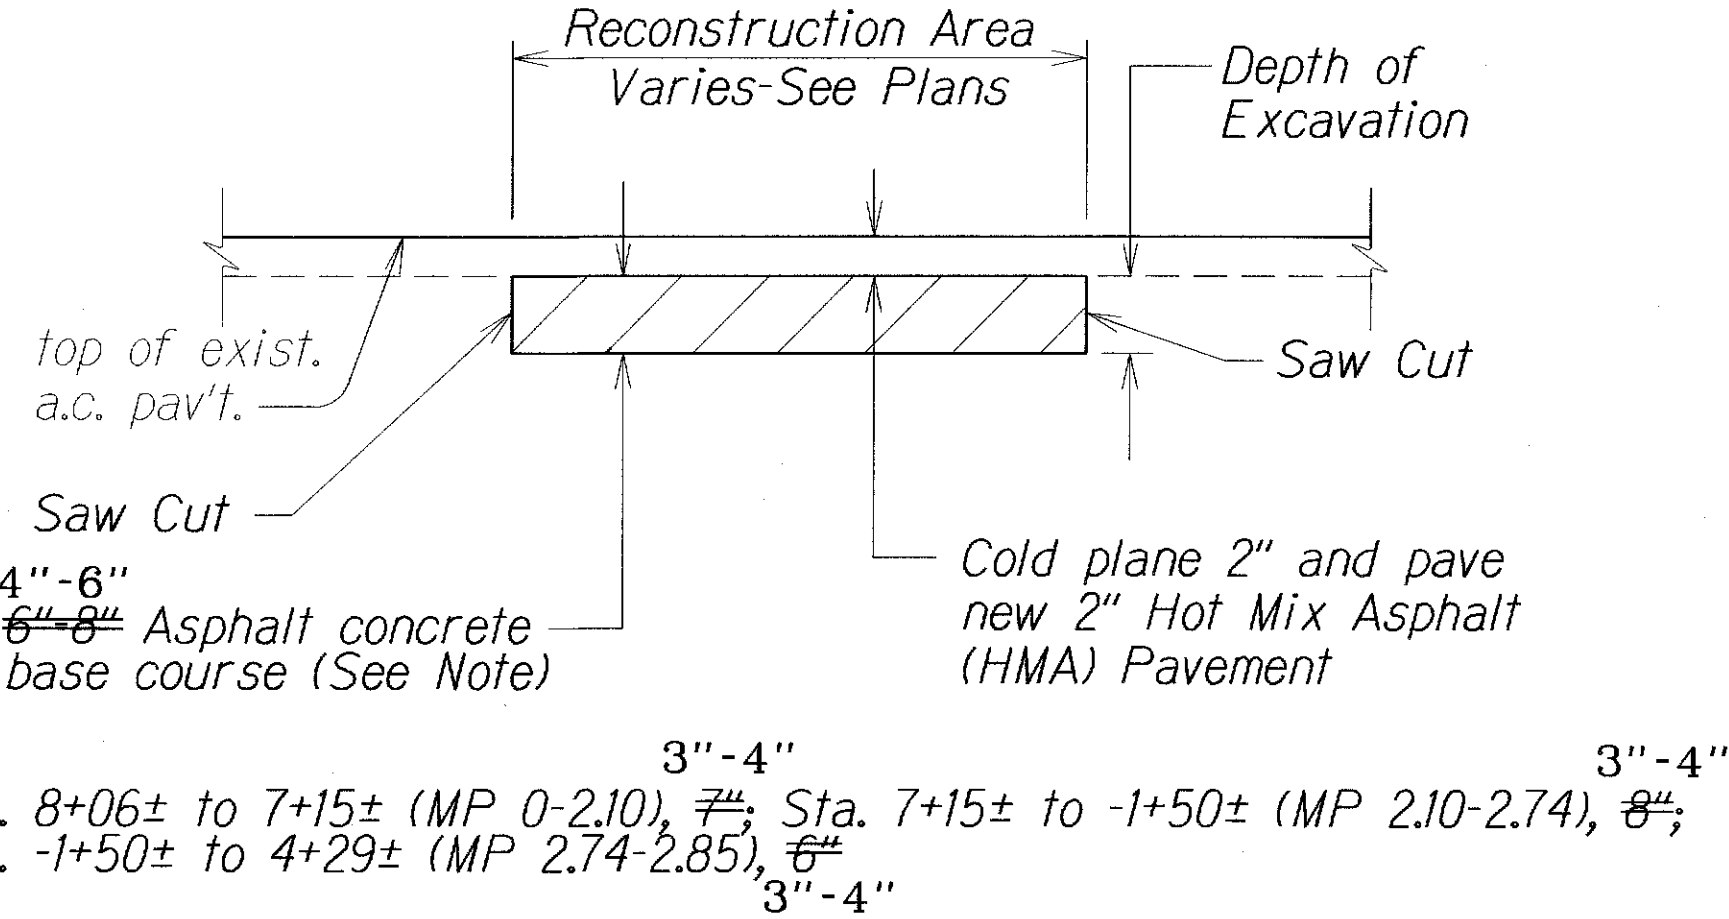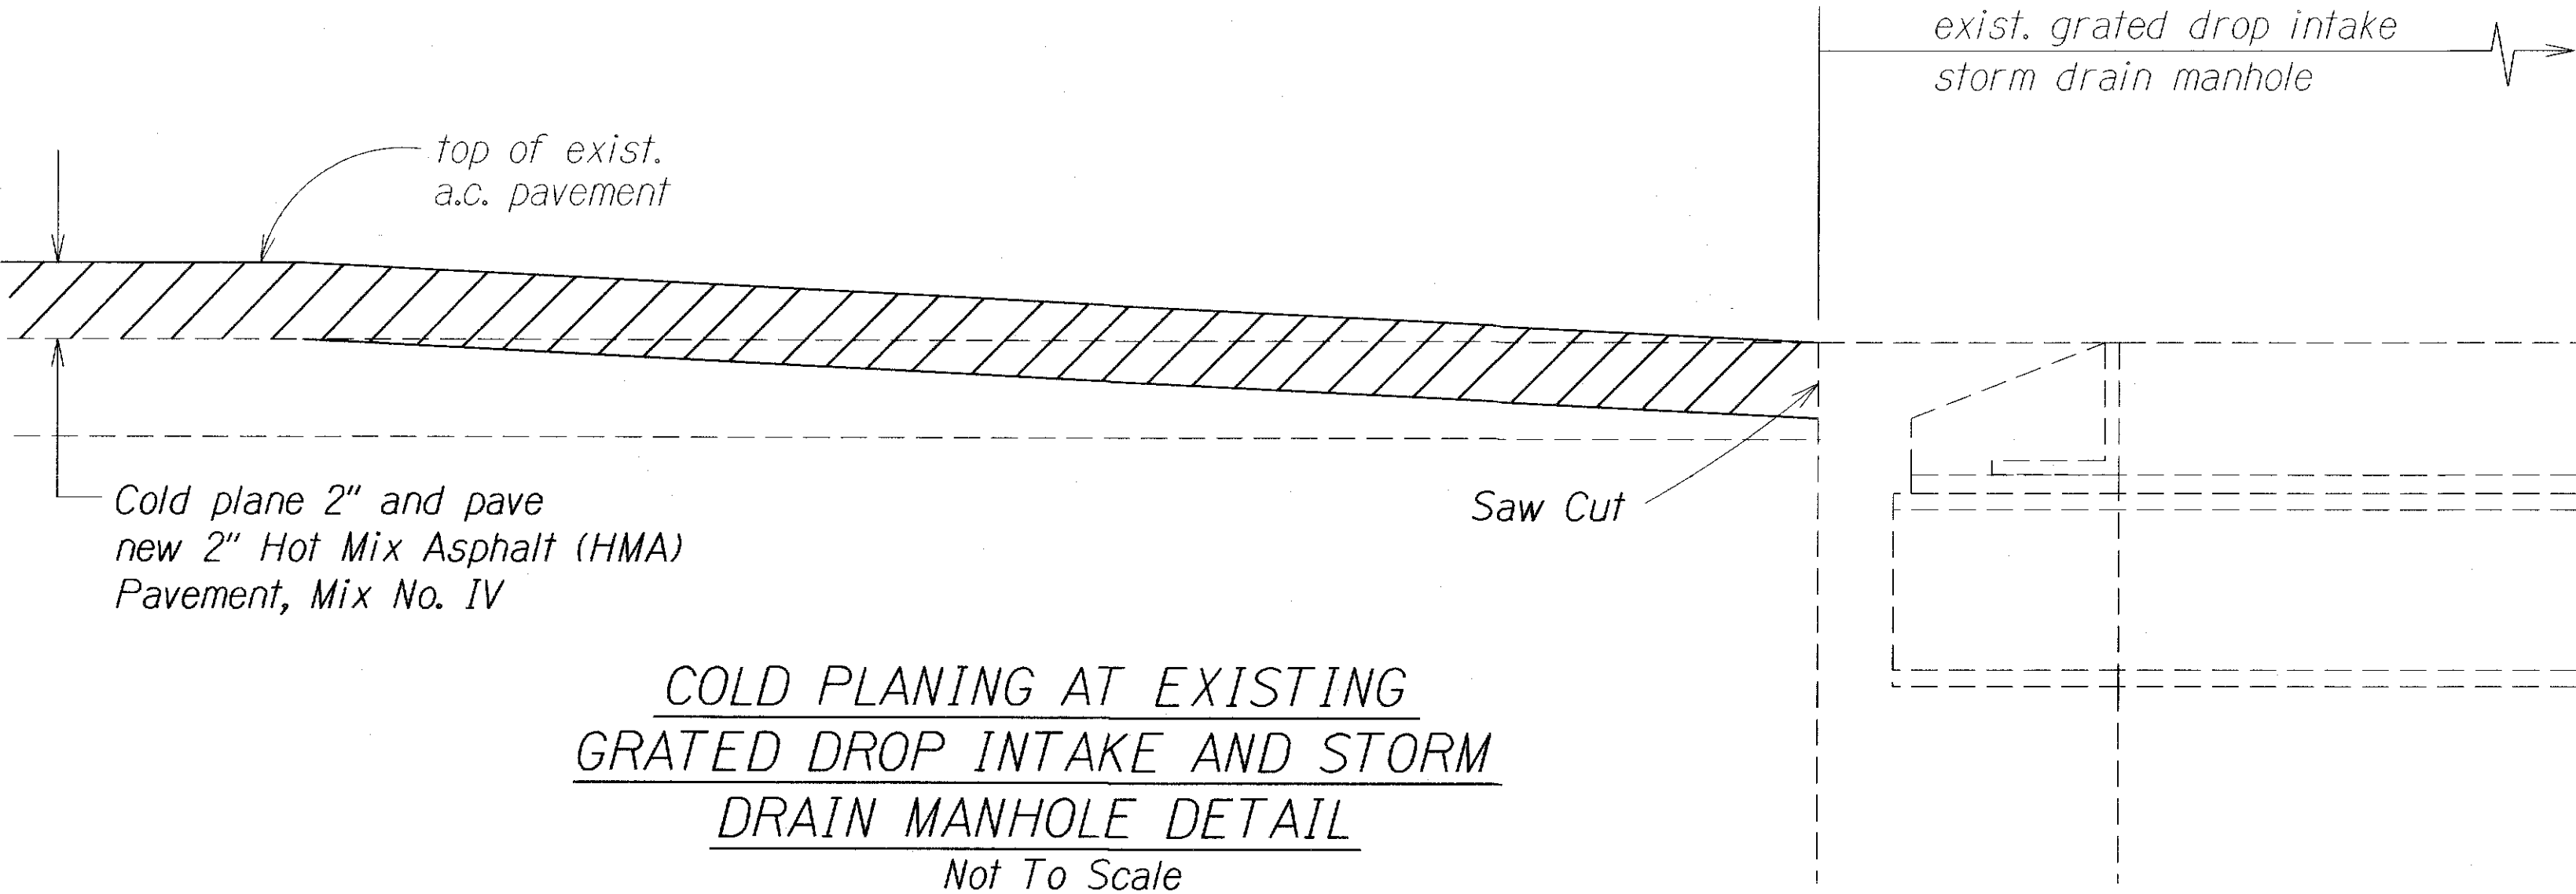


Note: Sta. 8+06± to 7+15± (MP 0-2.10), Sta. 7+15± to -1+50± (MP 2.10-2.74), Sta. -1+50± to 4+29± (MP 2.74-2.85), Sta. 4+29± to 5+00± (MP 2.85-3.00)

A.C. PAVEMENT RECONSTRUCTION DETAIL  
Not To Scale

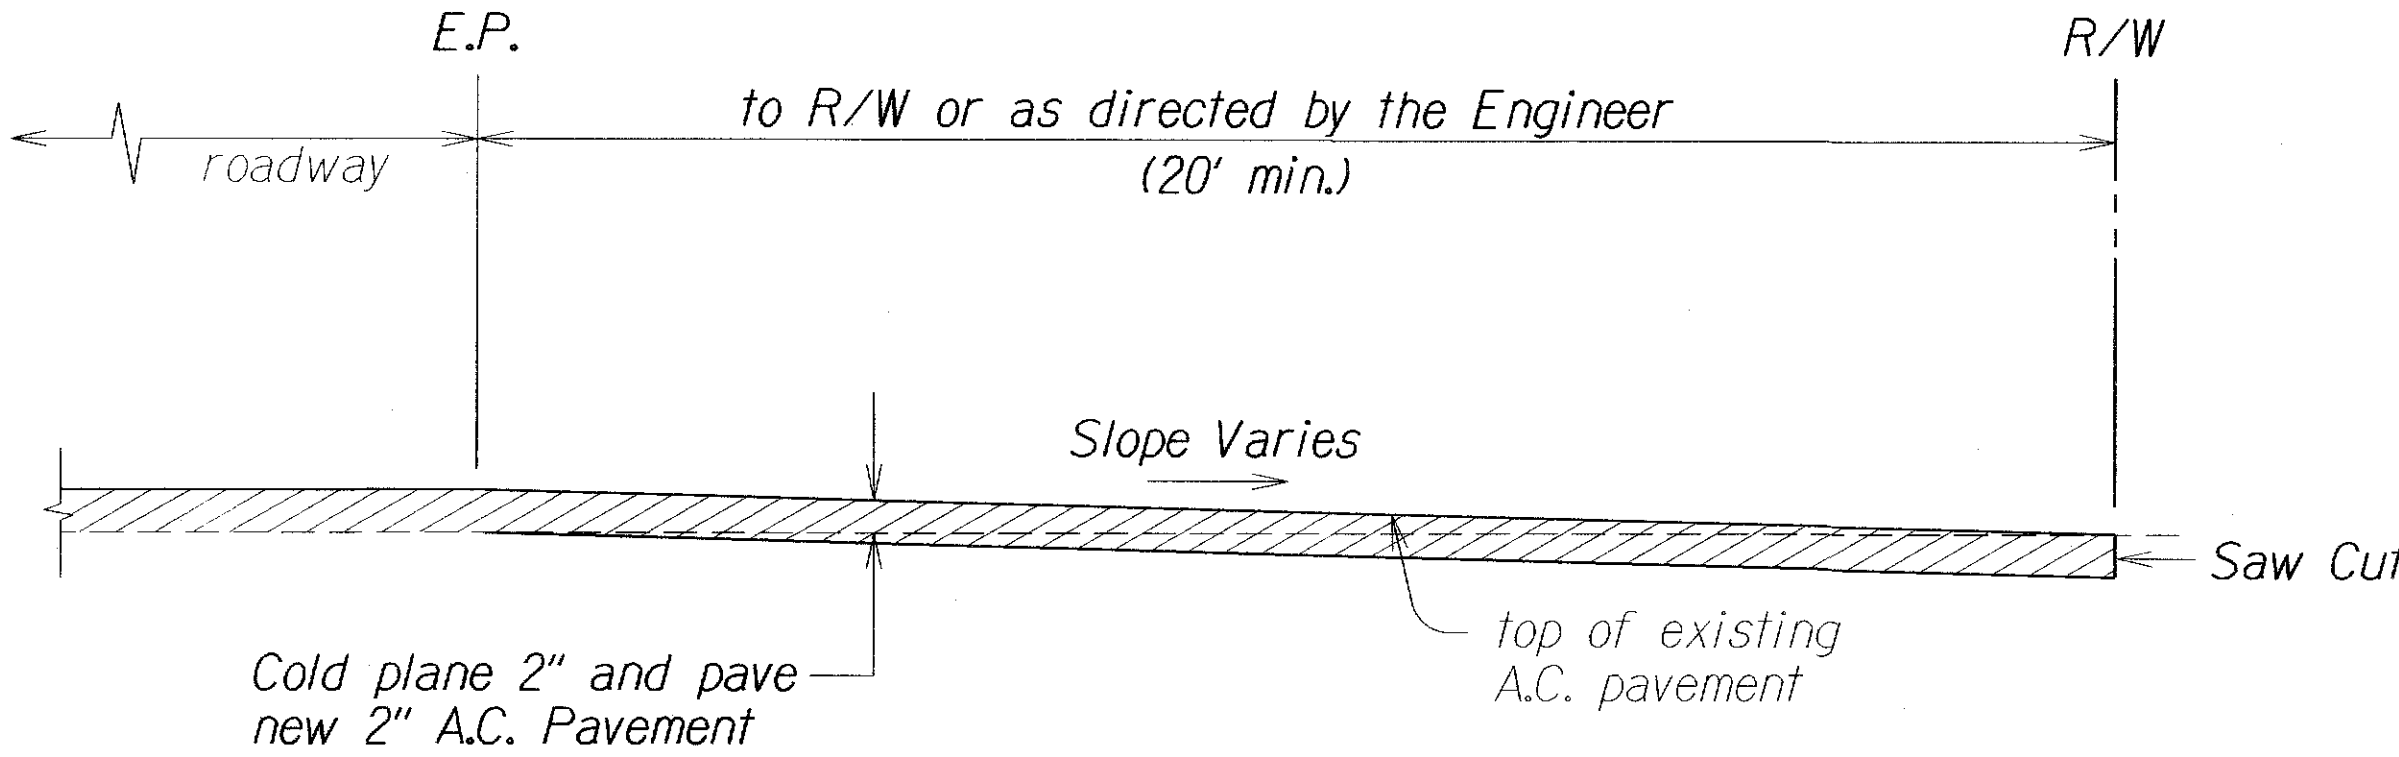


COLD PLANED TRANSITION TO EXISTING PAVED SIDE ROAD DETAIL  
Not To Scale

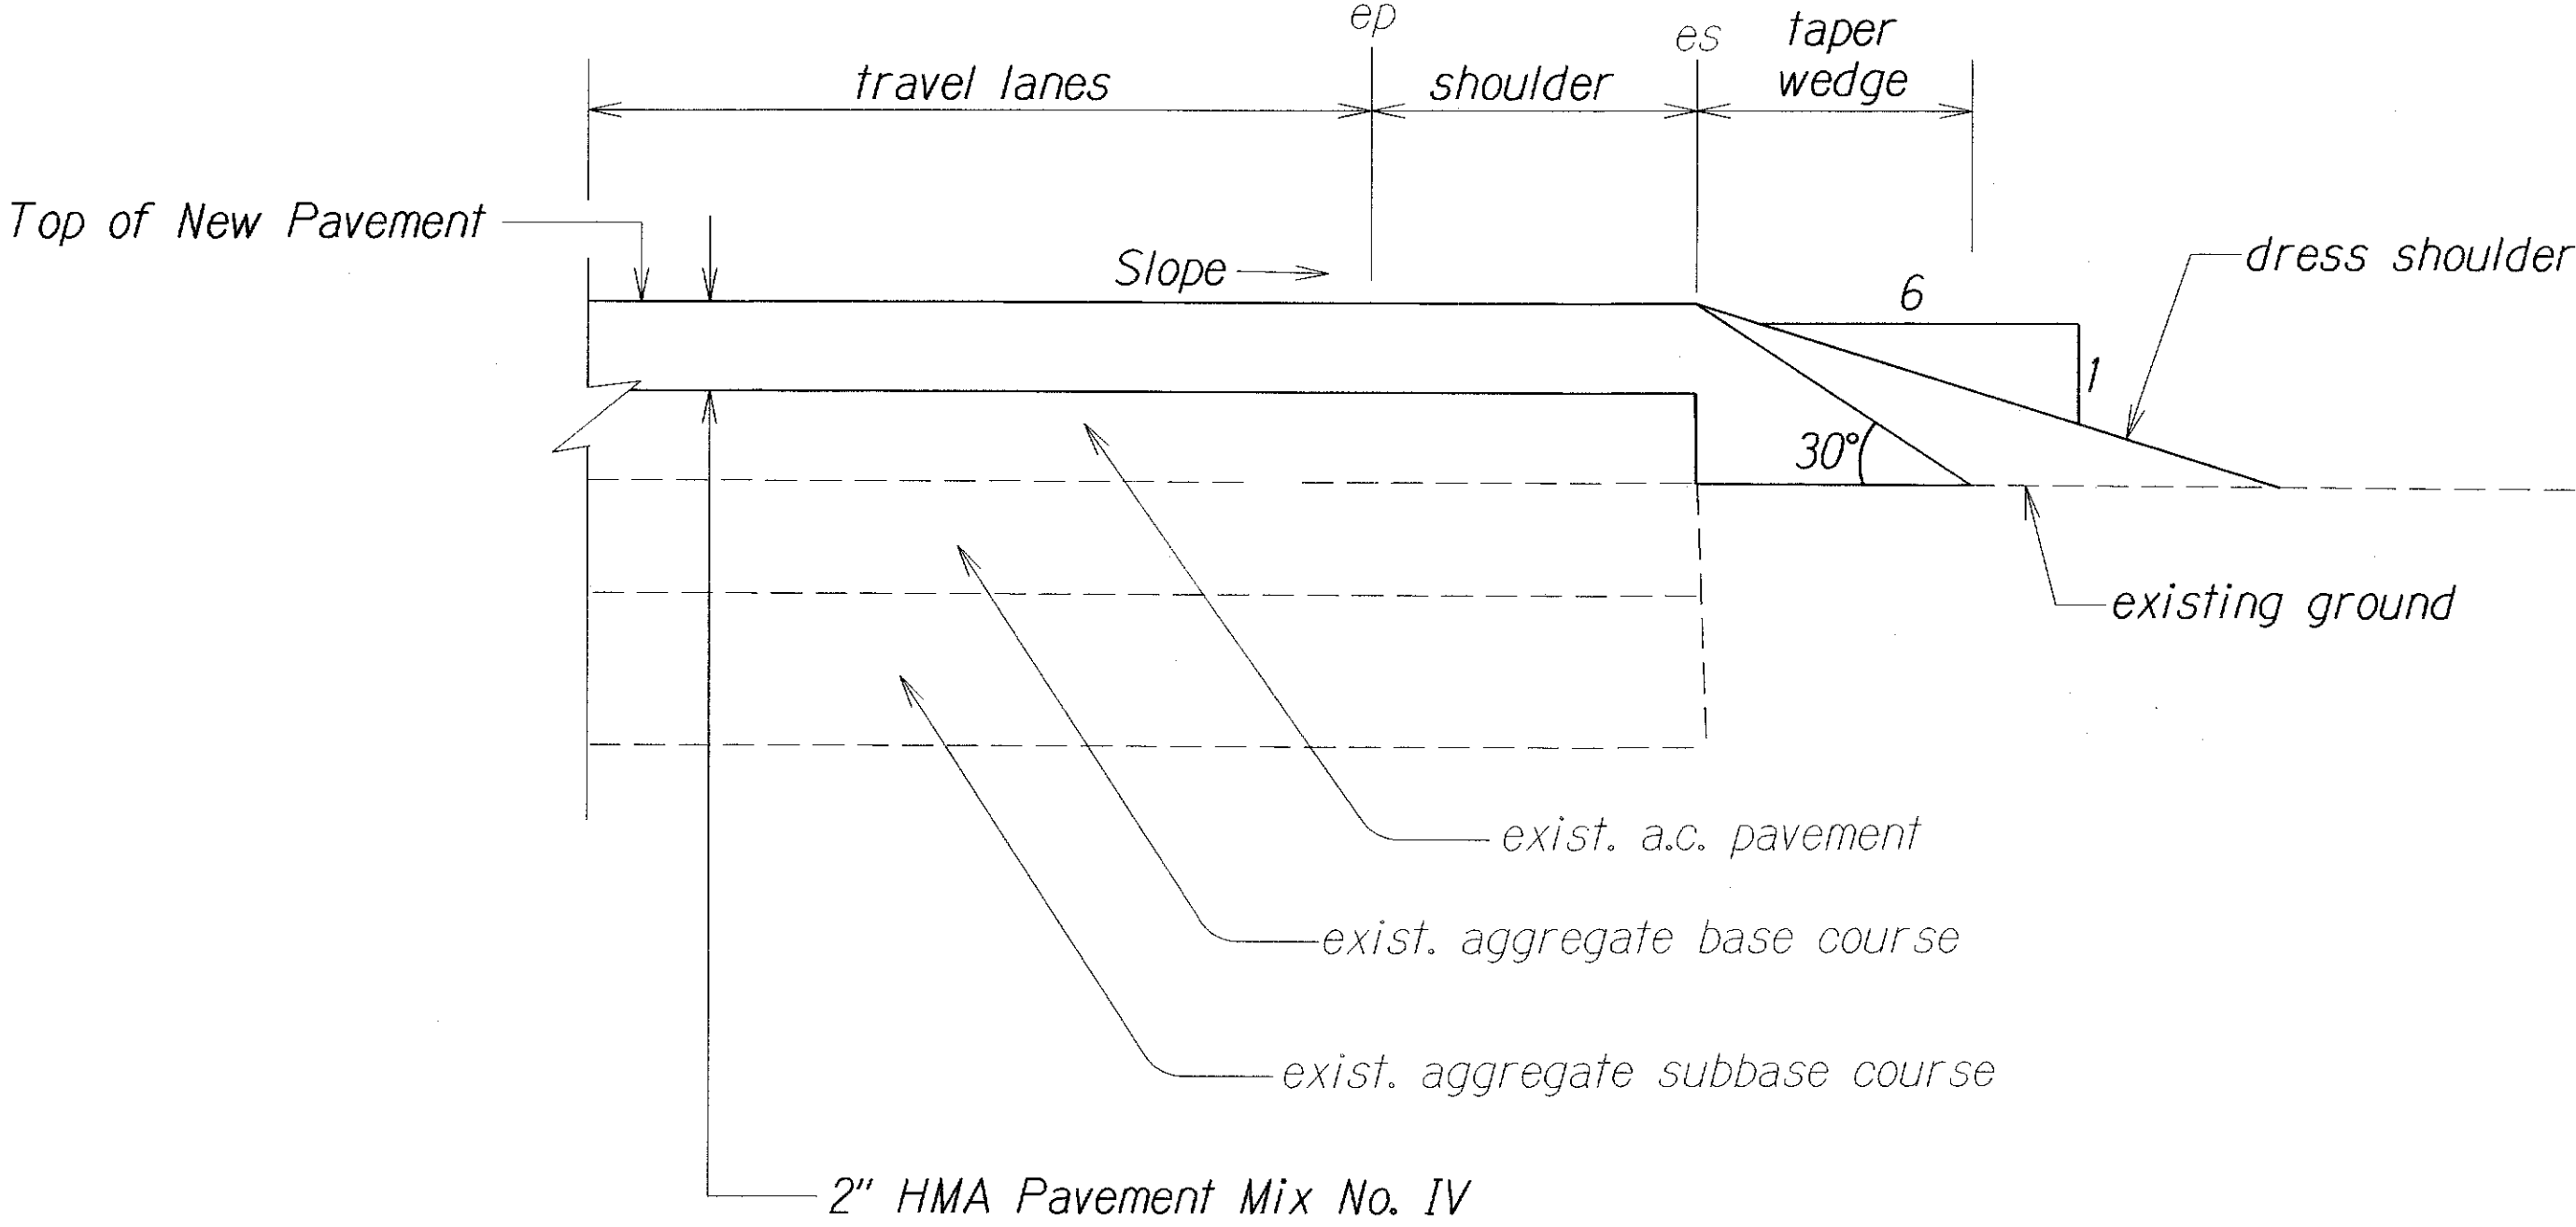

Note: Contractor shall mount a device directly on the paver screed extension to provide a 30° beveled shoulder edge.

TYPICAL PAVEMENT EDGE DETAIL (FOR OVERLAYING PROJECT)  
Not To Scale

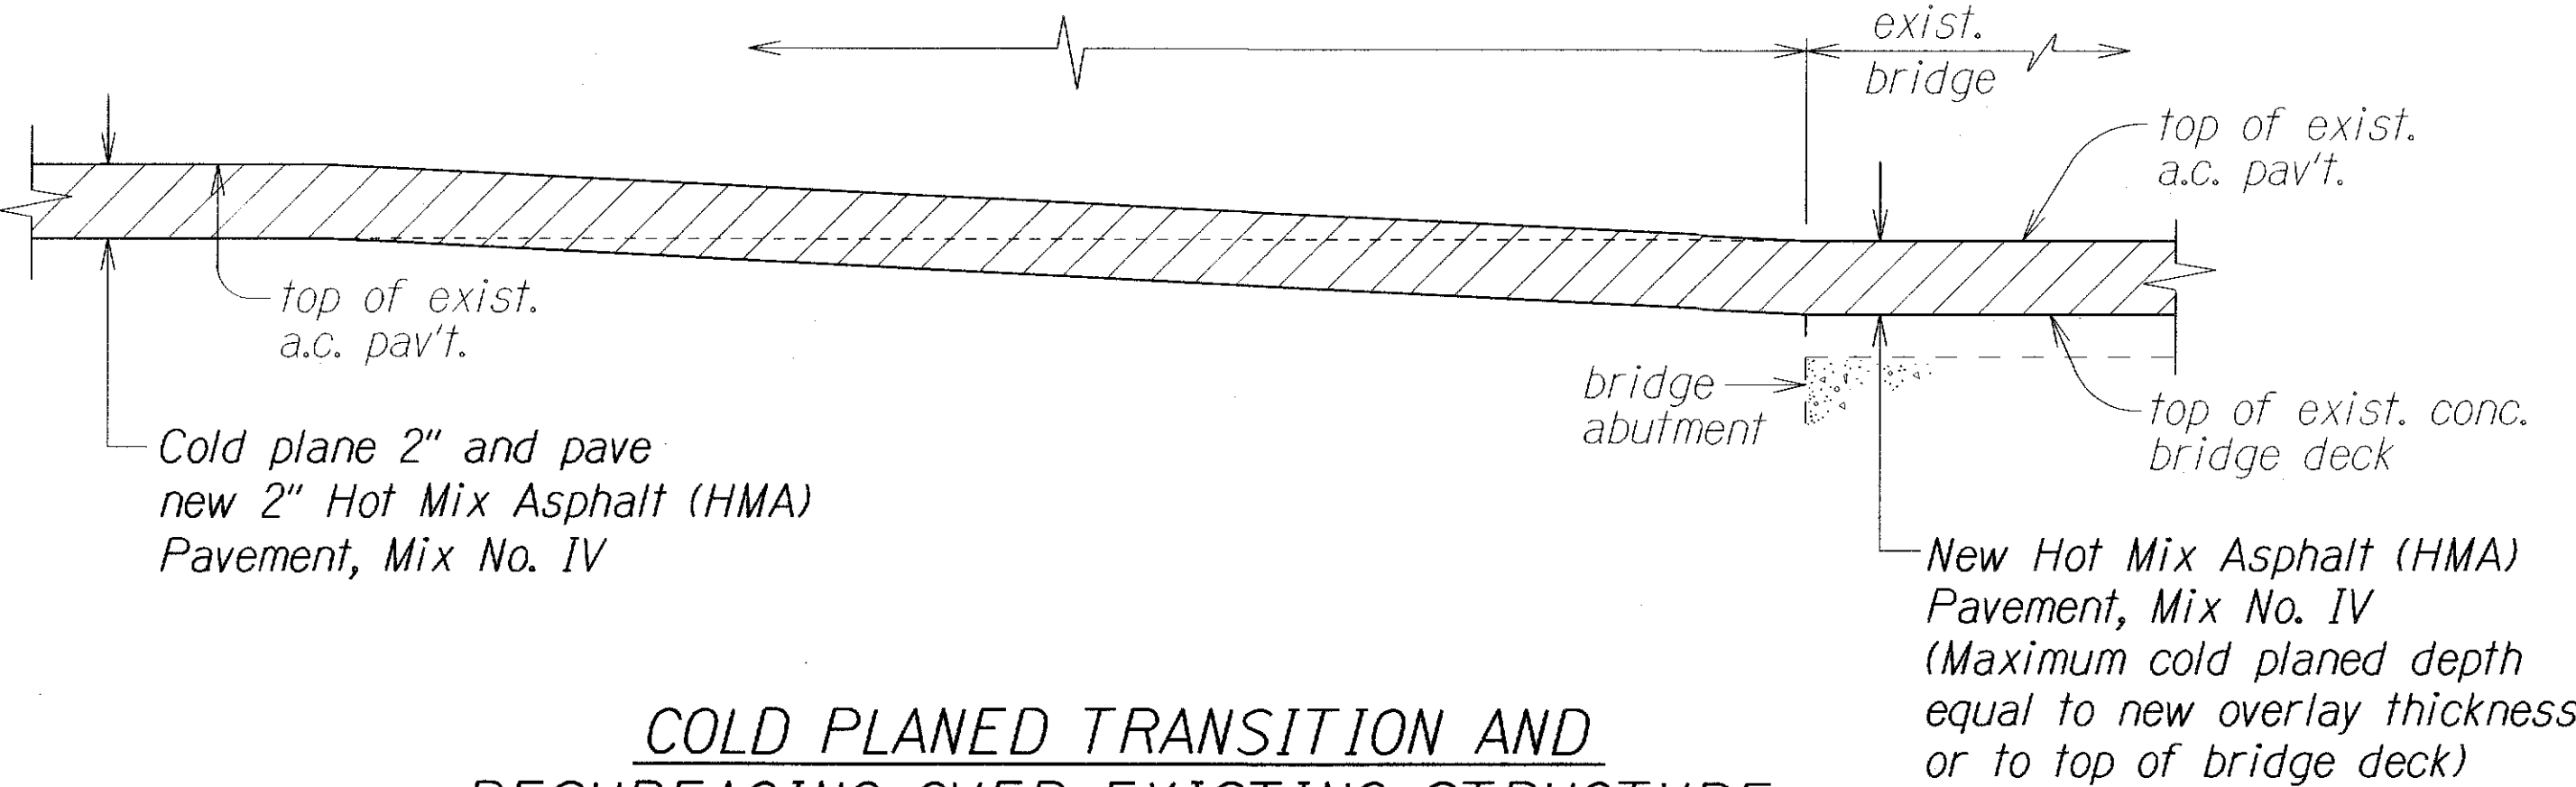

COLD PLANED TRANSITION AND RESURFACING OVER EXISTING STRUCTURE  
Not To Scale

LEGEND FOR AS-BUILT POSTINGS	
	Squiggly line for as-built deletion
	Double line for as-built deletion
	Text for as-built posting


Note: Contractor shall mount a device directly on the paver screed extension to provide a 30° beveled shoulder edge.

DATE	REVISION
12/8/14	Revised Note to include Sta.


STATE OF HAWAII DEPARTMENT OF TRANSPORTATION HIGHWAYS DIVISION	
TYPICAL SECTIONS & DETAILS	
MAIN STREET RESURFACING	
High Street to Kaahumanu Avenue and KAAHUMANU AVENUE RESURFACING	
Main Street to Hobron Avenue	
Federal-Aid Project No. NH-032-1(010)	
Scale: As Shown Date: July, 2014	
SHEET No. 2 OF 8 SHEETS	

"AS-BUILT"

ADD. 8

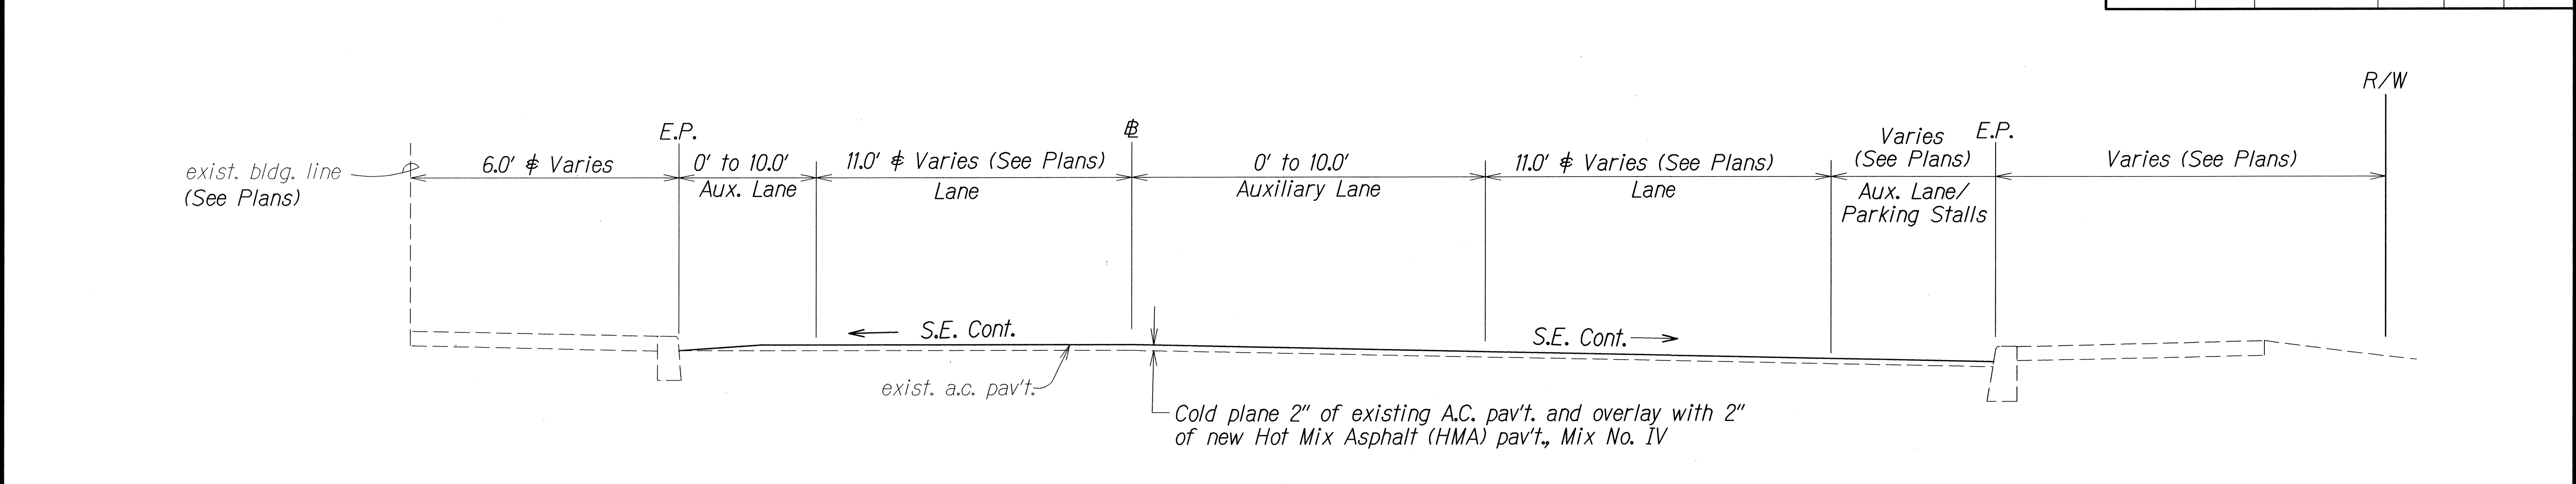

MAIN STREET  
Sta. 8+06.93± to Sta. 25+00±  
Scale: 1/2"=1'-0"

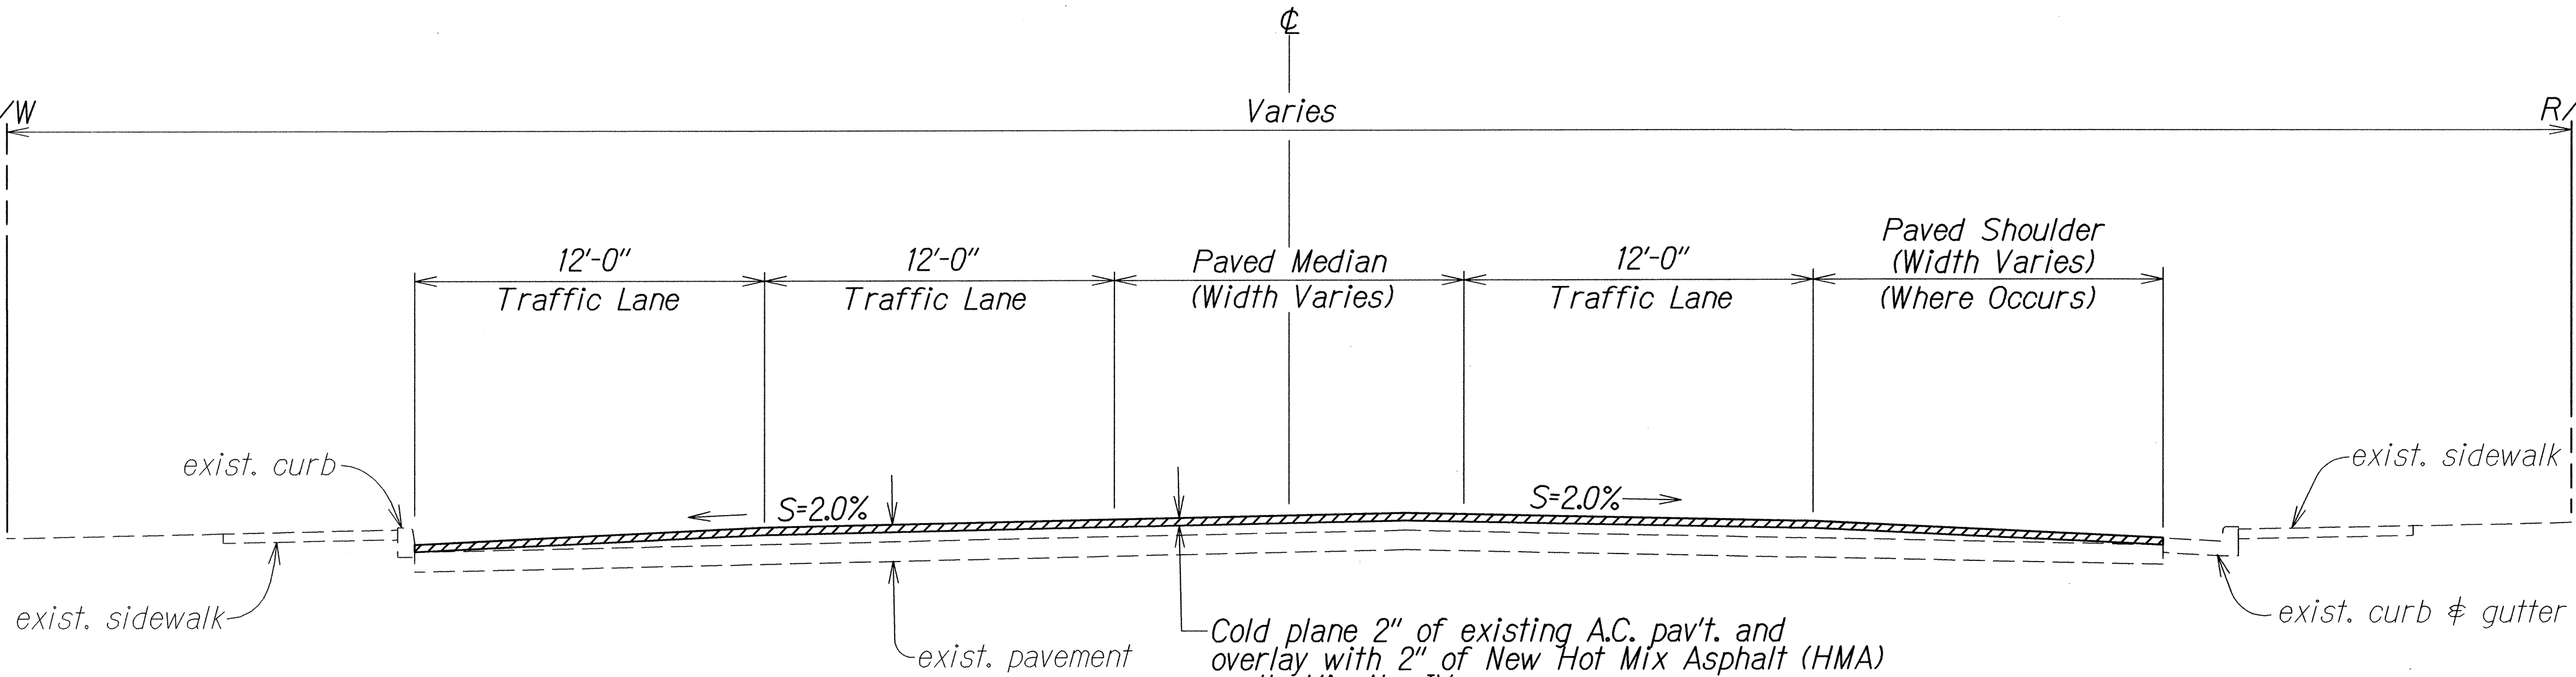

TYPICAL SECTION - CENTRAL AVE. TO KINIPOPO STREET  
Scale:  $\frac{1}{4}" = 1'-0"$

ORIGINAL PLAN	SURVEY PLOTTED BY _____	DATE _____
NOTE BOOK <i>dx dx</i> <i>x dgn</i>	DRAWN BY <i>x</i>	• <i>x</i>
	TRACED BY _____	•
	DESIGNED BY <i>x</i>	•
	QUANTITIES BY _____	•
N <sub>4</sub>	CHECKED BY _____	•

STATE OF HAWAII  
DEPARTMENT OF TRANSPORTATION  
HIGHWAYS DIVISION

**TYPICAL SECTIONS & DETAILS**


**MAIN STREET RESURFACING**

High Street to Kaahumanu Avenue and  
**KAAHUMANU AVENUE RESURFACING**


Main Street to Hobron Avenue  
**Federal-Aid Project No. NH-032-1(K010)**

Scale: As Shown      Date: July, 2014

FED. ROAD DIST. NO.	STATE	FED. AID PROJ. NO.	FISCAL YEAR	SHEET NO.	TOTAL SHEETS
HAWAII	HAW.	NH-032-1(010)	2014	10	51

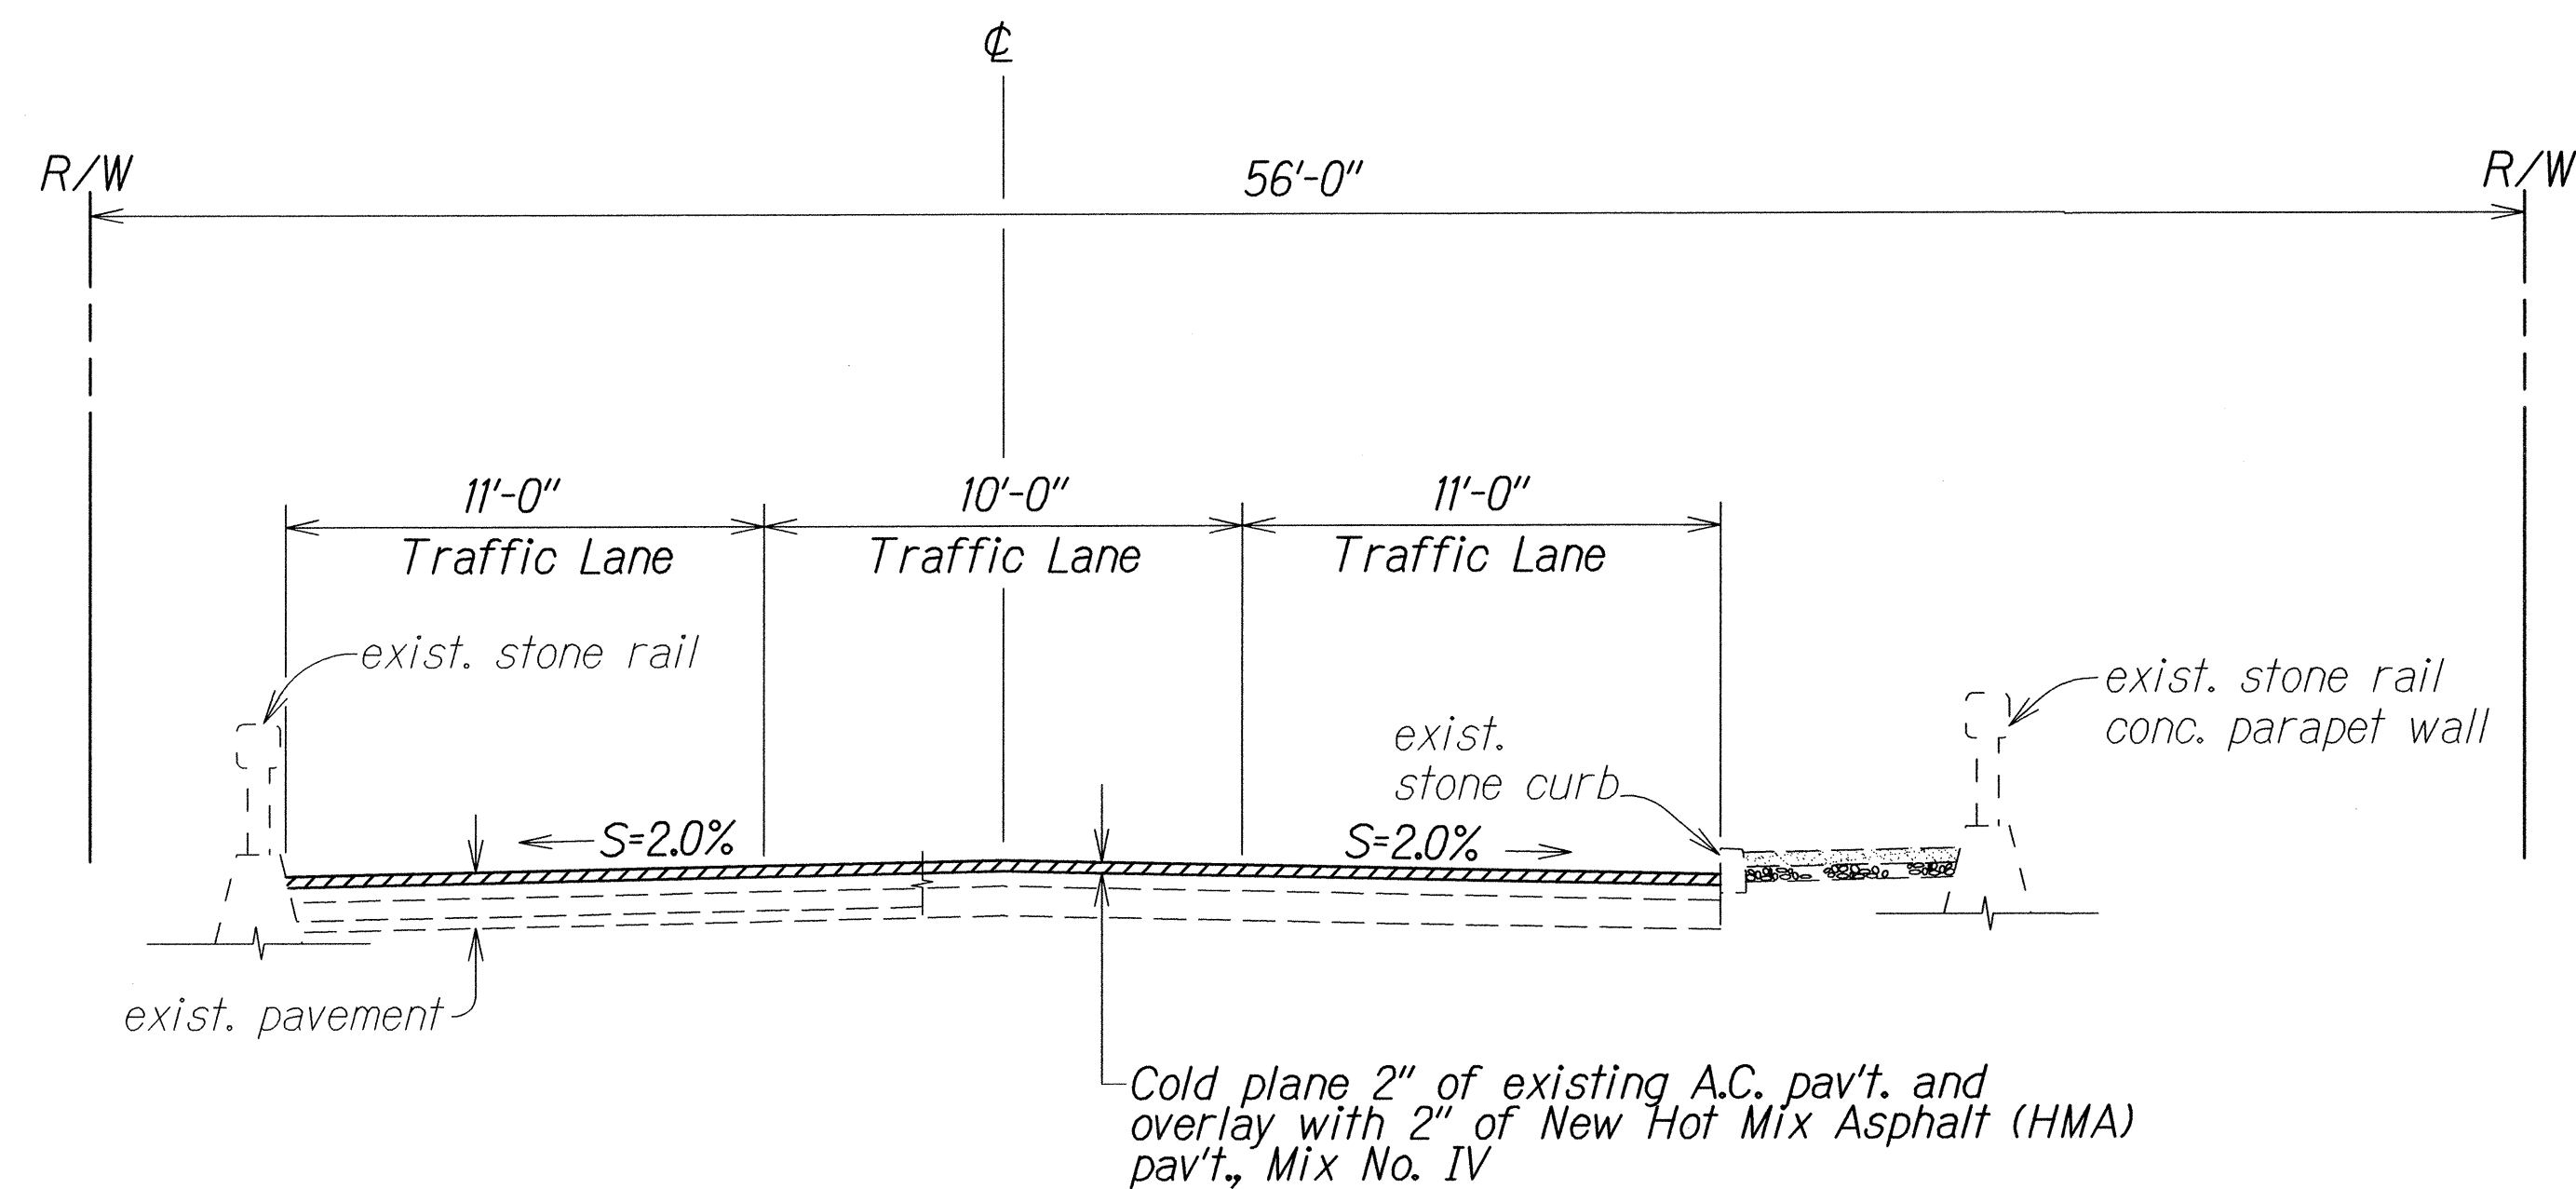

**TYPICAL SECTION - KINIPOPO STREET TO NANIHOA DRIVE**  
Scale: 1/4" = 1'-0"

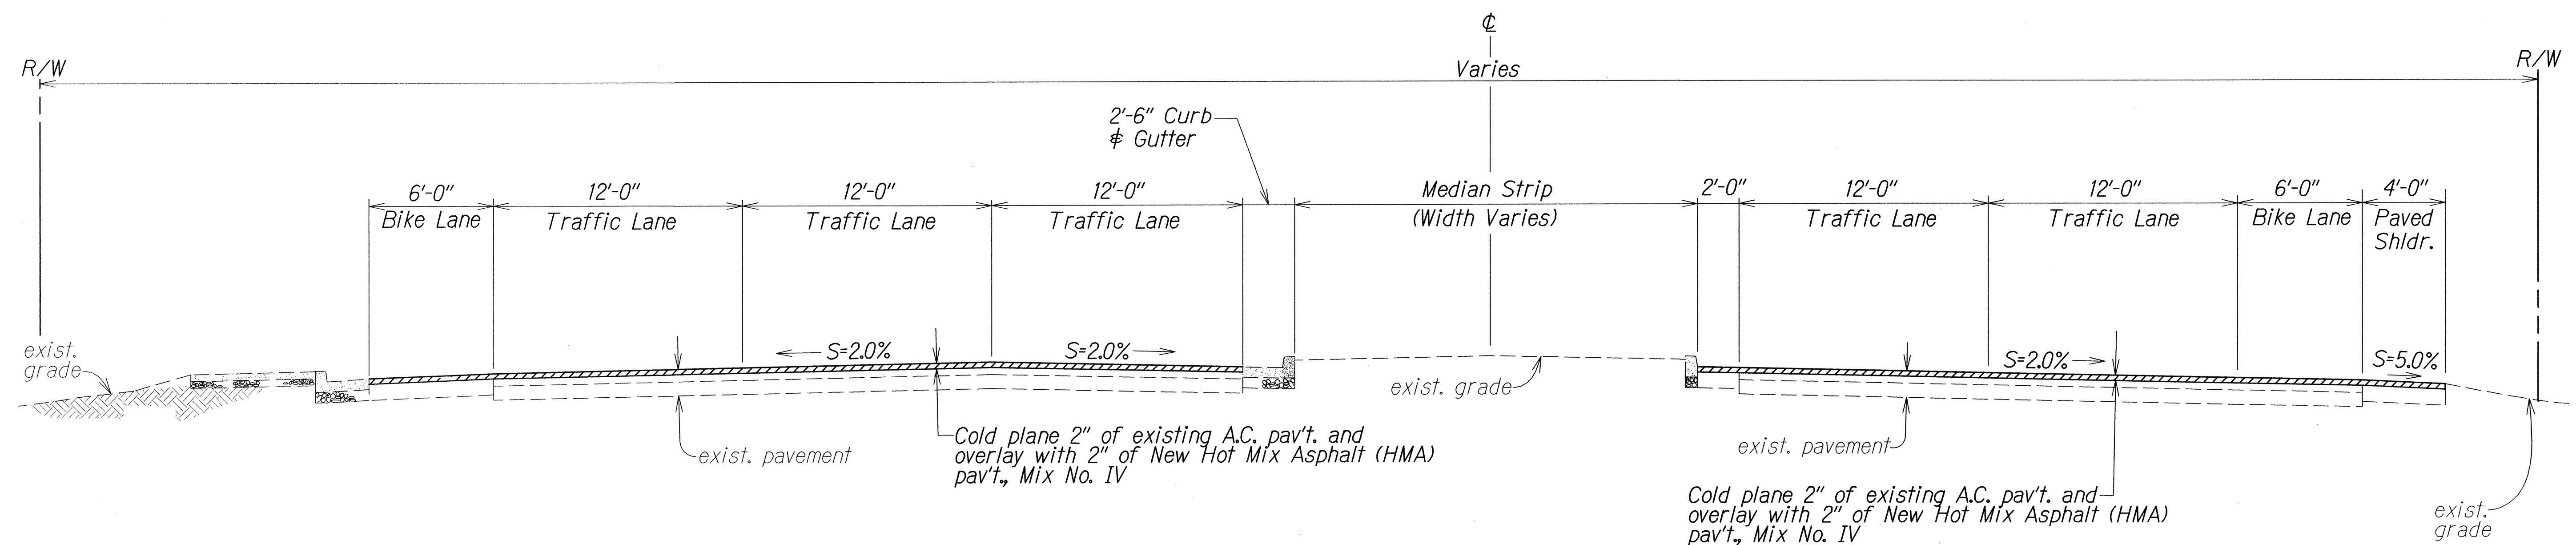


**TYPICAL SECTION - NANIHOA DRIVE TO LUNALILO STREET**  
Scale: 1/4" = 1'-0"

DESIGNED BY	DATE
DRAWN BY	
CHECKED BY	
IN CHARGE	
NOTED	
DATE	


STATE OF HAWAII DEPARTMENT OF TRANSPORTATION HIGHWAYS DIVISION
<b>TYPICAL SECTIONS &amp; DETAILS</b>
MAIN STREET RESURFACING High Street to Kaahumanu Avenue and KAAHUMANU AVENUE RESURFACING Main Street to Hobron Avenue Federal-Aid Project No. NH-032-1(010) Scale: As Shown Date: July, 2014
SHEET No. 4 OF 8 SHEETS



FED. ROAD DIST. NO.	STATE	FED. AID PROJ. NO.	FISCAL YEAR	SHEET NO.	TOTAL SHEETS
HAWAII	HAW.	NH-032-1(010)	2014	ADD.11	51

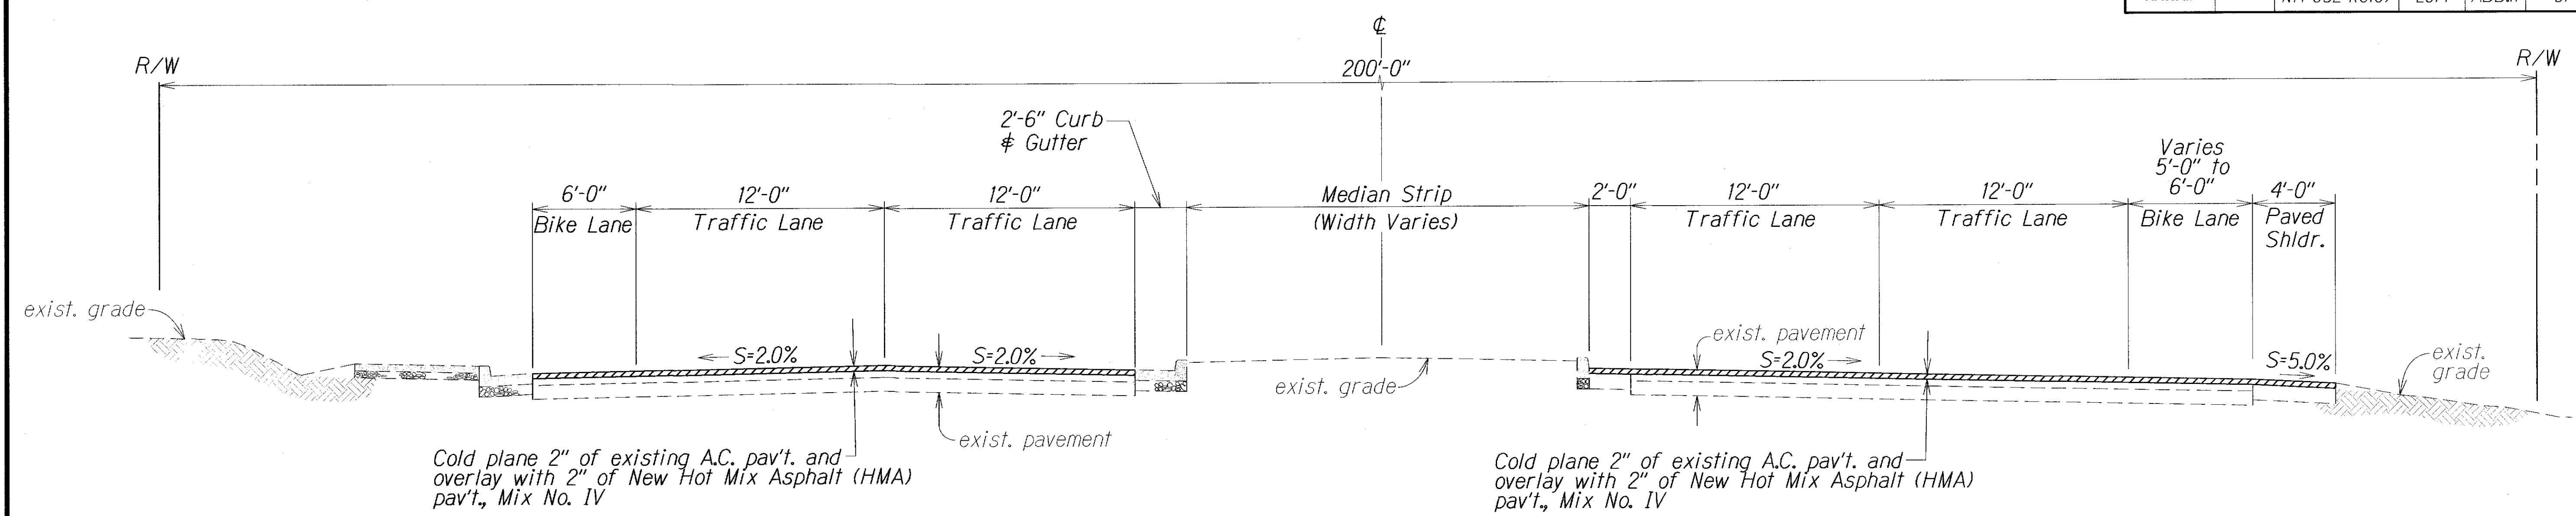

TYPICAL SECTION - LUNALILO STREET TO MAUI LANI PARKWAY  
Scale: 1/4" = 1'-0"

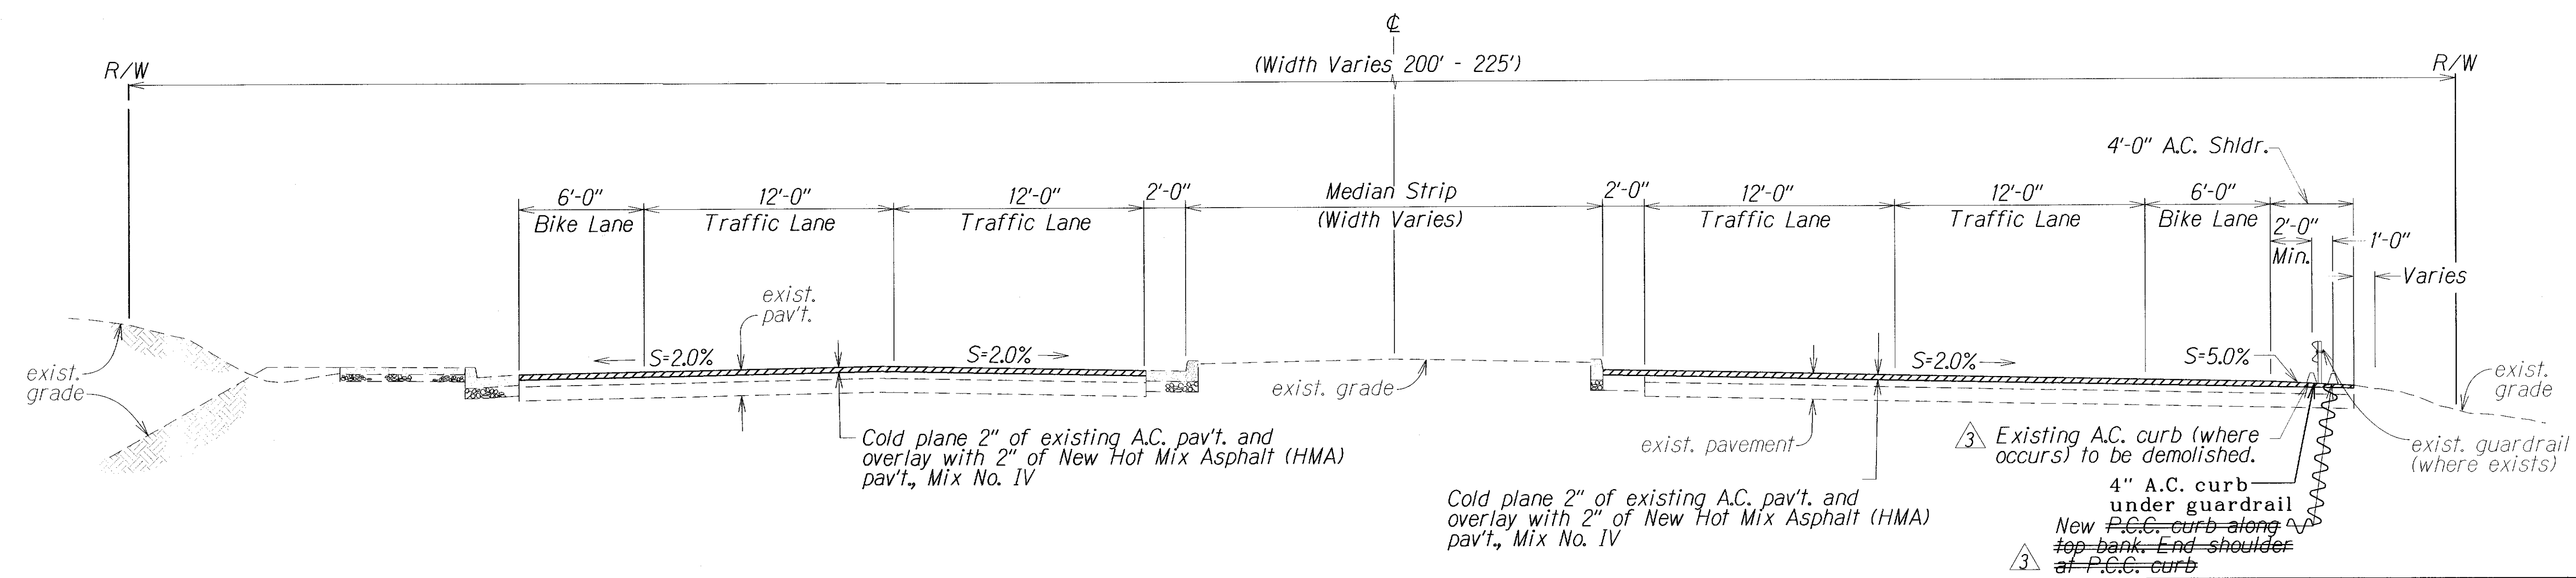

TYPICAL SECTION - MAUI LANI PARKWAY TO KALO A AVENUE  
Scale: 1/4" = 1'-0"

LEGEND FOR AS-BUILT POSTINGS	
	Squiggly line for as-built deletion
	Double line for as-built deletion
Roadway	Text for as-built posting

12/8/14	Show existing A.C. curb Changed new curb to P.C.C.
---------	---

DATE	REVISION
------	----------

STATE OF HAWAII  
DEPARTMENT OF TRANSPORTATION  
HIGHWAYS DIVISION

**TYPICAL SECTIONS & DETAILS**  
MAIN STREET RESURFACING  
High Street to Kaahumanu Avenue and  
KAAHUMANU AVENUE RESURFACING  
Main Street to Hobron Avenue  
Federal-Aid Project No. NH-032-1(010)  
Scale: As Shown      Date: July, 2014



SHEET No. 5 OF 8 SHEETS

ORIGINAL PLAN	SURVEY PLOTTED BY	DATE
NOTE BOOK	DRAWN BY	
	CHECKED BY	
	QUANTITIES BY	

"AS-BUILT"

ADD. 11

FED. ROAD DIST. NO.	STATE	FED. AID PROJ. NO.	FISCAL YEAR	SHEET NO.	TOTAL SHEETS
HAWAII	HAW.	NH-032-1(010)	2014	12	51

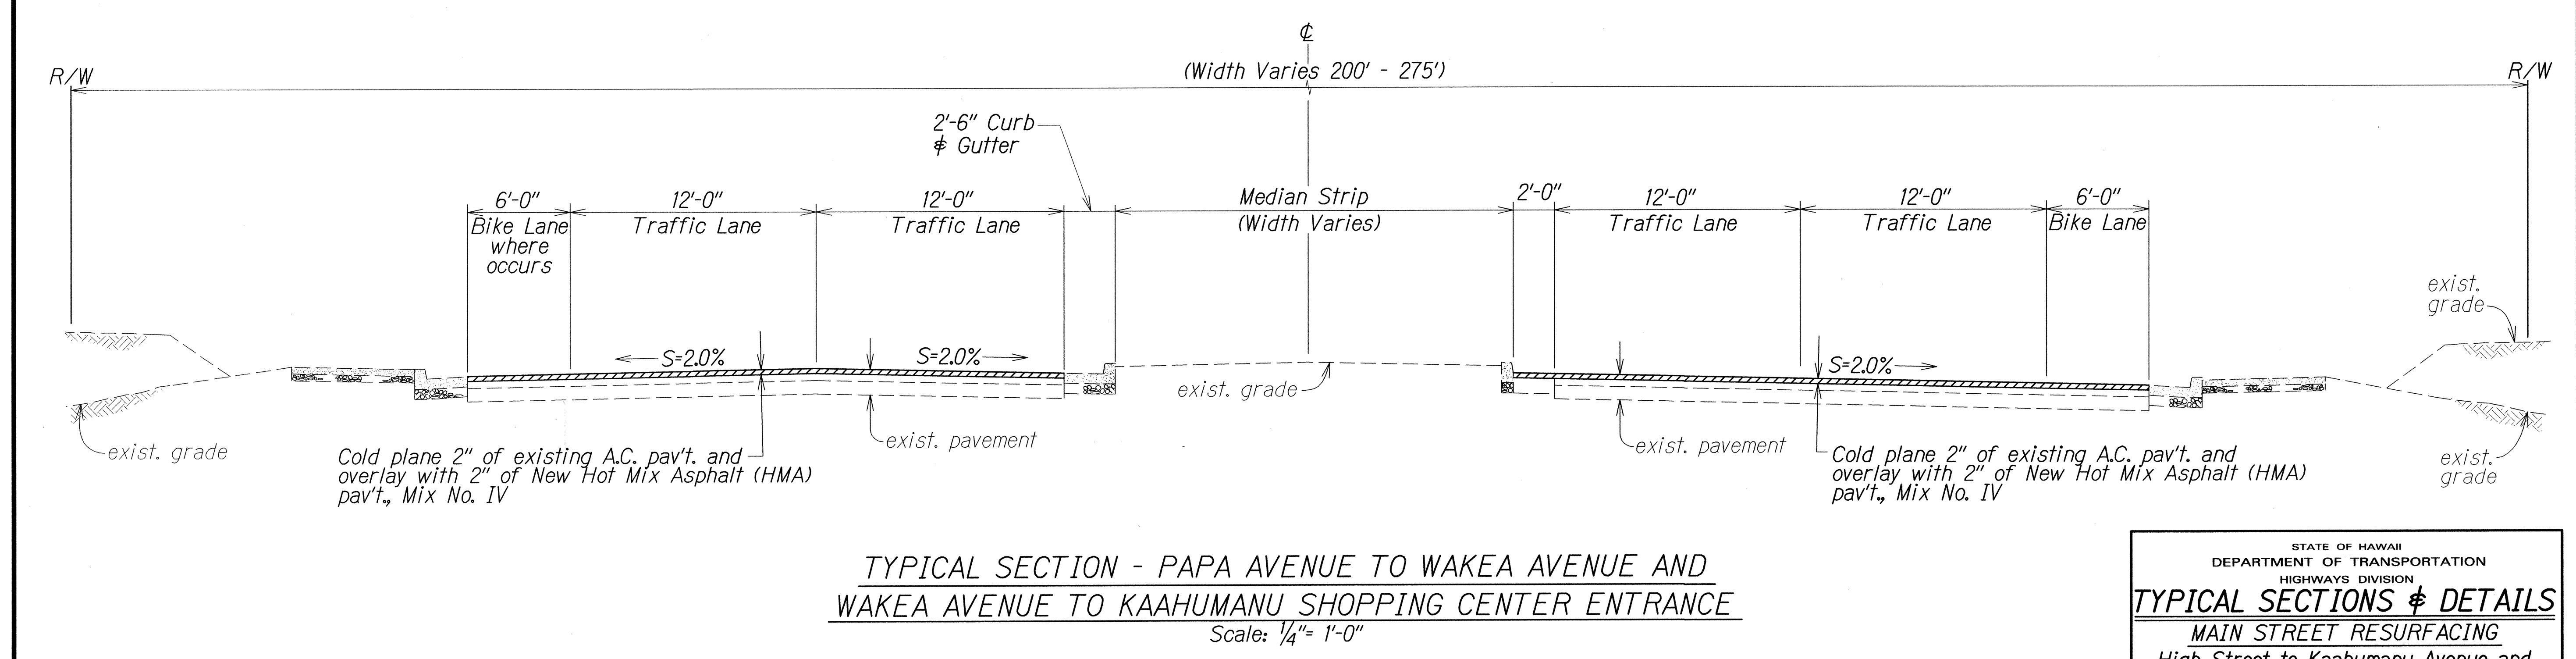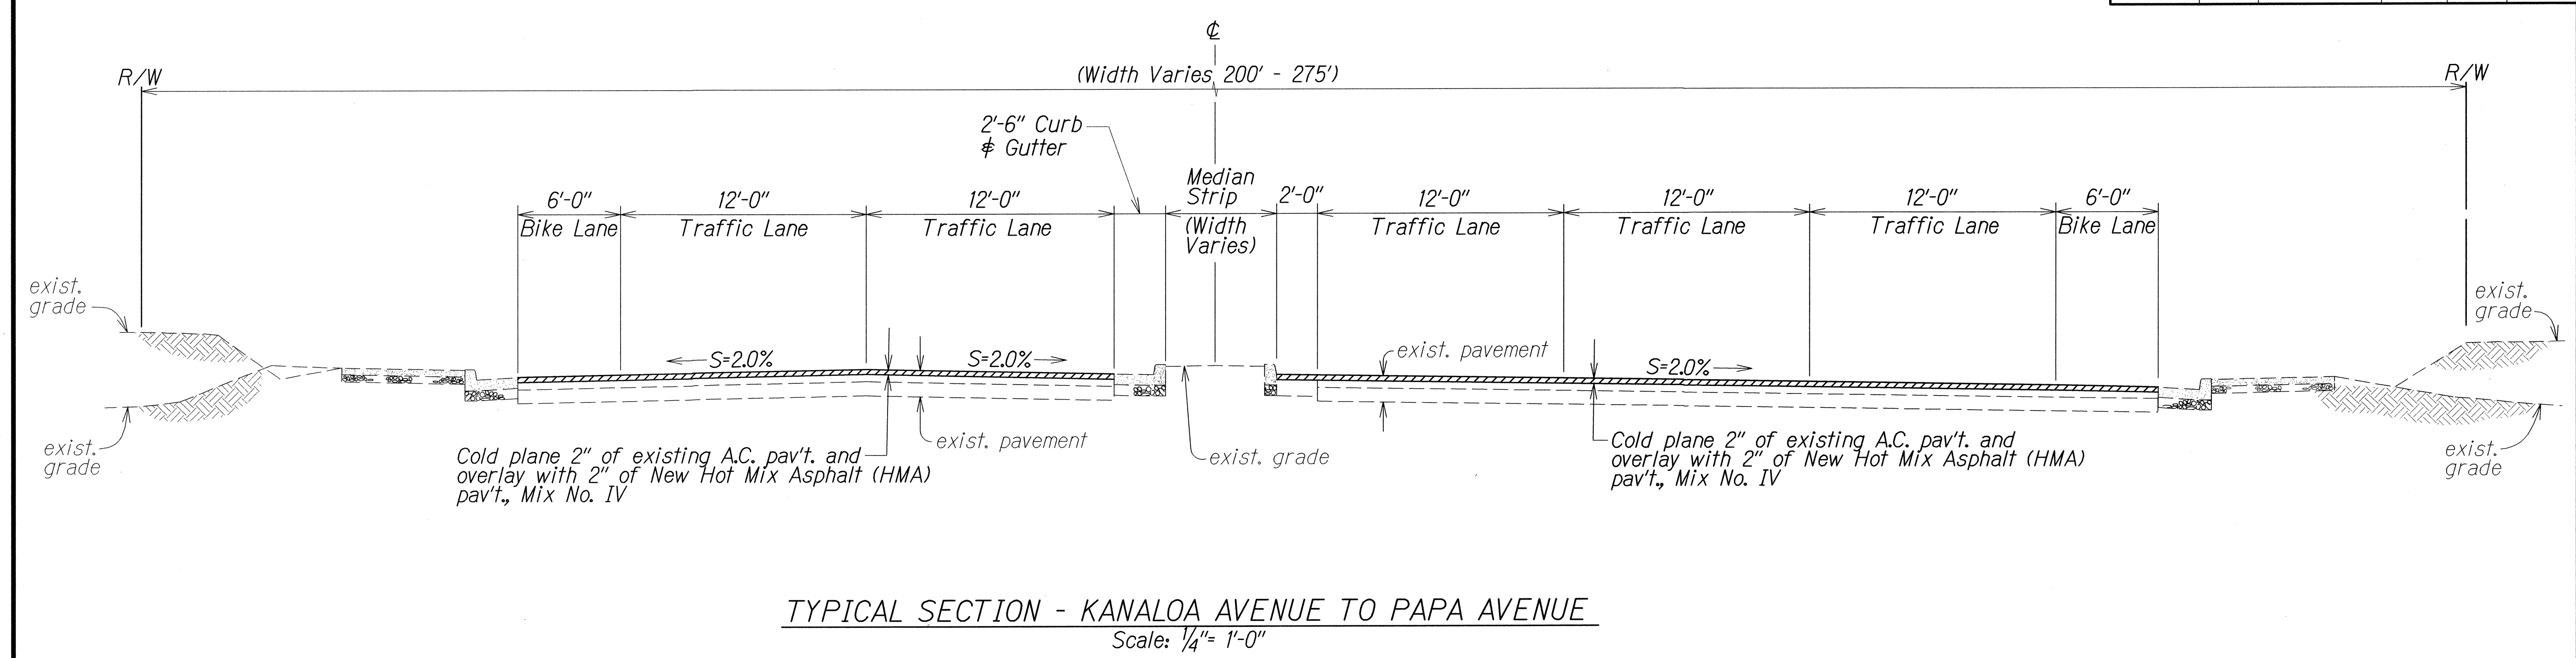


DESIGNED BY	DATE
TRACED BY	
DESIGNED BY	
QUANTITIES BY	
CHECKED BY	
ORIGINAL PLAN	
NOTE BOOK	
N <sup>o</sup>	

STATE OF HAWAII  
DEPARTMENT OF TRANSPORTATION  
HIGHWAYS DIVISION


**TYPICAL SECTIONS & DETAILS**

MAIN STREET RESURFACING  
High Street to Kaahumanu Avenue and  
KAAHUMANU AVENUE RESURFACING  
Main Street to Hobron Avenue  
Federal-Aid Project No. NH-032-1(010)  
Scale: As Shown Date: July, 2014

FED. ROAD DIST. NO.	STATE	FED. AID PROJ. NO.	FISCAL YEAR	SHEET NO.	TOTAL SHEETS
HAWAII	HAW.	NH-032-1(010)	2014	ADDJ3	51

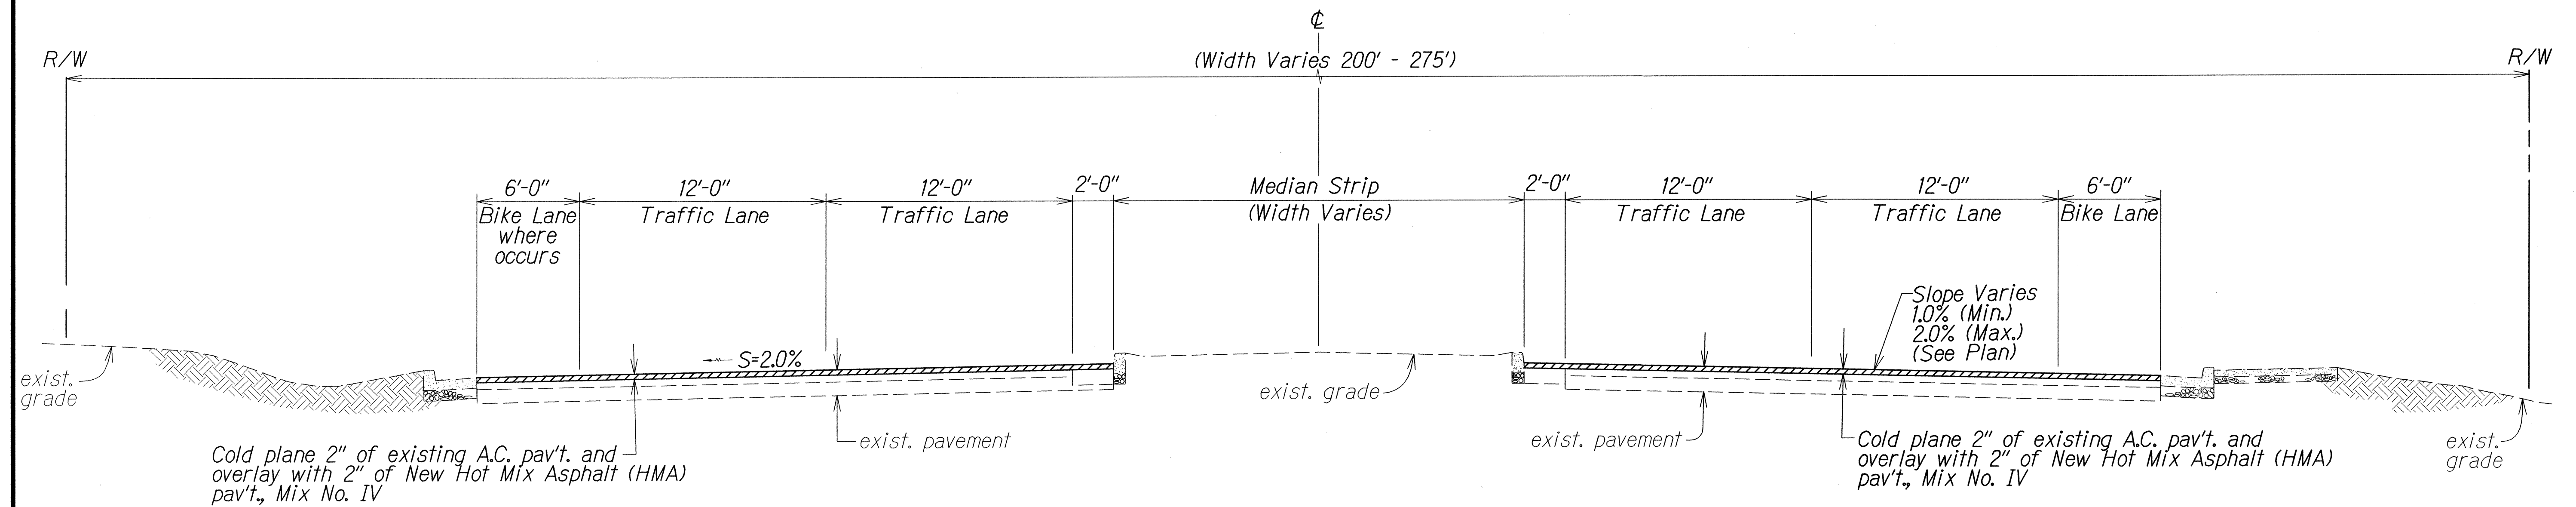

**TYPICAL SECTION - KAAHUMANU SHOPPING CENTER ENTRANCE TO KANE STREET**  
Scale: 1/4" = 1'-0"

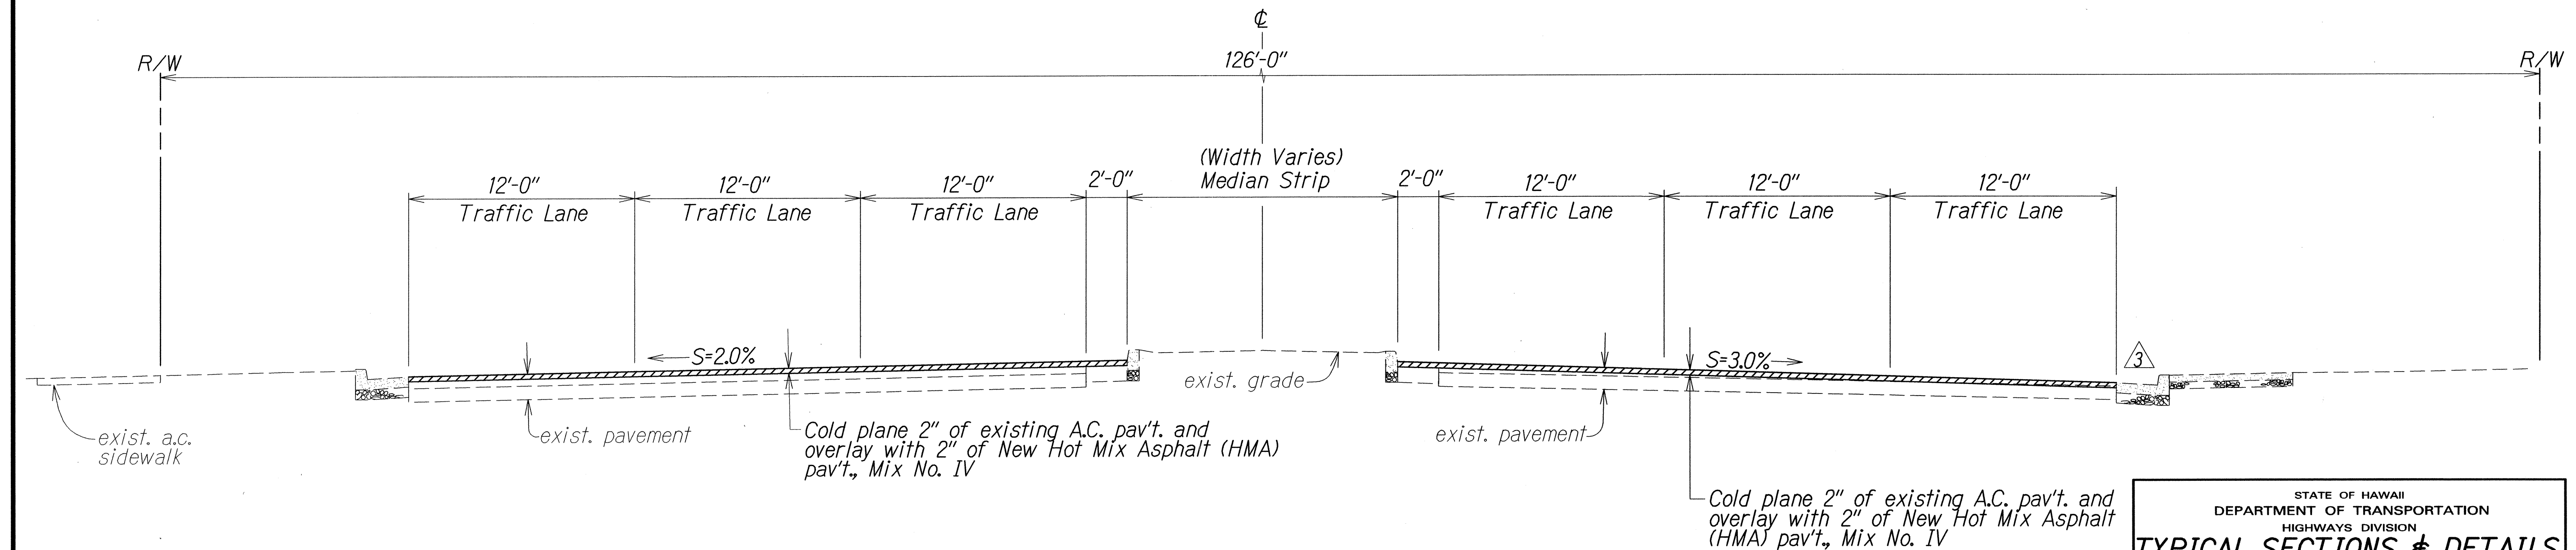

**TYPICAL SECTION - KANE STREET TO PUUNENE AVENUE**  
Scale: 1/4" = 1'-0"

SURVEY PLOTTED BY	DATE
DESIGNED BY	
QUANTITIES BY	
CHECKED BY	
ORIGINAL PLAN	
NOTE BOOK	
DATE	
NO.	

3 12/8/14 Removed line over gutter


DATE REVISION

STATE OF HAWAII DEPARTMENT OF TRANSPORTATION HIGHWAYS DIVISION
<b>TYPICAL SECTIONS &amp; DETAILS</b>
MAIN STREET RESURFACING
High Street to Kaahumanu Avenue and
KAAHUMANU AVENUE RESURFACING
Main Street to Hobron Avenue
Federal-Aid Project No. NH-032-1(010)
Scale: As Shown Date: July, 2014


SHEET No. 7 OF 8 SHEETS

**ADD. 13**

FED. ROAD DIST. NO.	STATE	FED. AID PROJ. NO.	FISCAL YEAR	SHEET NO.	TOTAL SHEETS
HAWAII	HAW.	NH-032-1(010)	2014	ADD.14	51

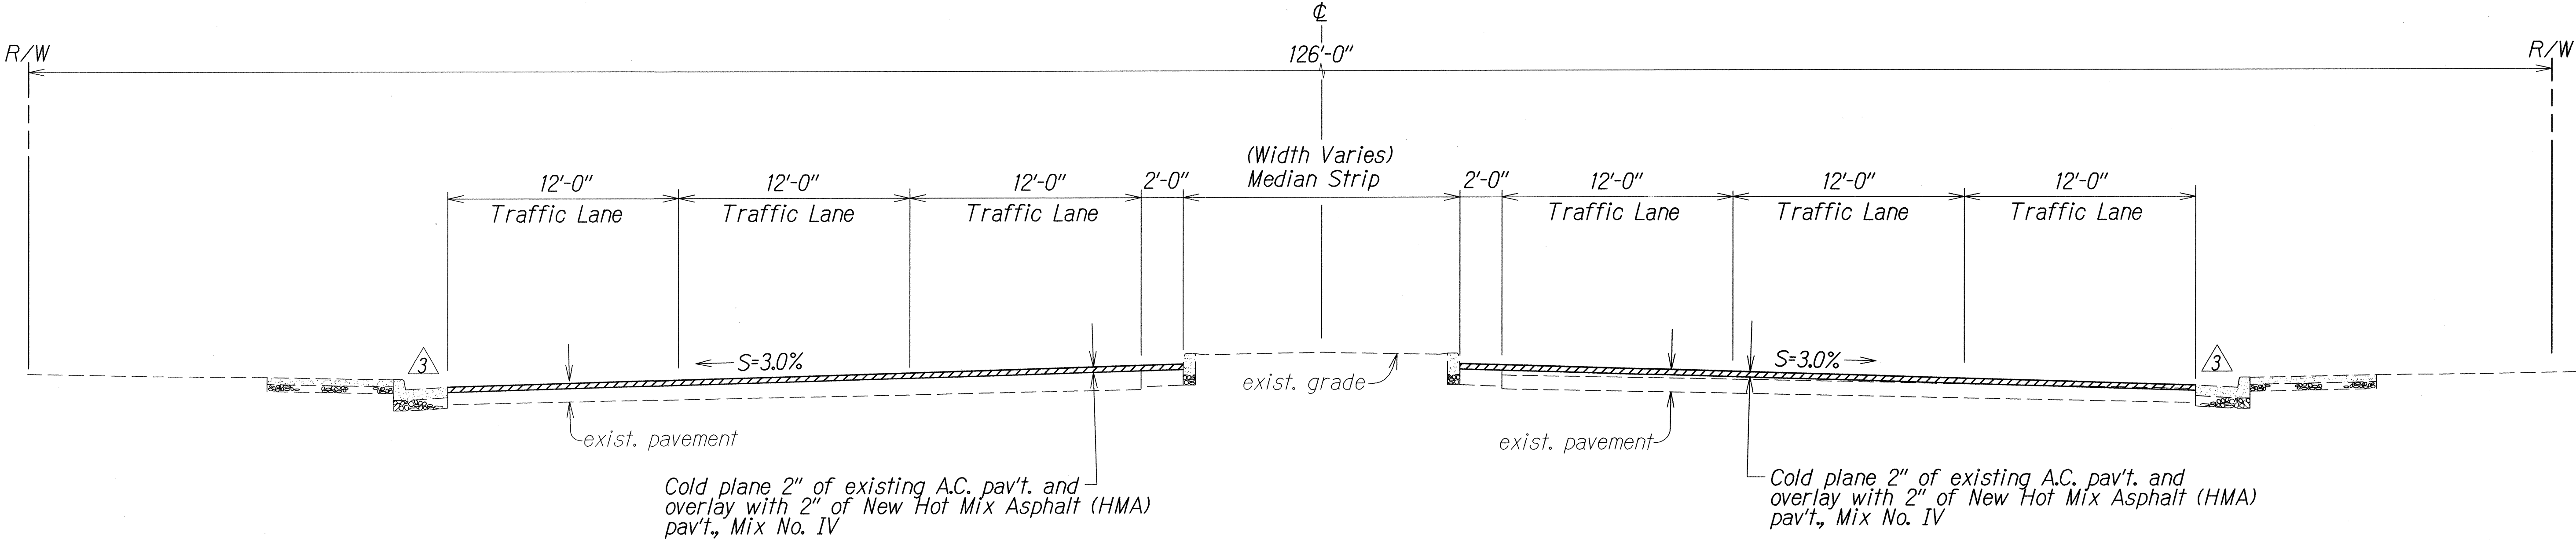

TYPICAL SECTION - PUUNENE AVENUE TO HANA HIGHWAY  
Scale: 1/4"= 1'-0"

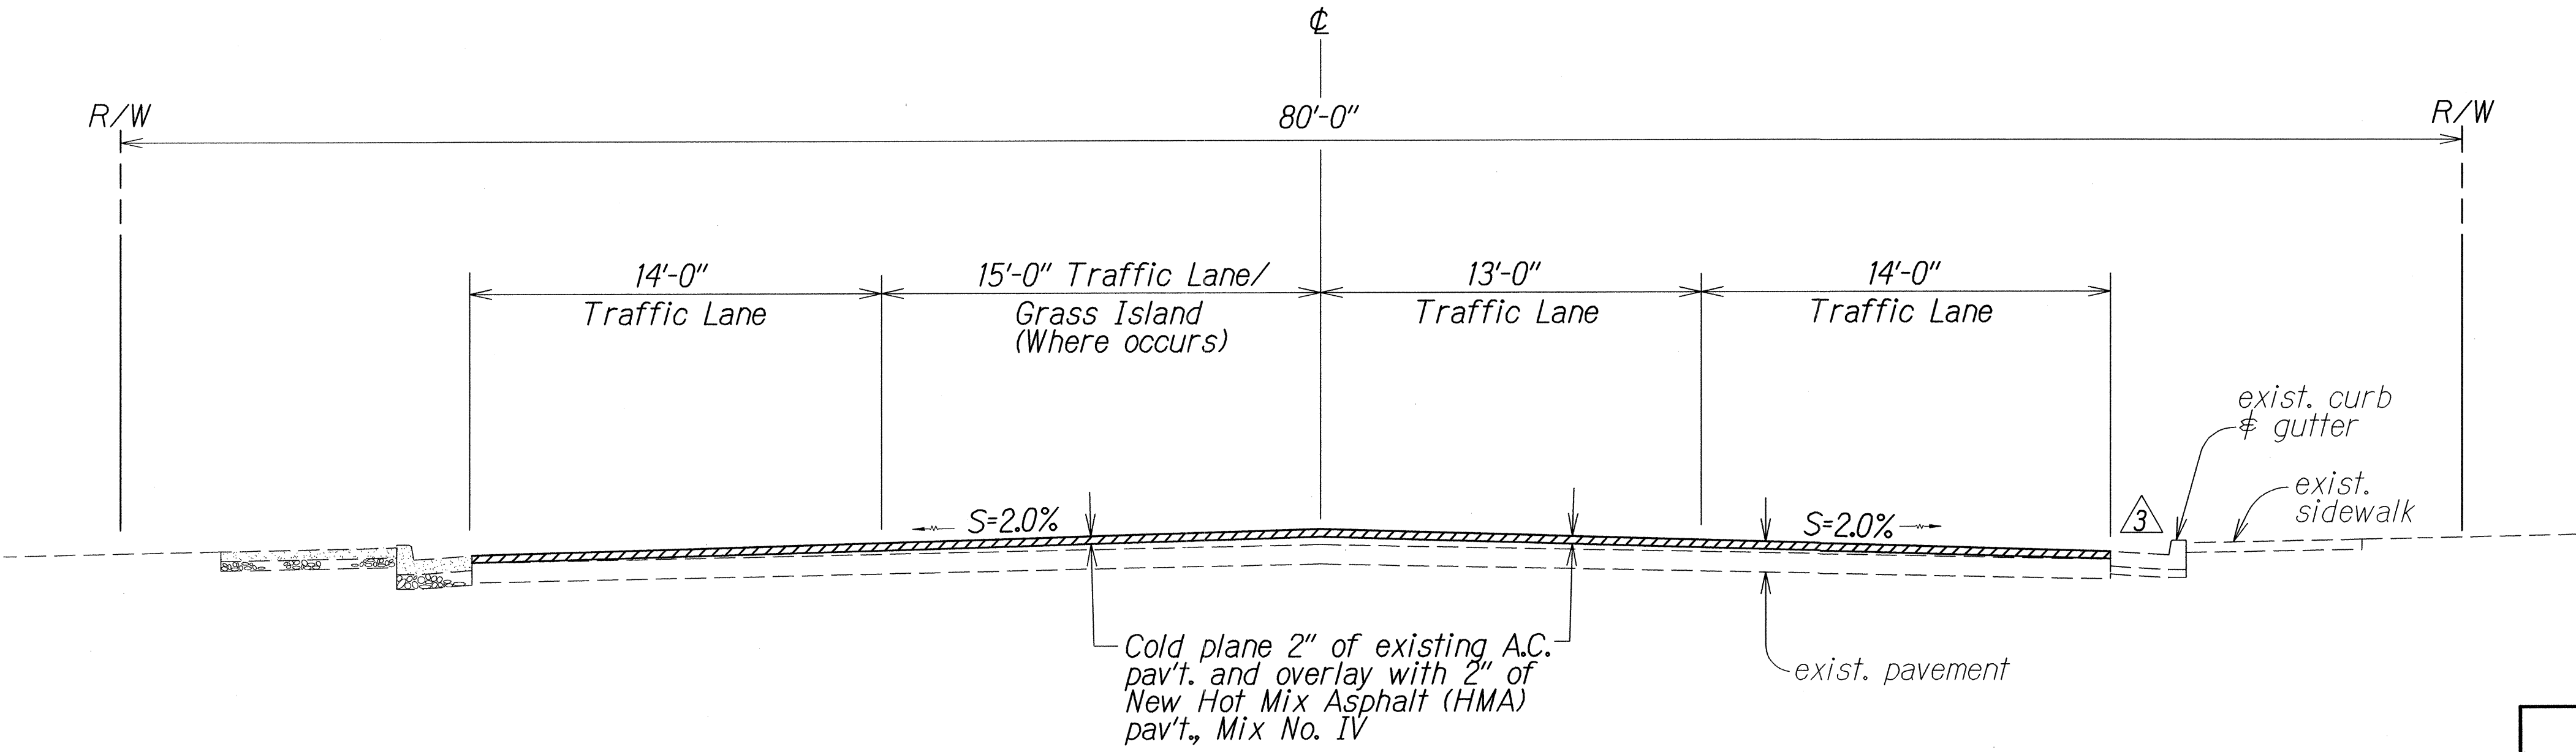

TYPICAL SECTION - HANA HIGHWAY TO HOBRON AVENUE  
Scale: 1/4"= 1'-0"

STATE OF HAWAII DEPARTMENT OF TRANSPORTATION HIGHWAYS DIVISION	
<b>TYPICAL SECTIONS &amp; DETAILS</b>	
MAIN STREET RESURFACING	
High Street to Kaahumanu Avenue and KAAHUMANU AVENUE RESURFACING	
Main Street to Hobron Avenue	
Federal-Aid Project No. NH-032-1(010)	
Scale: As Shown	Date: July, 2014
SHEET No. 8 OF 8 SHEETS	

3	12/8/14	Removed line over gutter Removed pavement overlay over gutter
DATE	REVISION	