


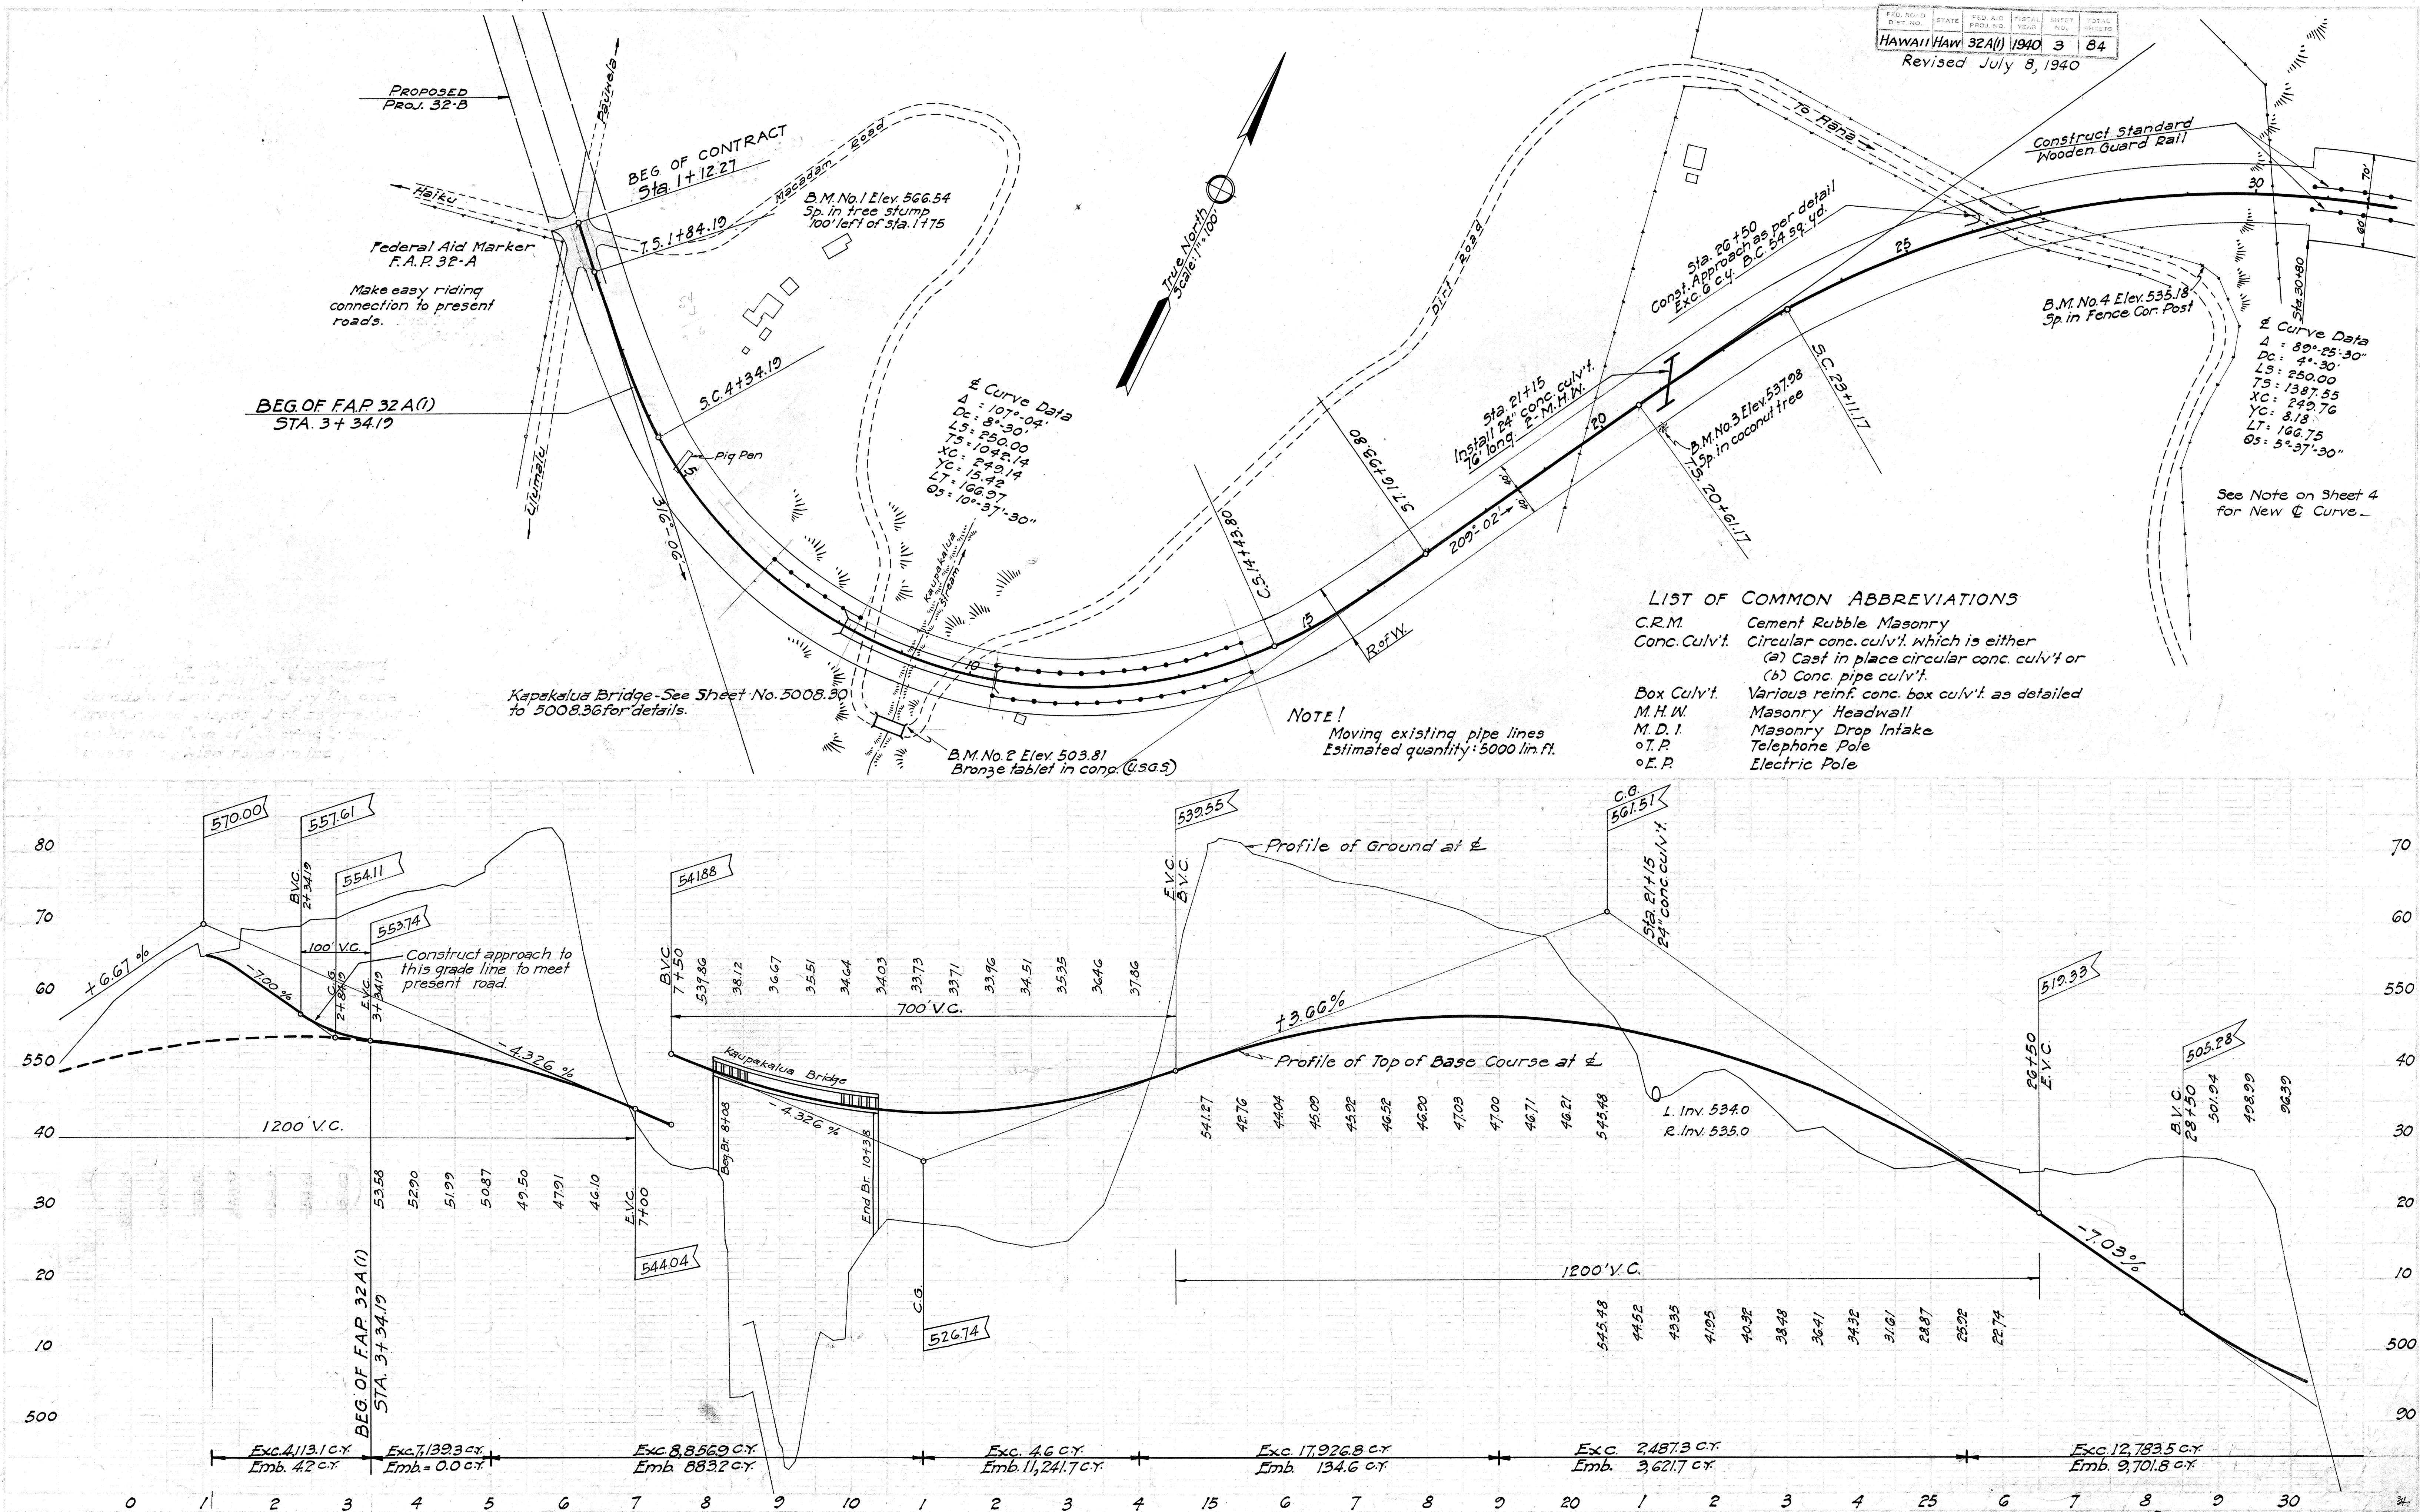
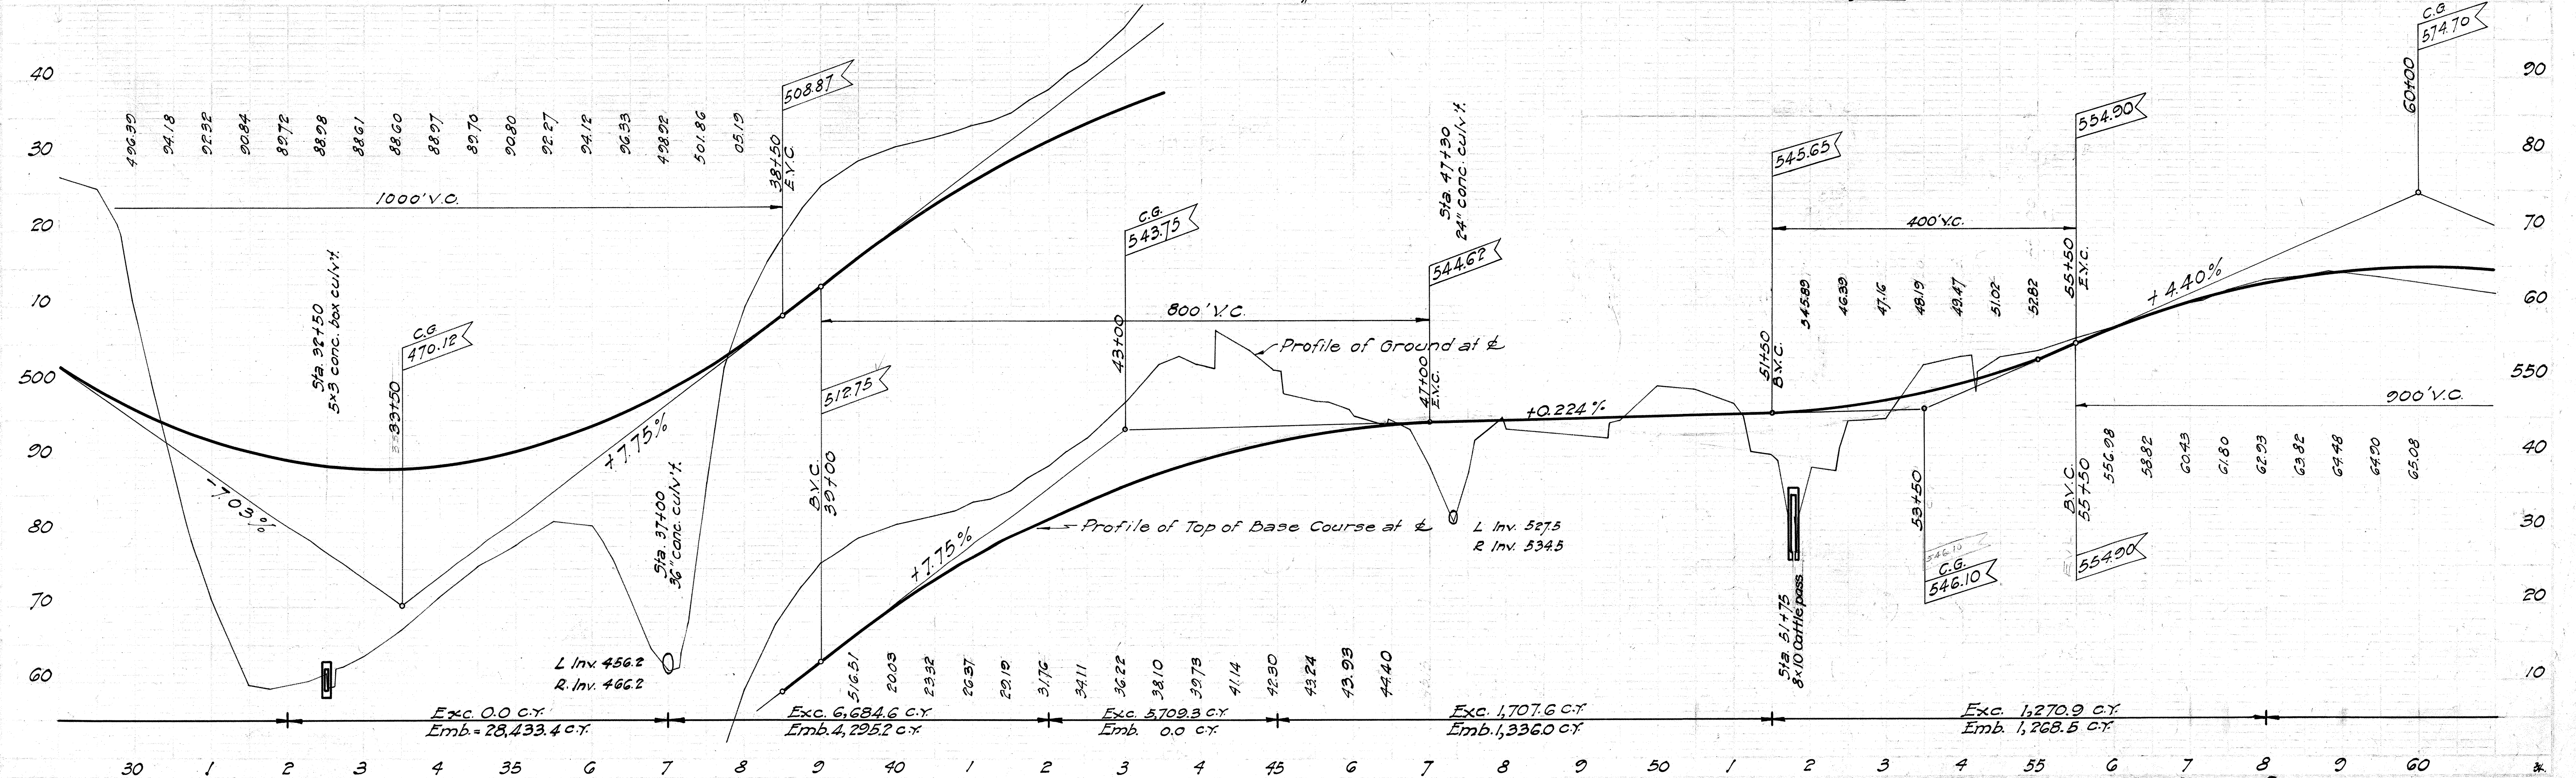


Revised July 8, 1940, & Curve to be changed.


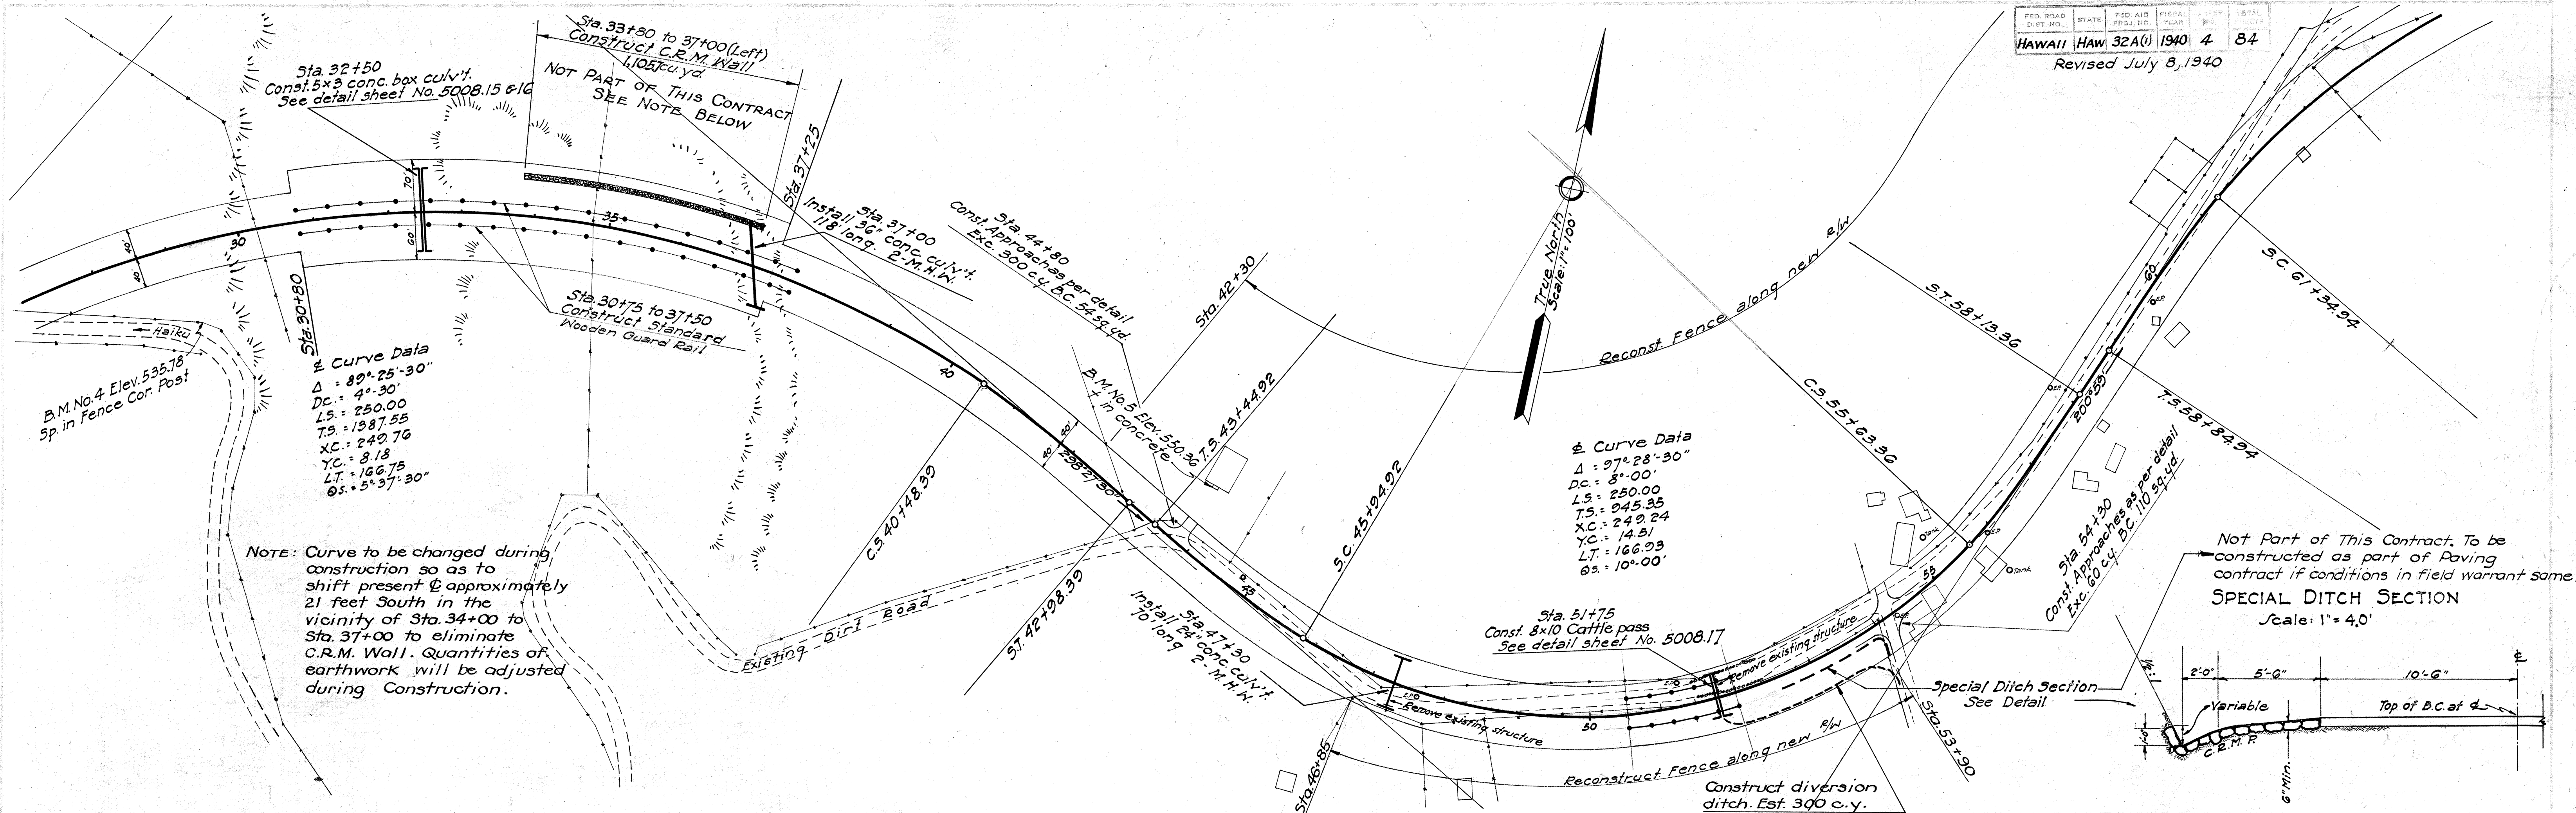


Revised July 8, 1940
Curve to be changed.
C.R.M. Wall deleted.
Special Ditch added.
Division Ditch added.


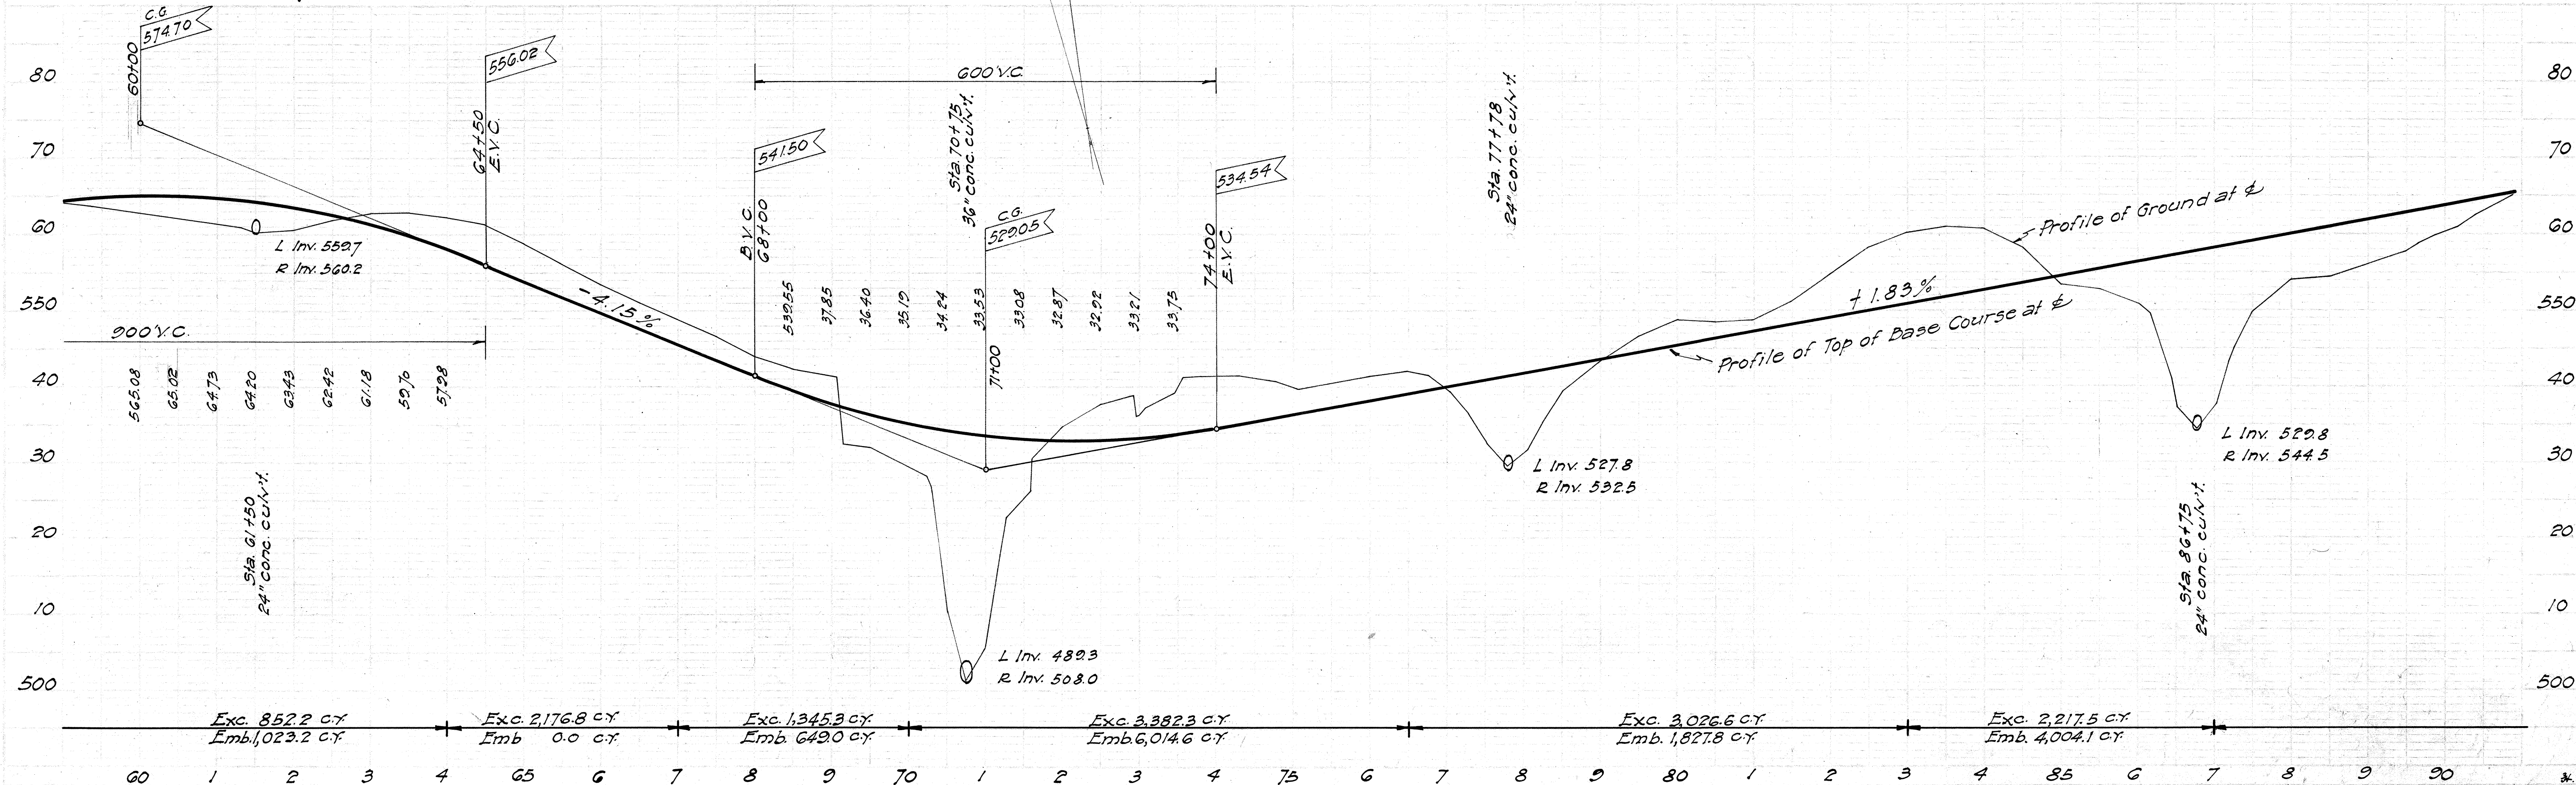


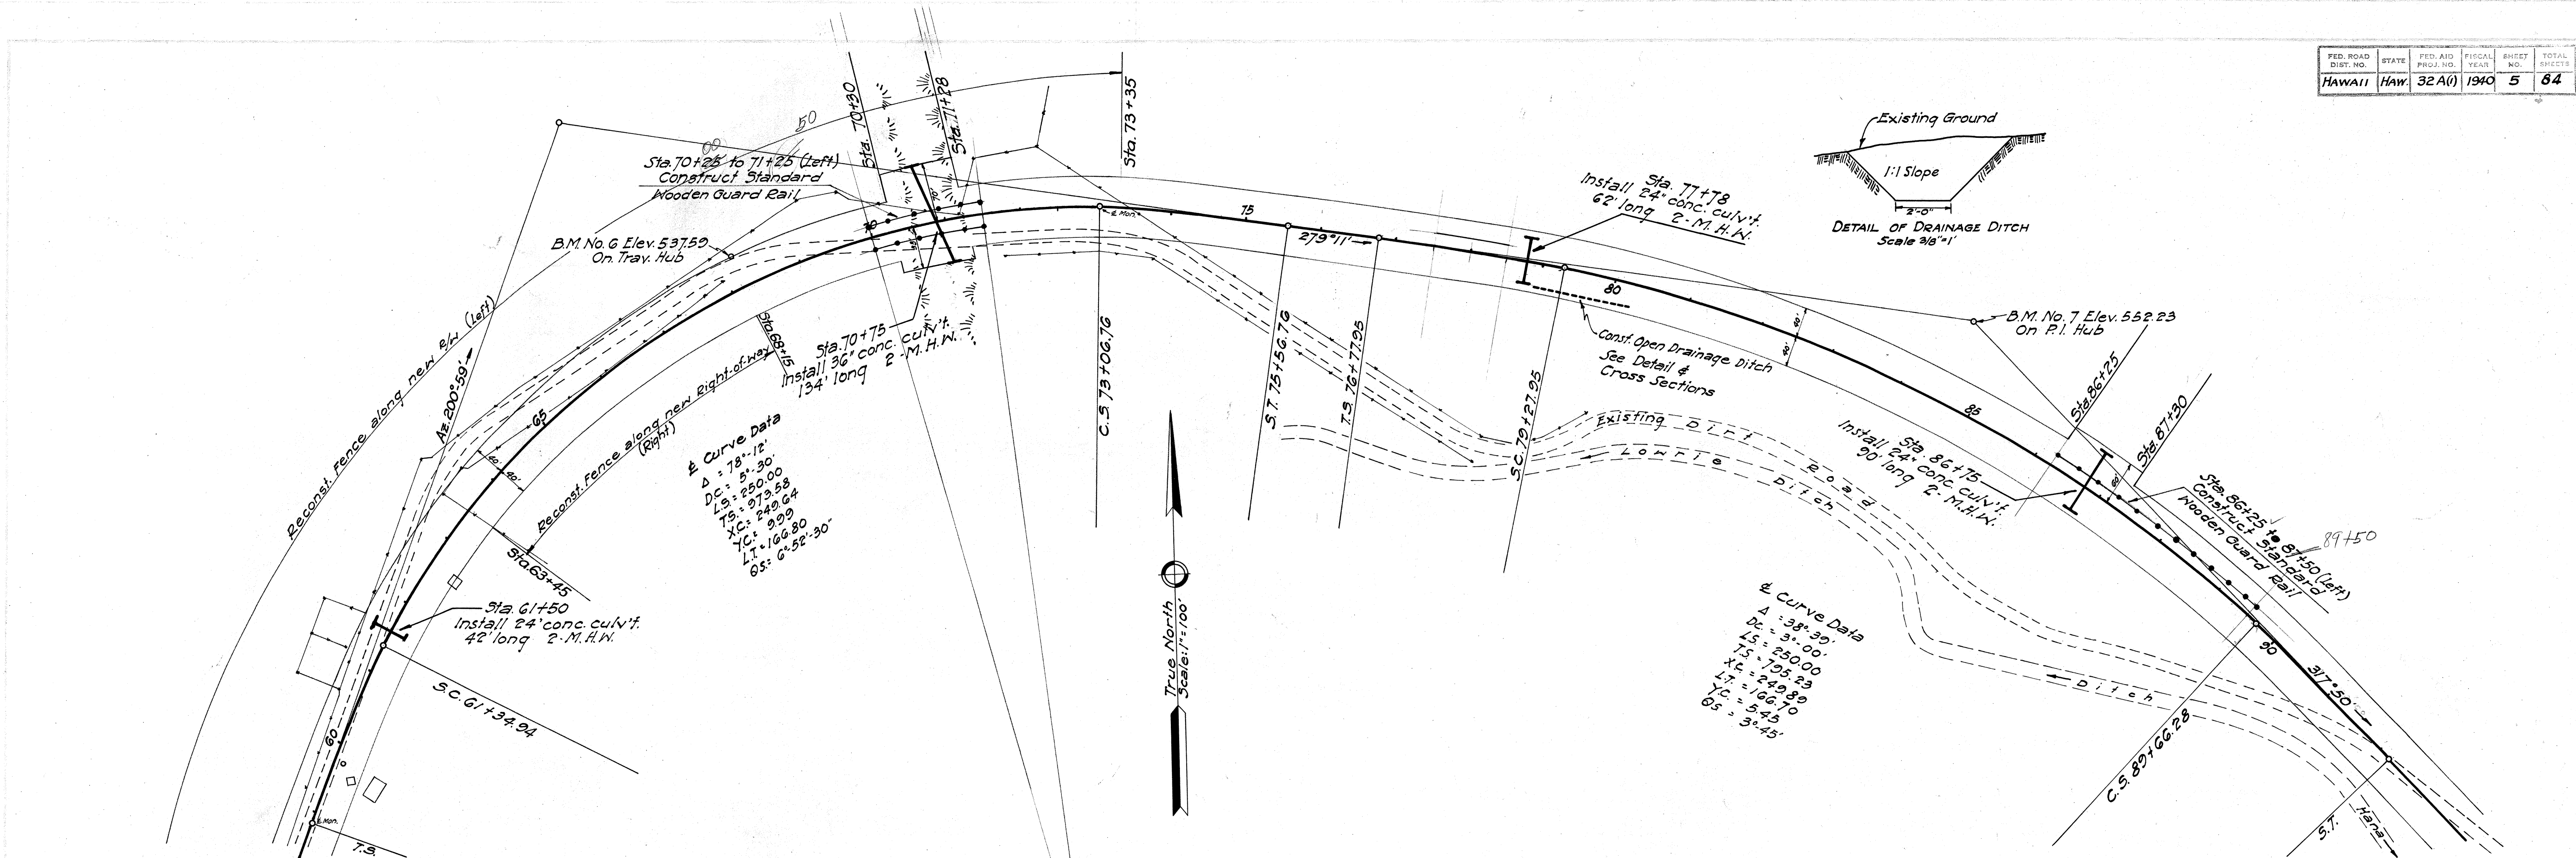

5008.5

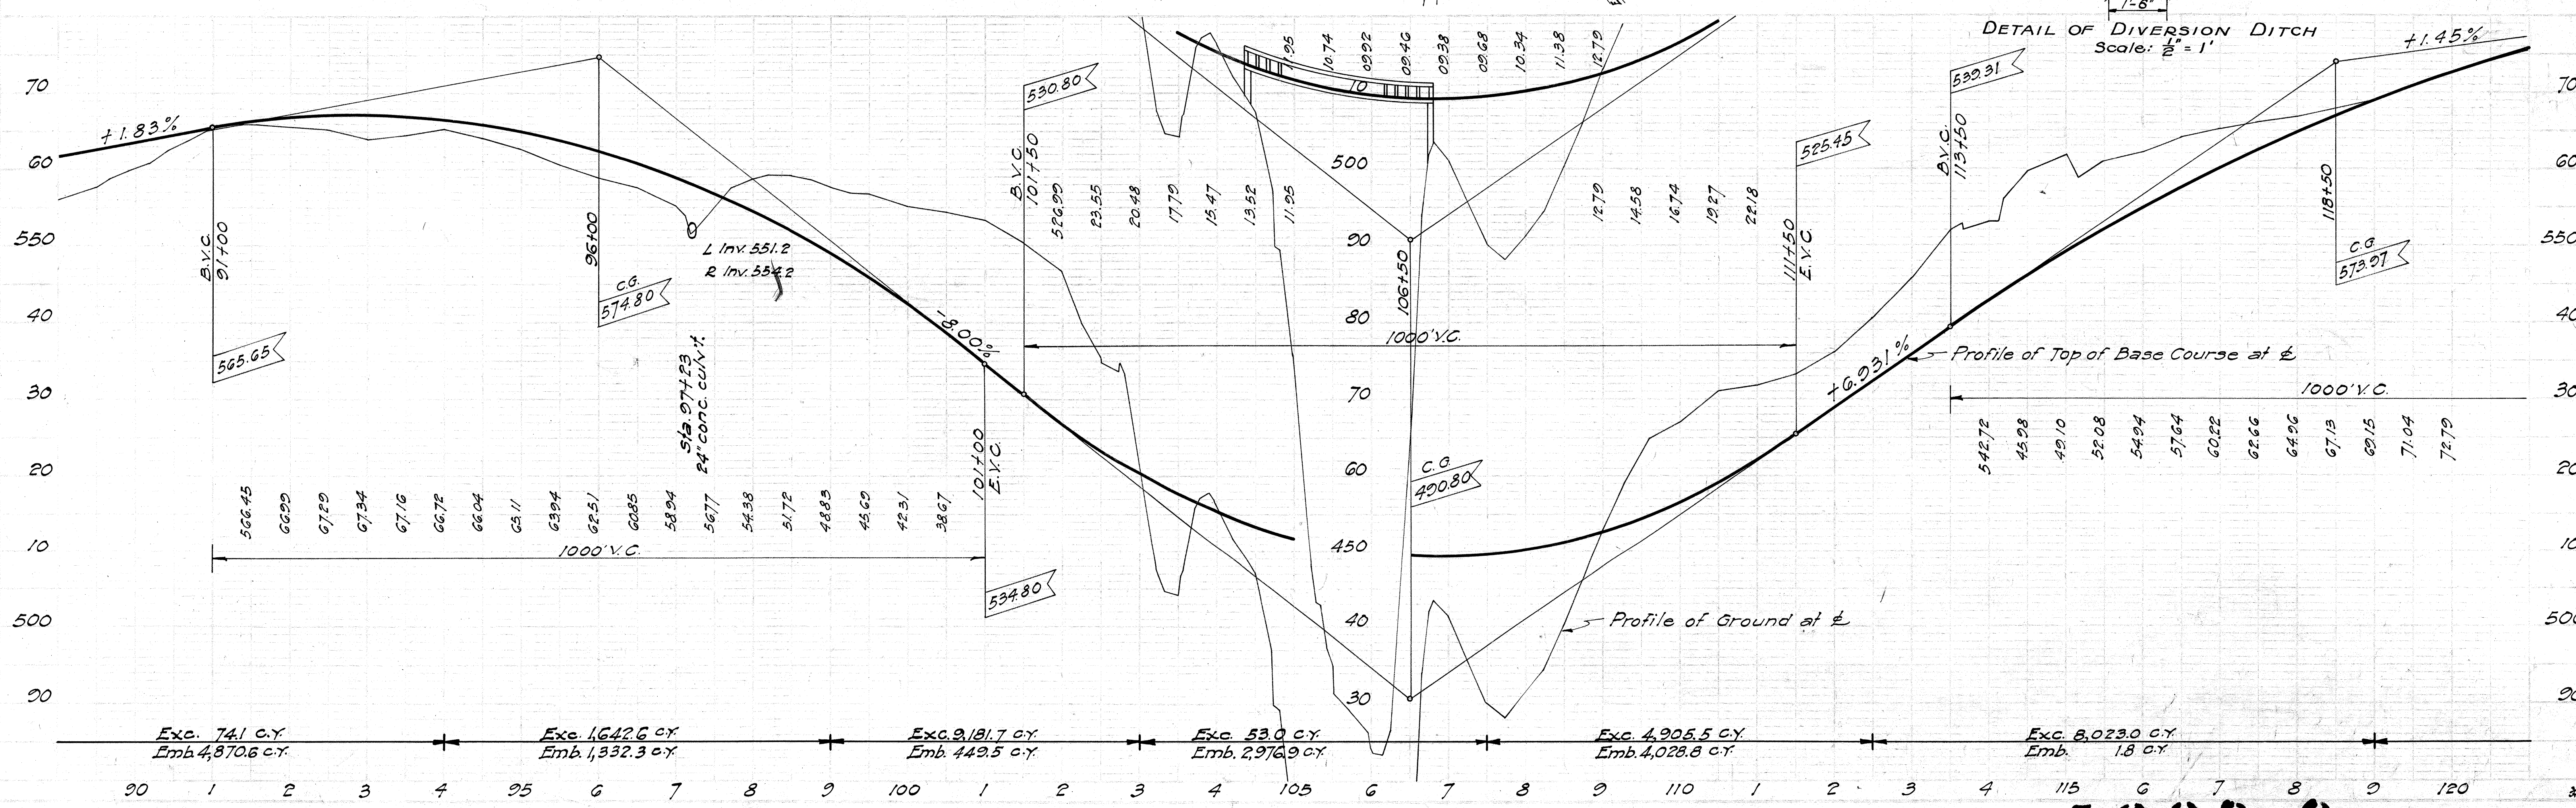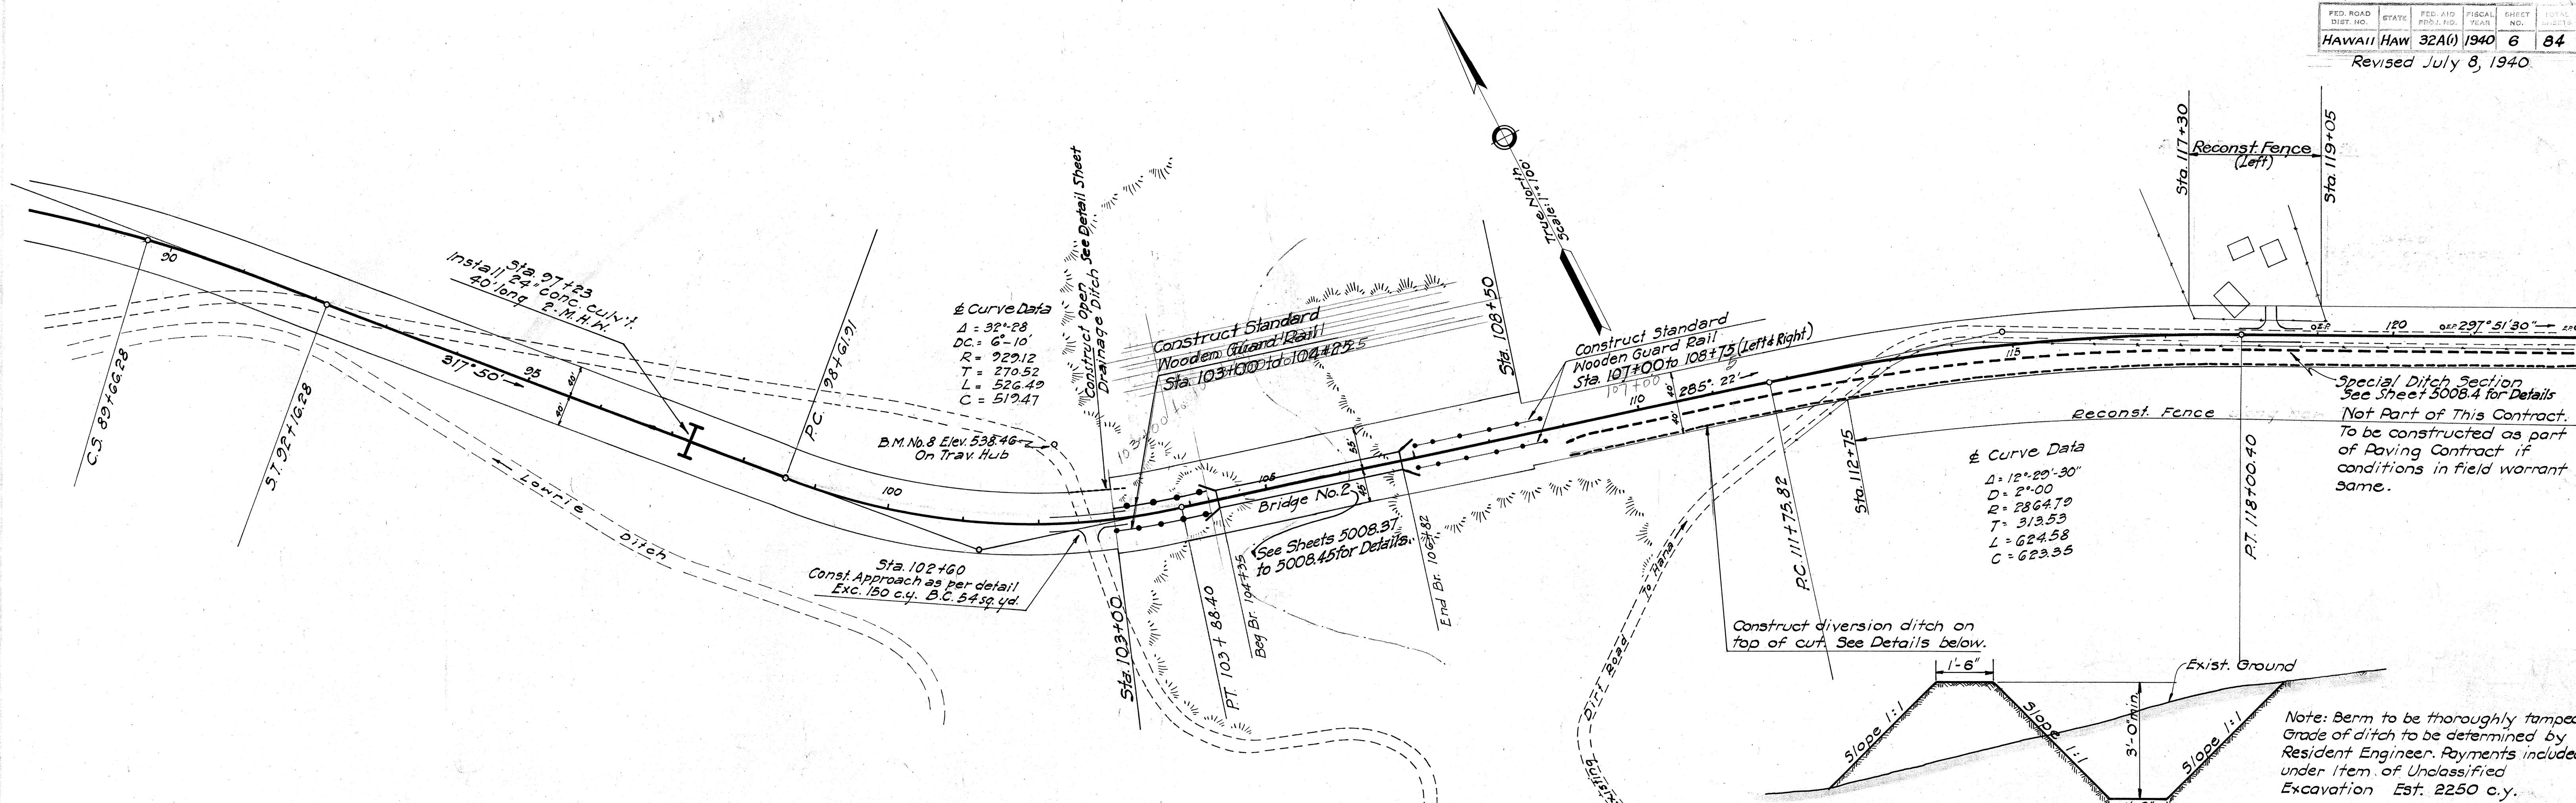



Revised July 8, 1940 Special Ditch deleted. Diversion Ditch added.

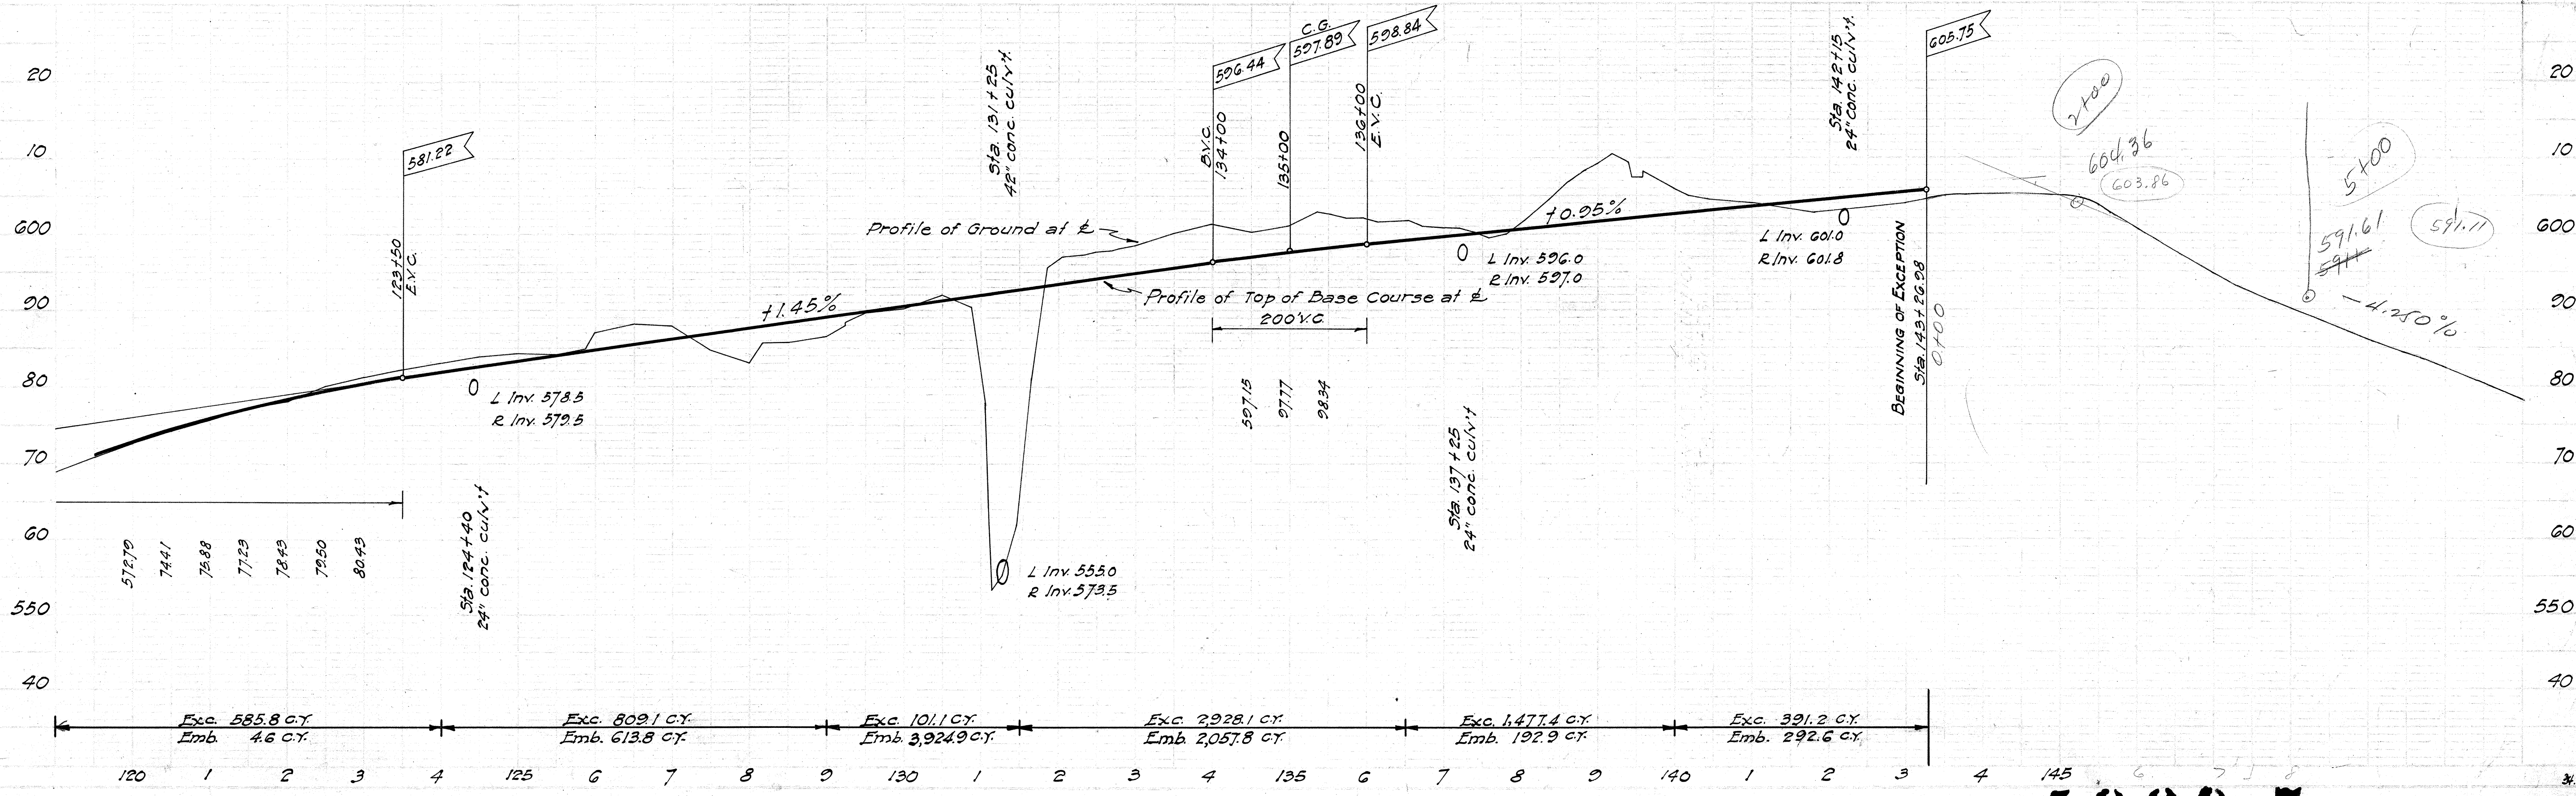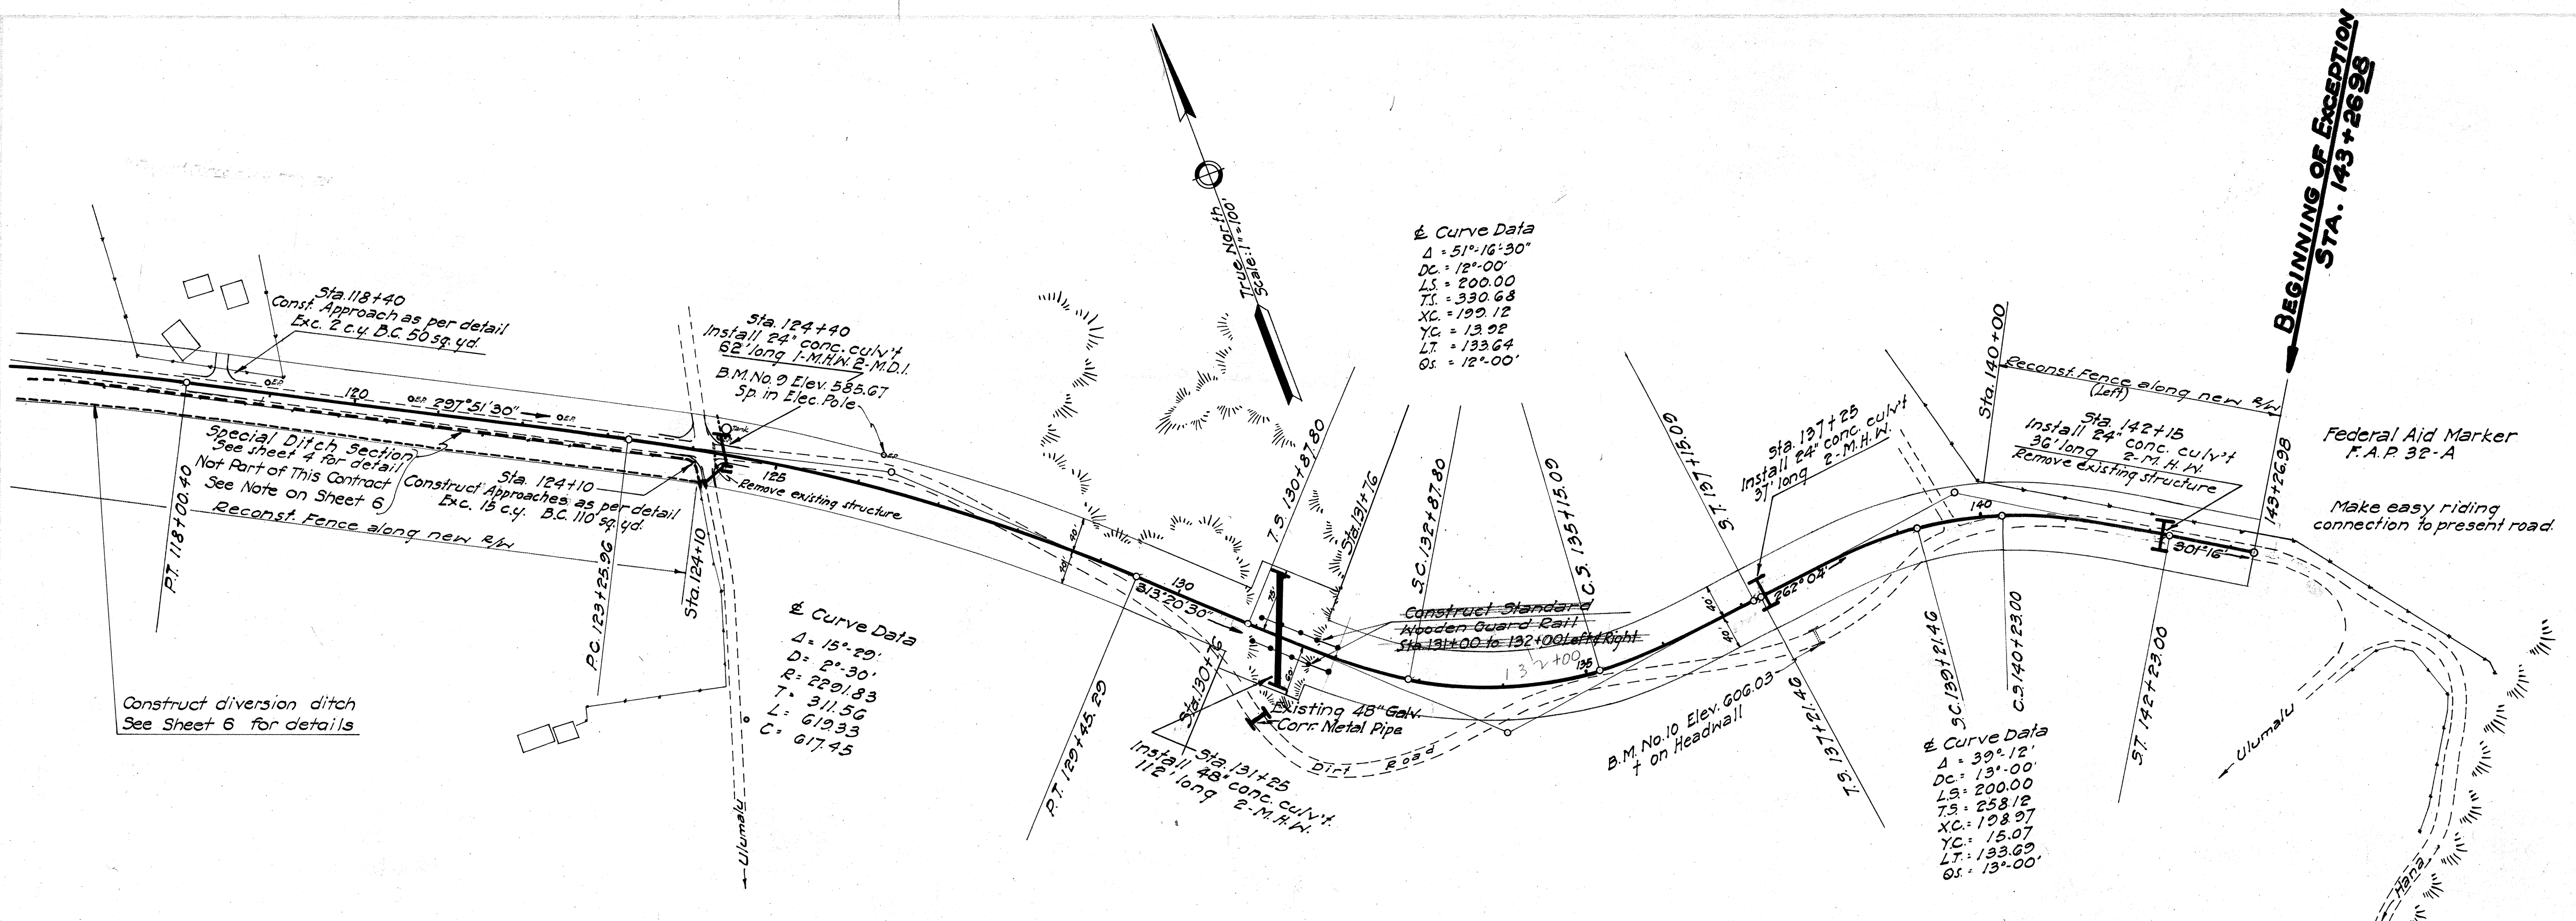

REVISED Sept. 5, 1939
Guard Rail Eliminated



FED. ROAD DIST. NO.	STATE	FED. AID PROJ. NO.	FISCAL YEAR	SHEET NO.	TOTAL SHEETS
HAWAII	HAW	329(1)	1939	8	84

REVISED 9-5-39

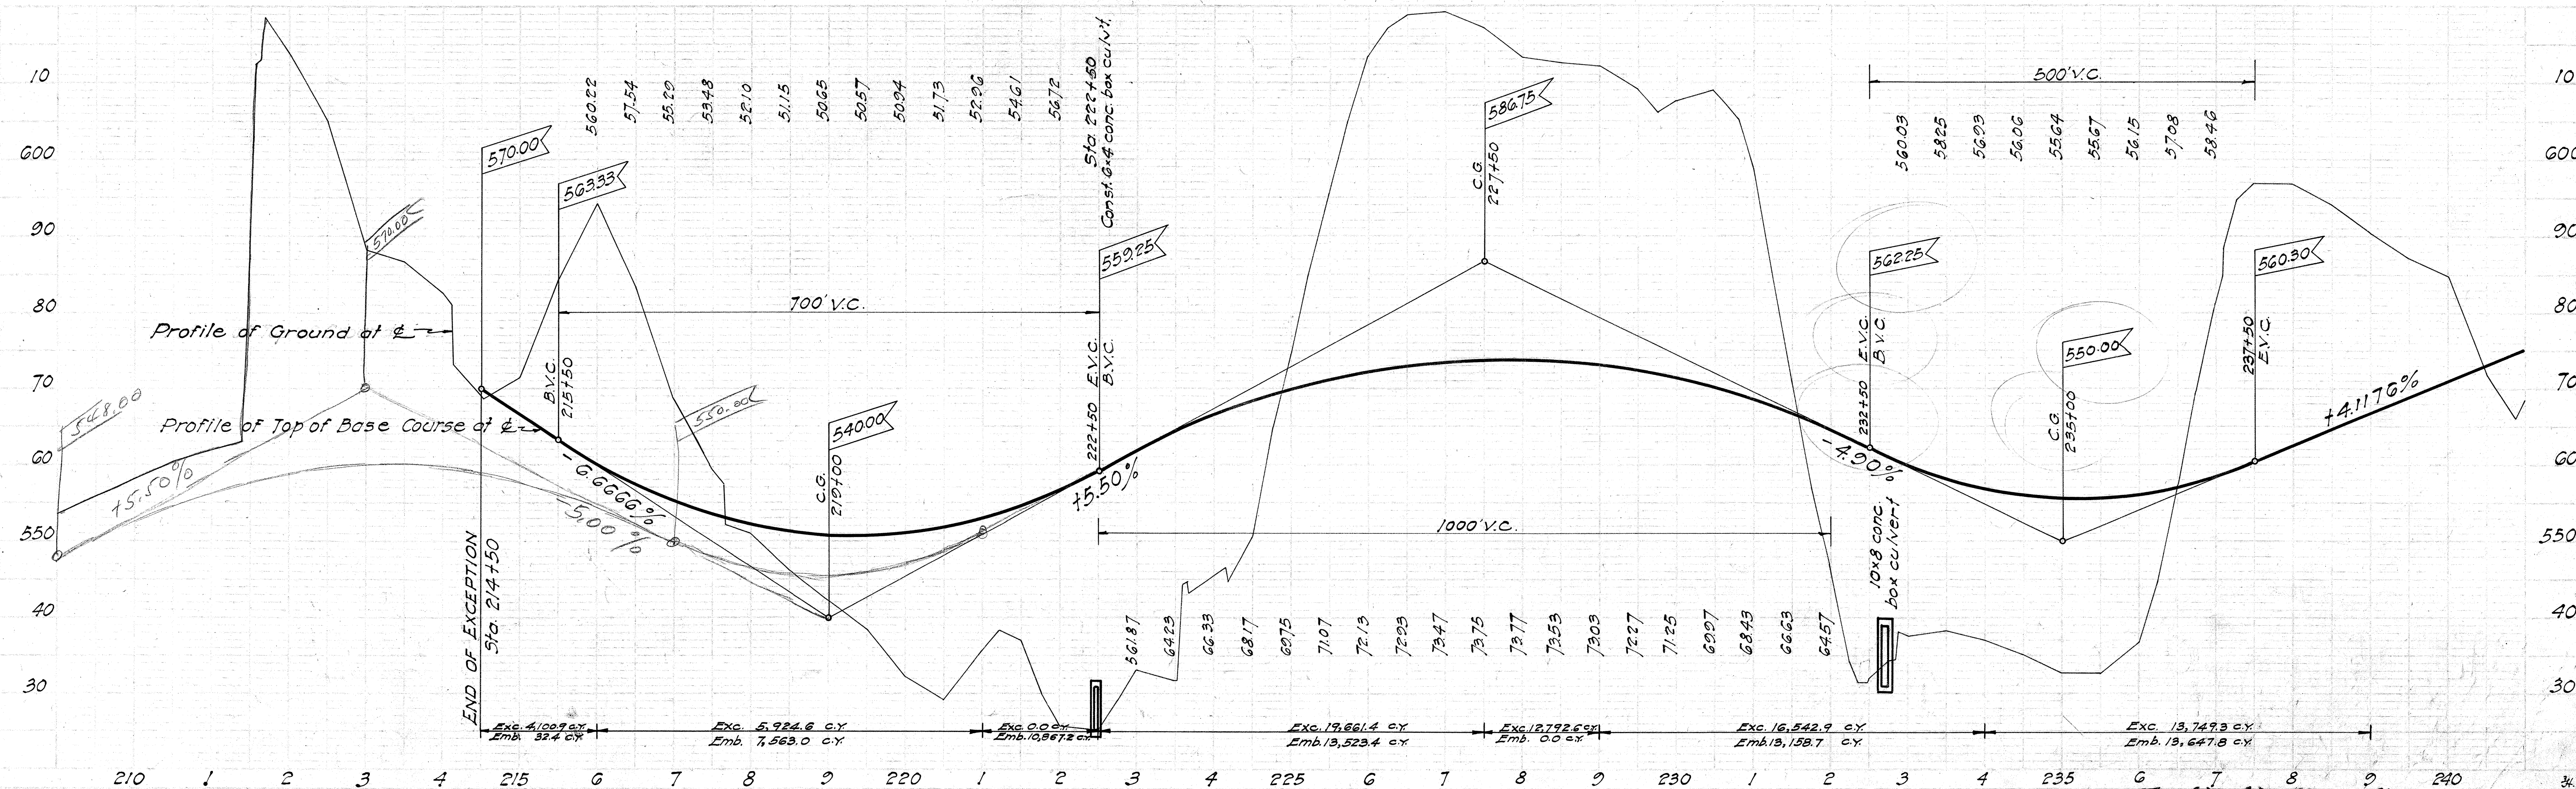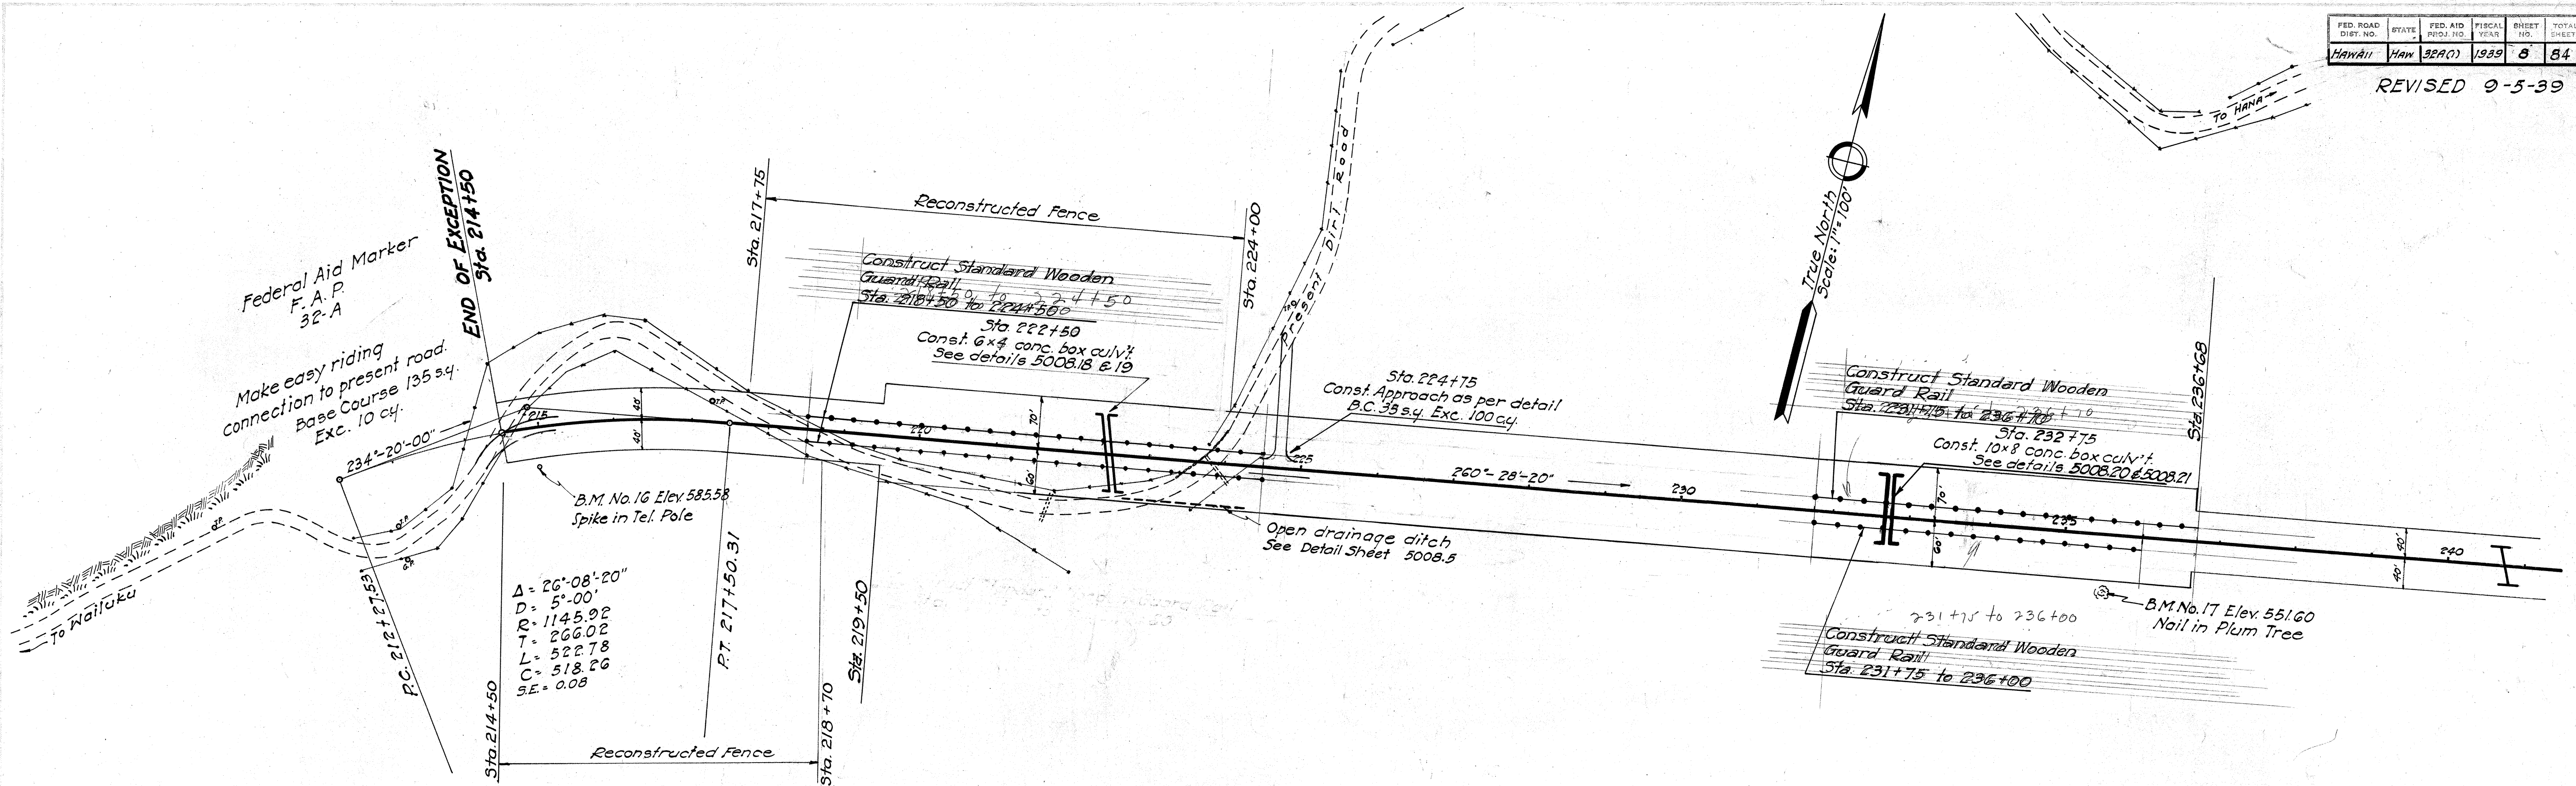

5008.8

REVISED Sept. 5, 1939
Guard Rail Eliminated

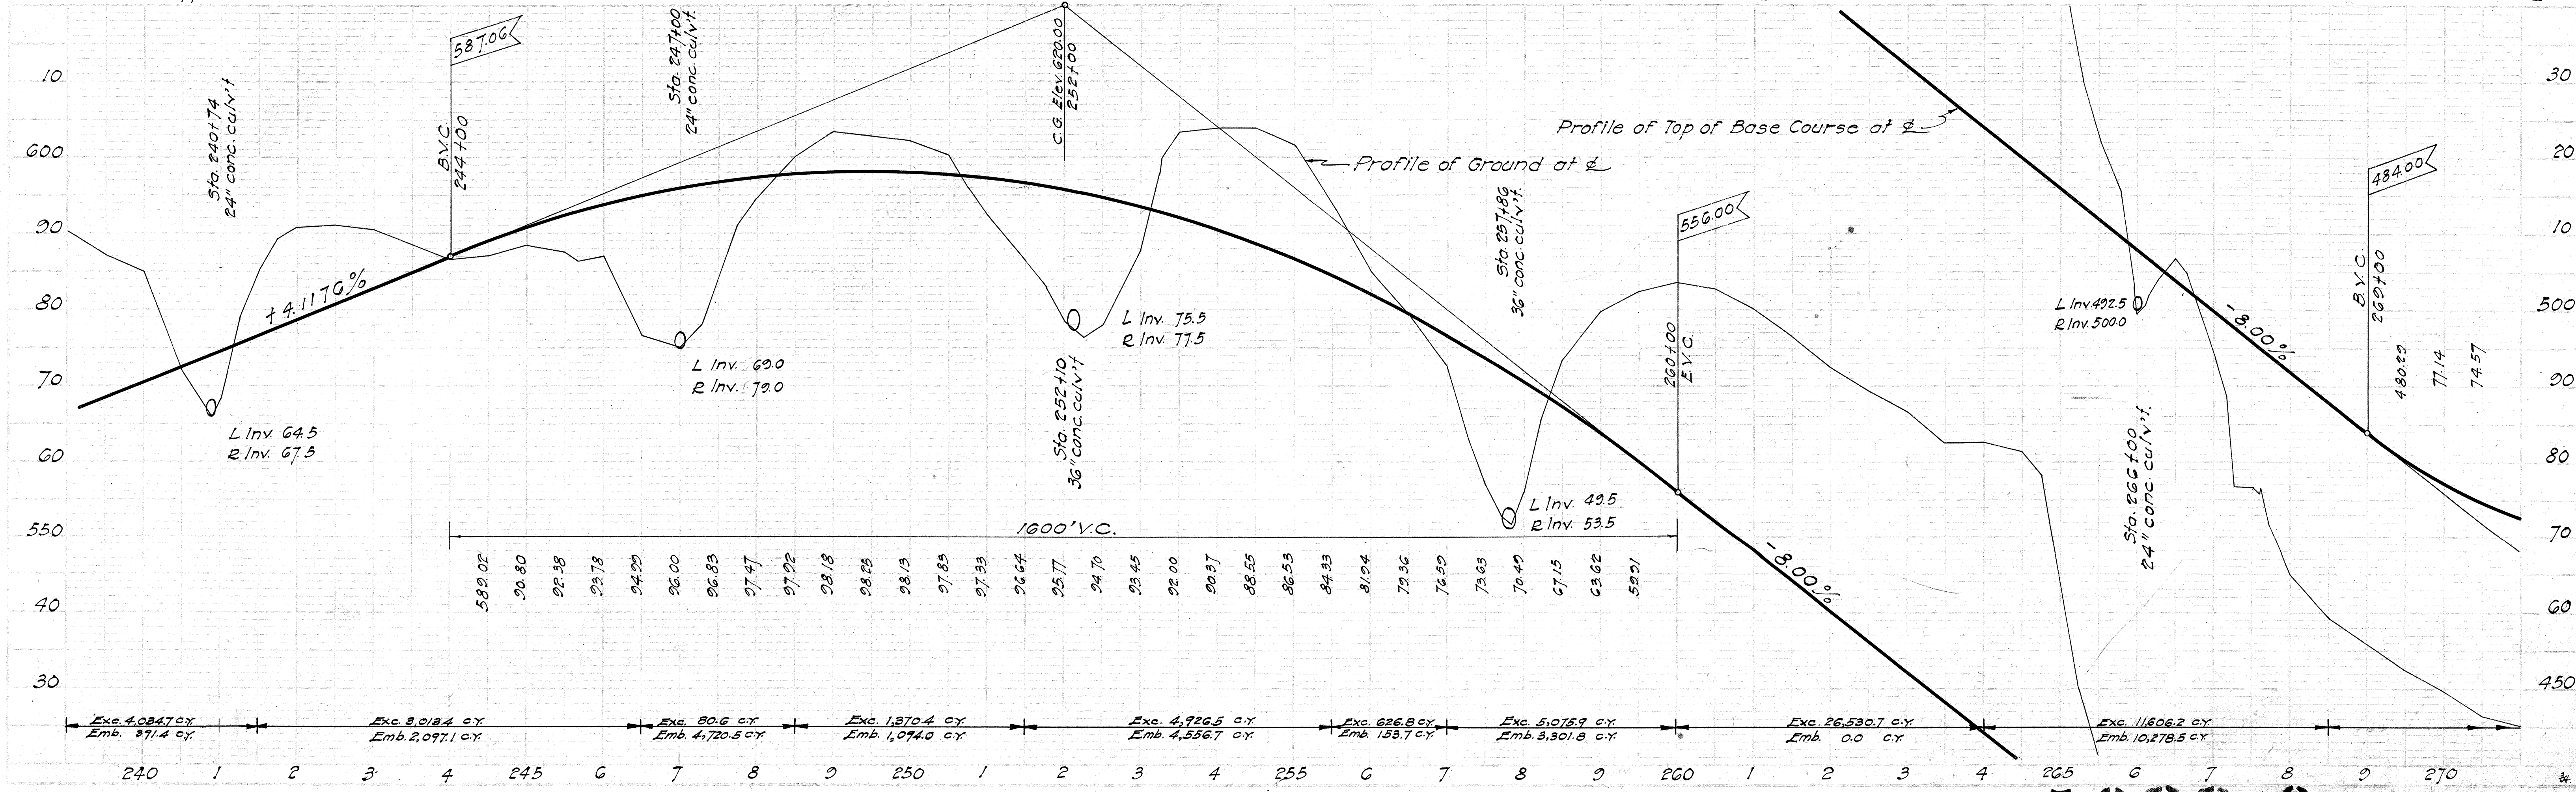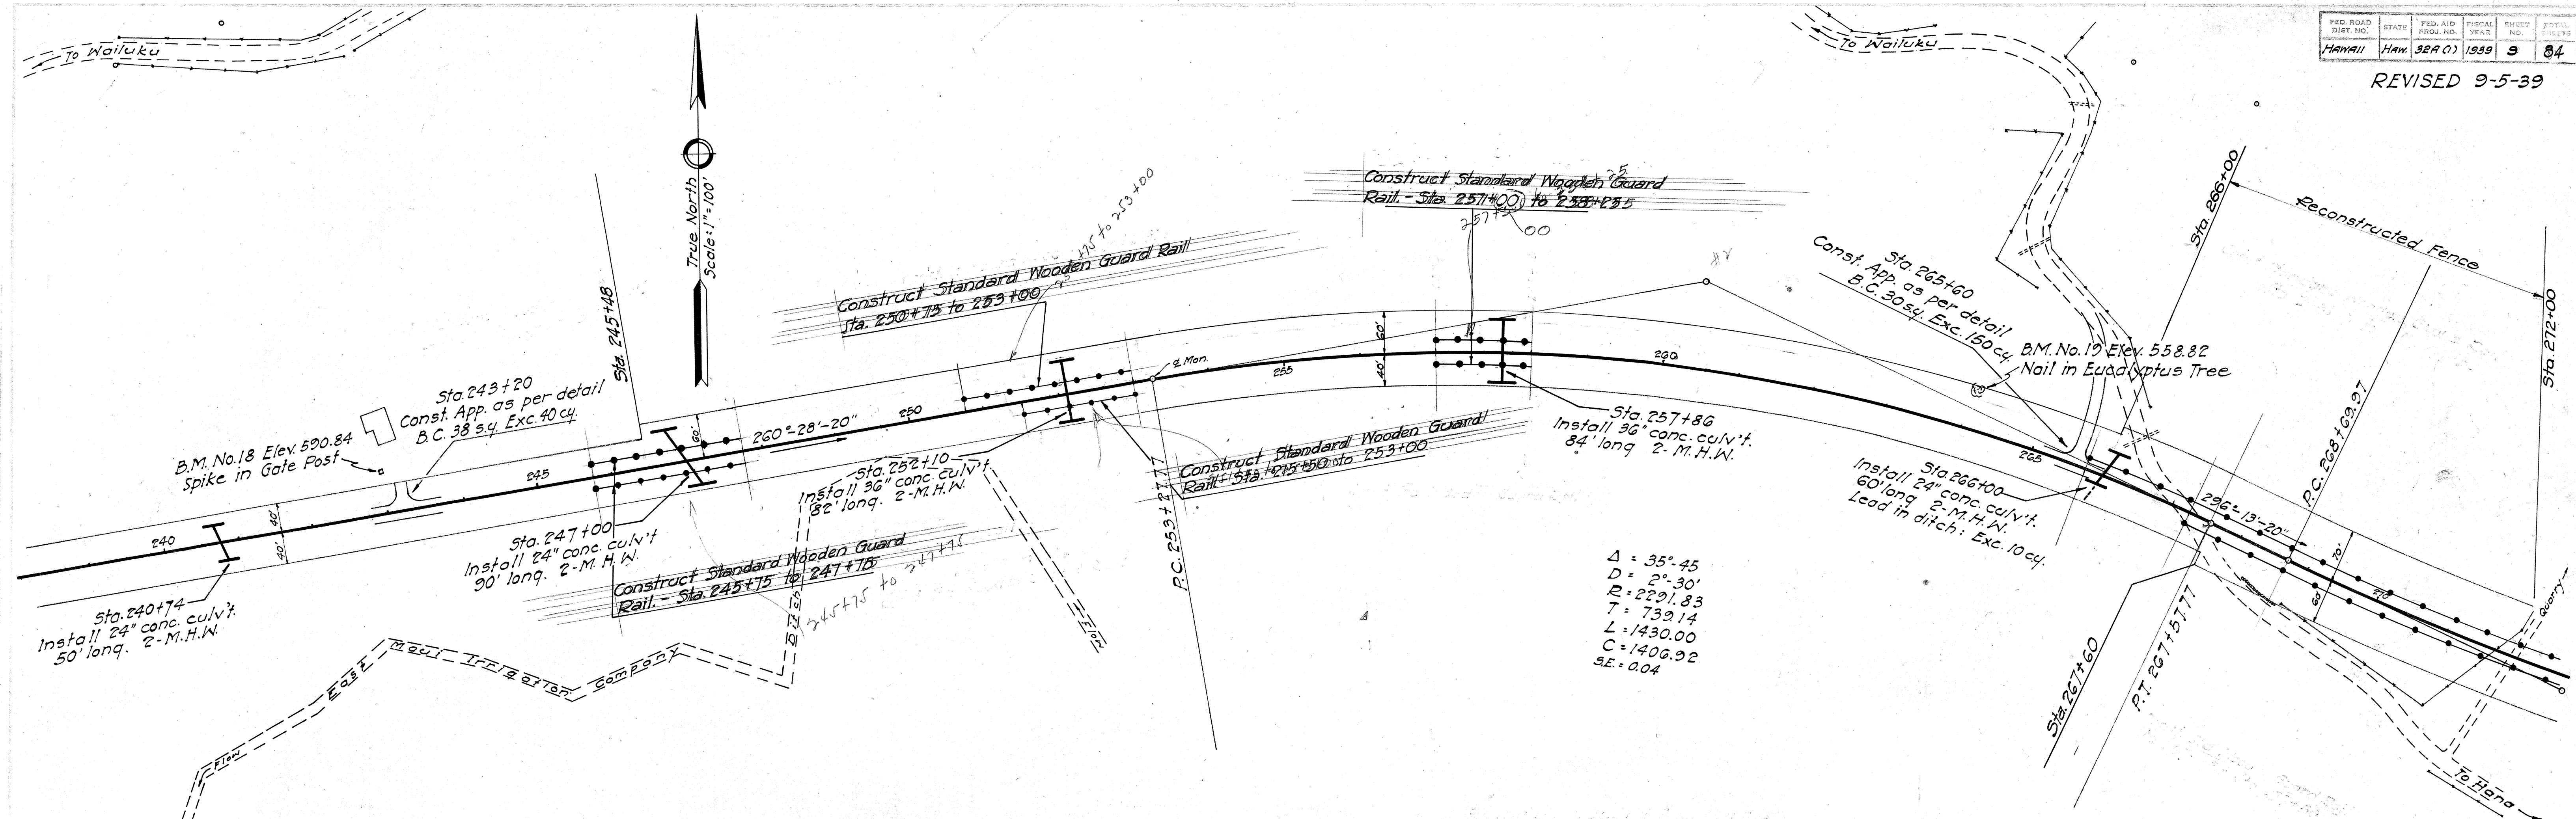

FED. ROAD DIST. NO.	STATE	FED. AID PROJ. NO.	FISCAL YEAR	SHEET NO.	TOTAL SHEETS
HAWAII	HAW.	32A (1)	1939	9	84



REVISED 9-5-39

5008.9


Revised Sept. 5, 1939
Guard Rail Eliminated

FED. ROAD DIST. NO.	STATE	FED. AID PROJ. NO.	FISCAL YEAR	SHEET NO.	TOTAL SHEETS
HAWAII	HAW	32A(1)	1939	10	84

REVISED 9-5-39

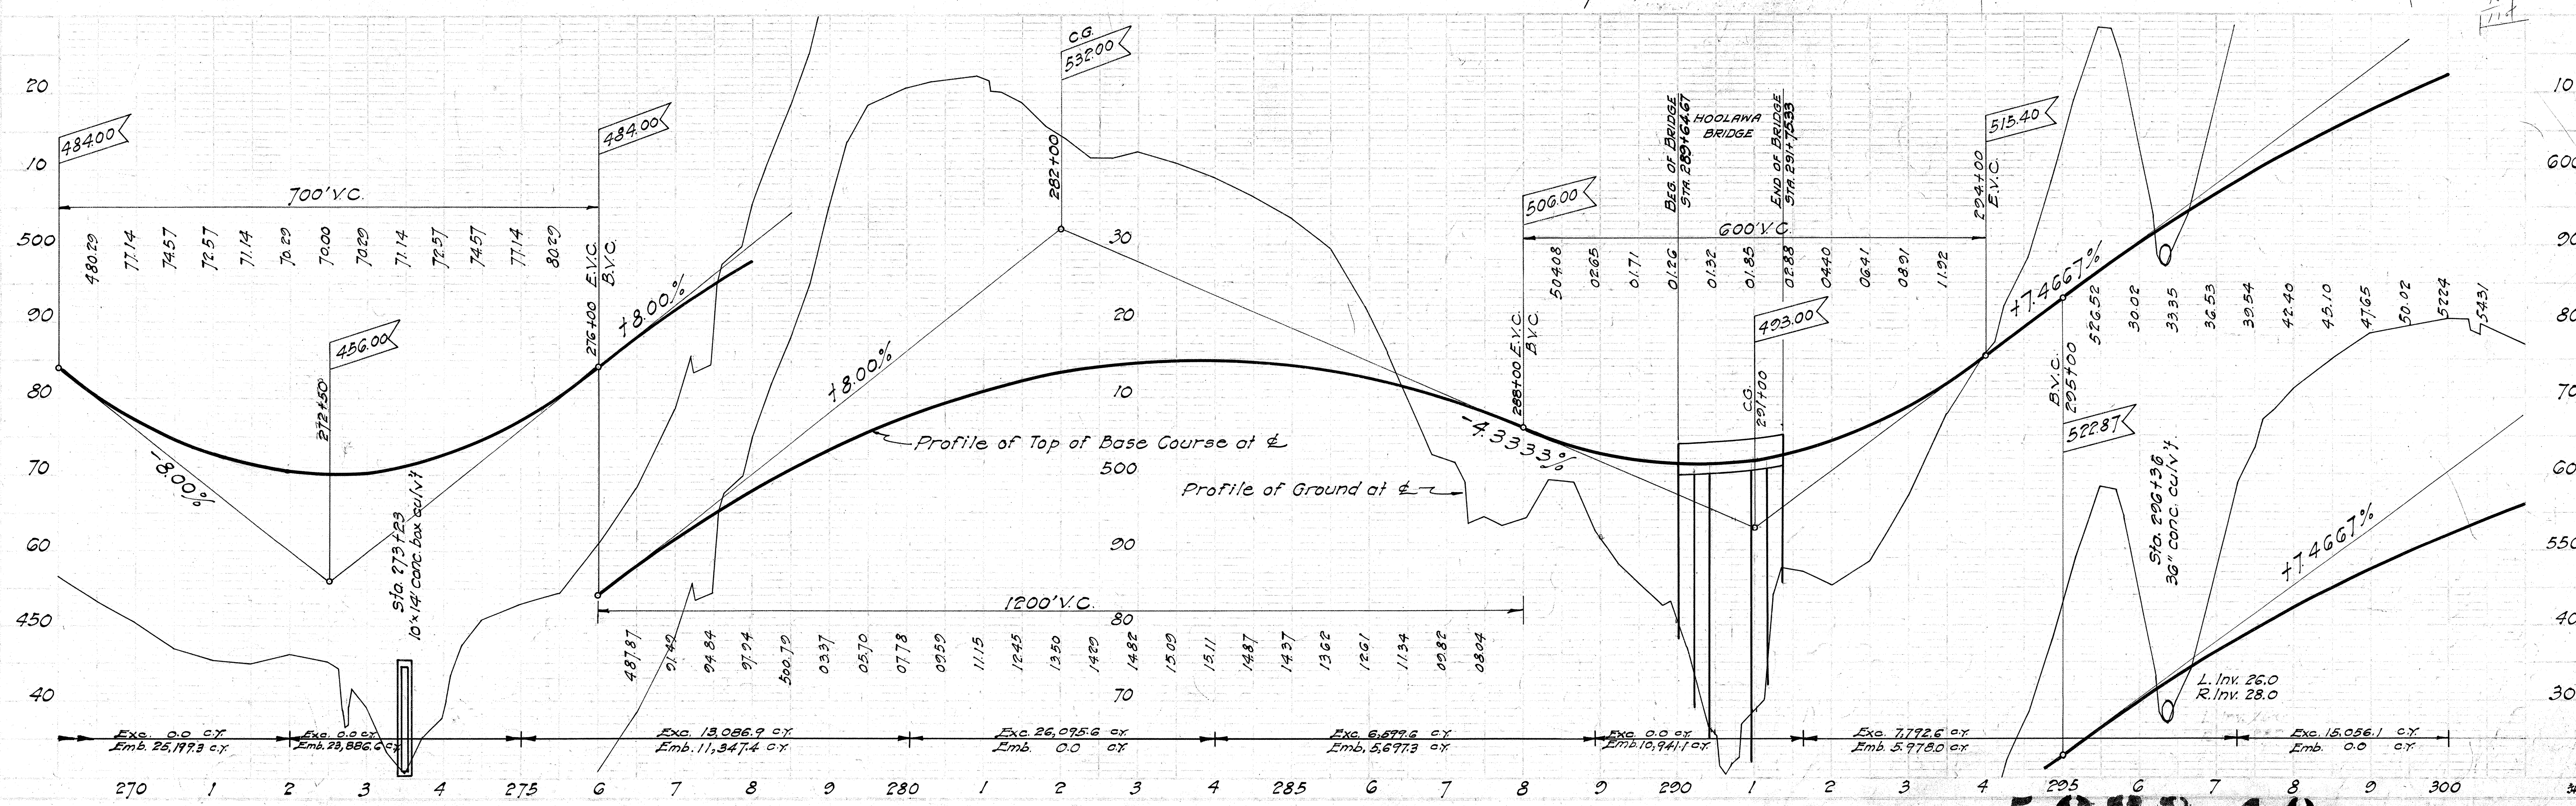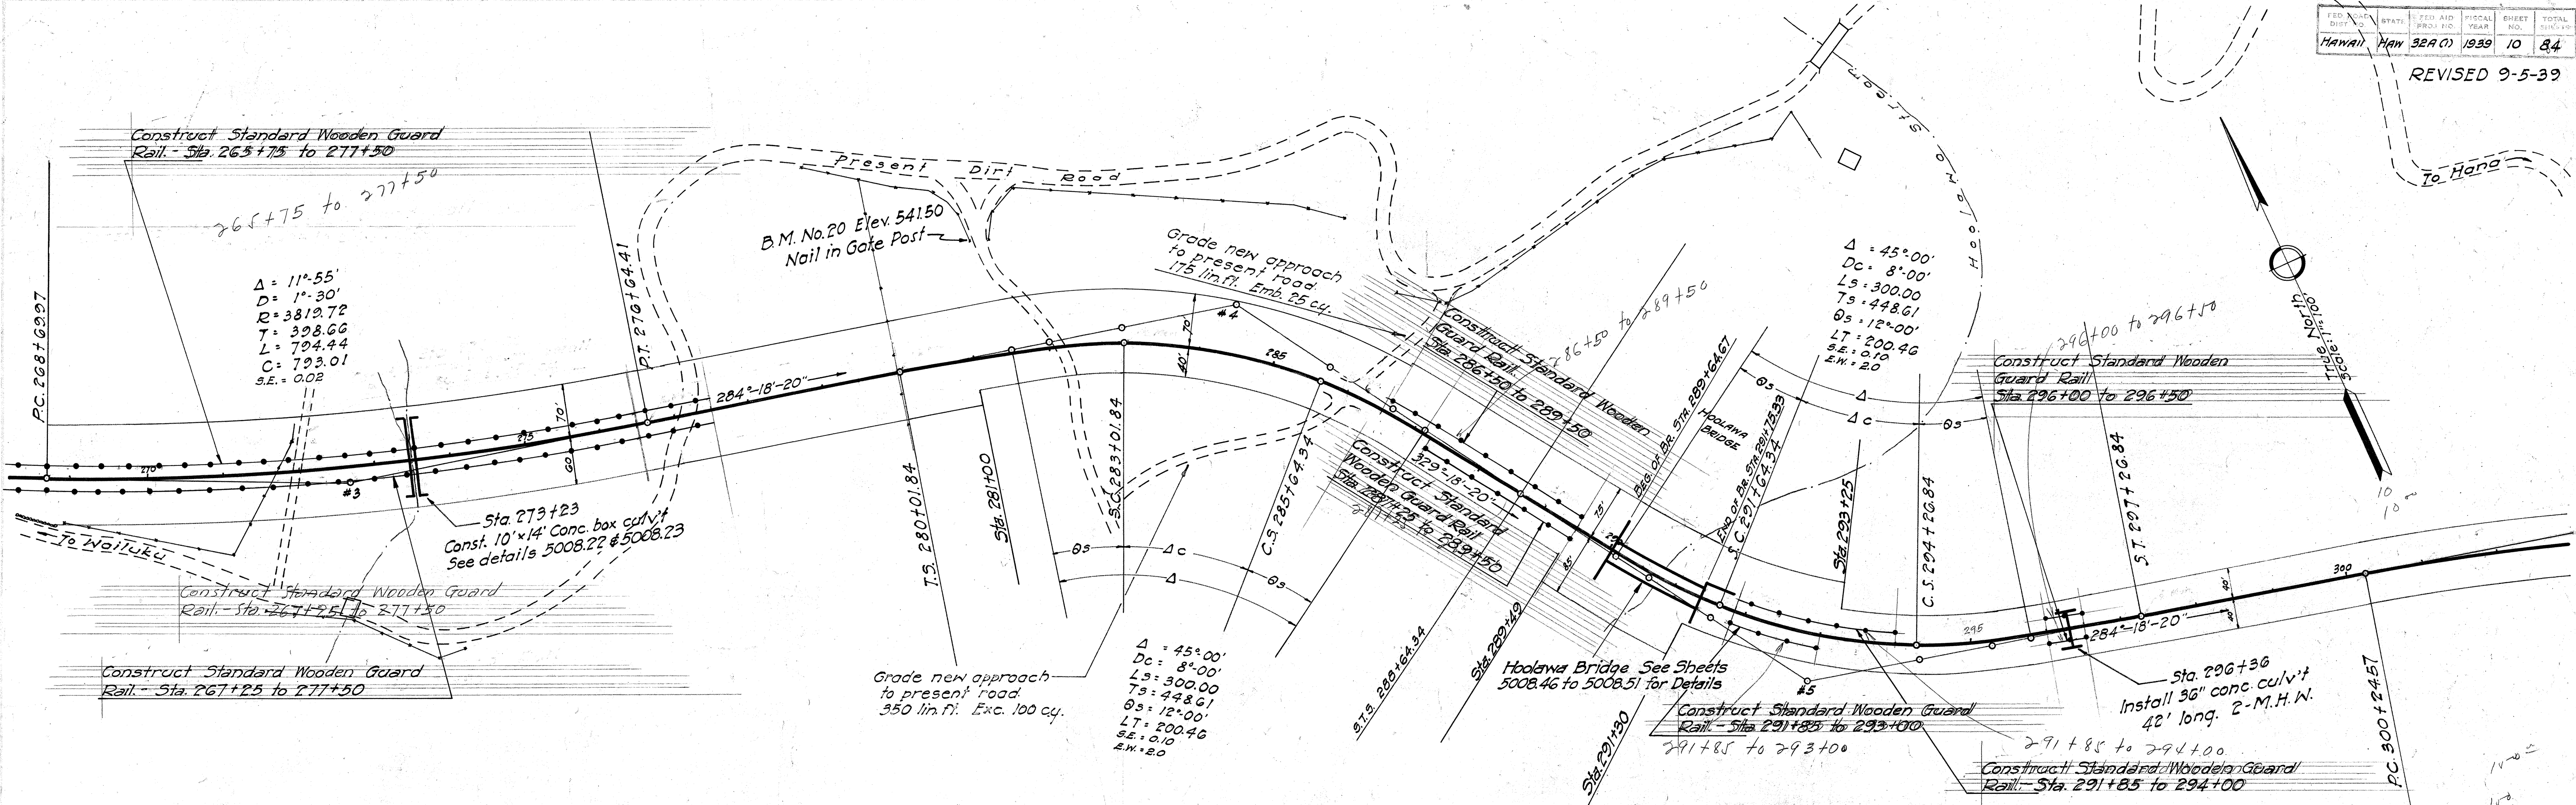

5008-10

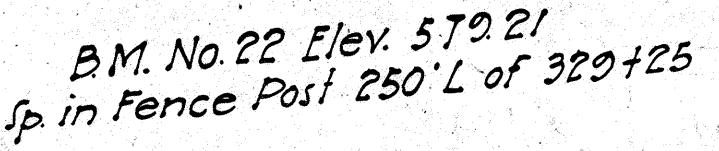

REVISED, Sept. 5, 1939
Guard Rail Eliminated