

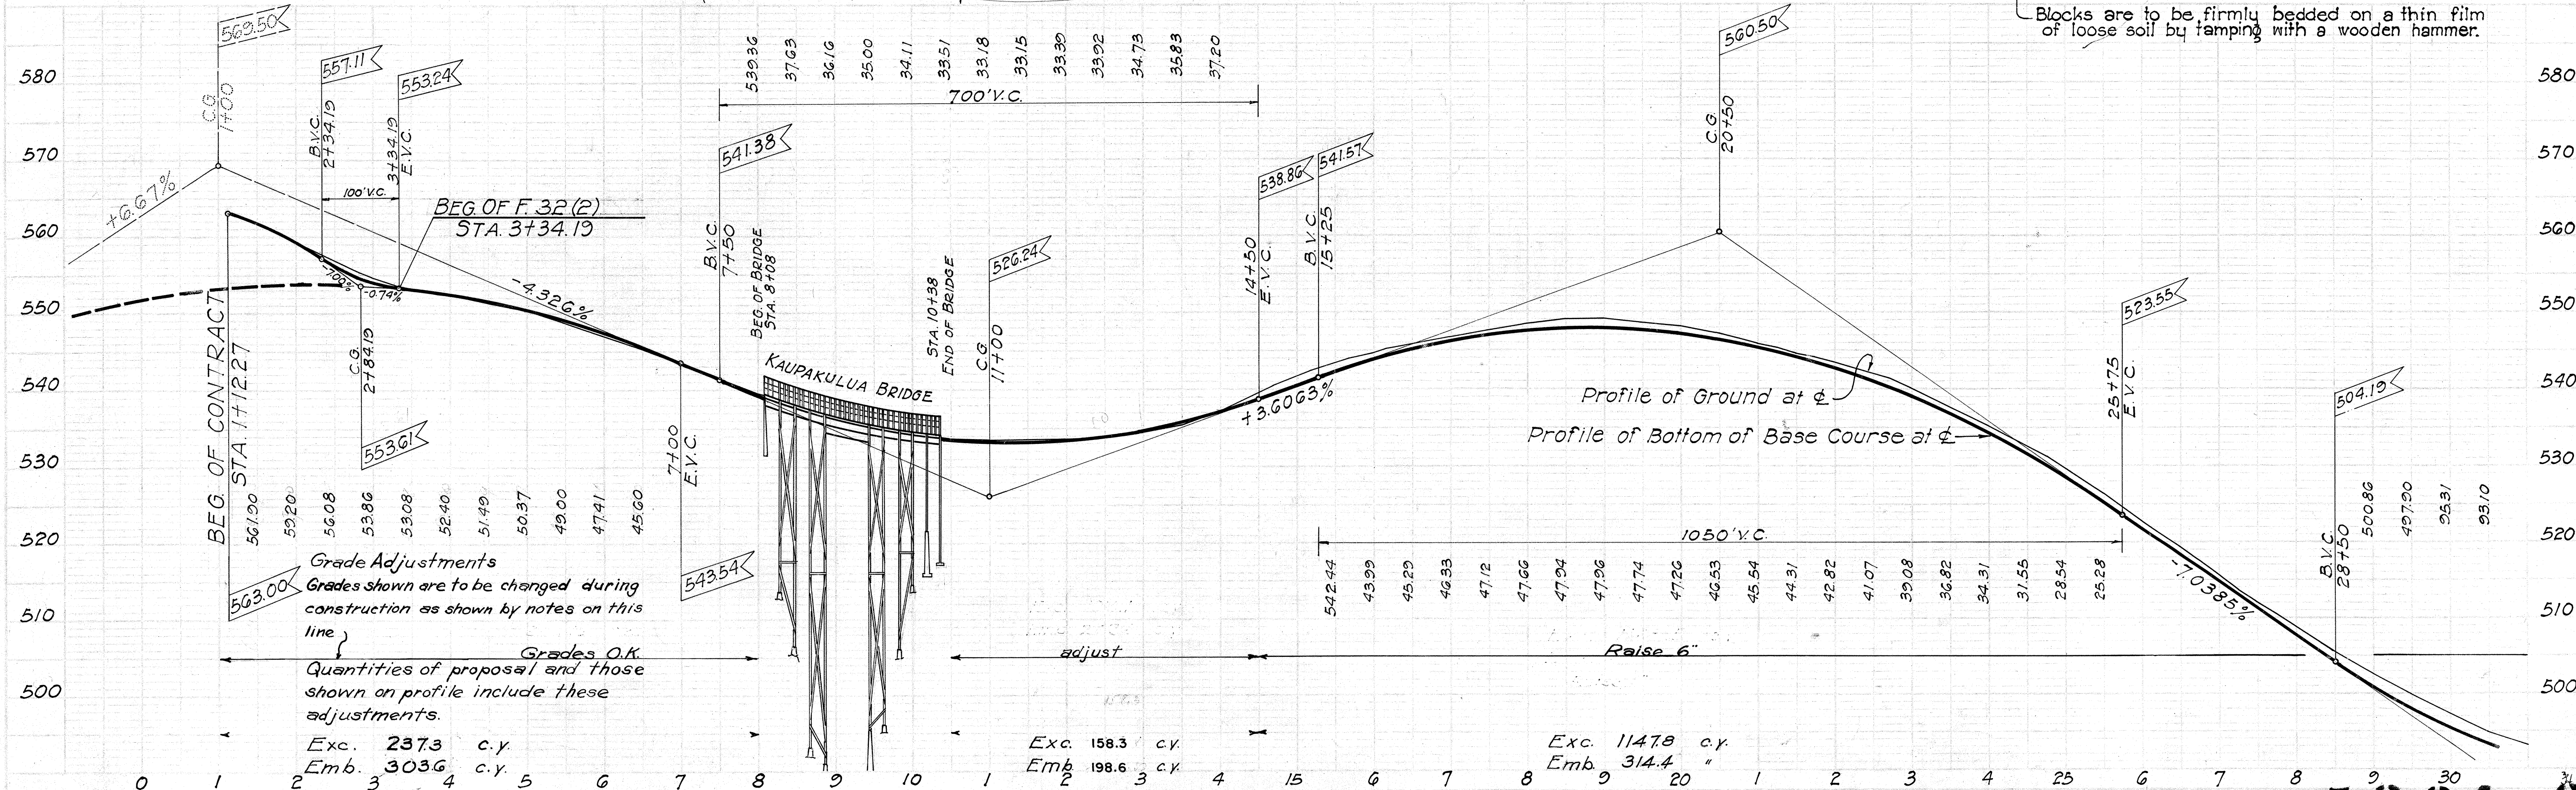
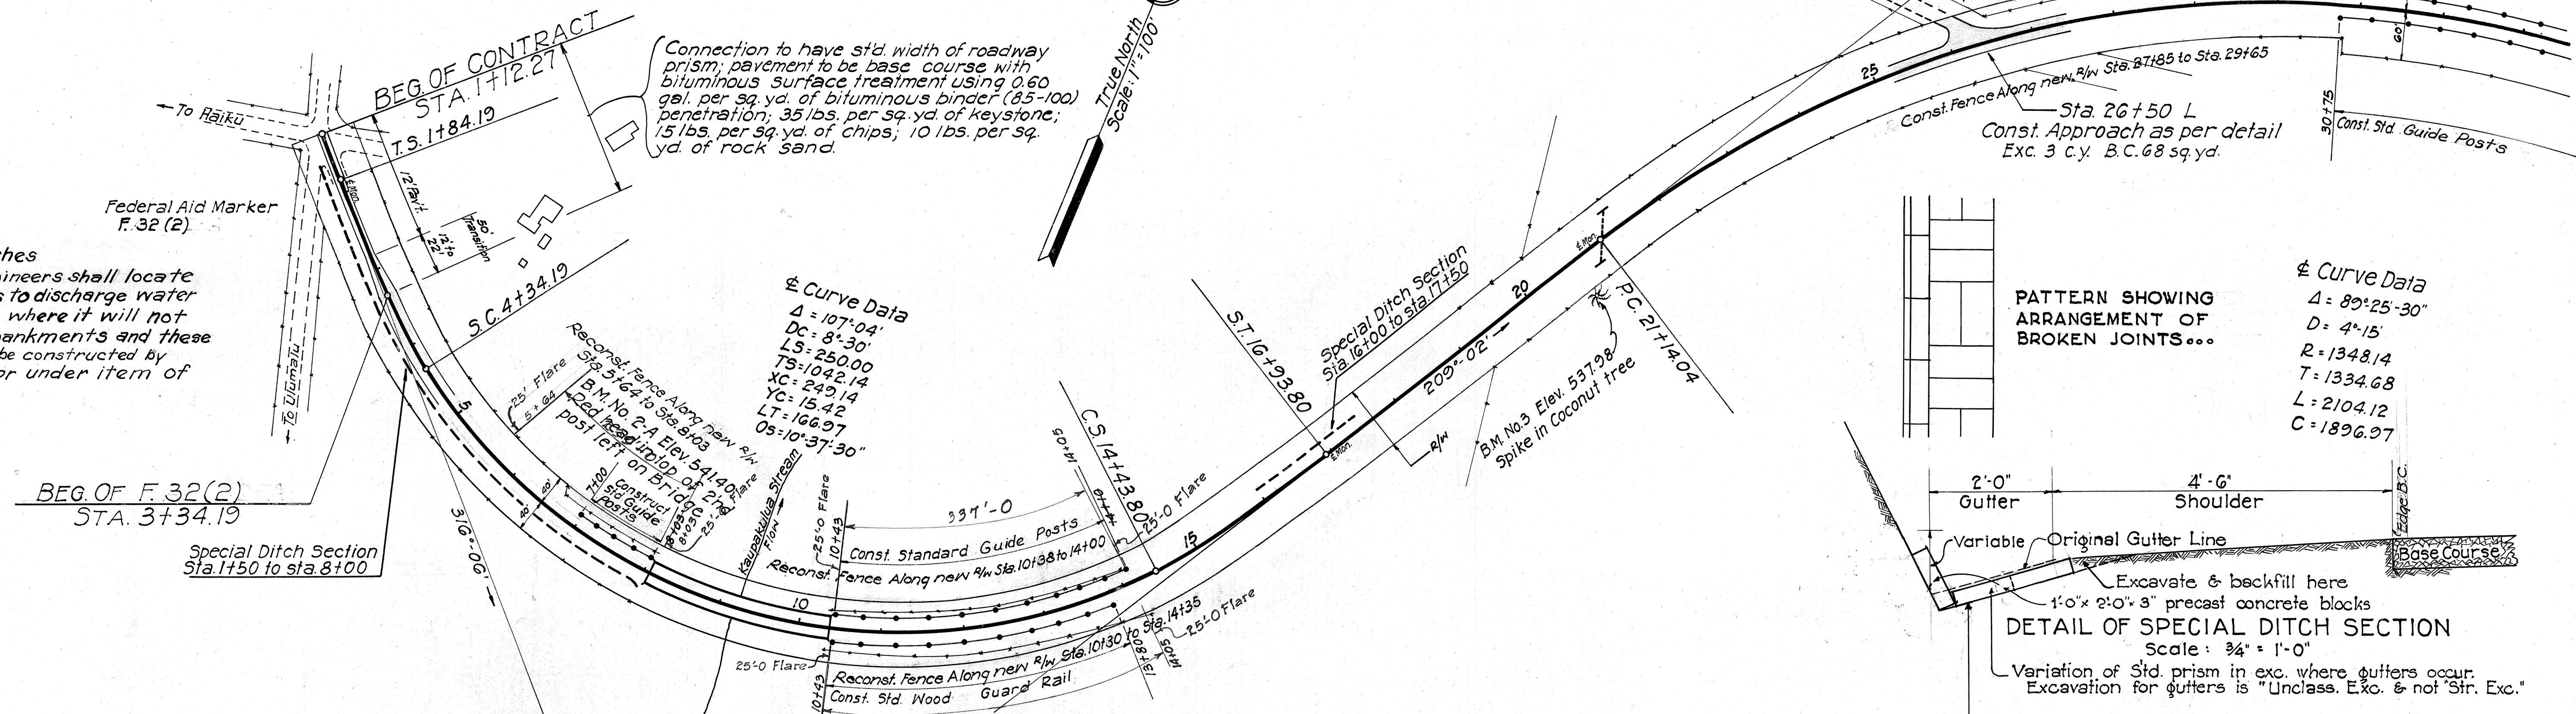


NOTE:-
Intersection of existing roads at
Beginning of Contract Sta. 1+12.27 shall
be graded as directed by the Engineer.
500 c.y. unclassified excavation included
in contract quantities for this purpose.

Relief Ditches
Resident Engineers shall locate
relief ditches to discharge water
from gutters where it will not
wash out embankments and these
ditches shall be constructed by
the contractor under item of
"Uncl. Exc."


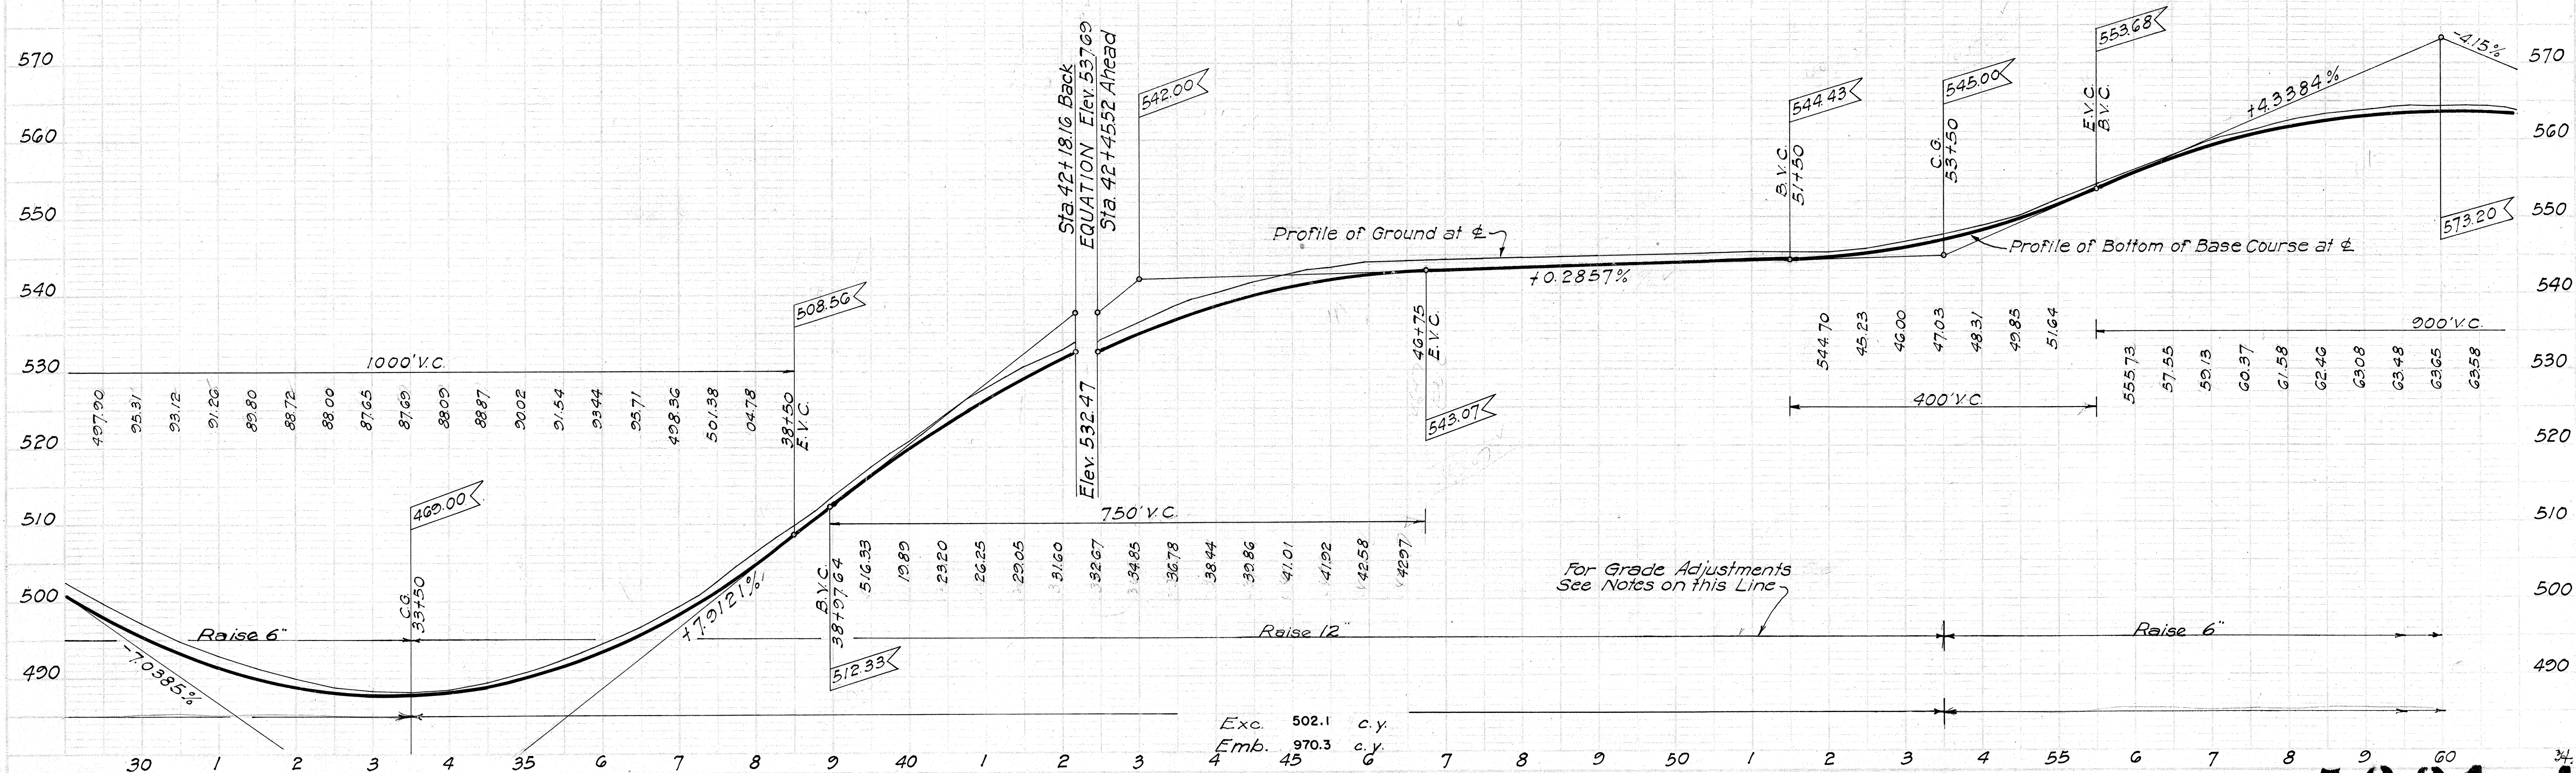


5221.3

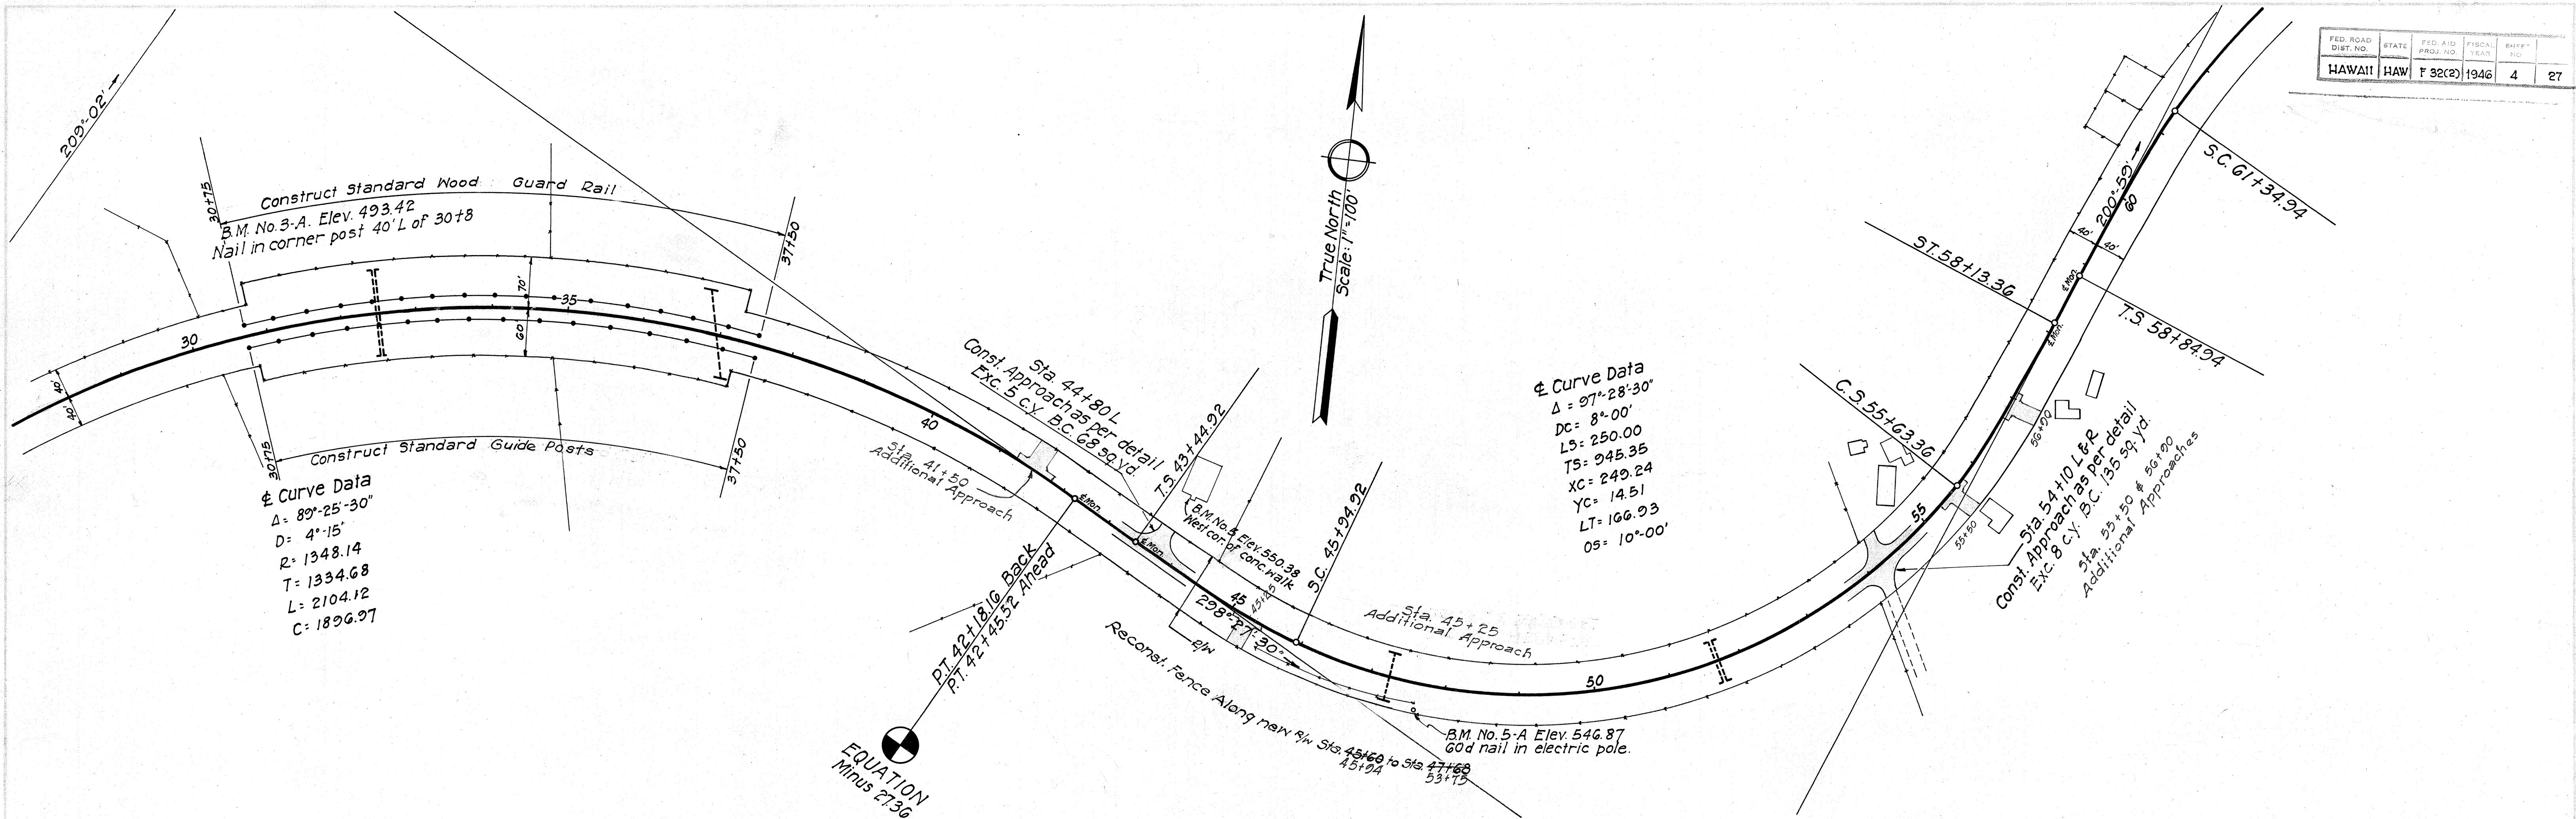


PLAN
 CURVES
 NOTE: SHOW ALIGNMENT CHANGES
 BY J. W. HARRIS


PROFILES
 CURVES
 NOTE: SHOW GRADES, CHANGES
 BY J. W. HARRIS

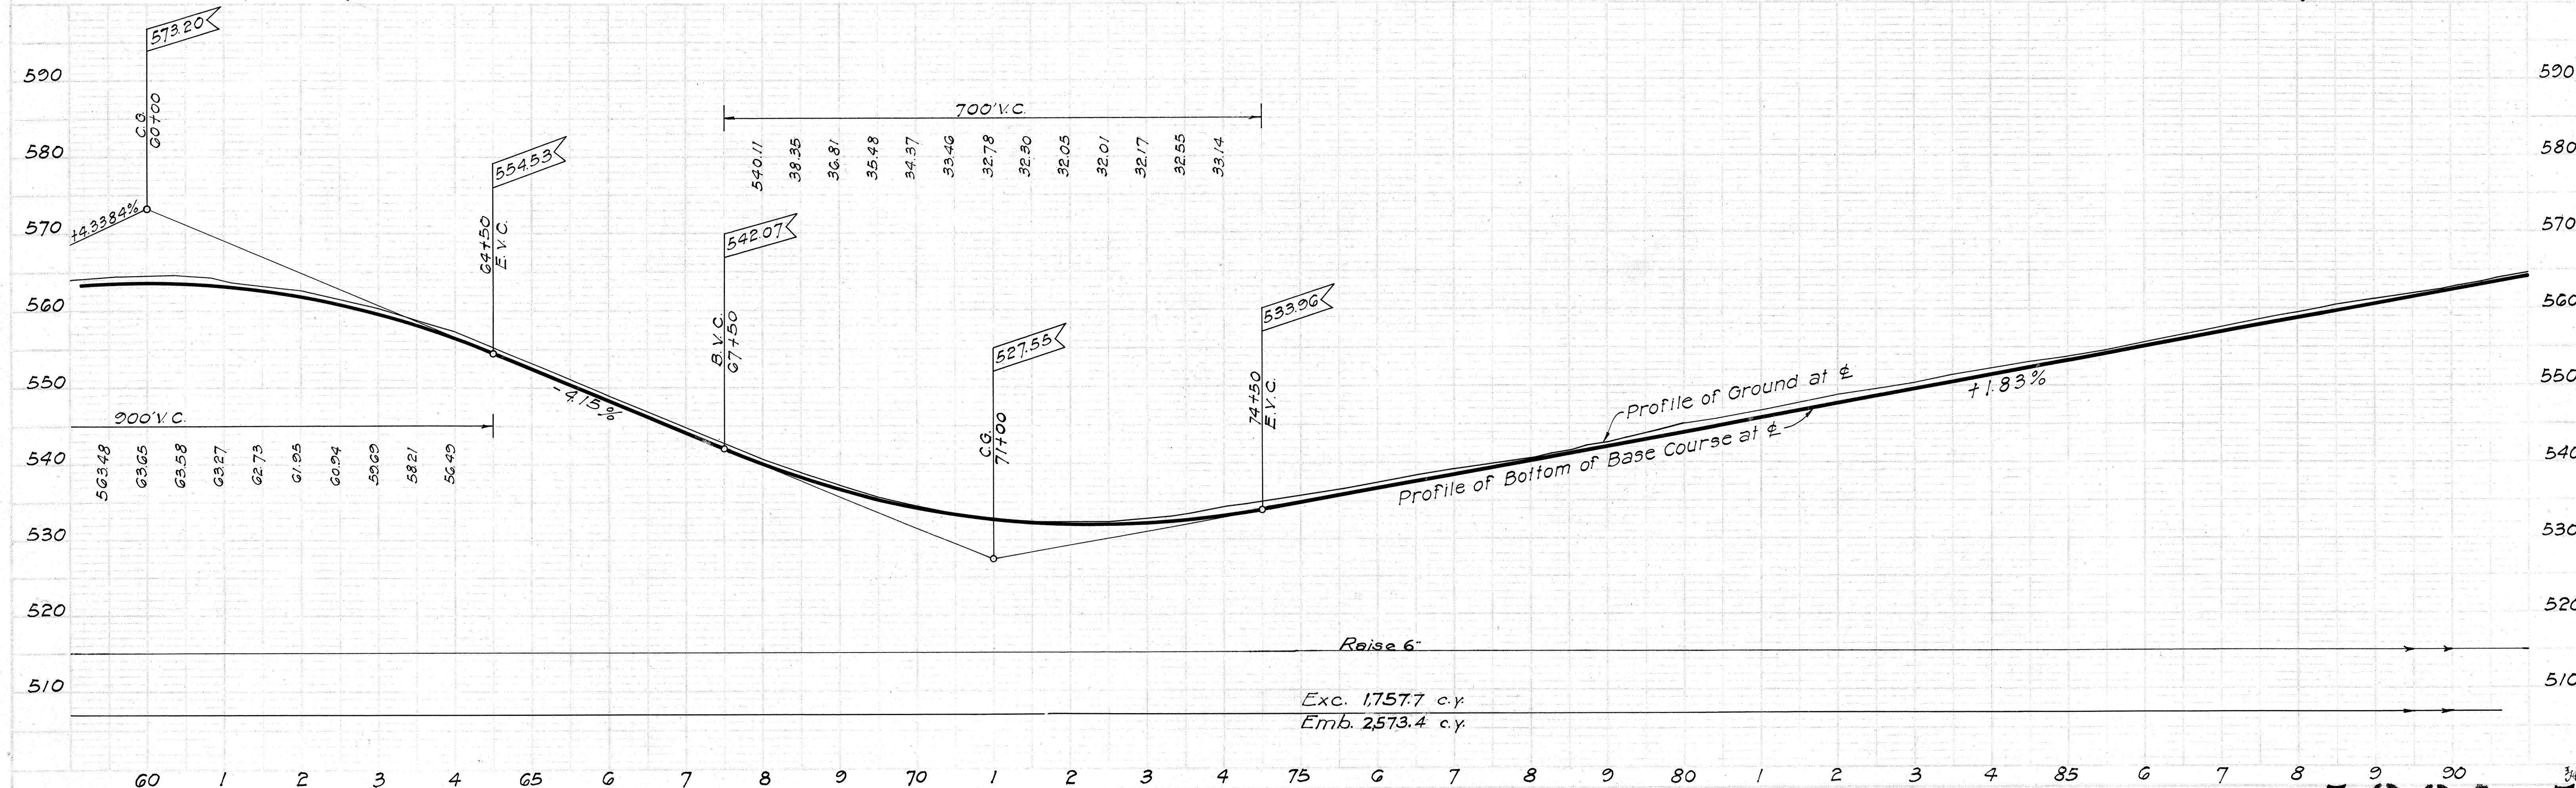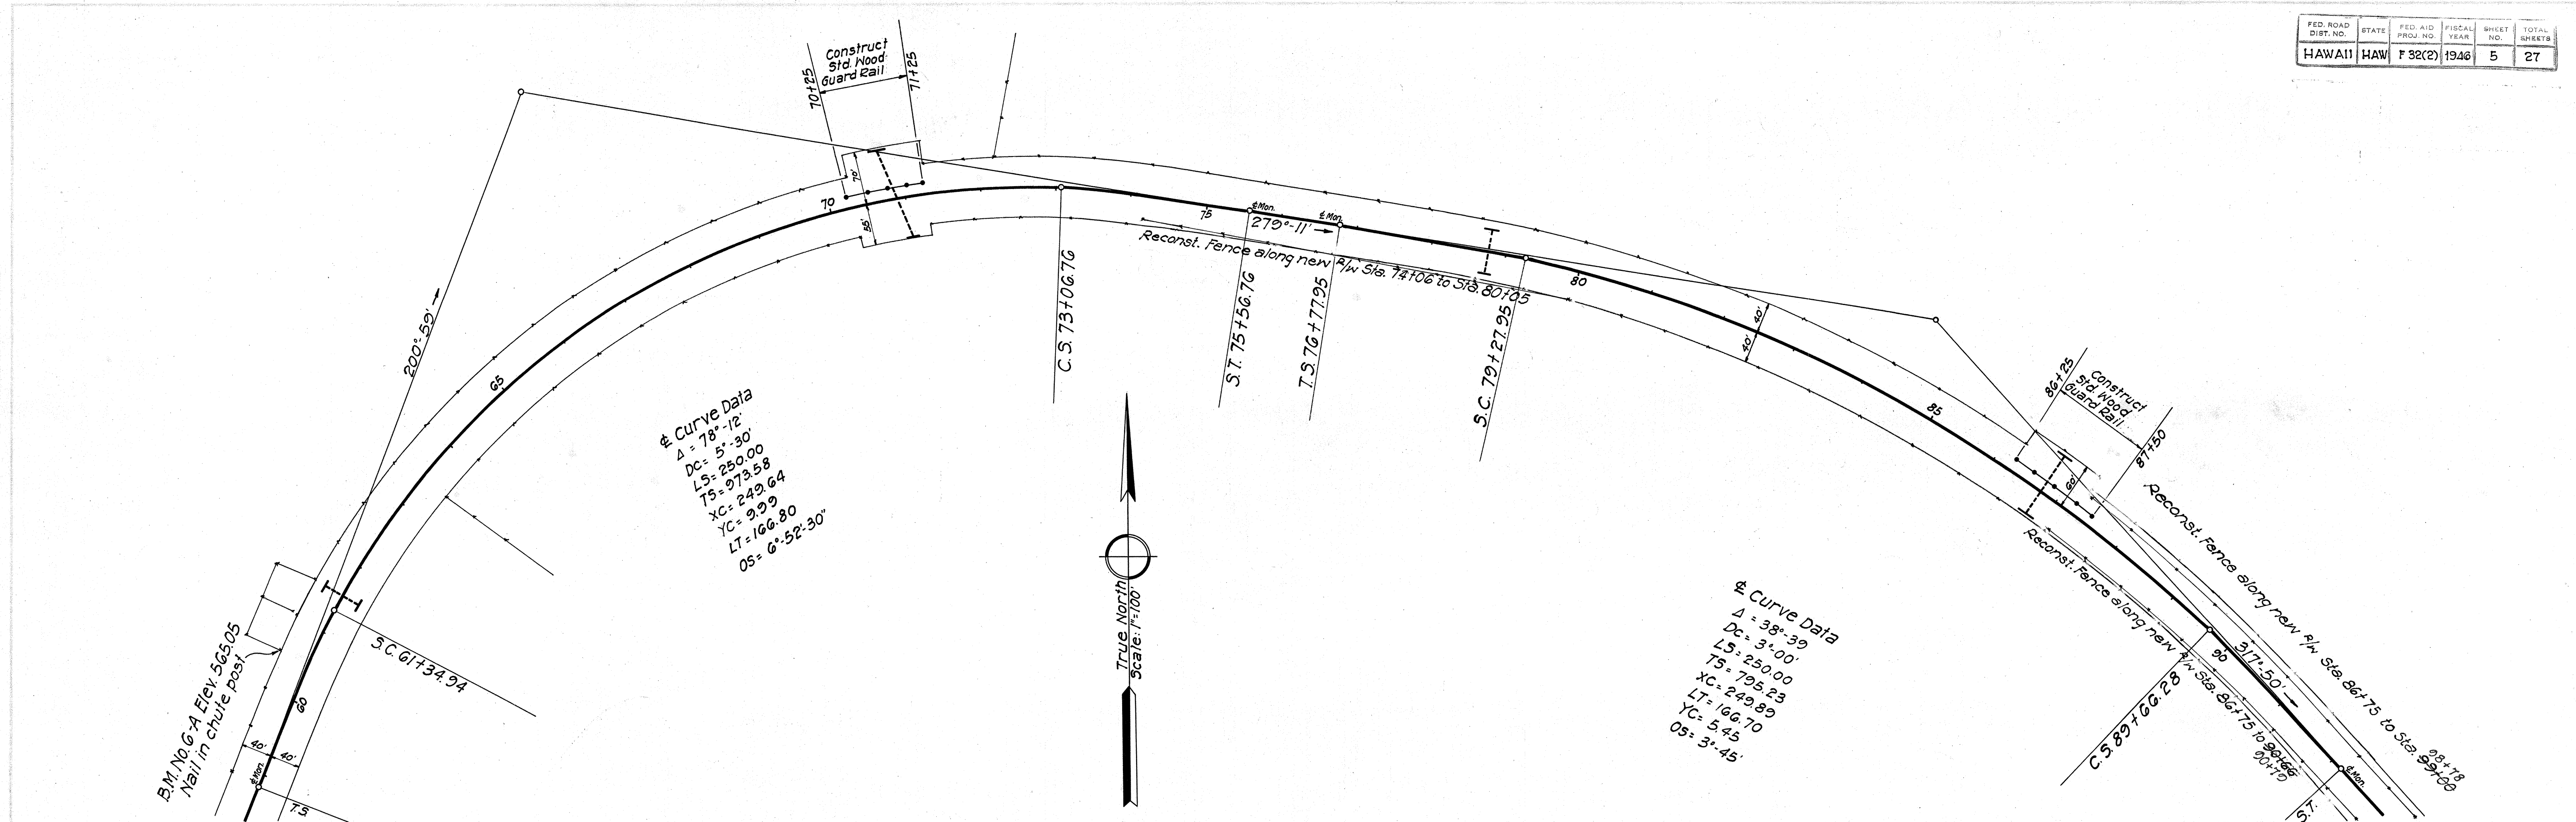



PLAN
SURVEYED
NOTED
BY
DATE

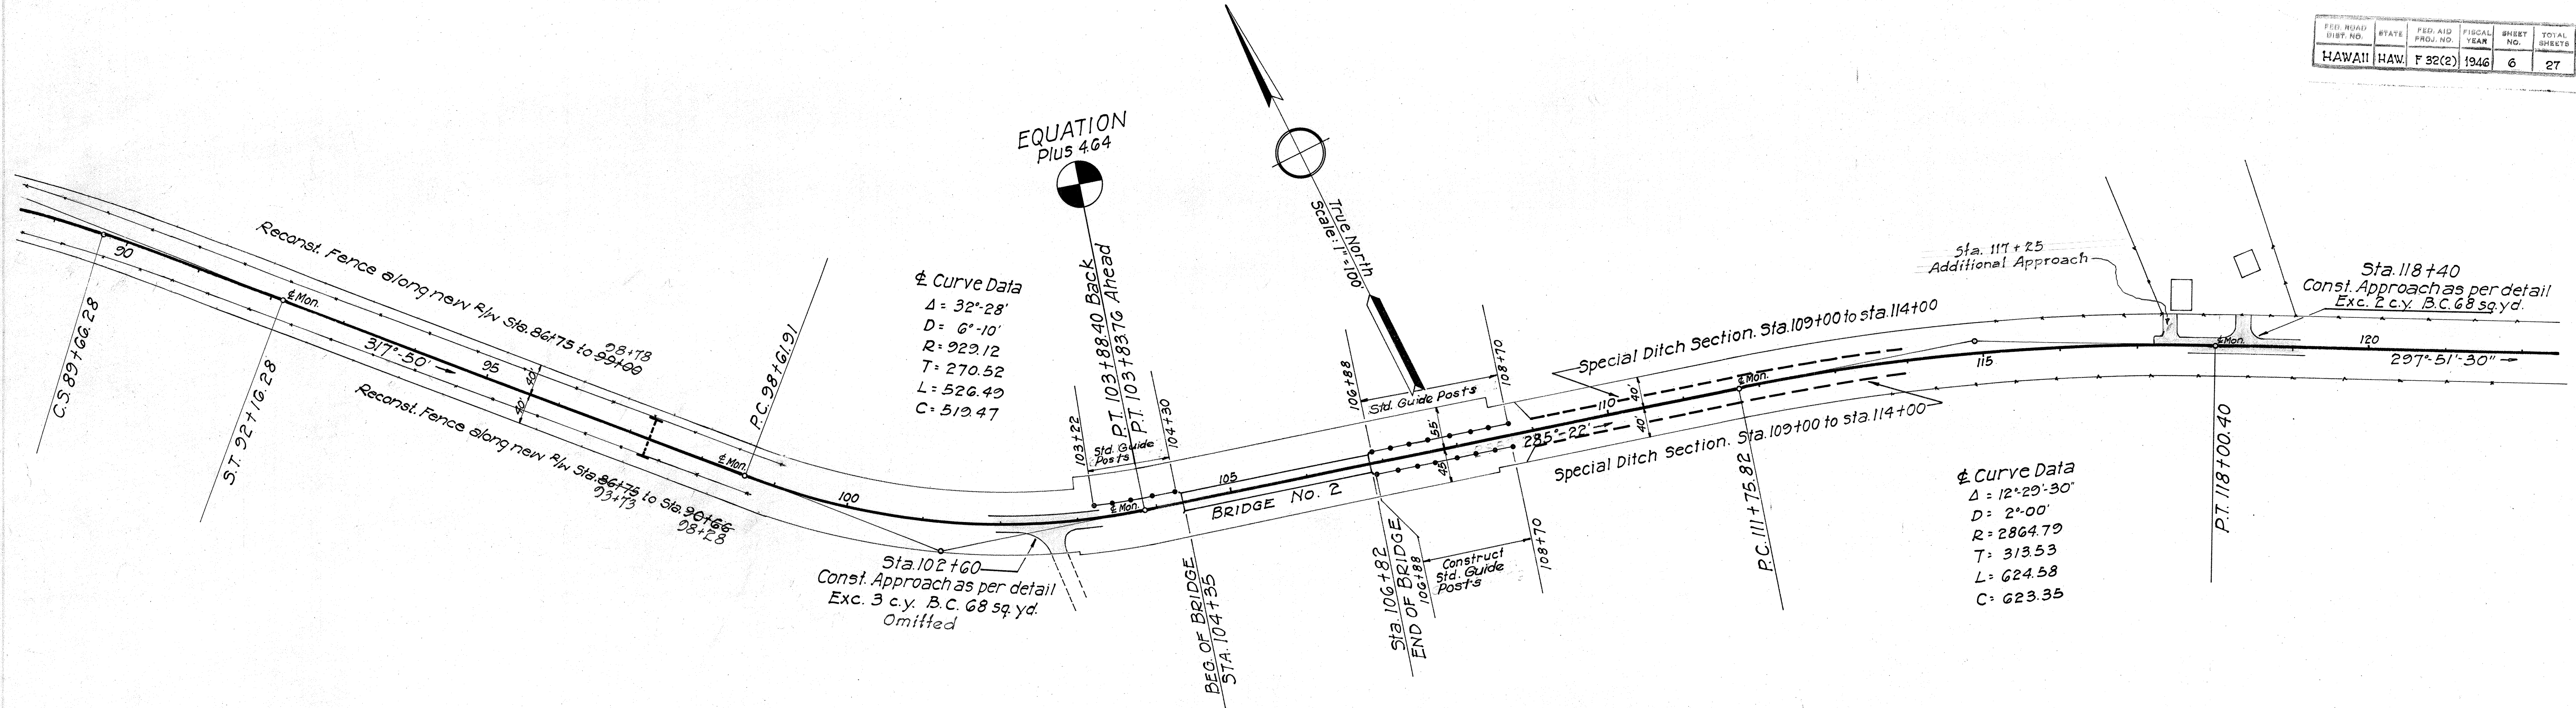

PROFILE
SURVEYED
NOTED
BY
DATE


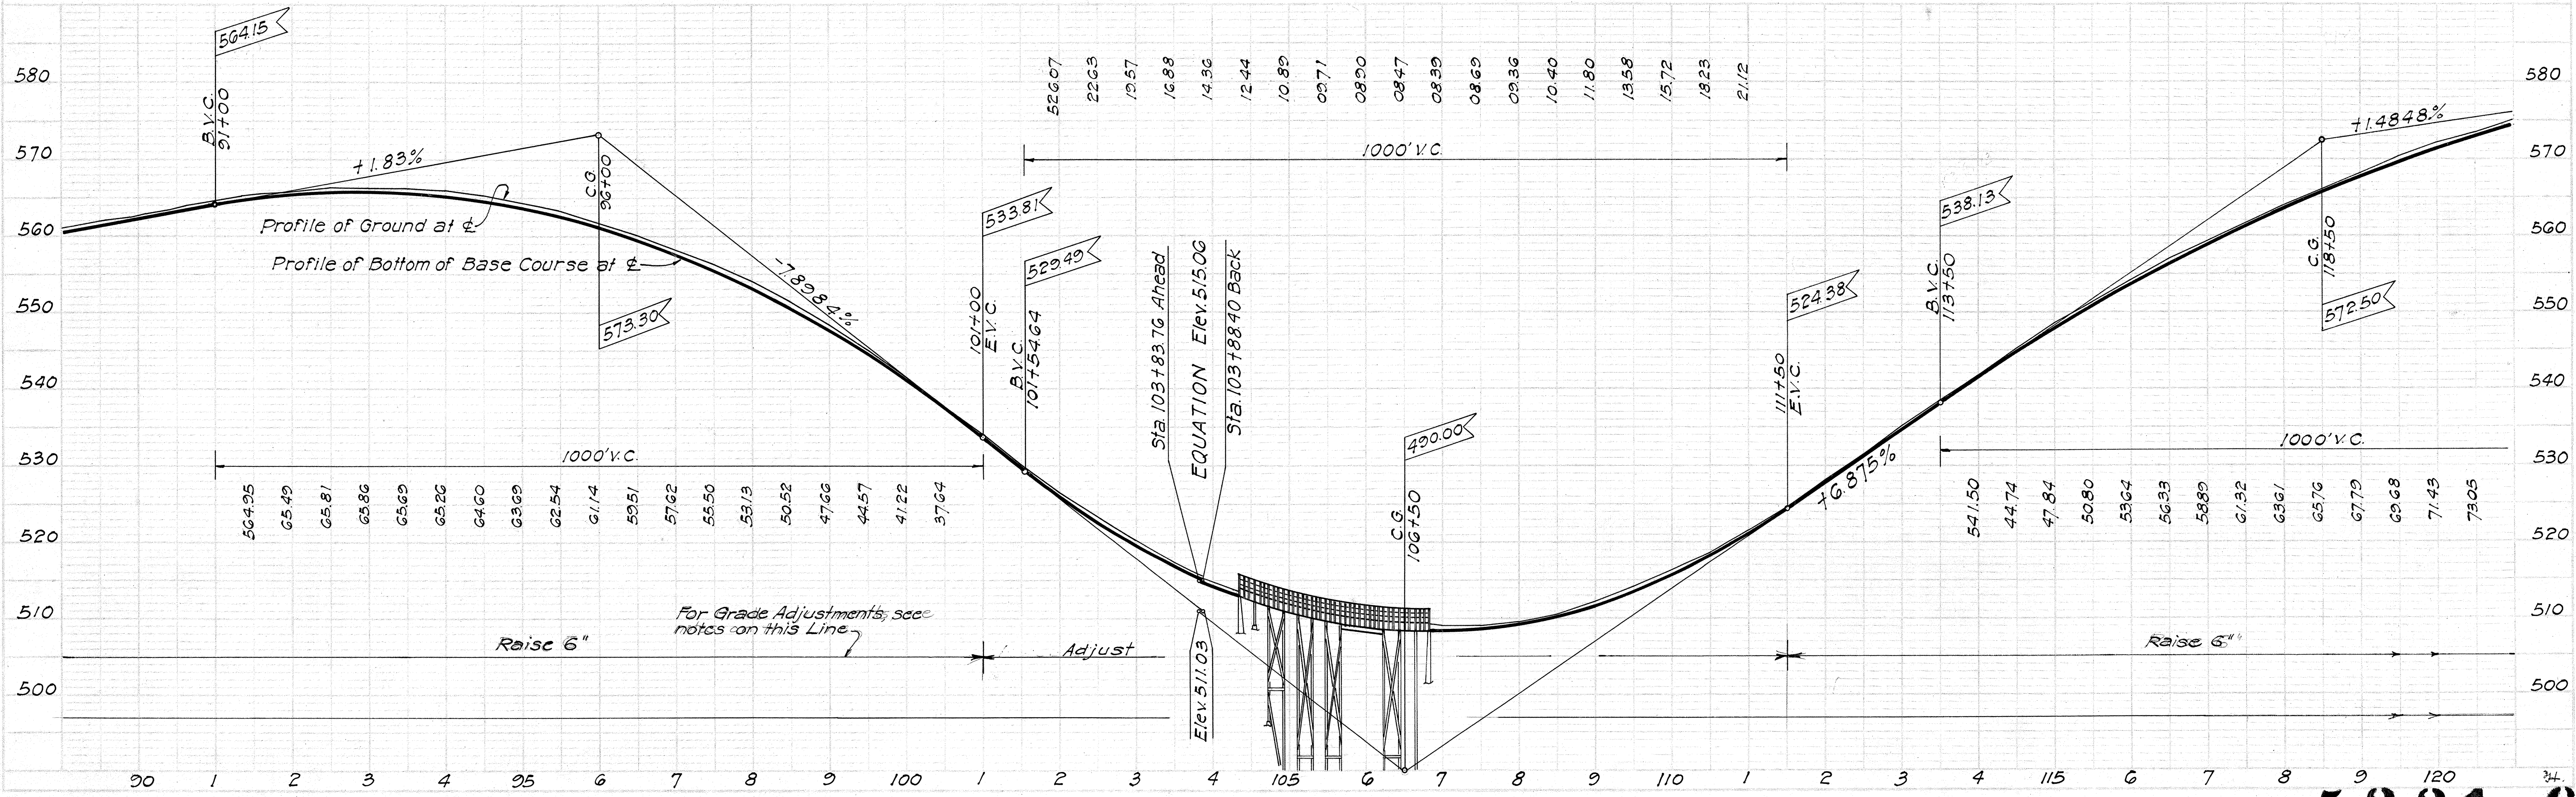


FED. ROAD DIST. NO.	STATE	FED. AID PROJ. NO.	YEAR	NO.	SHEET
HAWAII	HAW	F 32(2)	1946	7	27

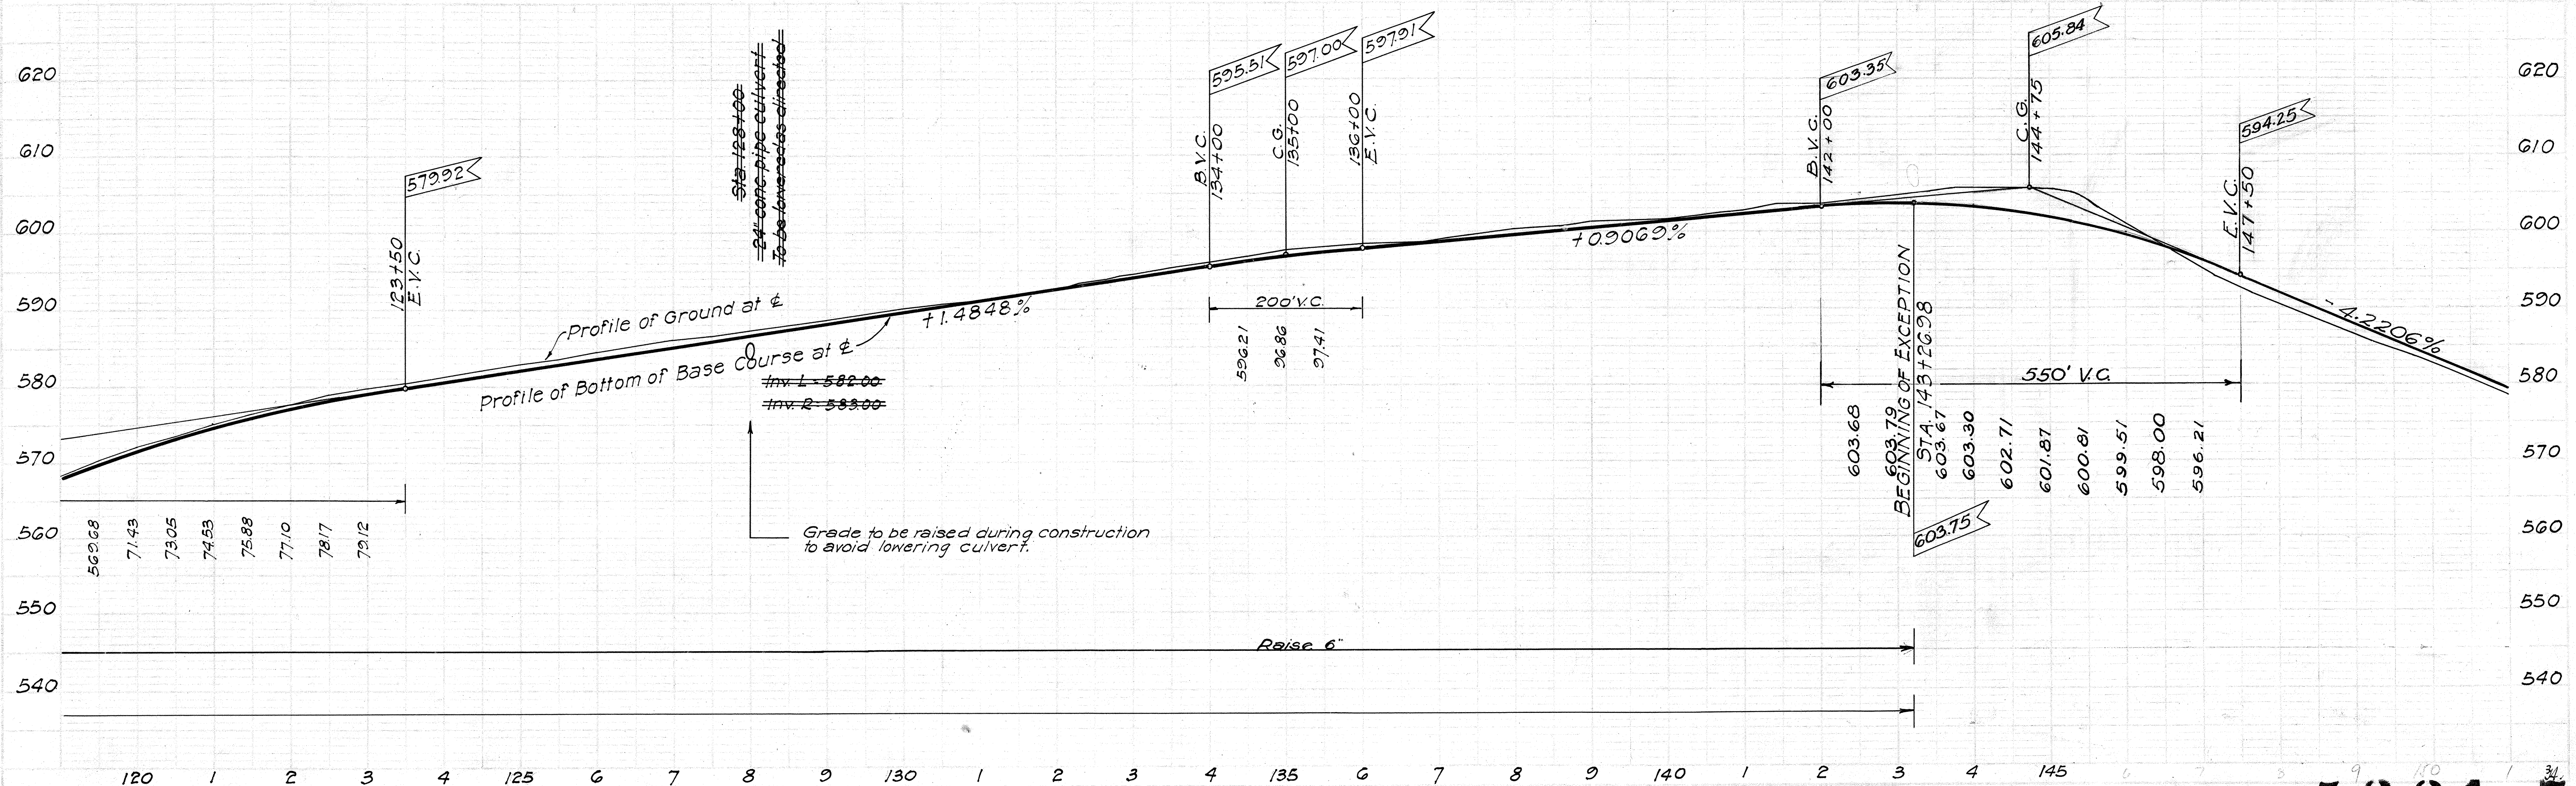
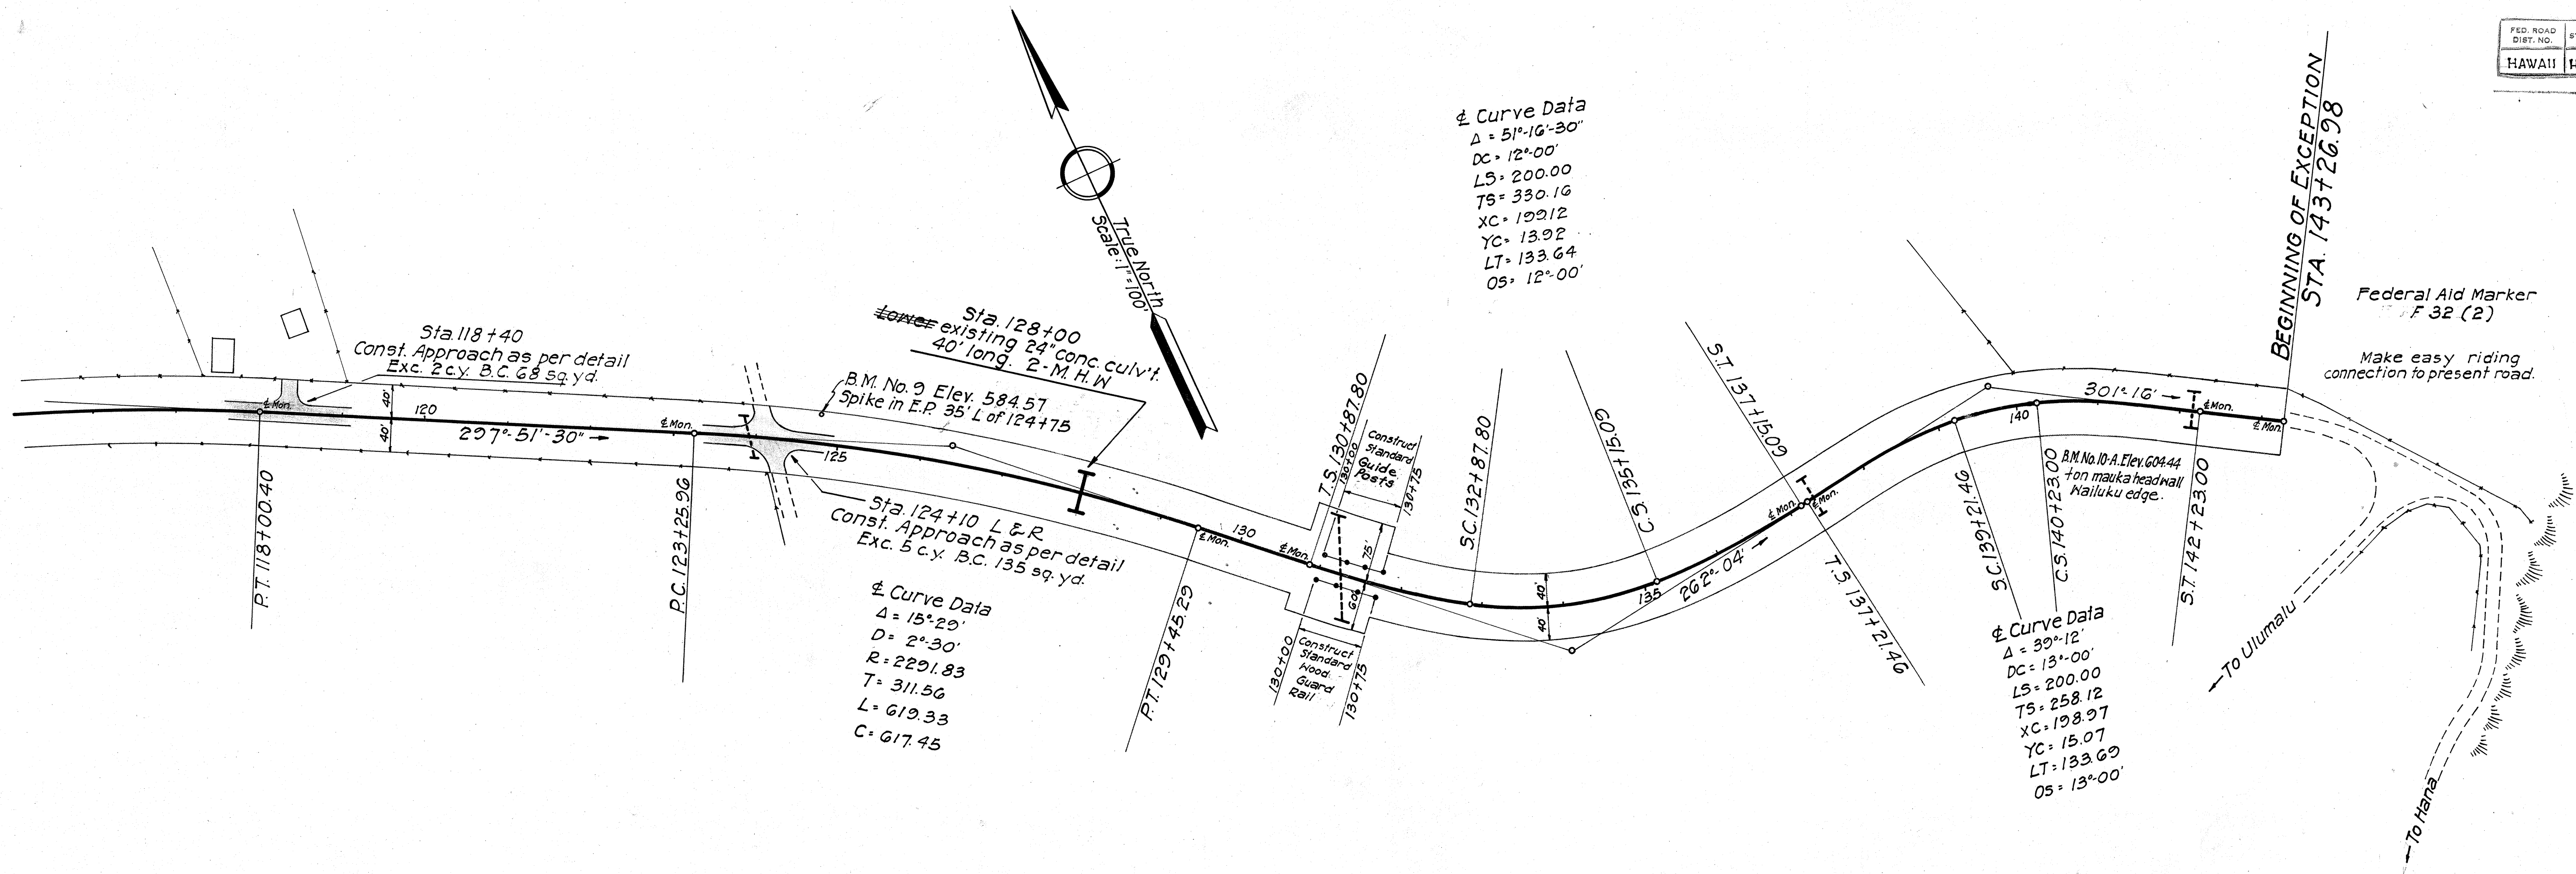



5221.7


FED. ROAD DIST. NO.	STATE	FED. AID PROJ. NO.	FISCAL YEAR	SHEET NO.	TOTAL SHEETS
HAWAII	HAW	F 32(2)	1946	8	27

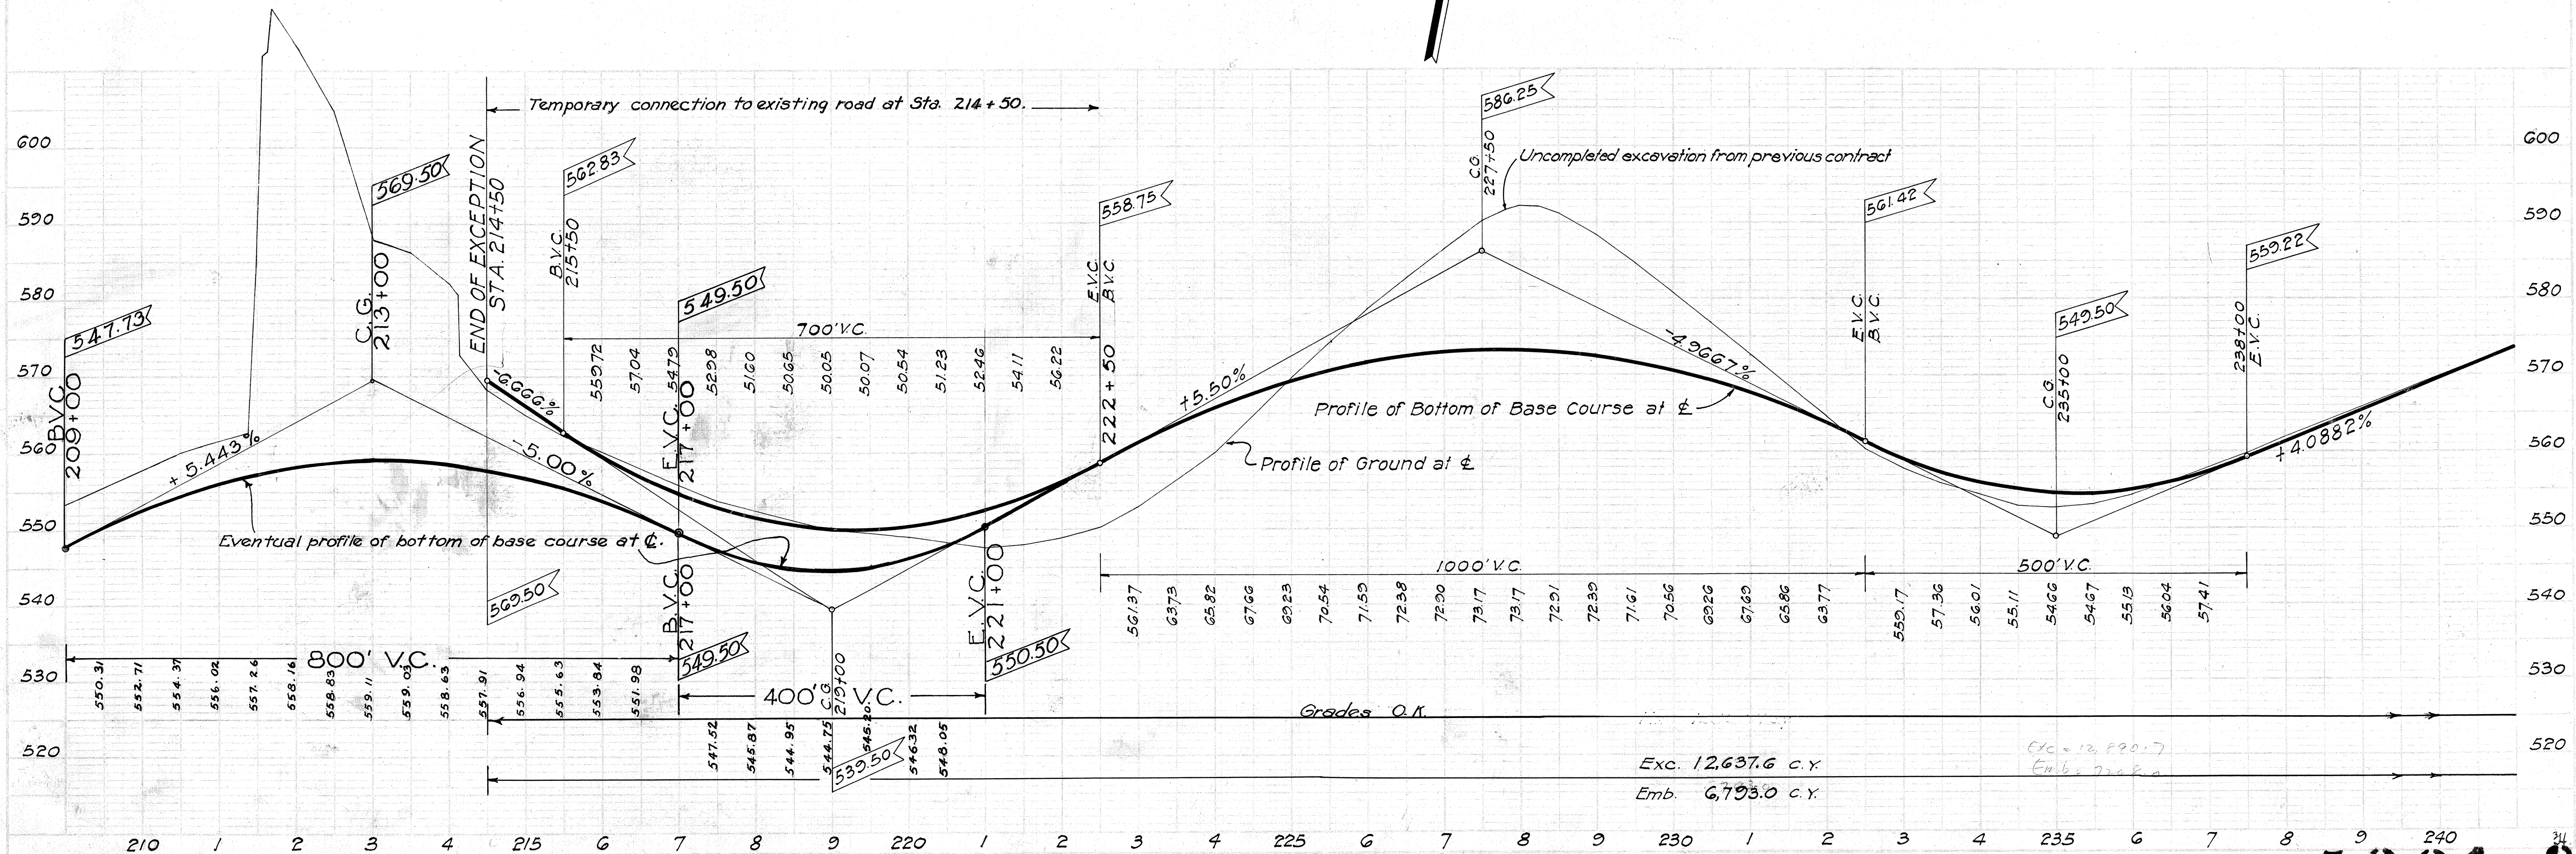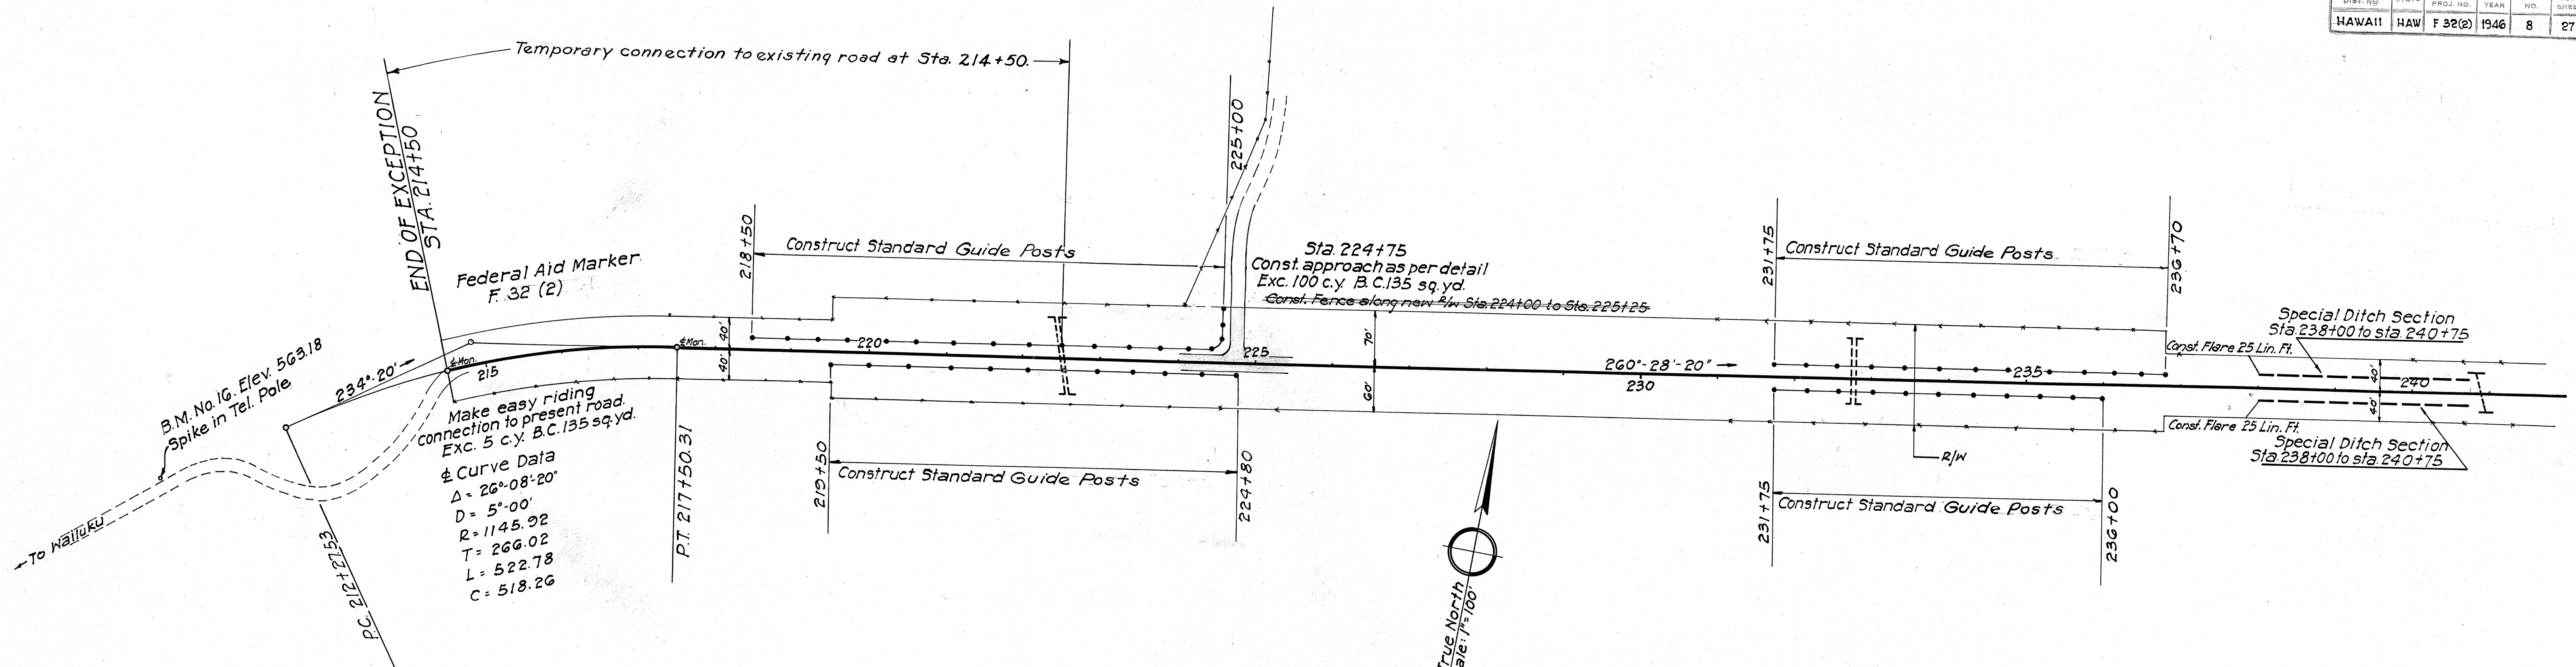

5221.8

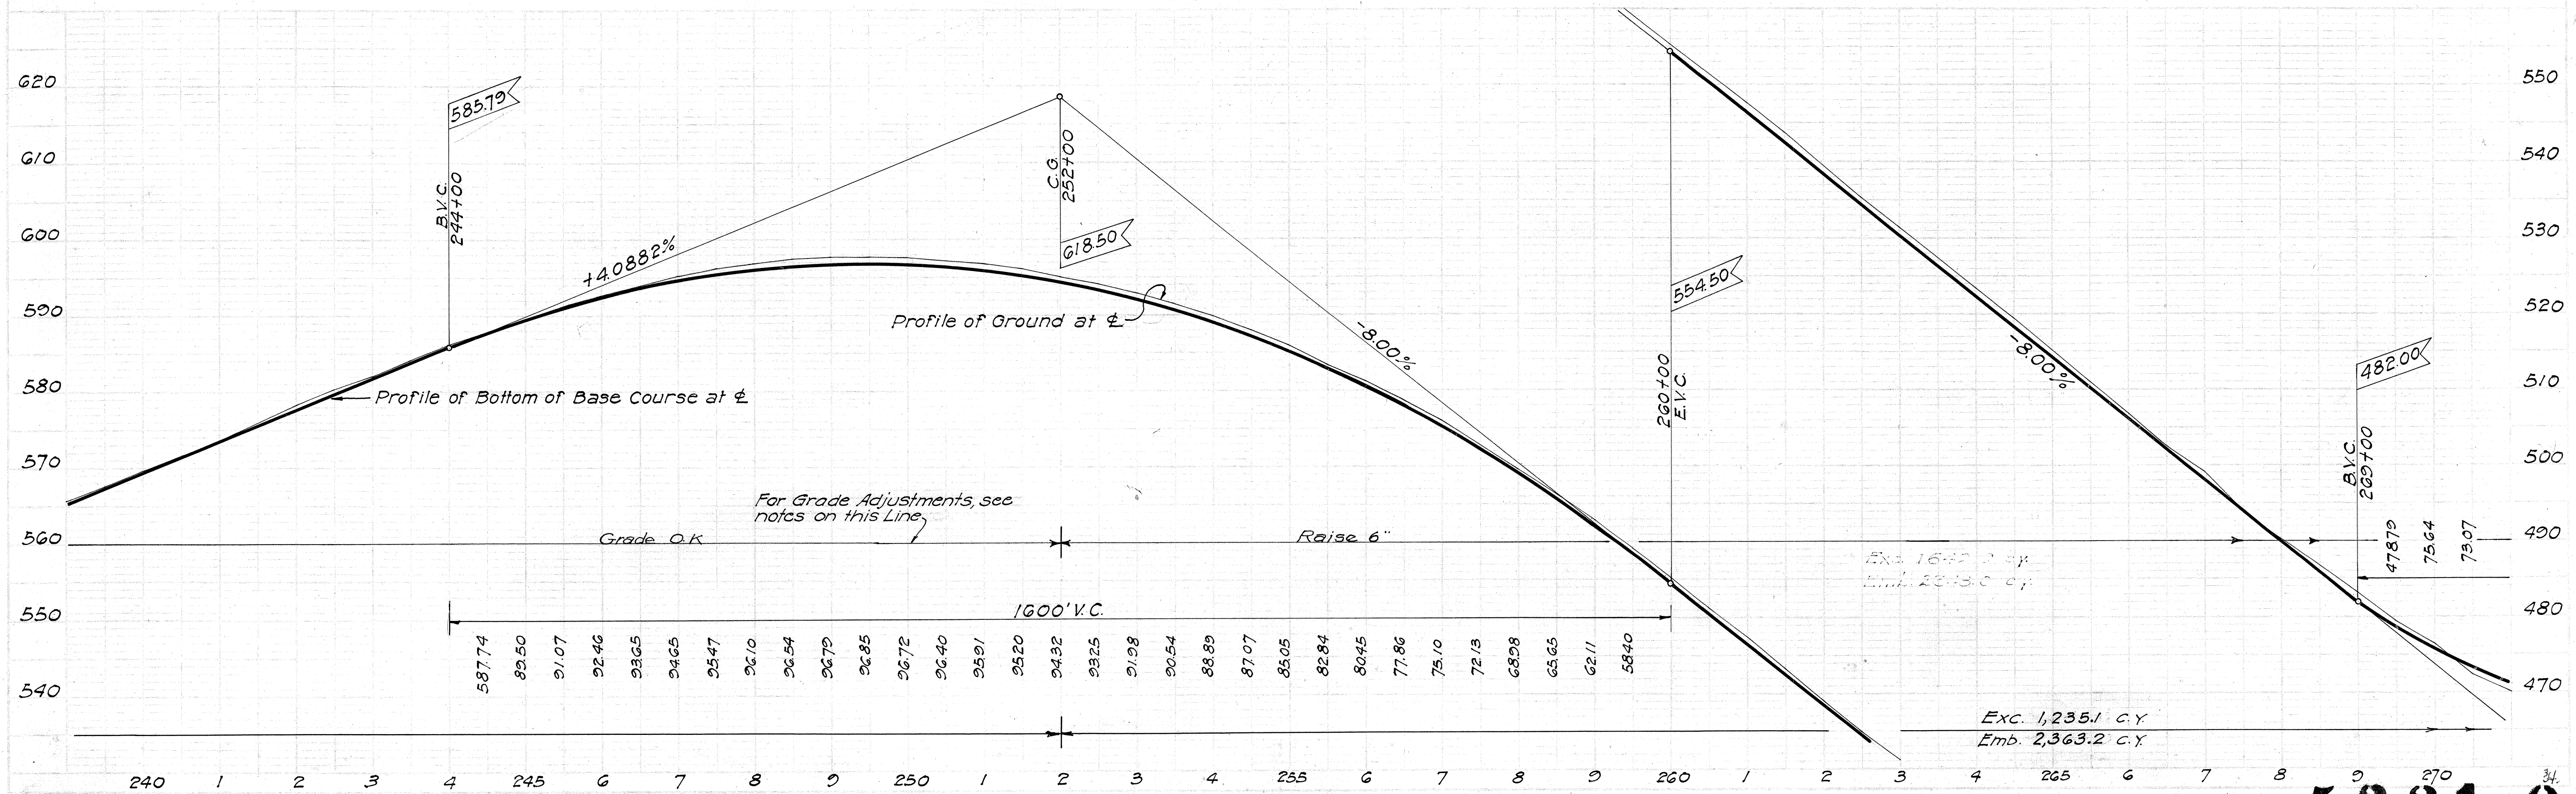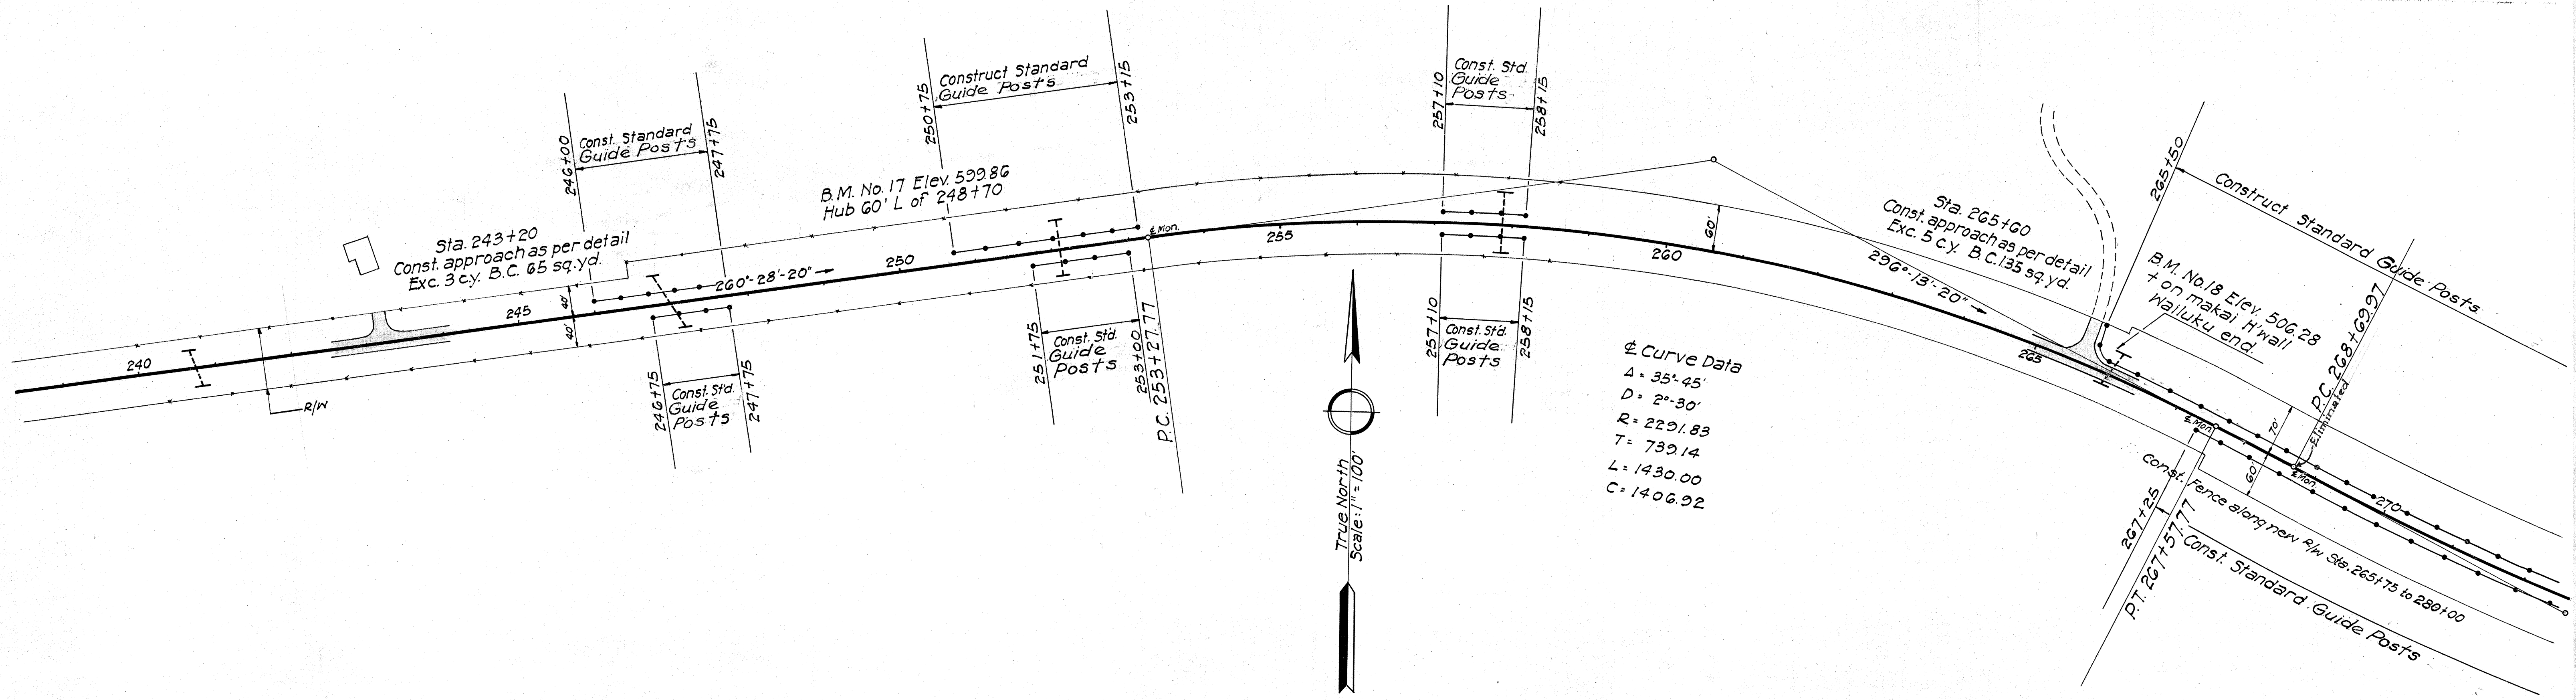

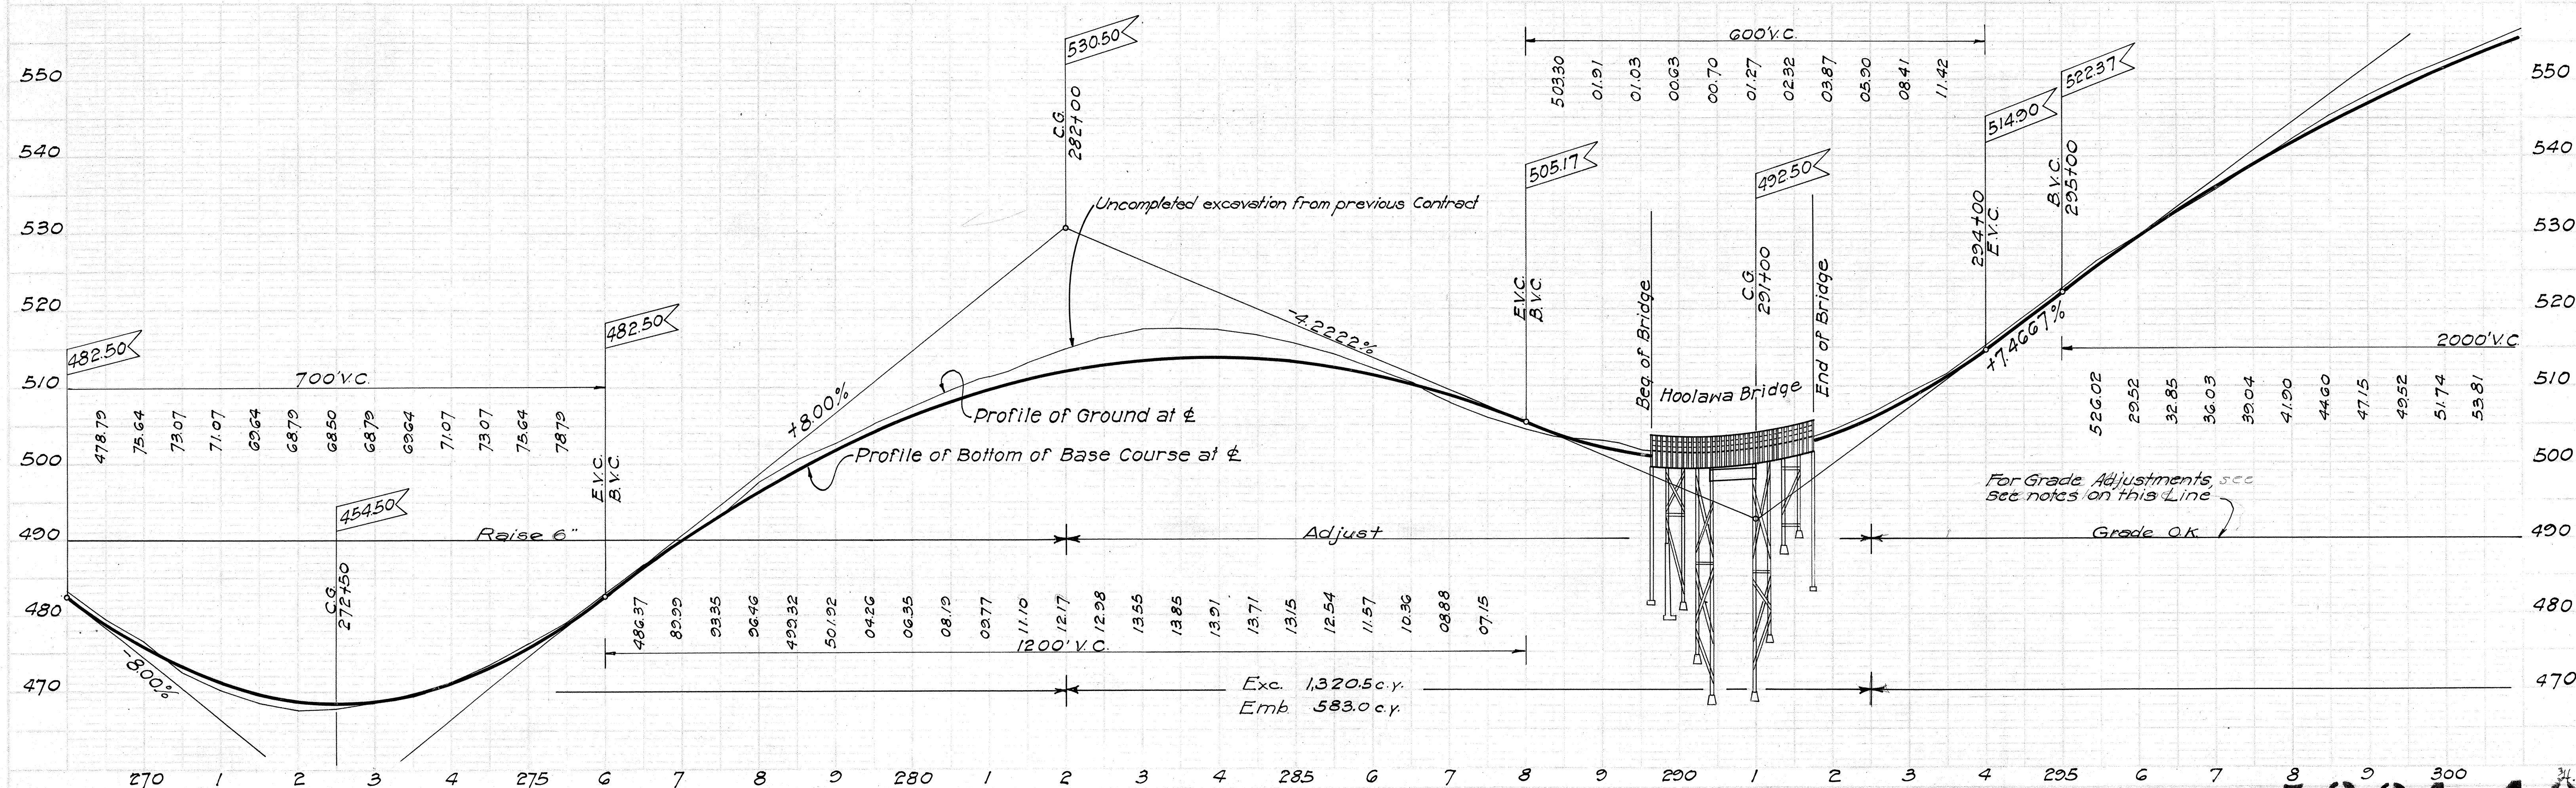

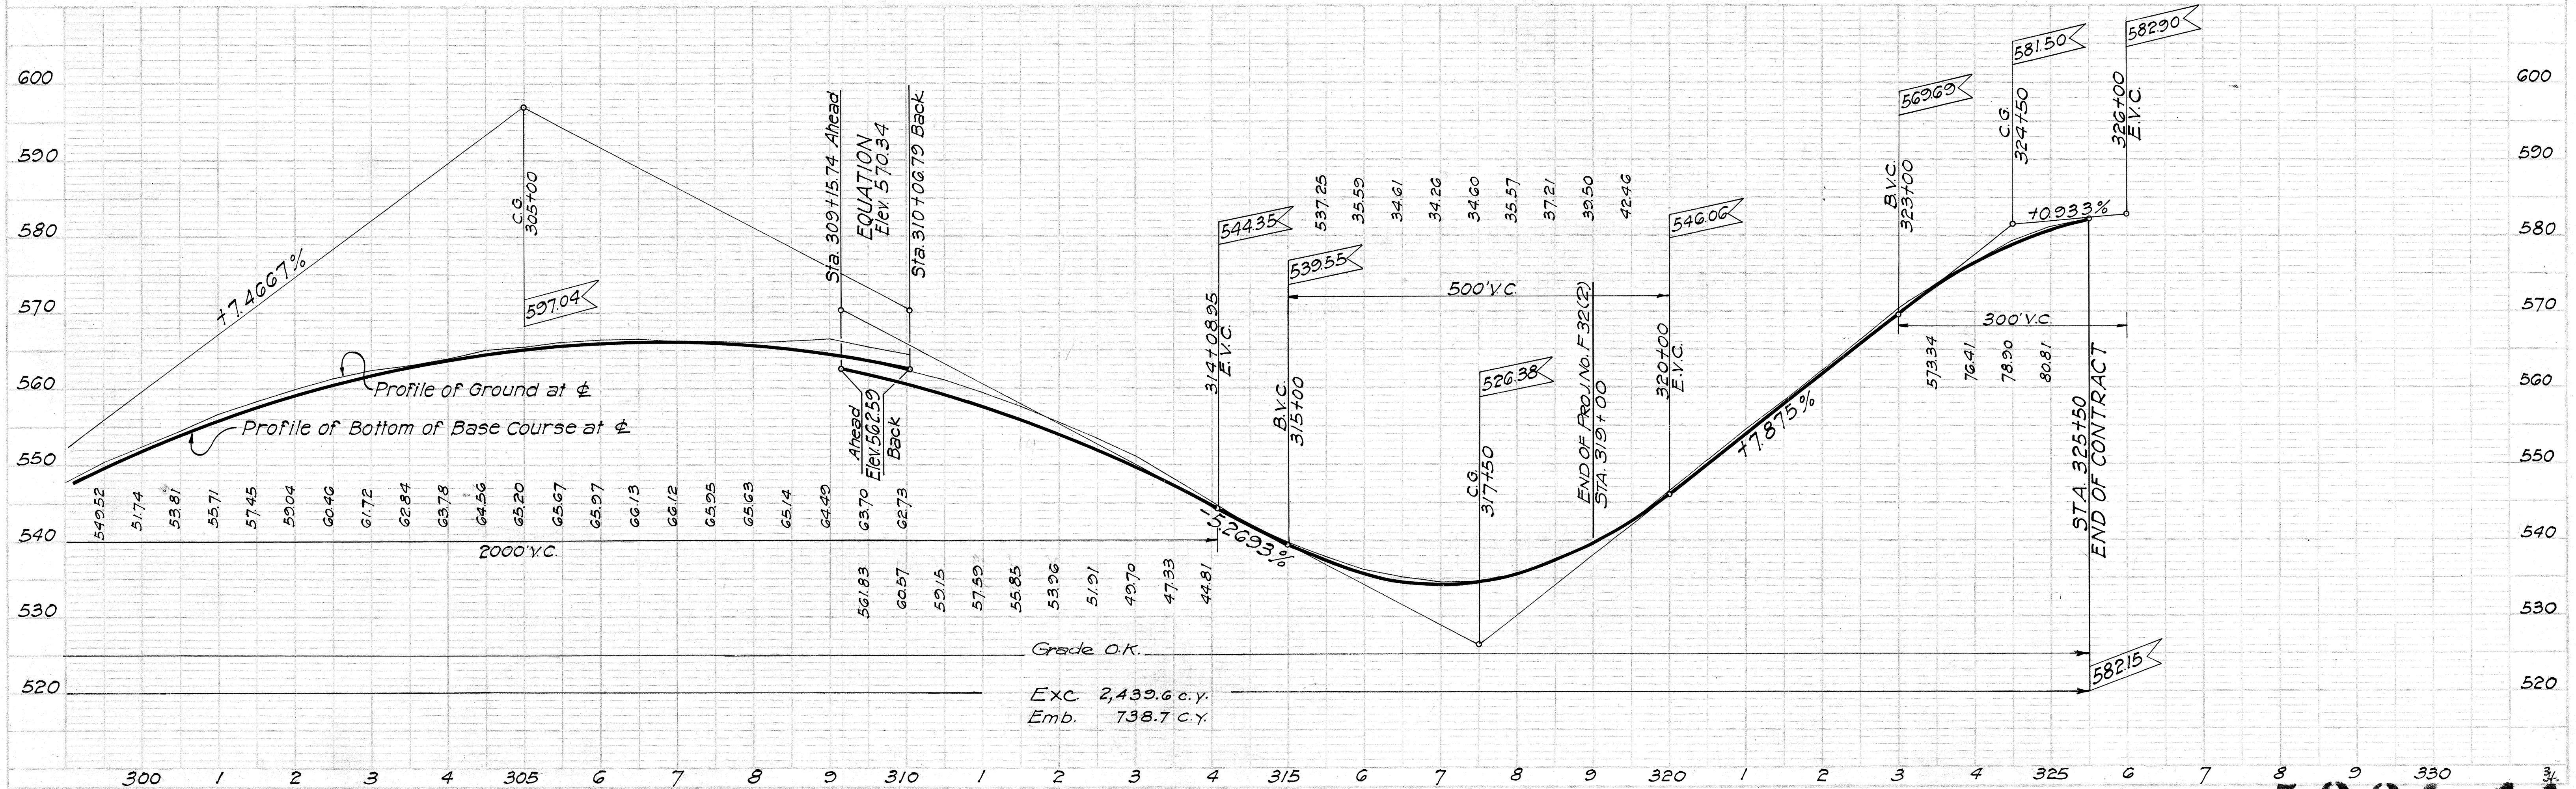

5 2 2 1.11