


PLANS & PROFILES OF APPROACHES REQUIRING RELOCATION OF EXISTING SIDE & CROSS ROADS

FED. ROAD DIST. NO.	STATE	FED. AID PROJ. NO.	FISCAL YEAR	SHEET NO.	TOTAL SHEETS
HAWAII	HAW	F 32(3)	1951	9	41

8-22-51

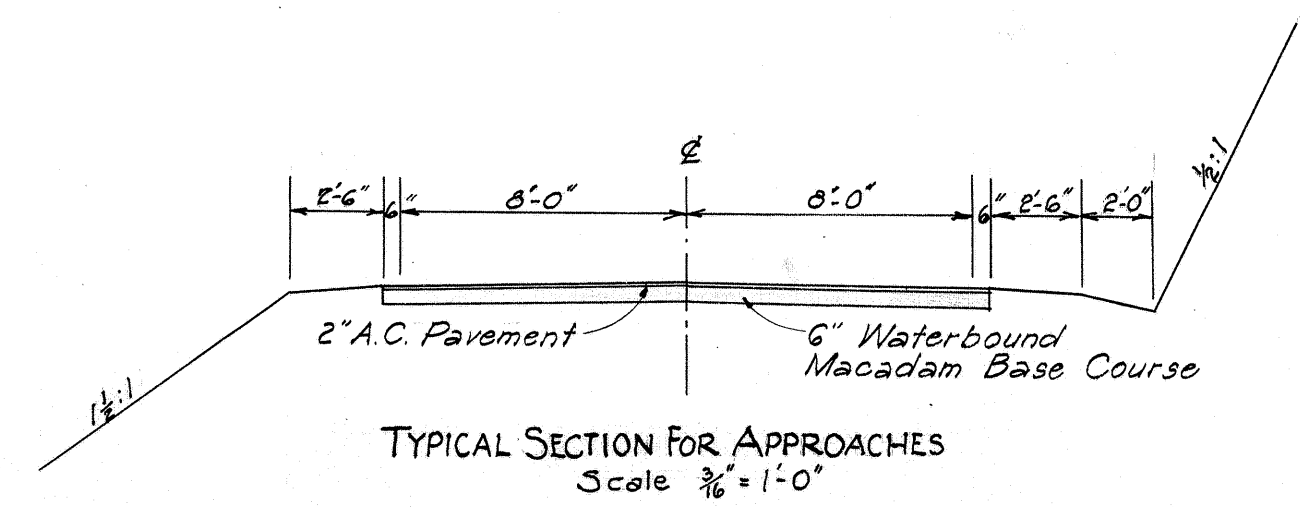

NOTE:
Approaches shall be constructed with three centered compound curves. See Detail Sheet No. 5522.4

