

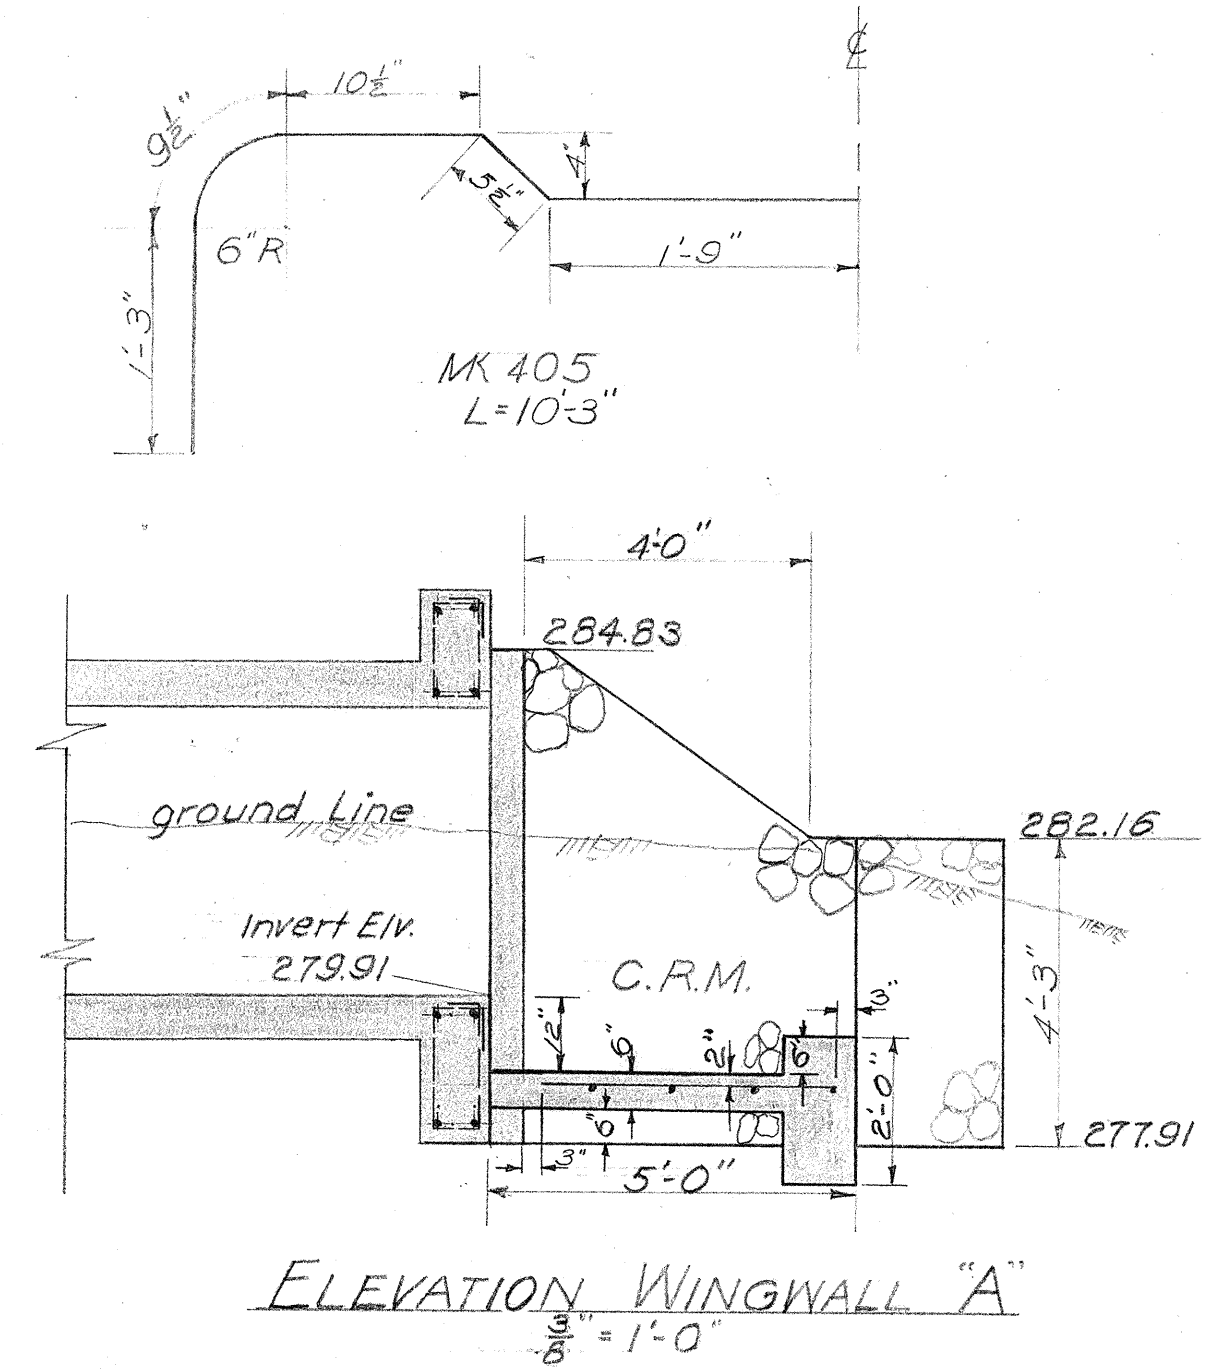
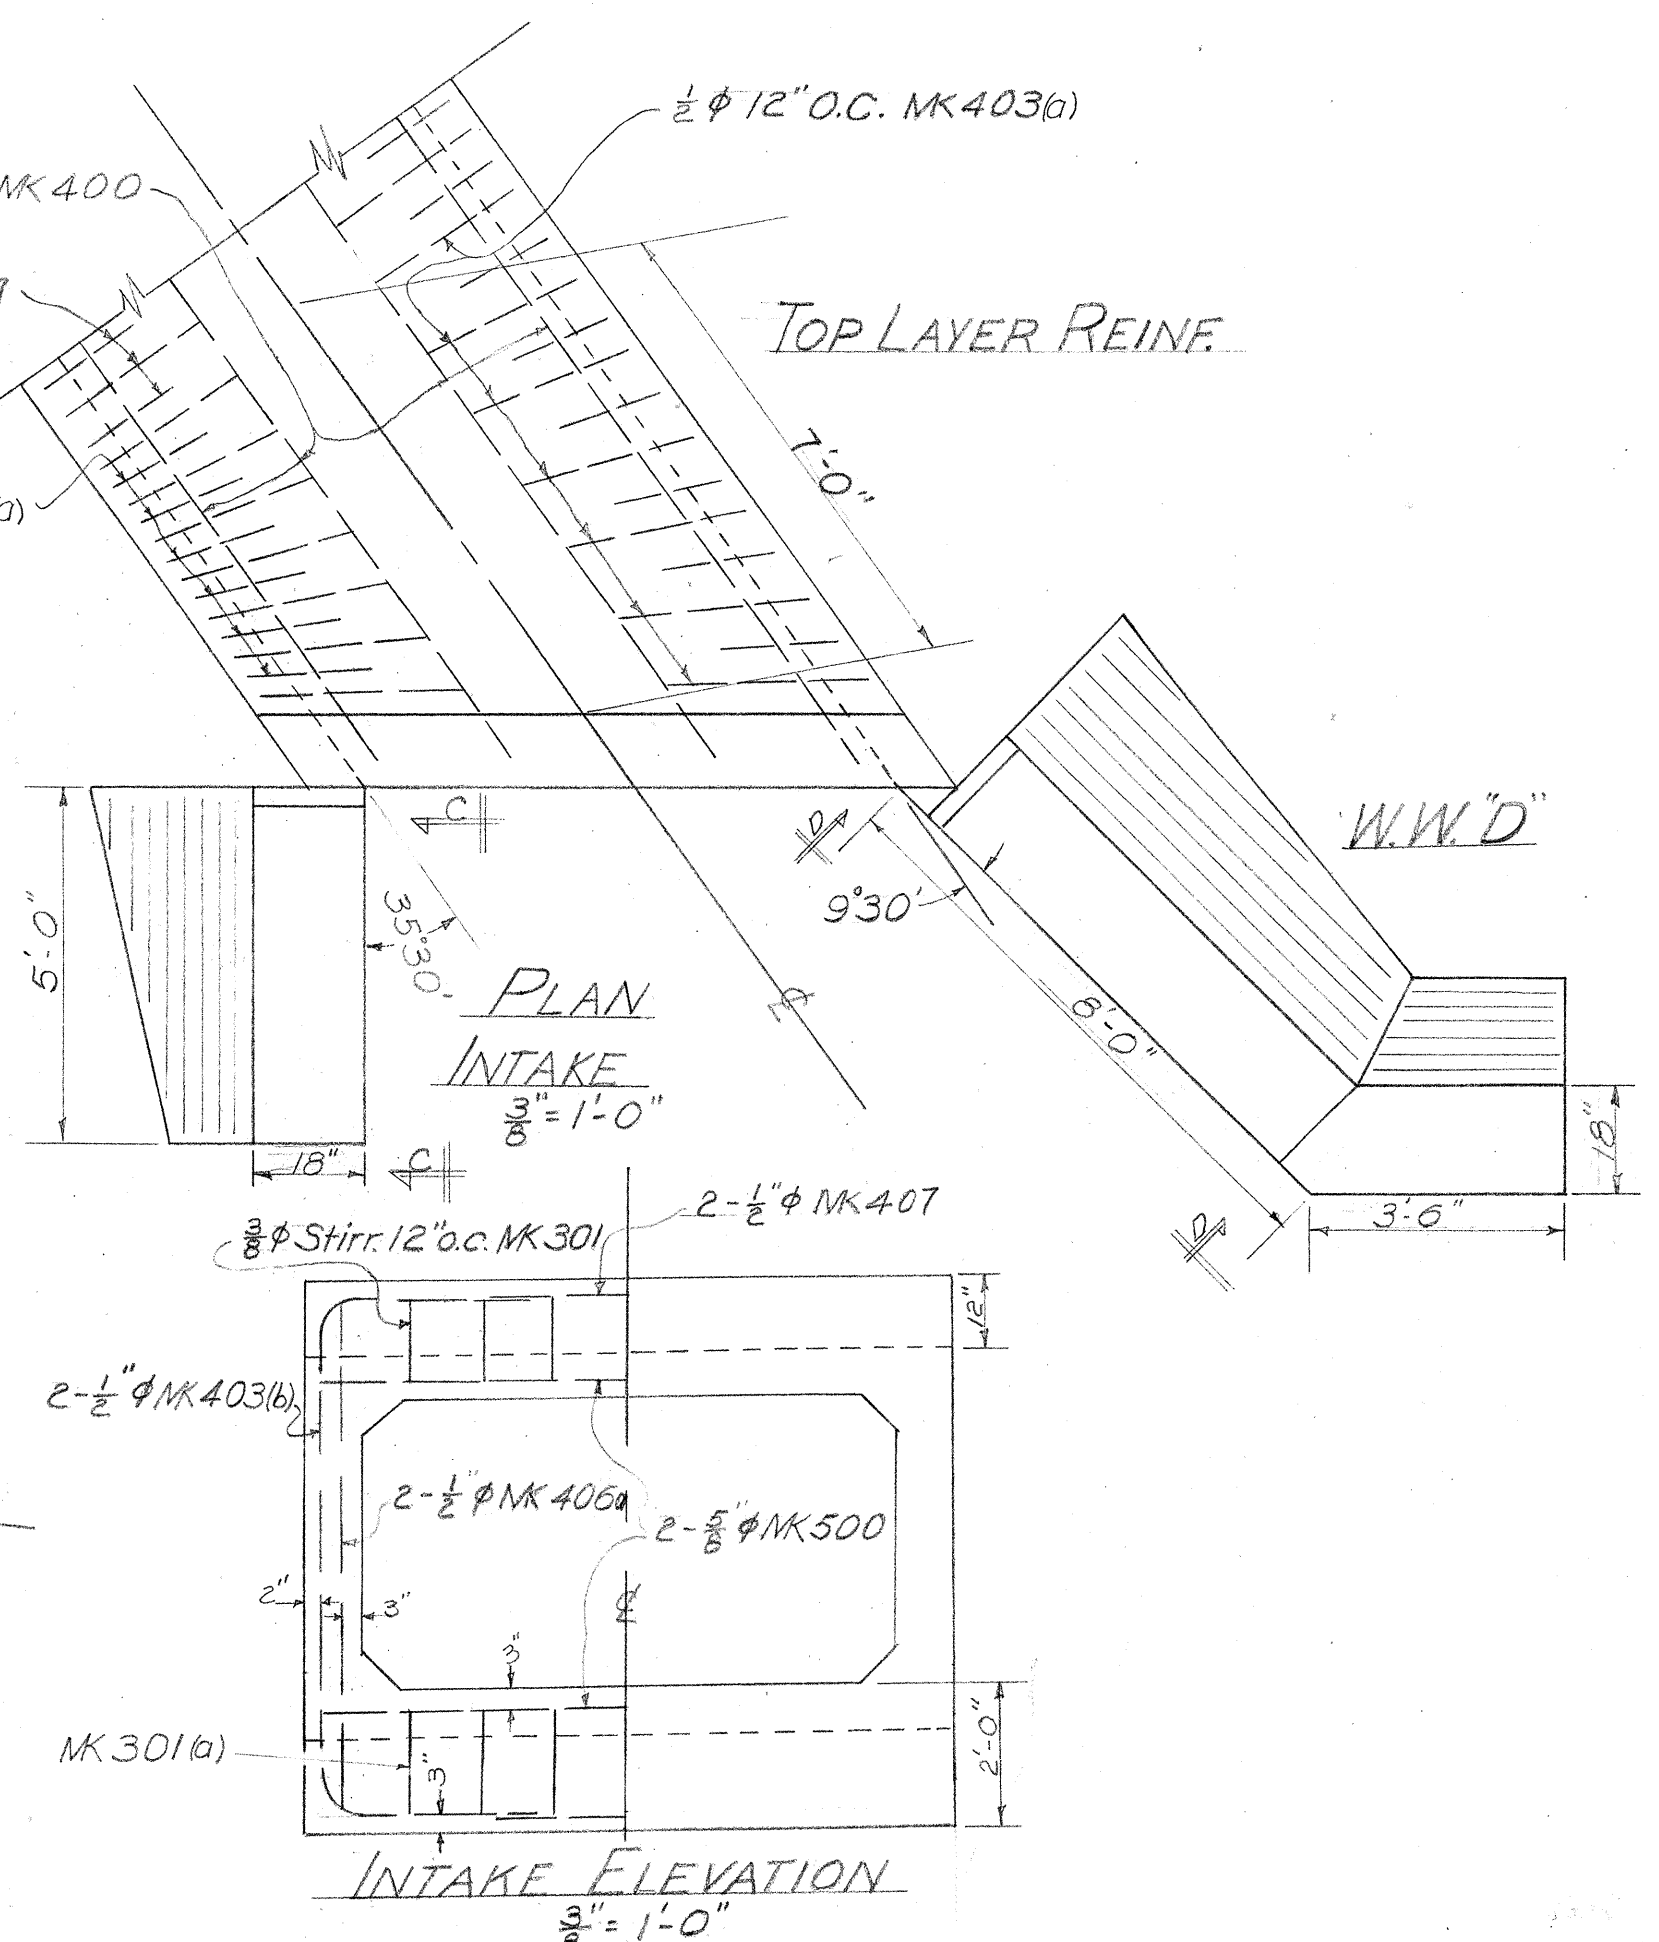
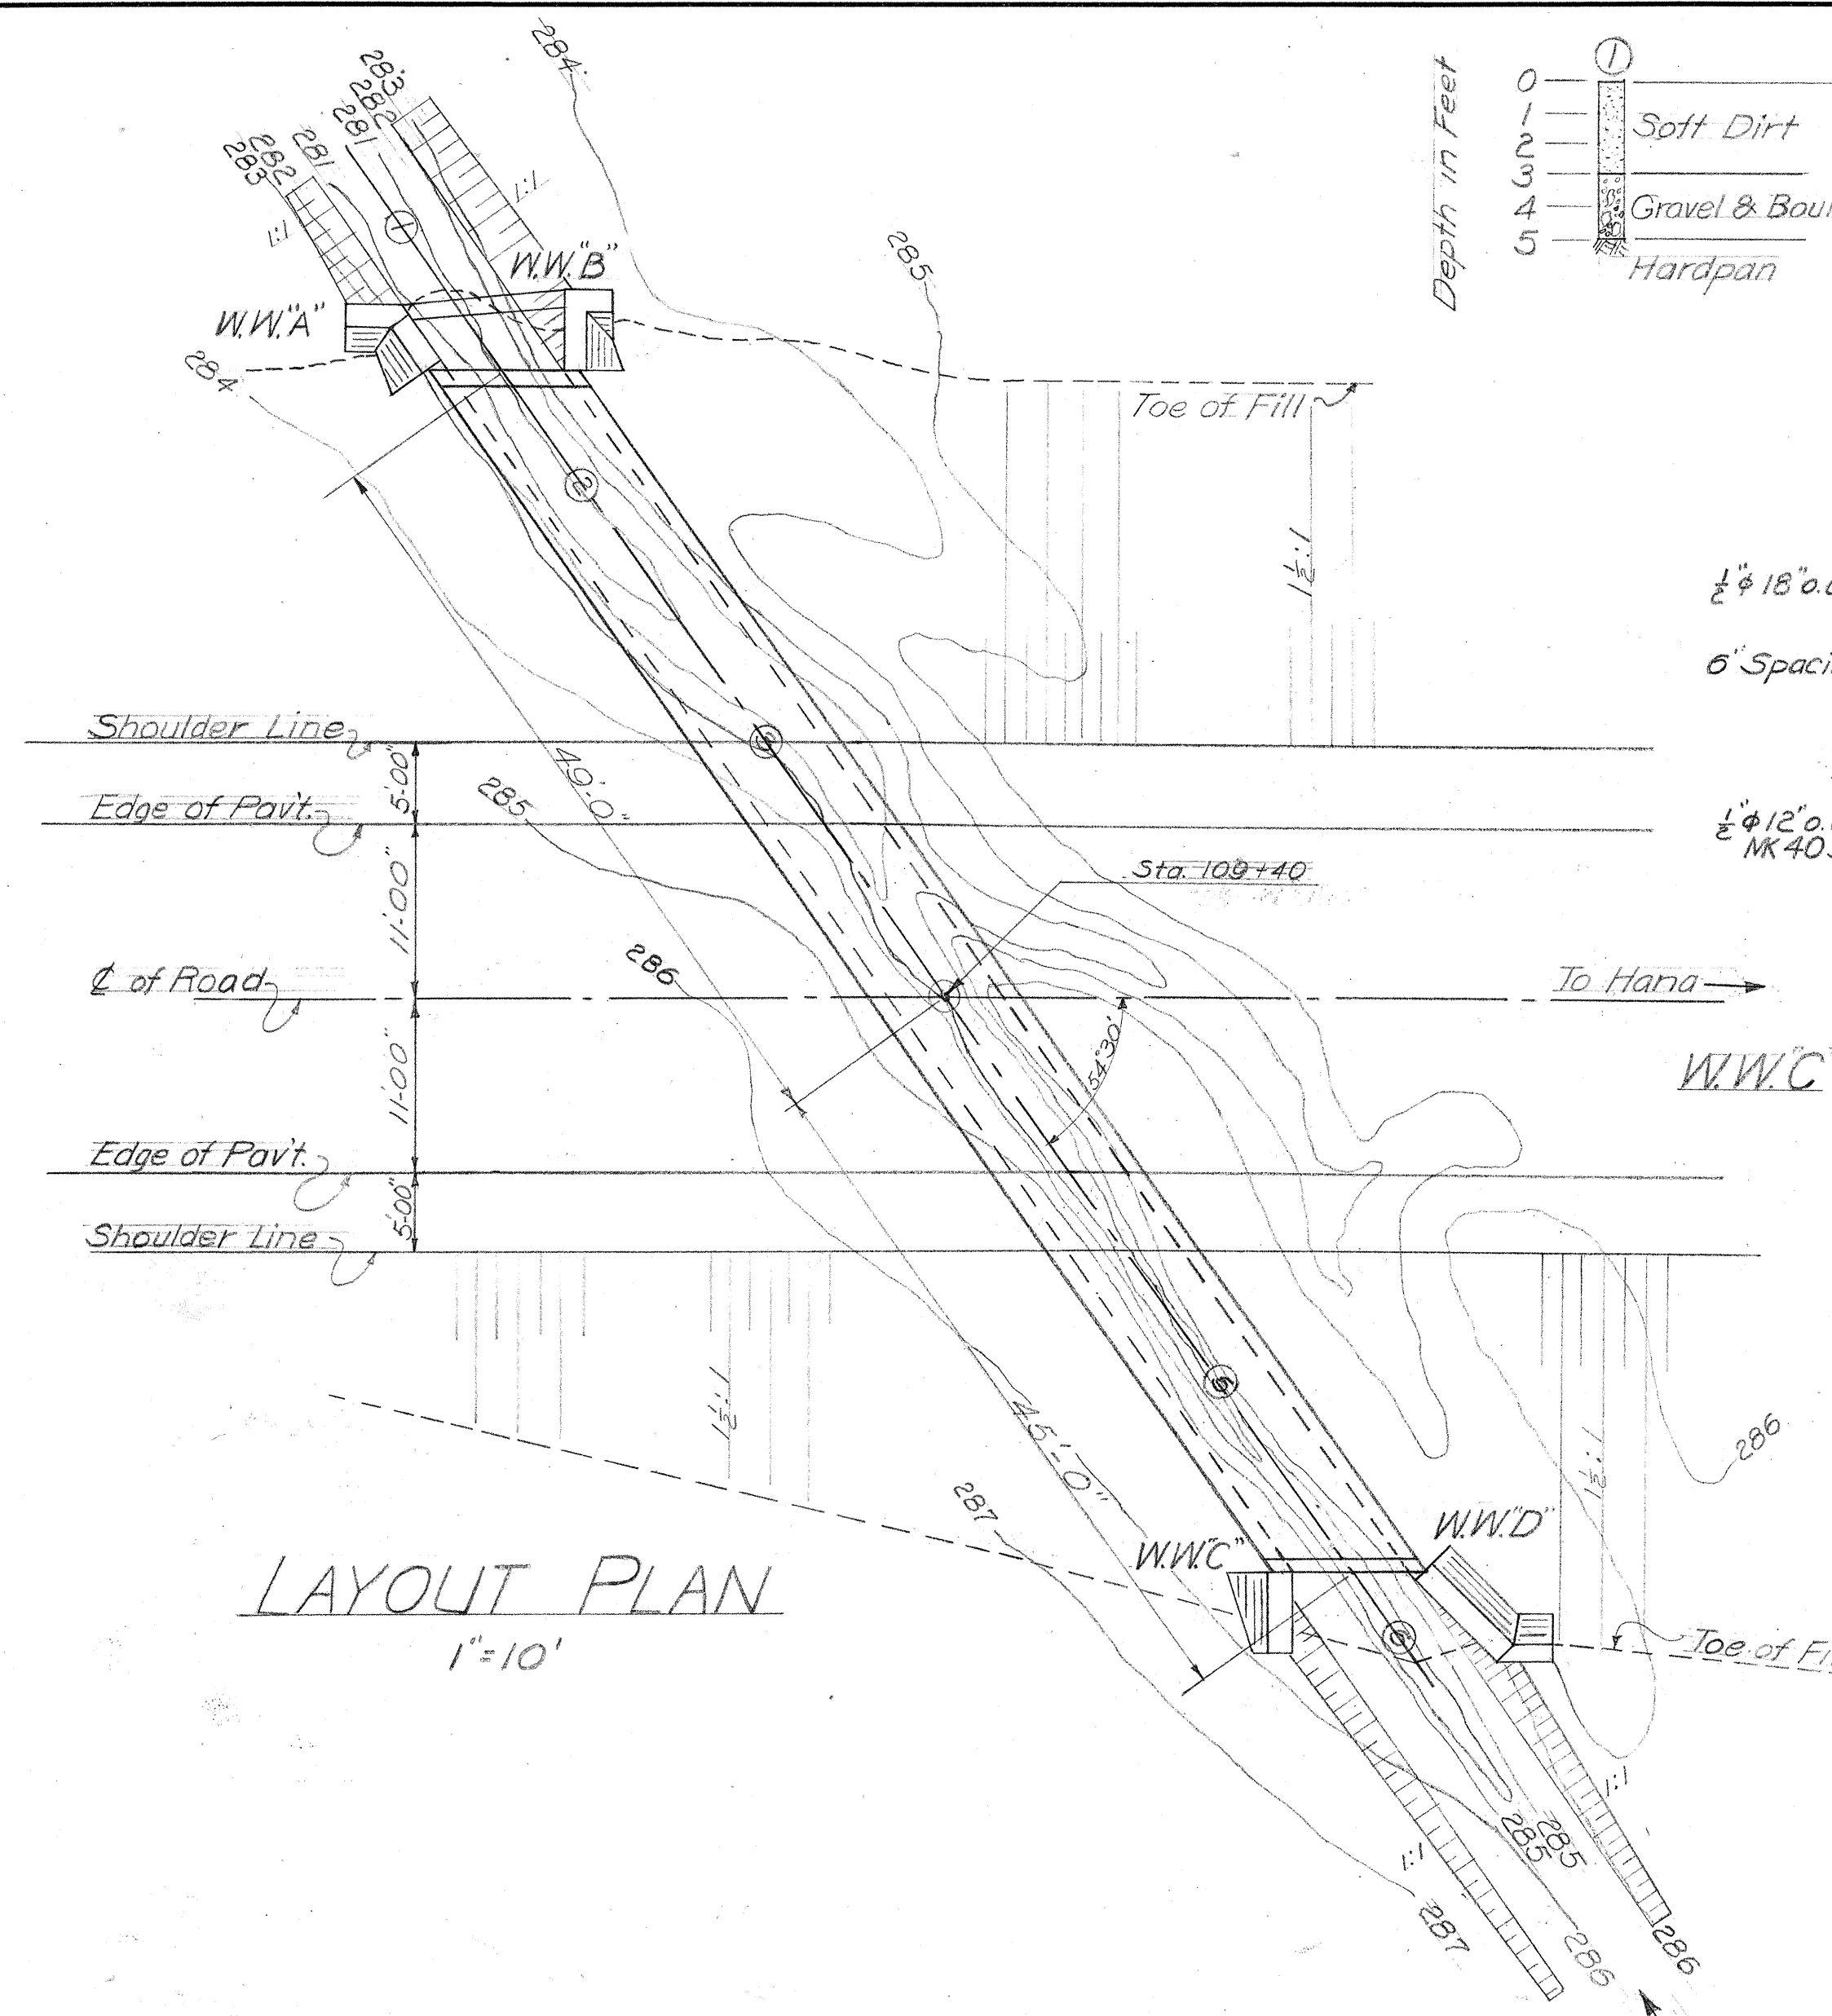
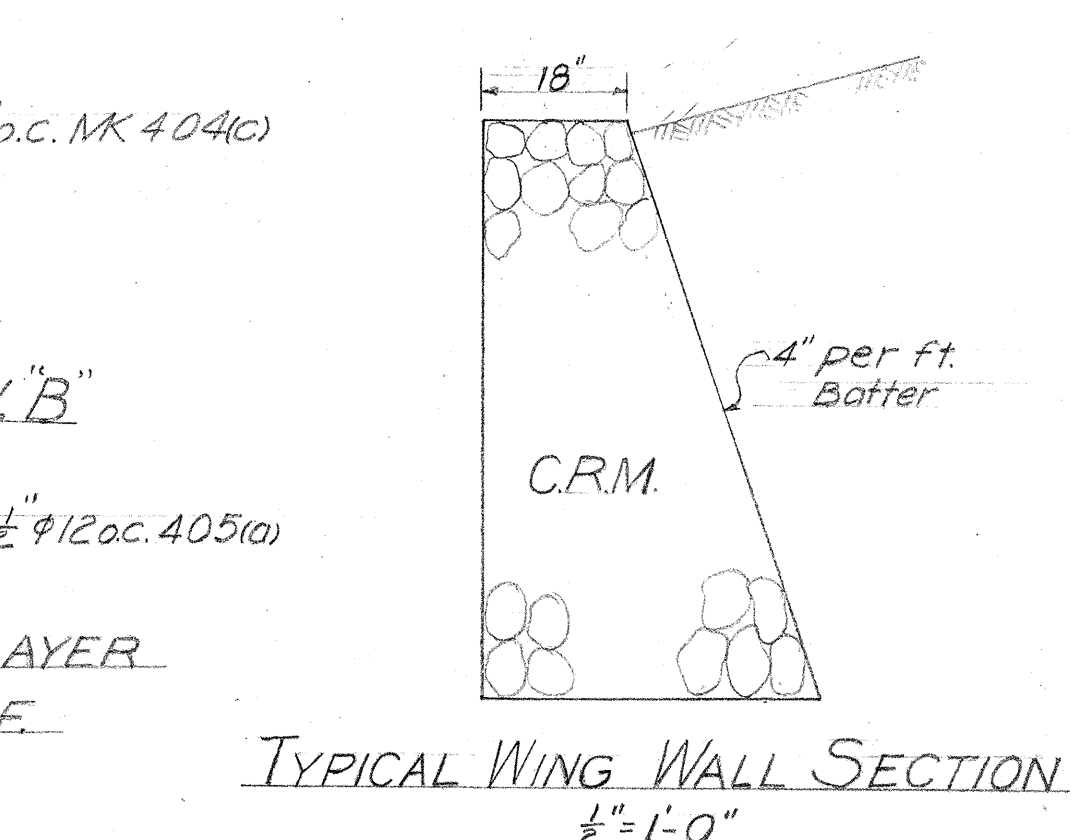
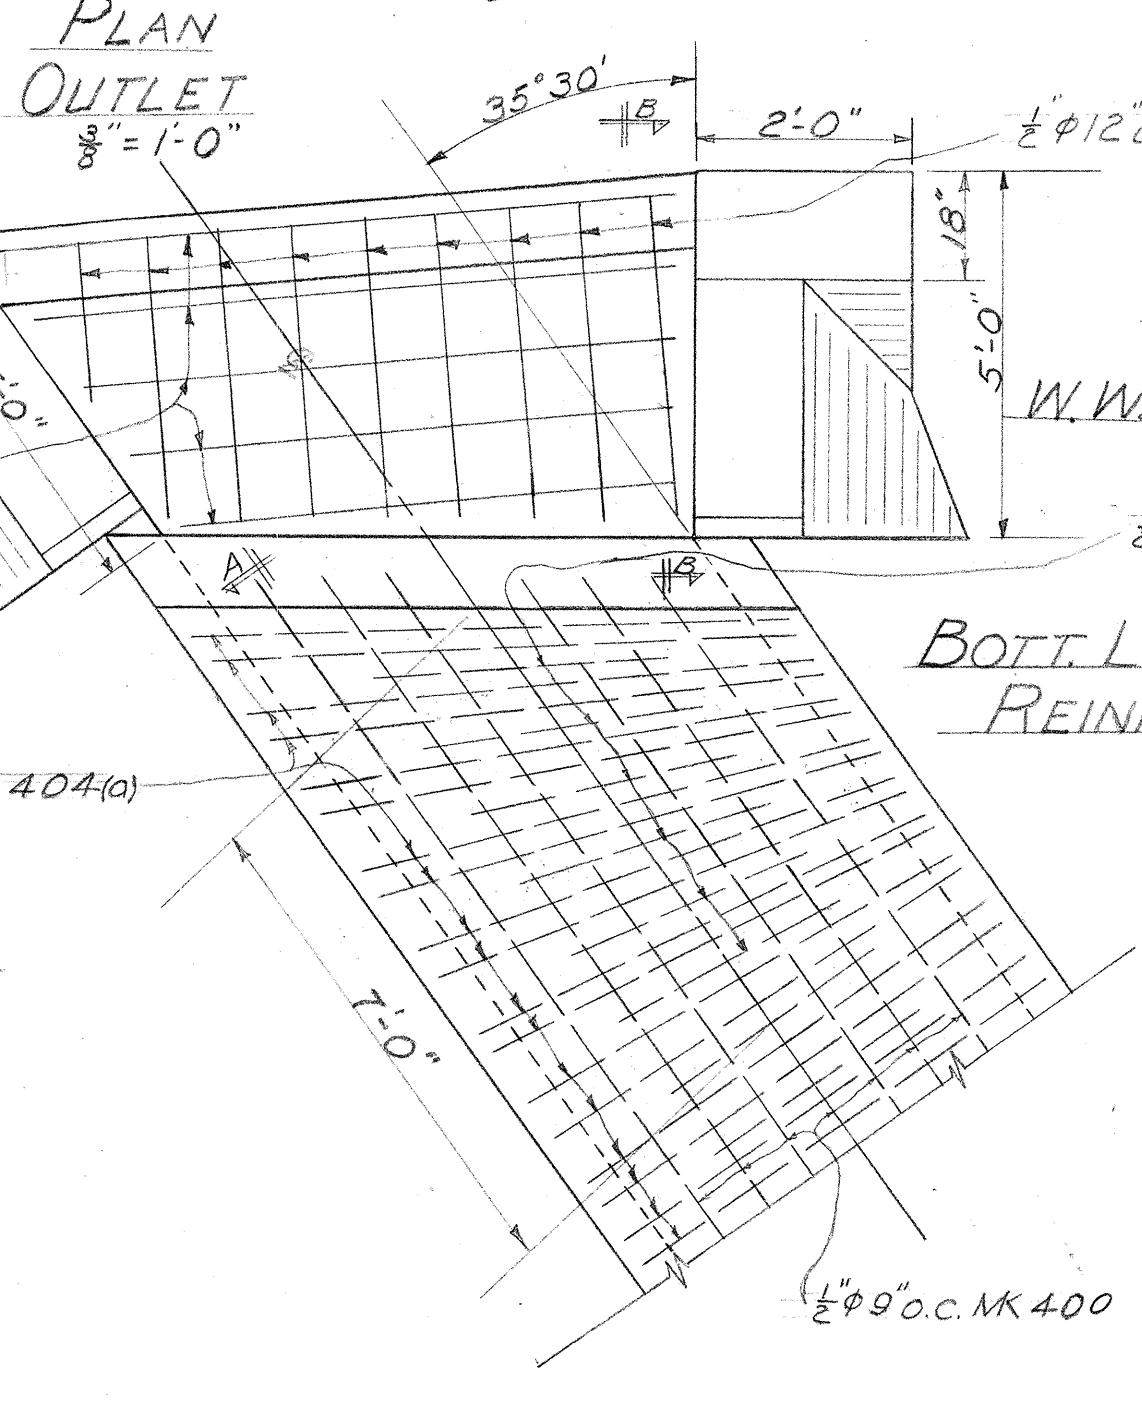
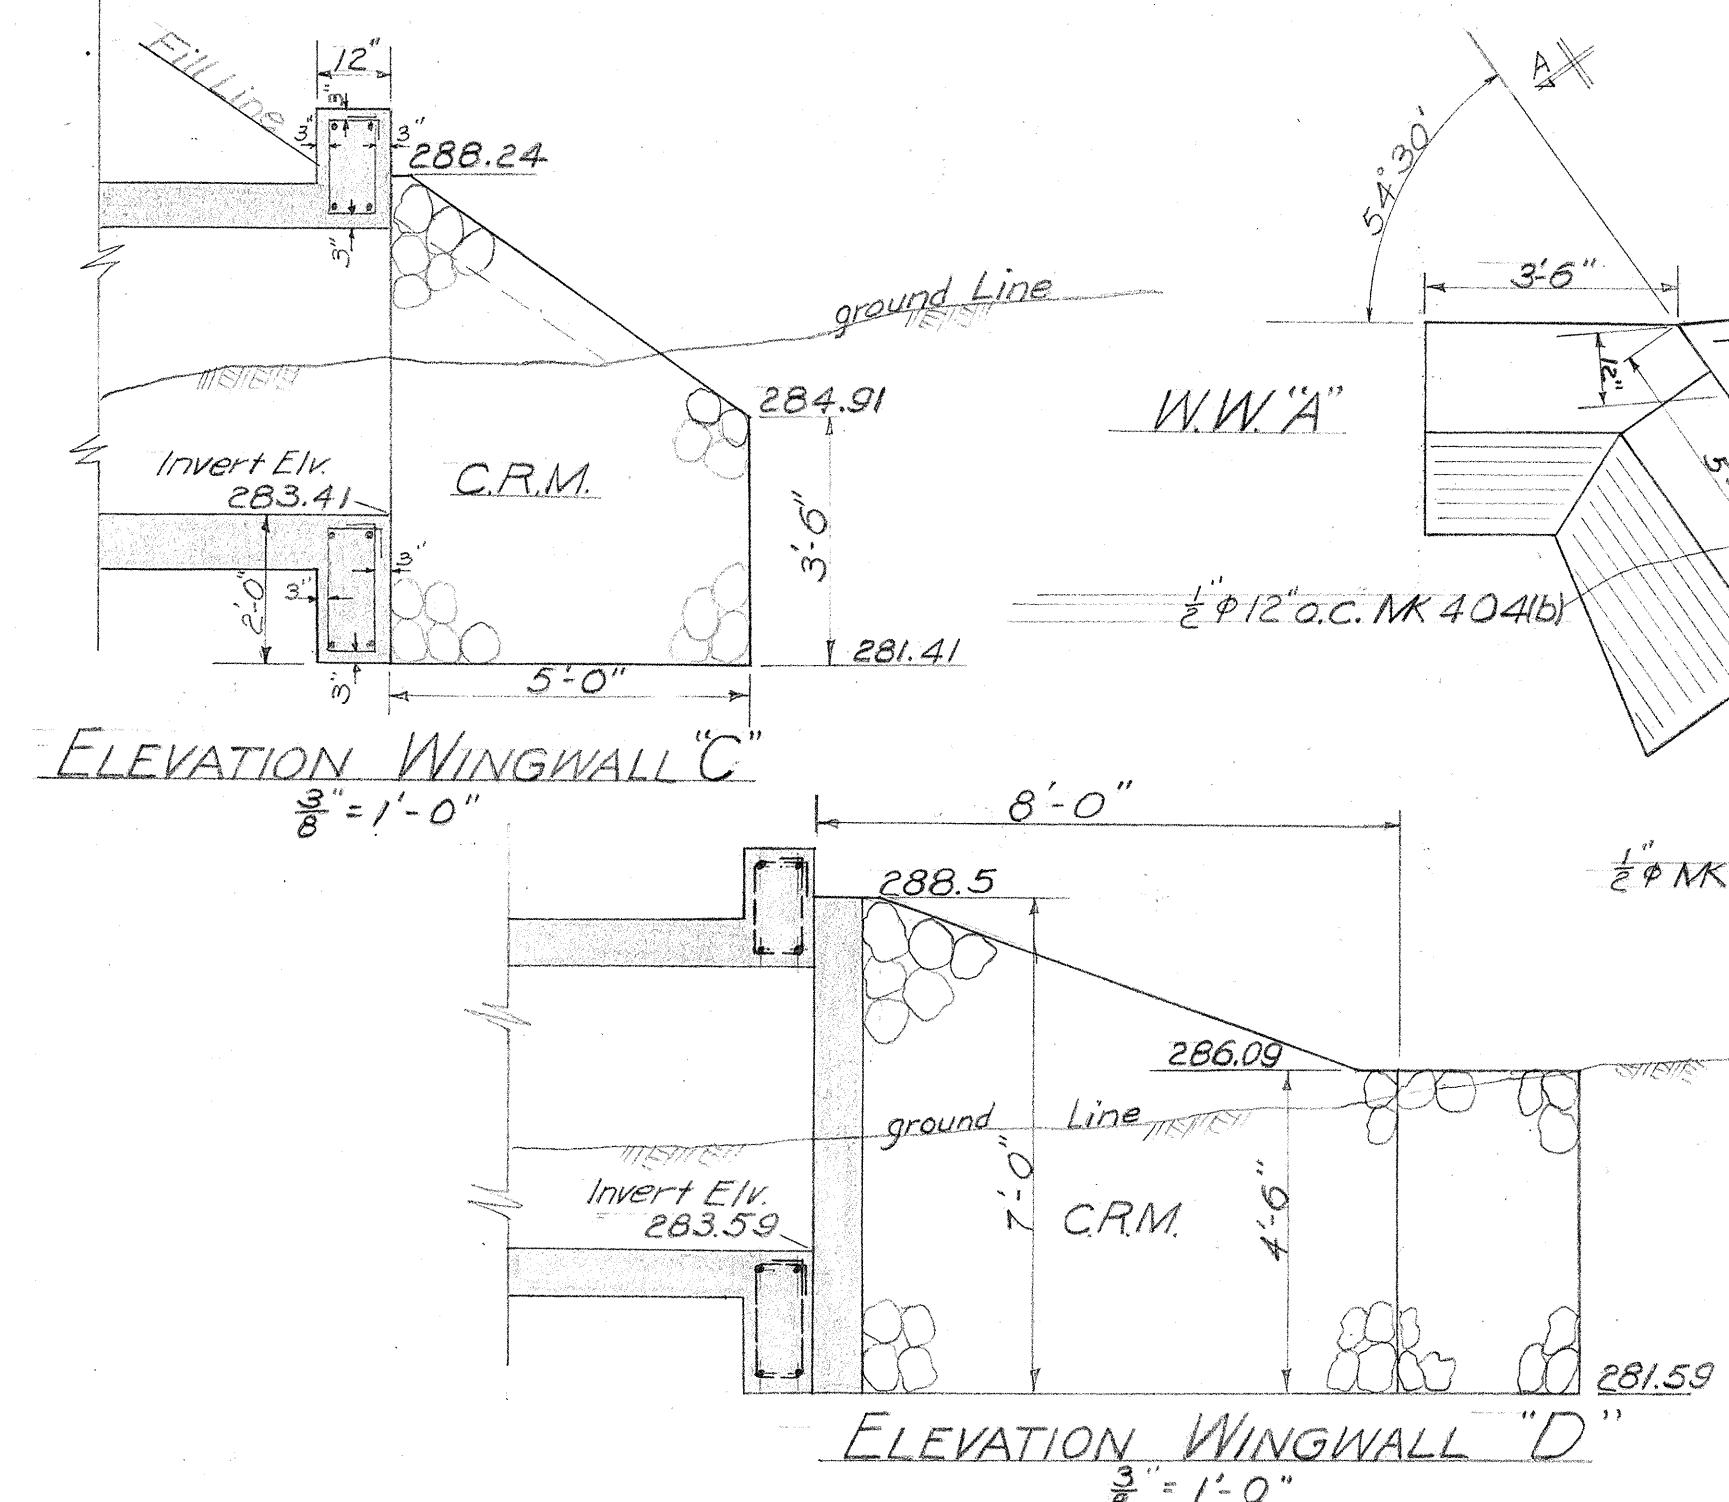
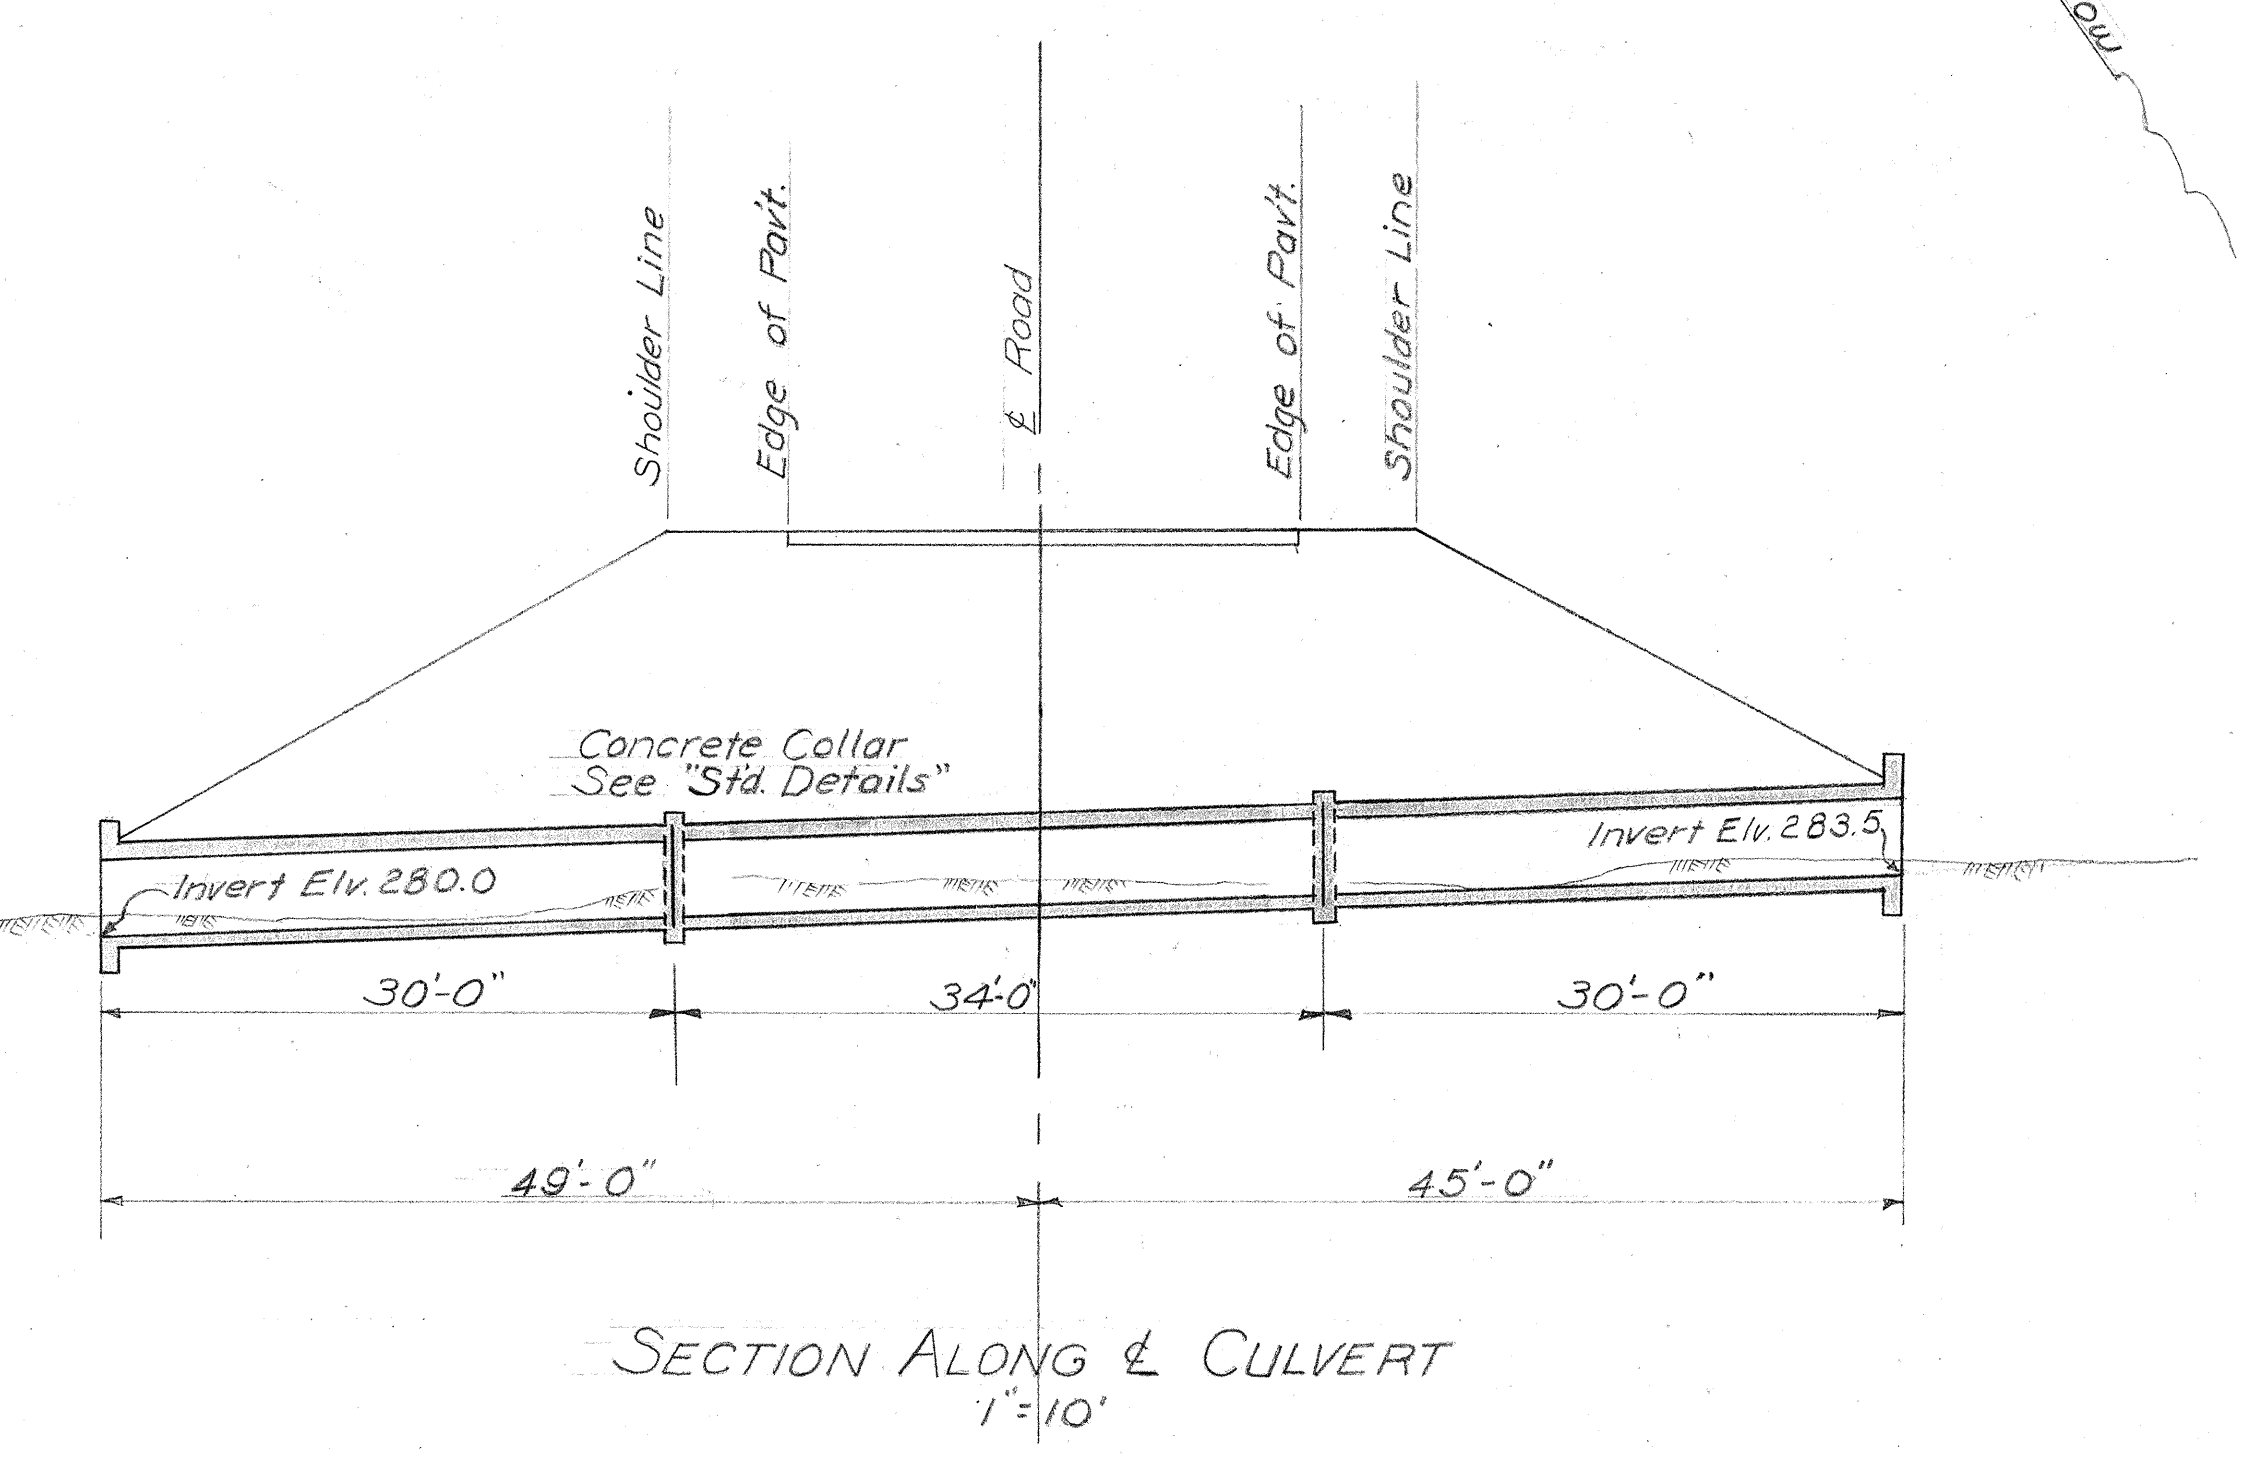


Depth in Feet	1	2	3	5	6
0 - 1	Soft Dirt	Soft Dirt	Soft Dirt	Soft Dirt	Soft Dirt
1 - 4	Gravel & Boulders	Dirt & Boulders	Dirt & Boulders	Dirt & Boulders	Dirt & Boulders
4 - 5	Hardpan	Dirt & Gravel	Gravel	Hardpan	Hardpan

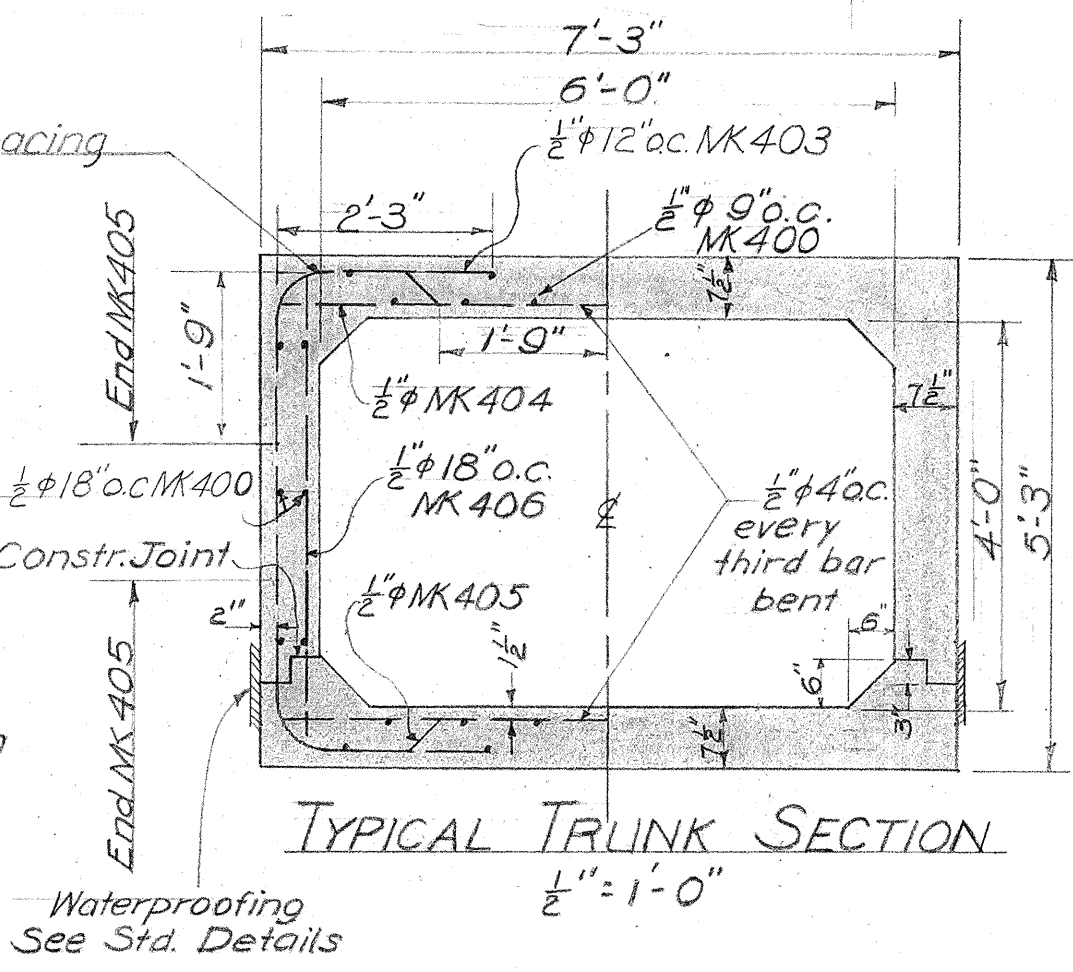

ESTIMATE OF QUANTITIES		
Class A-1 Concrete	56.2 cu. yd.	55.3
Reinforcing Steel	7069 lbs.	
Structure Excavation	118 cu. yd.	164.4
Channel Excavation	27 cu. yd.	73.3
C. R. M.	12 cu. yd.	12.5
Dampproofing	188.5 sq. yd.	

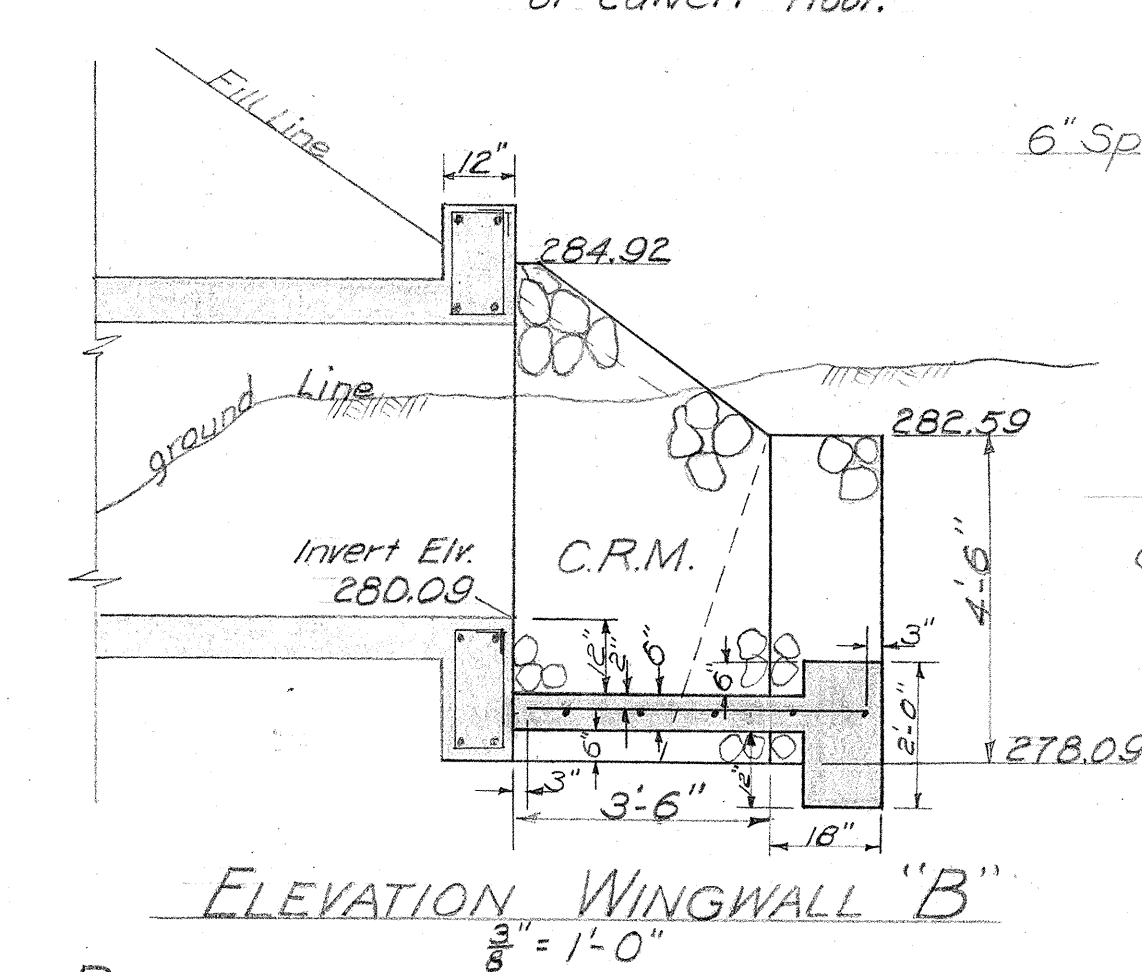

TERRITORIAL HIGHWAY DEPARTMENT
TERRITORY OF HAWAII
6'x4' CONC. BOX CULVERT
STA. 109+40
HANA BELT ROAD F32(3)
JULY 1950

SURVEY PLOTTED BY: [Name]
DATE: [Date]
DESIGNED BY: [Name]
DRAWN BY: [Name]
CHECKED BY: [Name]
ORIGINAL PLAN NO. [Number]
NOTE BOOK NO. [Number]