

INDEX TO DRAWINGS	
SHEET NO.	DESCRIPTION
1	TITLE SHEET
2	TYPICAL SECTION
3-8	PLAN & PROFILE
9-10	APPROACH DETAILS
11	DIVERSION TUNNEL DETAILS
12	BOX CULVERT DETAILS
13-15	STANDARD DETAILS
16	BUILDINGS TO BE REMOVED
17-41	CROSS SECTIONS
16A, 16B	RELOCATION OF BUILDINGS

CONVENTIONAL SIGNS USED	
Centerline	125
Boundary Lines	
Fences	
Existing Roadways	
Circular Culvert	
Box Culvert	
Telephone Pole	Sp
Electric Power Pole	o E.P.
Fire Hydrant	o hyd.
Concrete Drop Intake	U
Centerline Monument	C & Mon.
Guard Rail	
Warning & Regulatory Signs	Type



TERRITORY OF HAWAII
TERRITORIAL HIGHWAY DEPARTMENT
HONOLULU, T. H.

PLANS OF
HANA BELT ROAD
FEDERAL AID PROJECT NO. F-32(3)

MAKAWAO DISTRICT
ISLAND OF MAUI

SCALE

PLAN	1" = 100'
PROFILE	HOR. 1" = 100'
	VER. 1" = 10'
CROSS SECTION	HOR. 1" = 10'
	VER. 1" = 10'

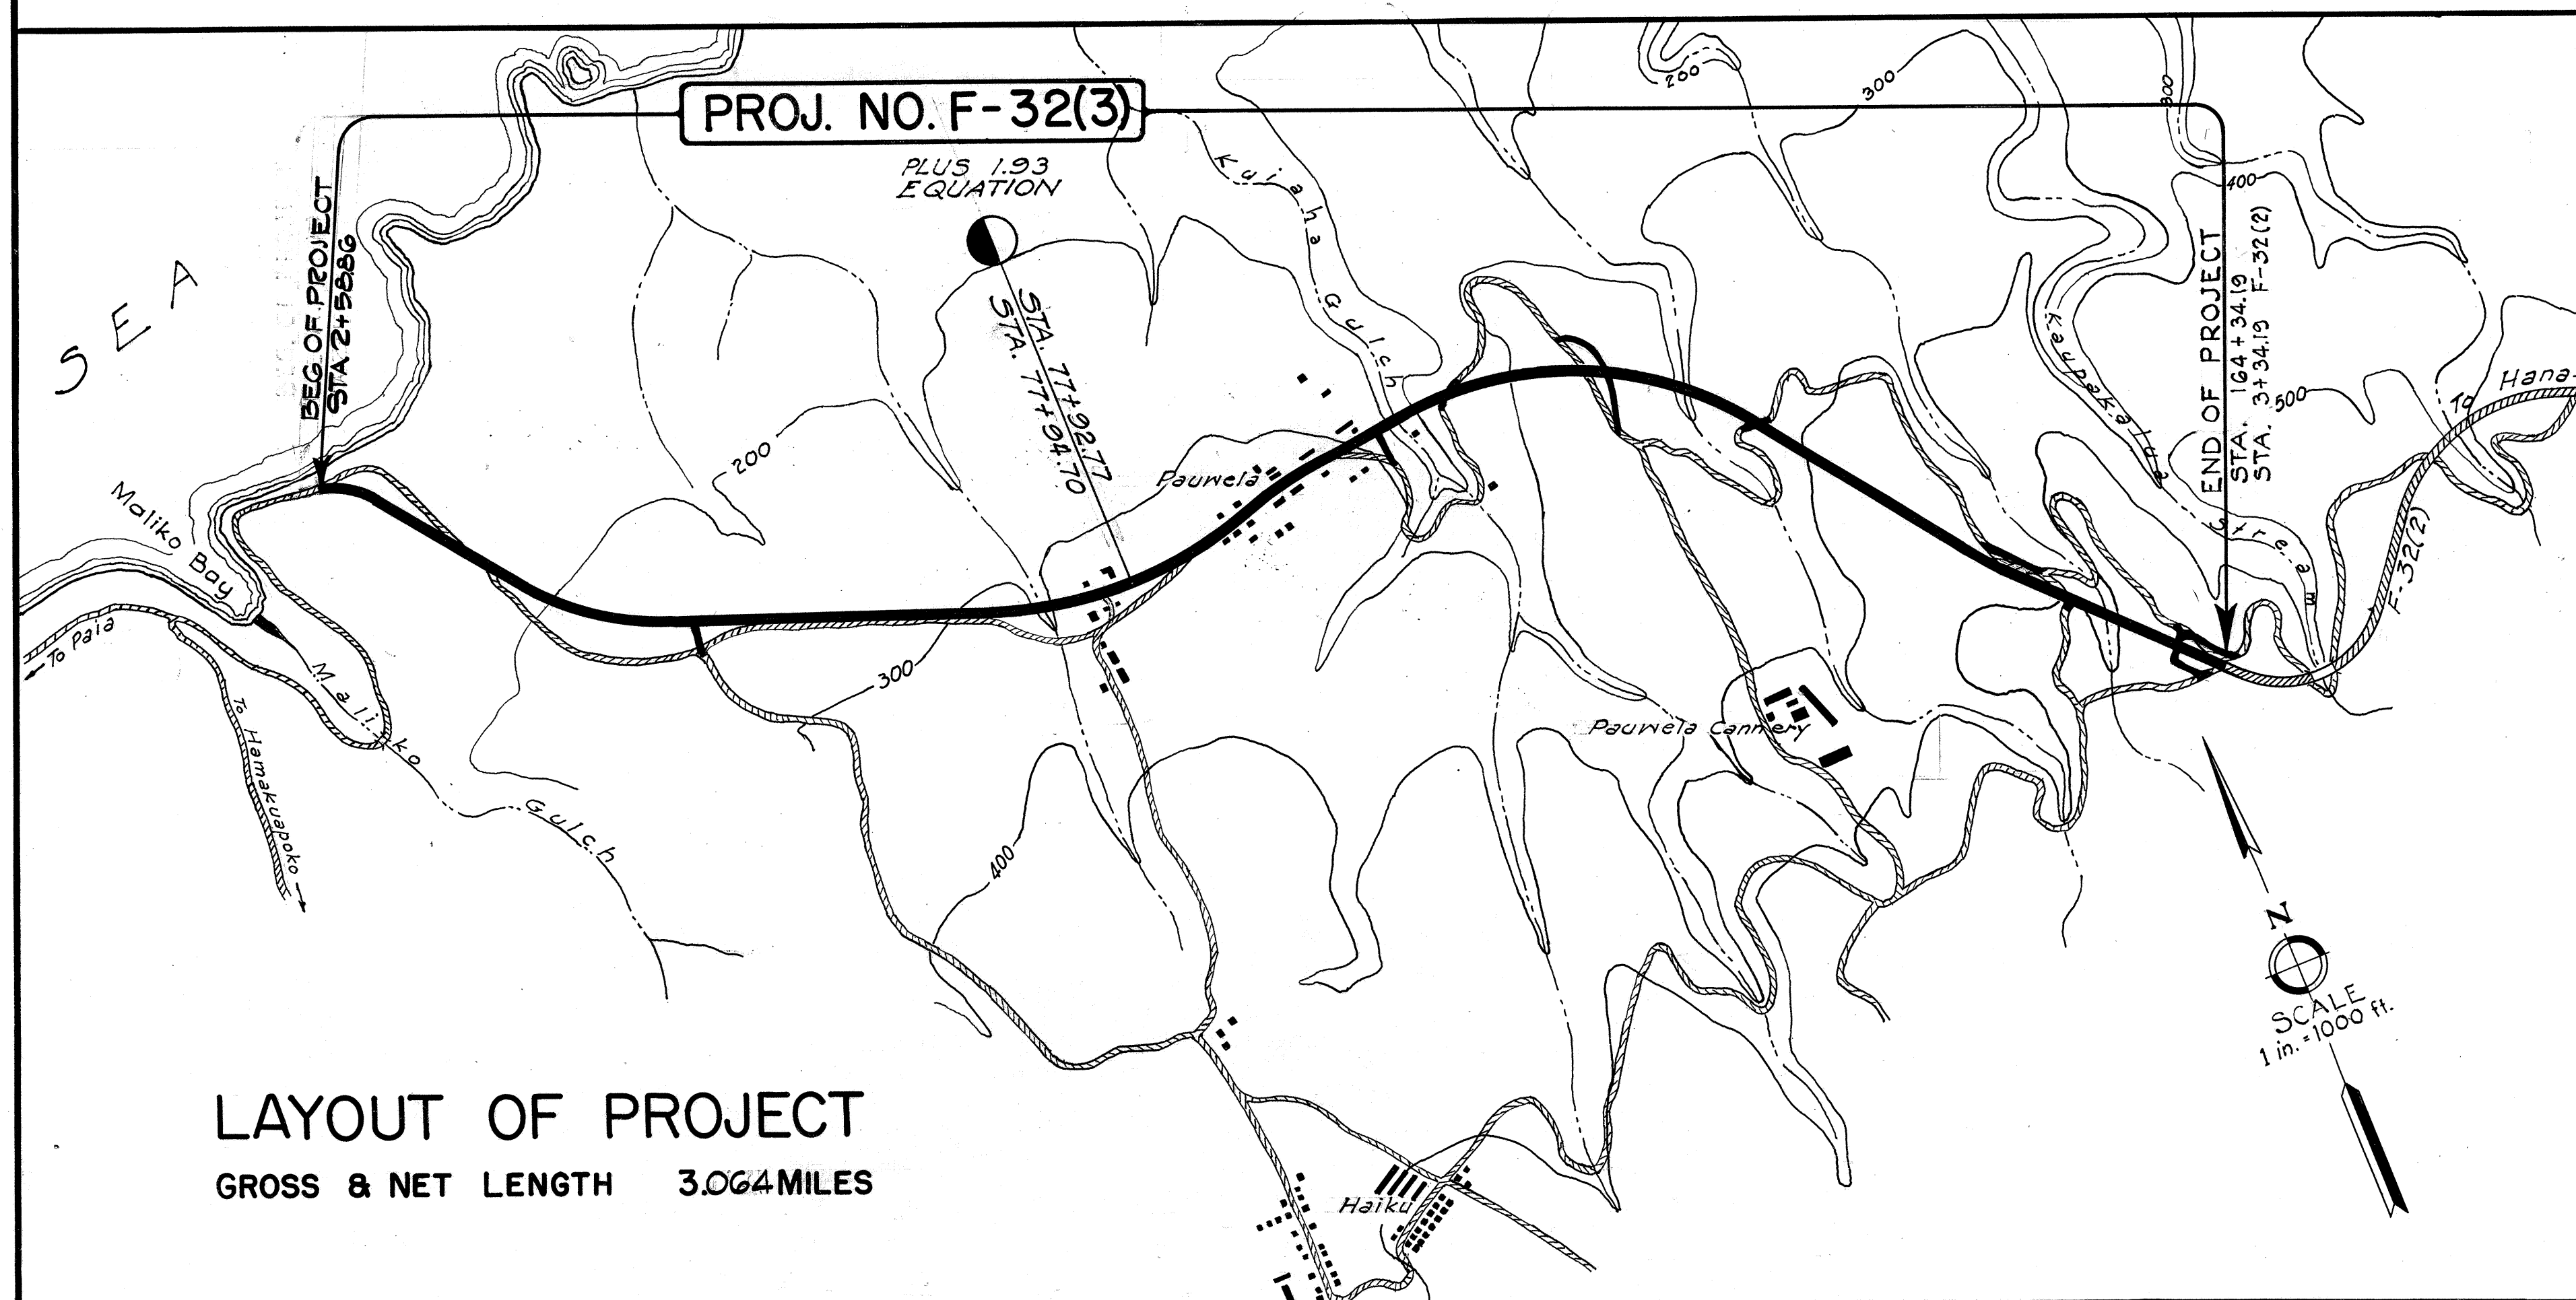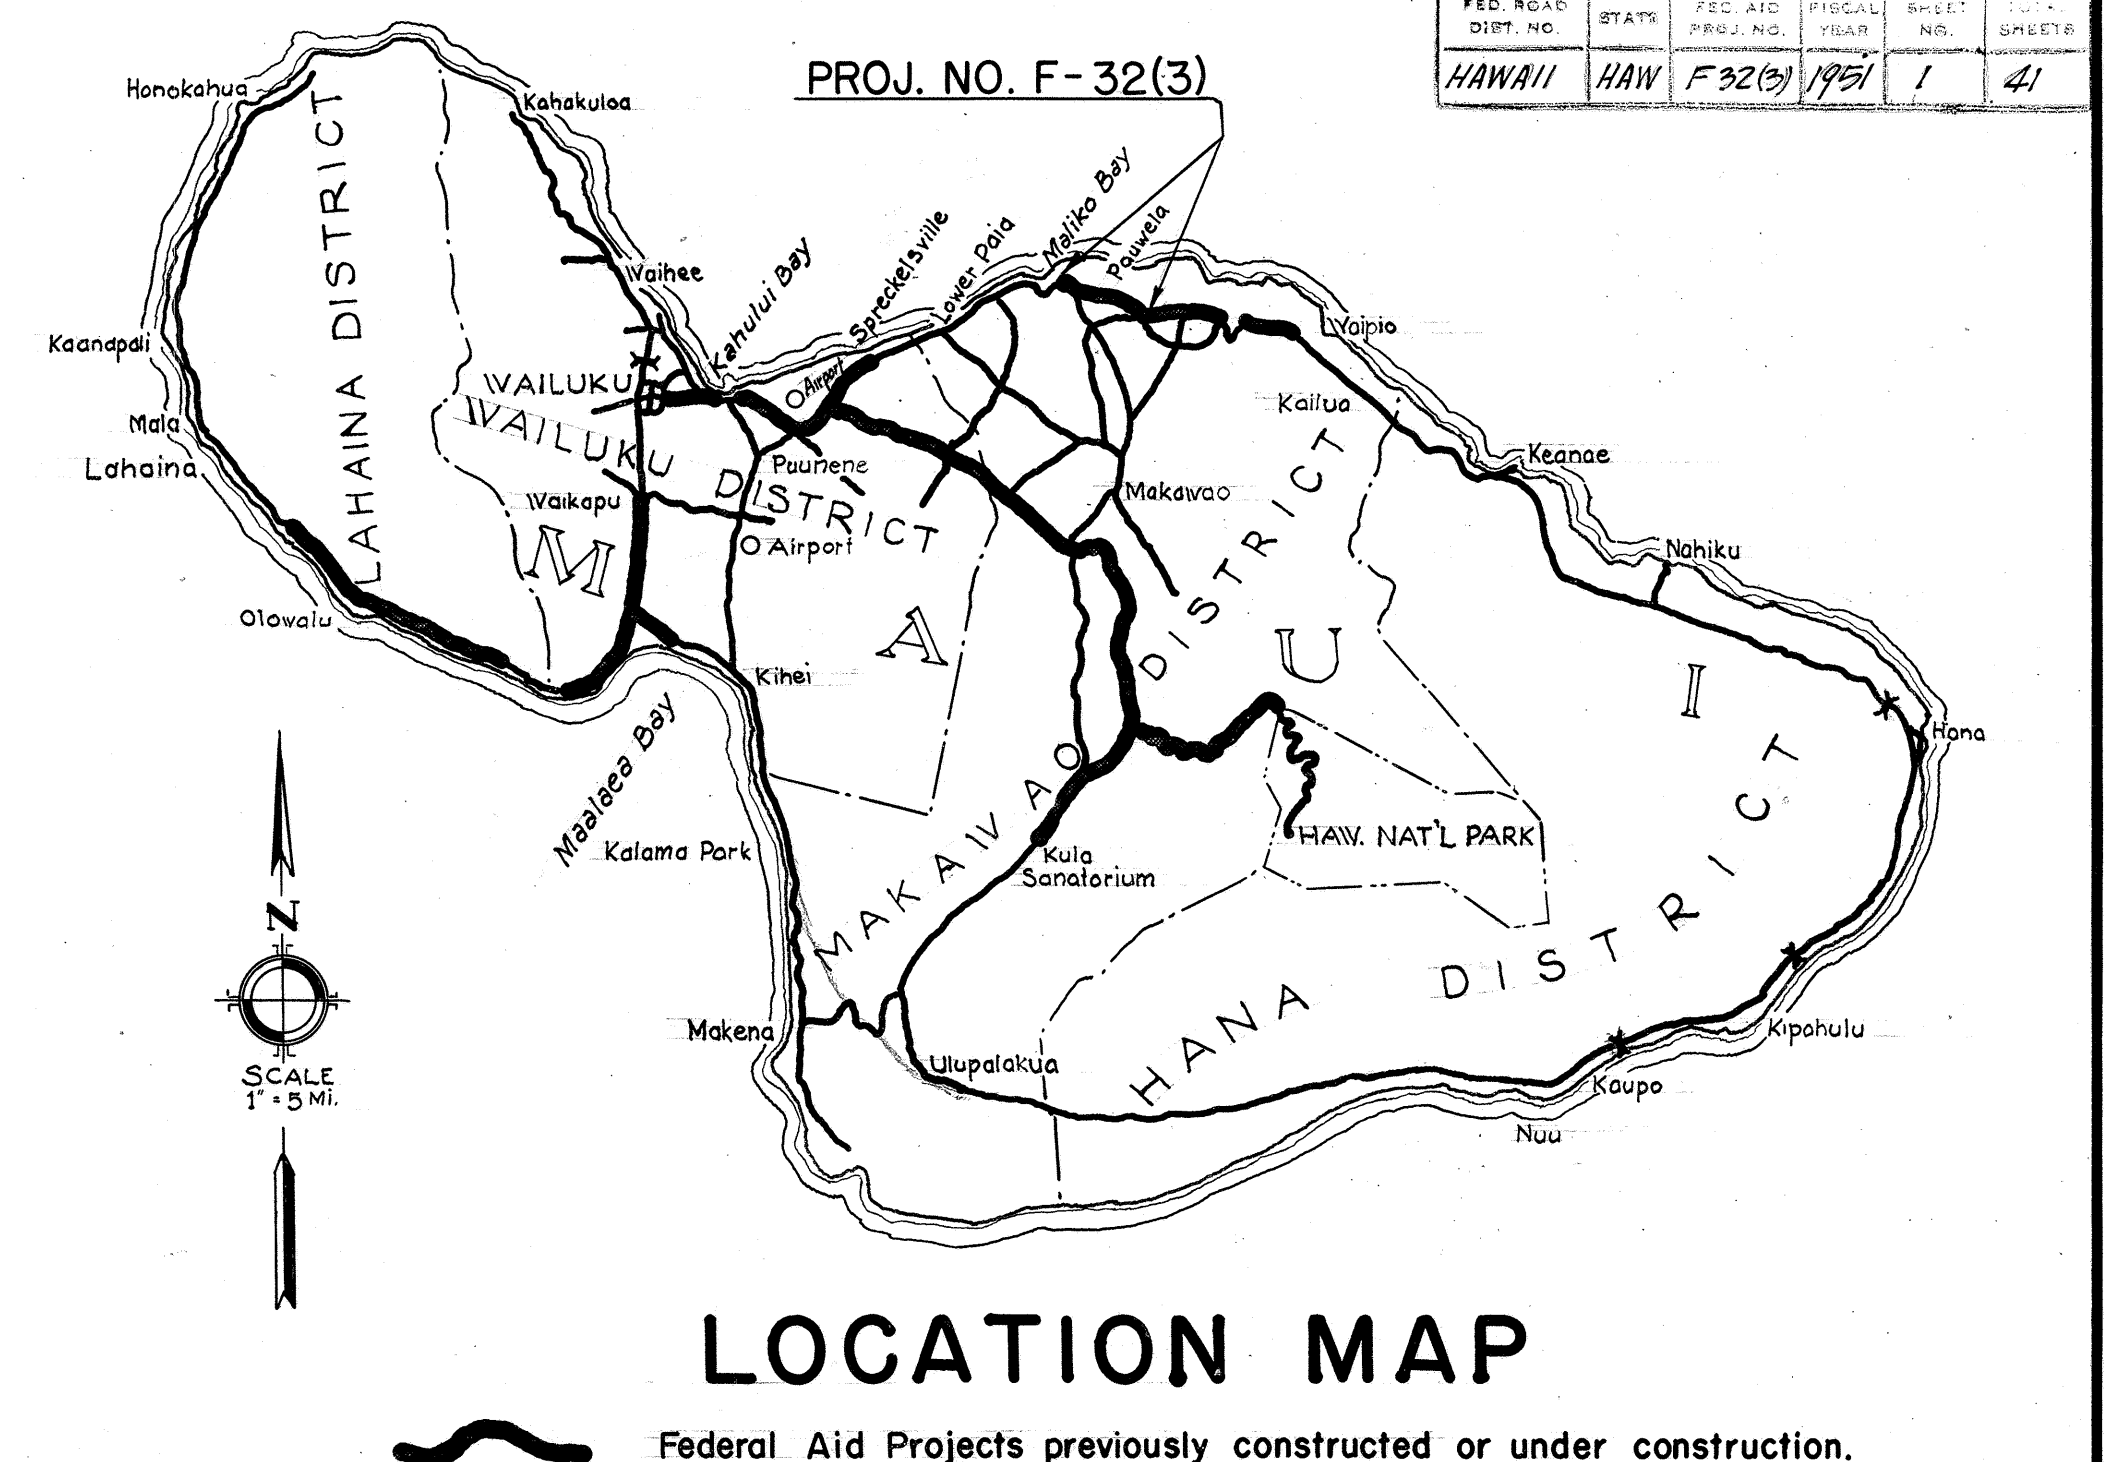

NOTE:
ALL CHANGES MADE DURING CONSTRUCTION
ARE SHOWN IN RED AND CHECKED BY:

[Signature]
DISTRICT ENGINEER
DATE 11/19/63

APPROVED: *[Signature]* DATE APR 23 1964
TERRITORIAL HIGHWAY ENGINEER

DEPARTMENT OF COMMERCE BUREAU OF PUBLIC ROADS	
RECOMMENDED FOR APPROVAL:	
DISTRICT ENGINEER	DATE
APPROVED:	
DIVISION ENGINEER	DATE

5522.1