

INDEX TO DRAWINGS	
SHEET NO	DESCRIPTION
1	TITLE SHEET
2	TYPICAL SECTION
3	PLAN

TERRITORY OF HAWAII

TERRITORIAL HIGHWAY DEPARTMENT

HONOLULU, T. H.

PLANS OF

FOOTPATH

HANA BELT ROAD

JOB NO. 5968


MAKAWAO DISTRICT

ISLAND OF MAUI

SCALE


PLAN

1 IN. = 100 FT.

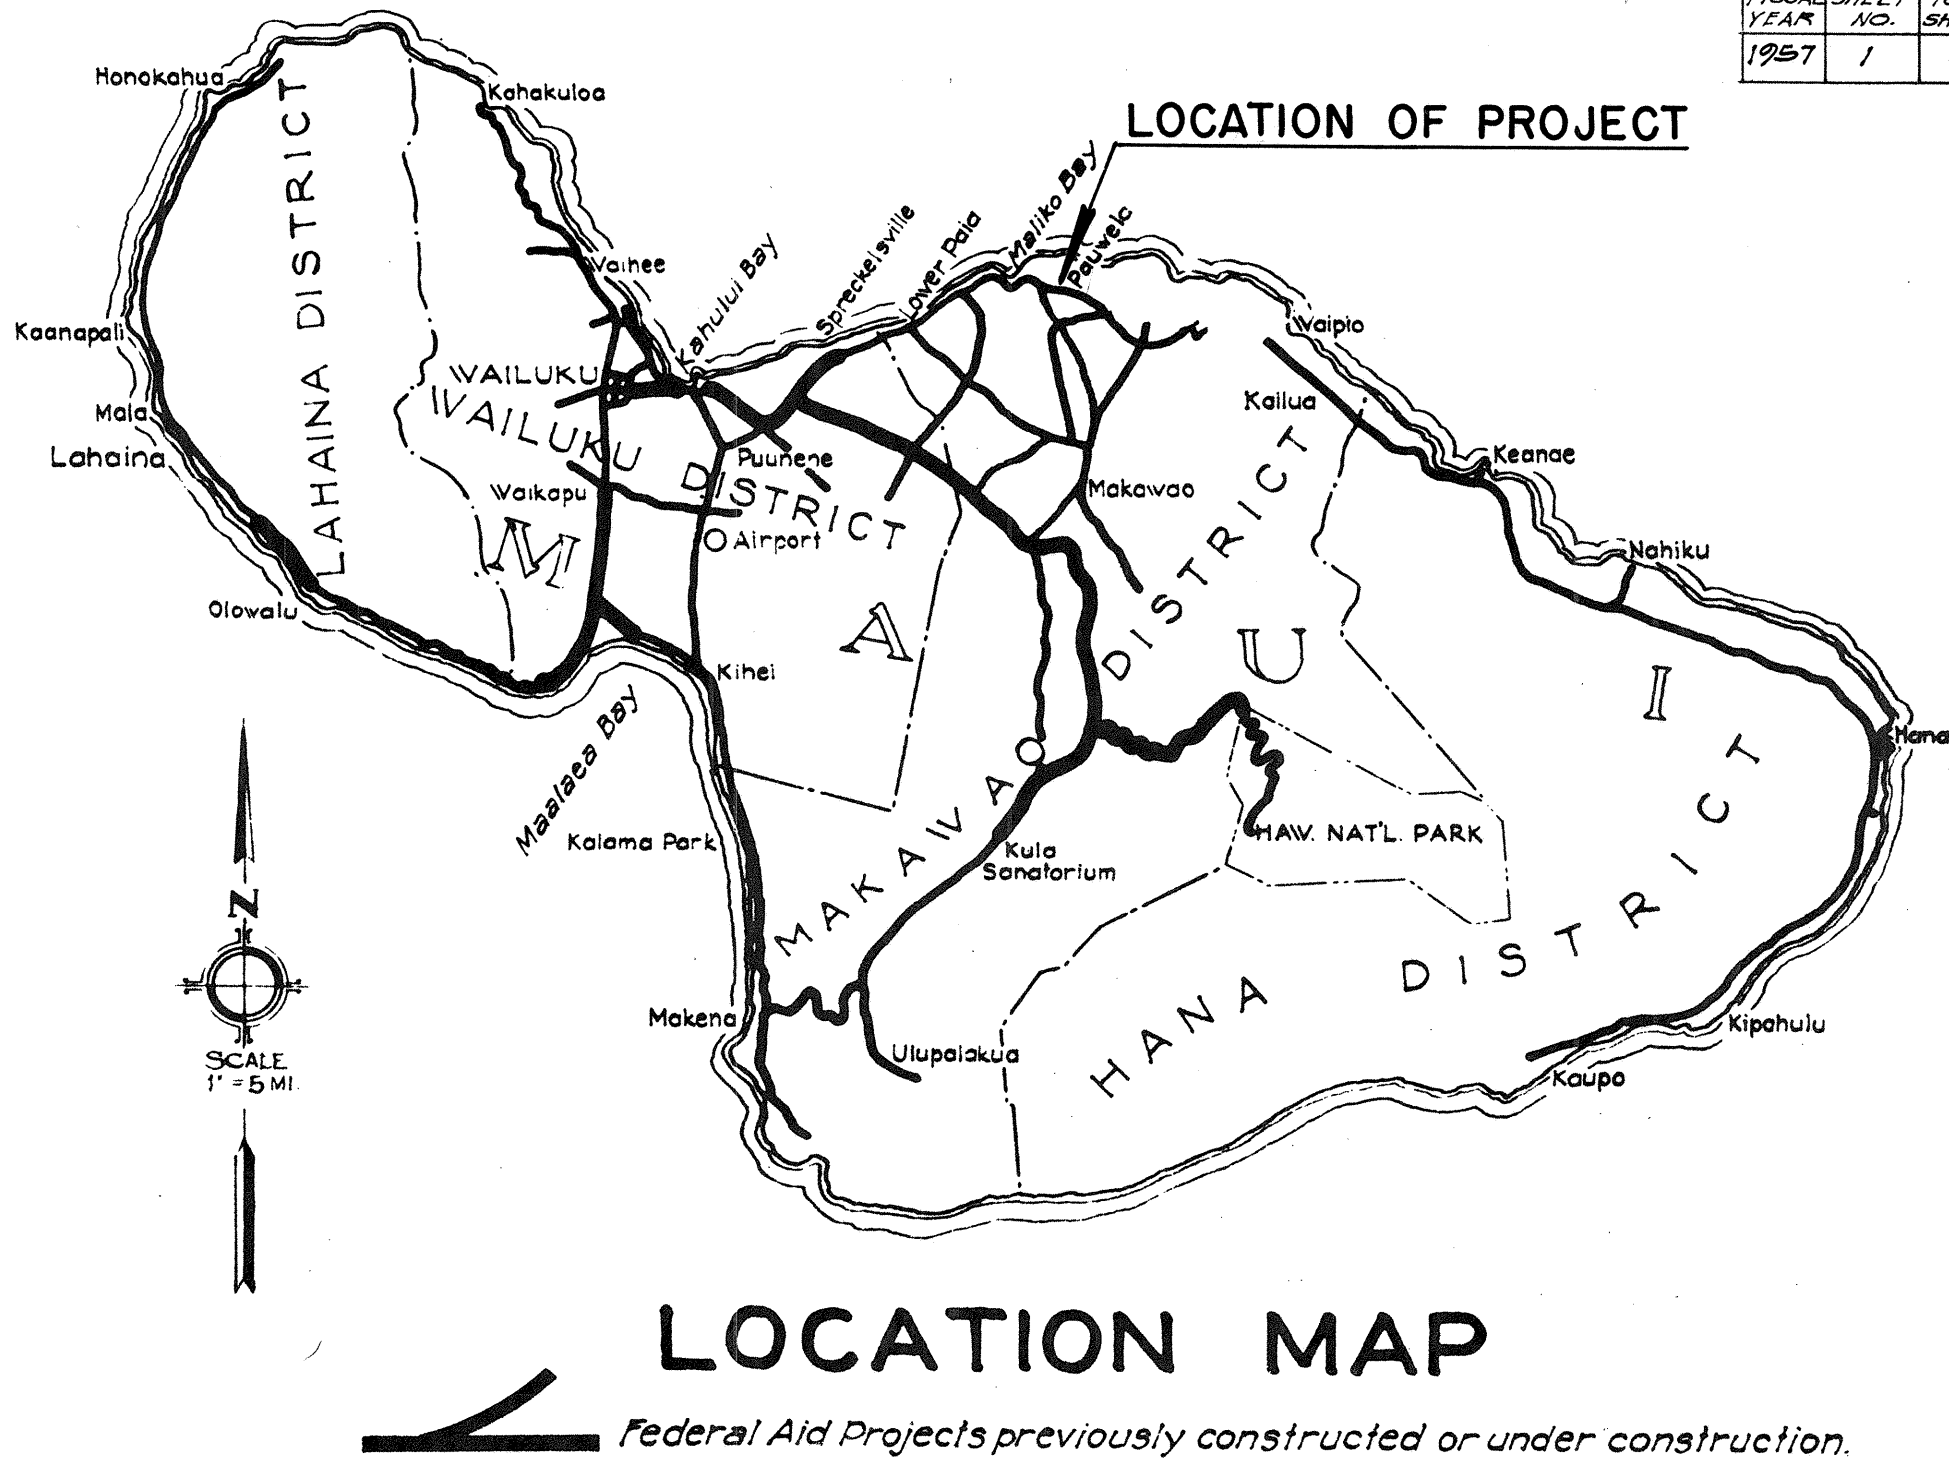

CONVENTIONAL SIGNS

Centerline	
Boundary Lines	
Fences (Named)	
Existing Roadways	
Circular Culvert	
Box Culvert	
Bridge	
Telephone Pole	
Electric Power Pole	
Water Main	
Storm Drain	
Concrete Drop Intake	
Standard Catch Basin	
Standard Manhole	
Sewer Manhole	
Telephone Manhole	
Fire Hydrant	
Trees (Named)	
Railroad	

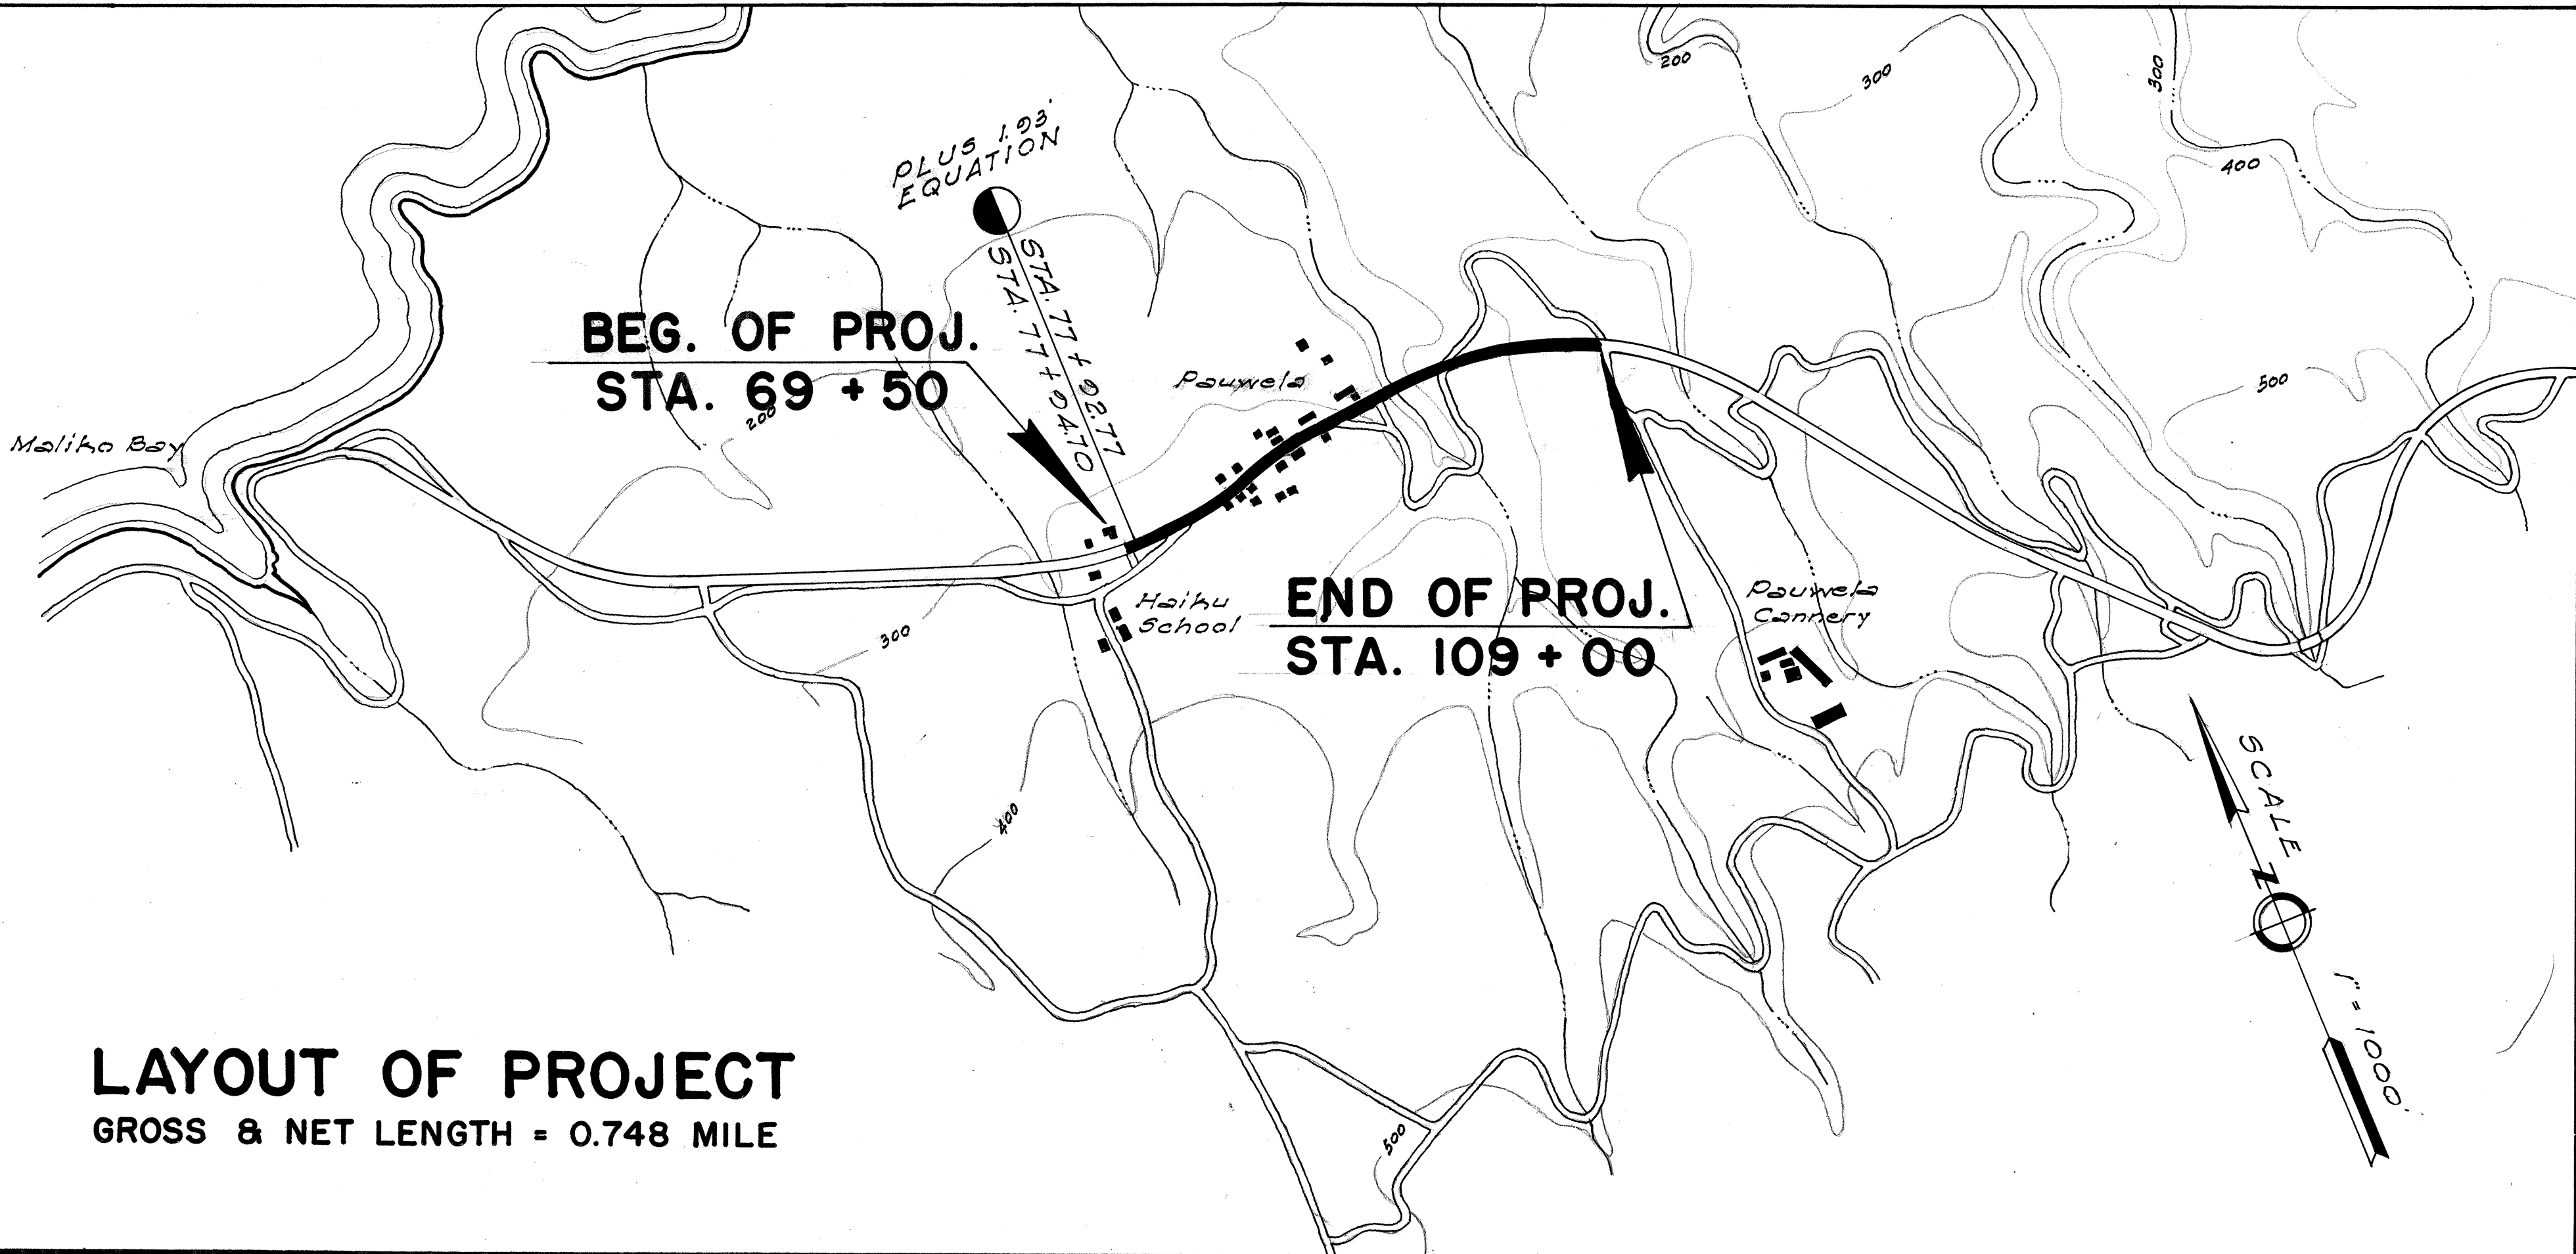

APPROVED:

DATE 10/25/17

Acting TERRITORIAL HIGHWAY ENGINEER