


DATE: _____
BY: _____
SURVEYED: _____
PLANNED: _____
NOTED: _____
NO. _____

DATE: _____
BY: _____
SURVEYED: _____
PLANNED: _____
NOTED: _____
NO. _____

SUMMARY OF REGULATORY AND WARNING SIGNS		
TYPE	MESSAGE	QUANTITY
DELINEATORS		138 160
R-1	STOP	#9
W-5-R		2
W-6		#2
W-7		#12
W-42		2
W-43		2
TOTAL		#189

GENERAL NOTES

1. ROADWAY AZIMUTHS REFERRED TO PUUNENE 2(1950) Δ
2. B.M.'S ARE REFERRED TO MEAN SEA LEVEL.
3. INSTALL $\pm$ MONUMENTS ALONG R/W $\pm$ AND $\pm$ AS STAKED BY THE ENGINEER.

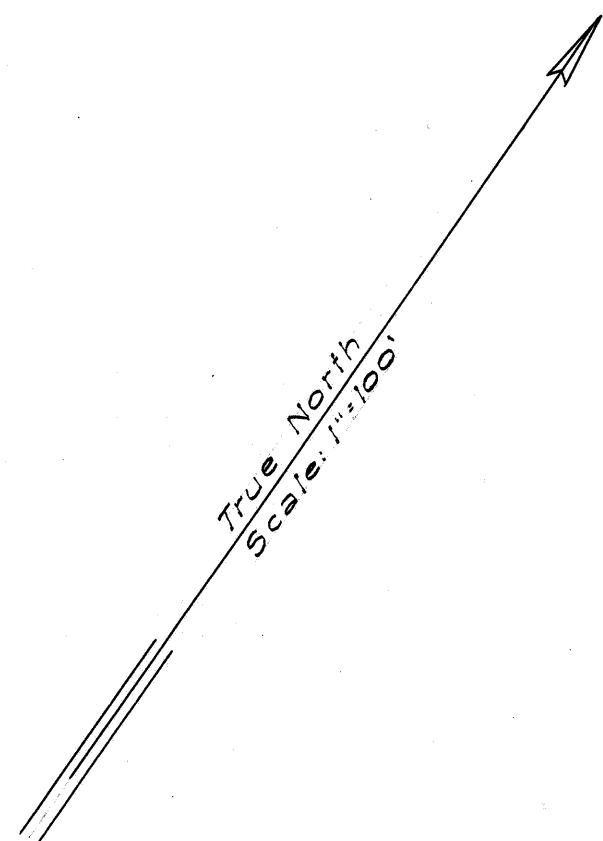

RIGHT OF WAY SYMBOLS

- NO VEHICULAR ACCESS PERMITTED
- VEHICULAR ACCESS PERMITTED

POINTS OF ACCESS

STATIONS	WIDTH OF ACCESS	
	LEFT	RIGHT
119+35	50.00'	50.00'
130+10	NONE	50.00'
141+00	50.68'	49.98'
152+00	NONE	50.00'
160+42.91	NONE	40.00'
175+90 $\pm$	40.10'	NONE
182+40	39.38'	32.95'
185+30	NONE	78.61'
190+00 $\pm$	NONE	50.00'
201+50	50.00'	NONE



NOTE TO CONTRACTOR:

THE SOIL PROFILE DATA SHOWN ON THESE SHEETS ARE FOR DESIGN PURPOSES ONLY AND ARE INTENDED FOR THE CONVENIENCE OF THE ENGINEER IN THE CONTROL OF EARTHWORK. THE BORINGS WERE CAREFULLY MADE AND ARE BELIEVED TO BE RELIABLE BUT THE ENGINEER DOES NOT GUARANTEE THE ACCURACY OF SAME. THE CONTRACTOR IS HEREBY ADVISED AND WILL BE PRESUMED TO HAVE MADE HIS OWN INVESTIGATION ON THE SITE PRIOR TO THE SUBMISSION OF HIS BID.

THE STATE WILL NOT BE HELD RESPONSIBLE FOR THE DATA SHOWN ON THESE SHEETS.



OVERHAUL SUMMARY					
Fr. Sta.	To Sta.	Net Dist.	Vol.(CY)	Sta. Yds.	Mt. Yds.
110+49	128+05	17.56	5.722	4579	4579
179+56	128+05	51.51	15.789	12662	12662
178+91	142+33	63.42	19.502	15285	15285
176+33	125+54	50.79	15.750	12662	12662
			103.833		
Free Haul			51.450		
Waste			23.220		
Total			103.833	4579	4579

FED. ROAD DIST. No.	STATE	FED. AID PROJ. No.	FISCAL YEAR	SHEET No.	TOTAL SHEETS
HAWAII	HAW.	F0364(1)	1957	3	50

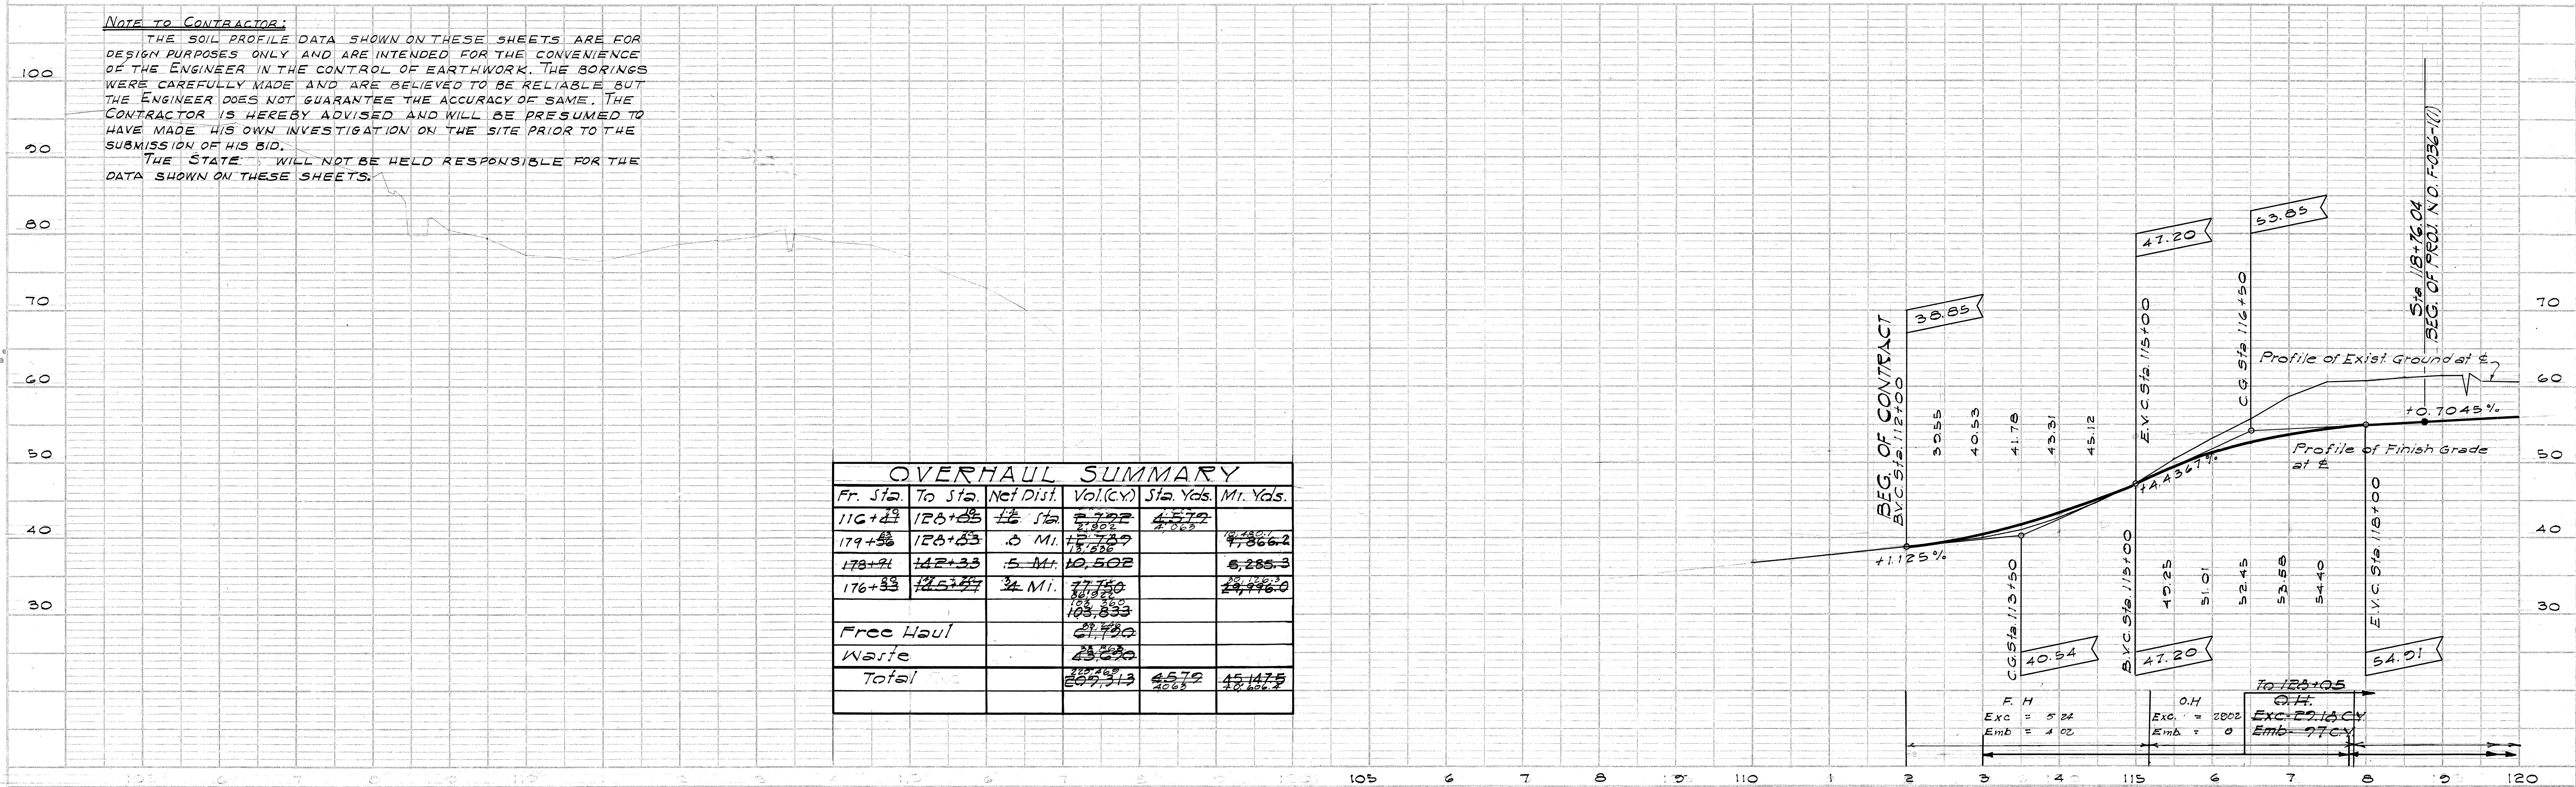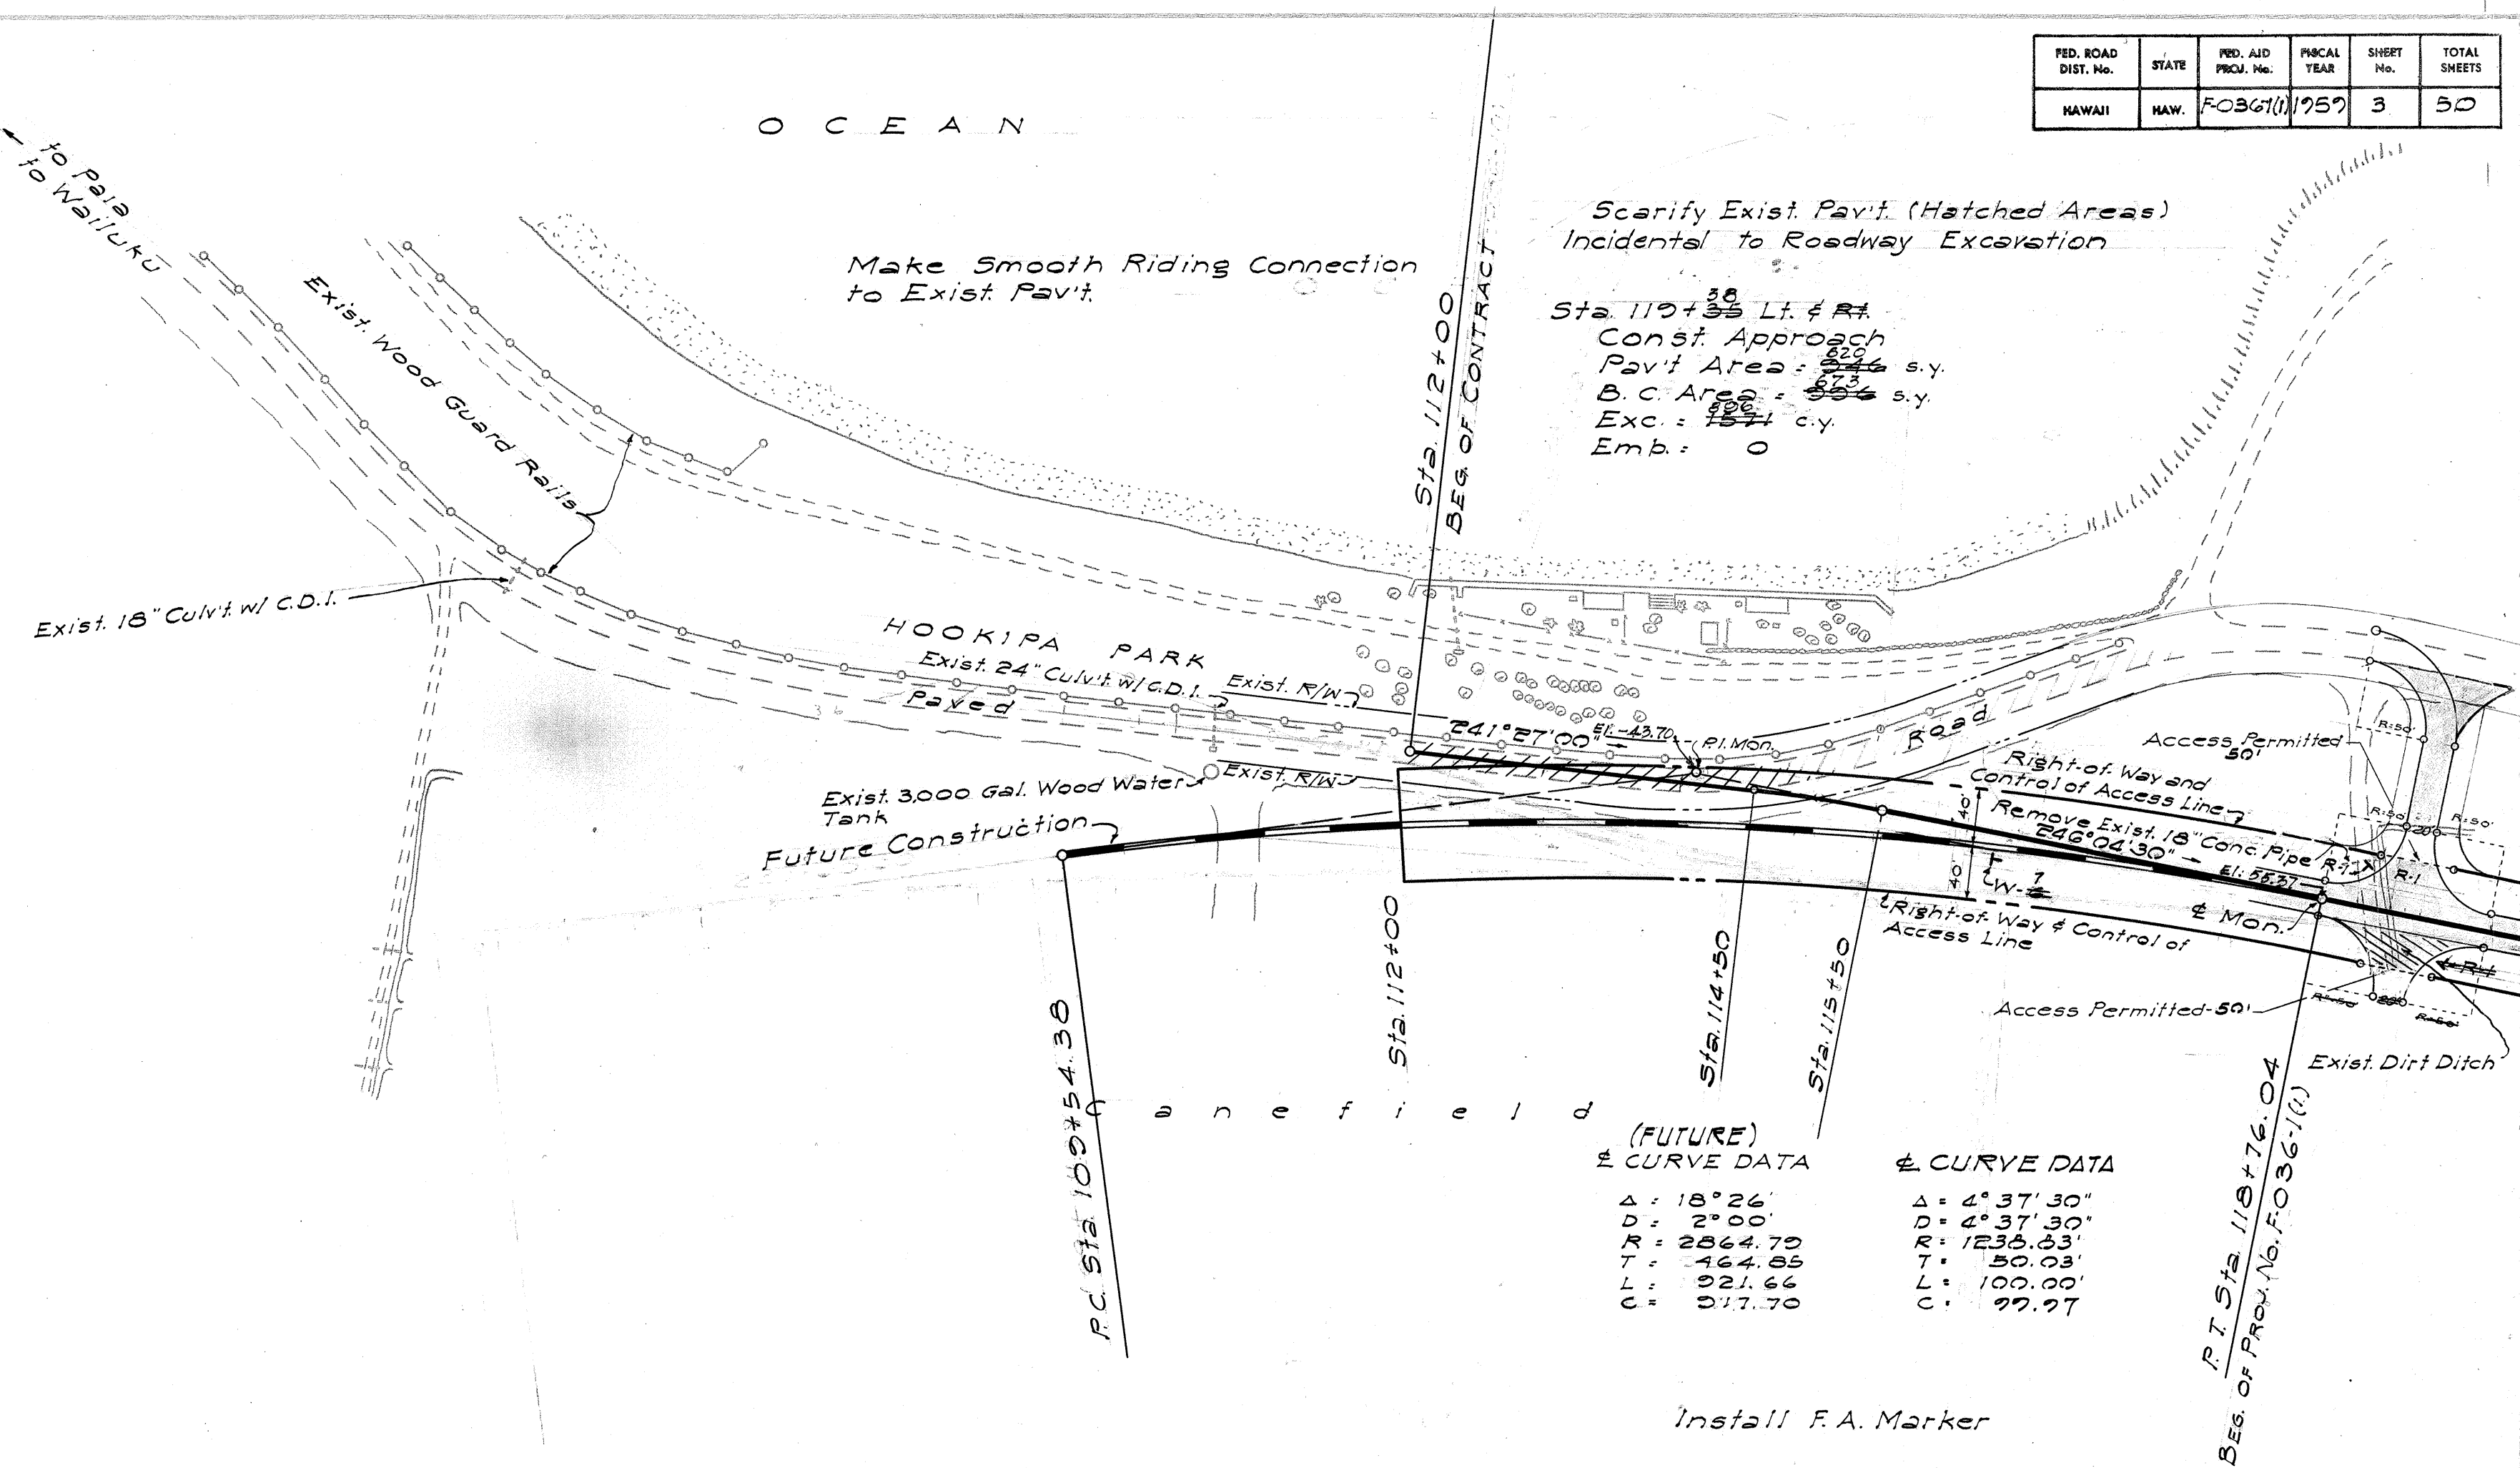

PLAN
 SURVEYED
 NOTE BOOK
 LAUNCHING CHECKED
 RT. OF WAY CHECKED
 NO.

PROFILE
 SURVEYED
 NOTE BOOK
 GRADE CHECKED
 3/8 IN. NOTED
 STRUCTURE NOTED
 NO.

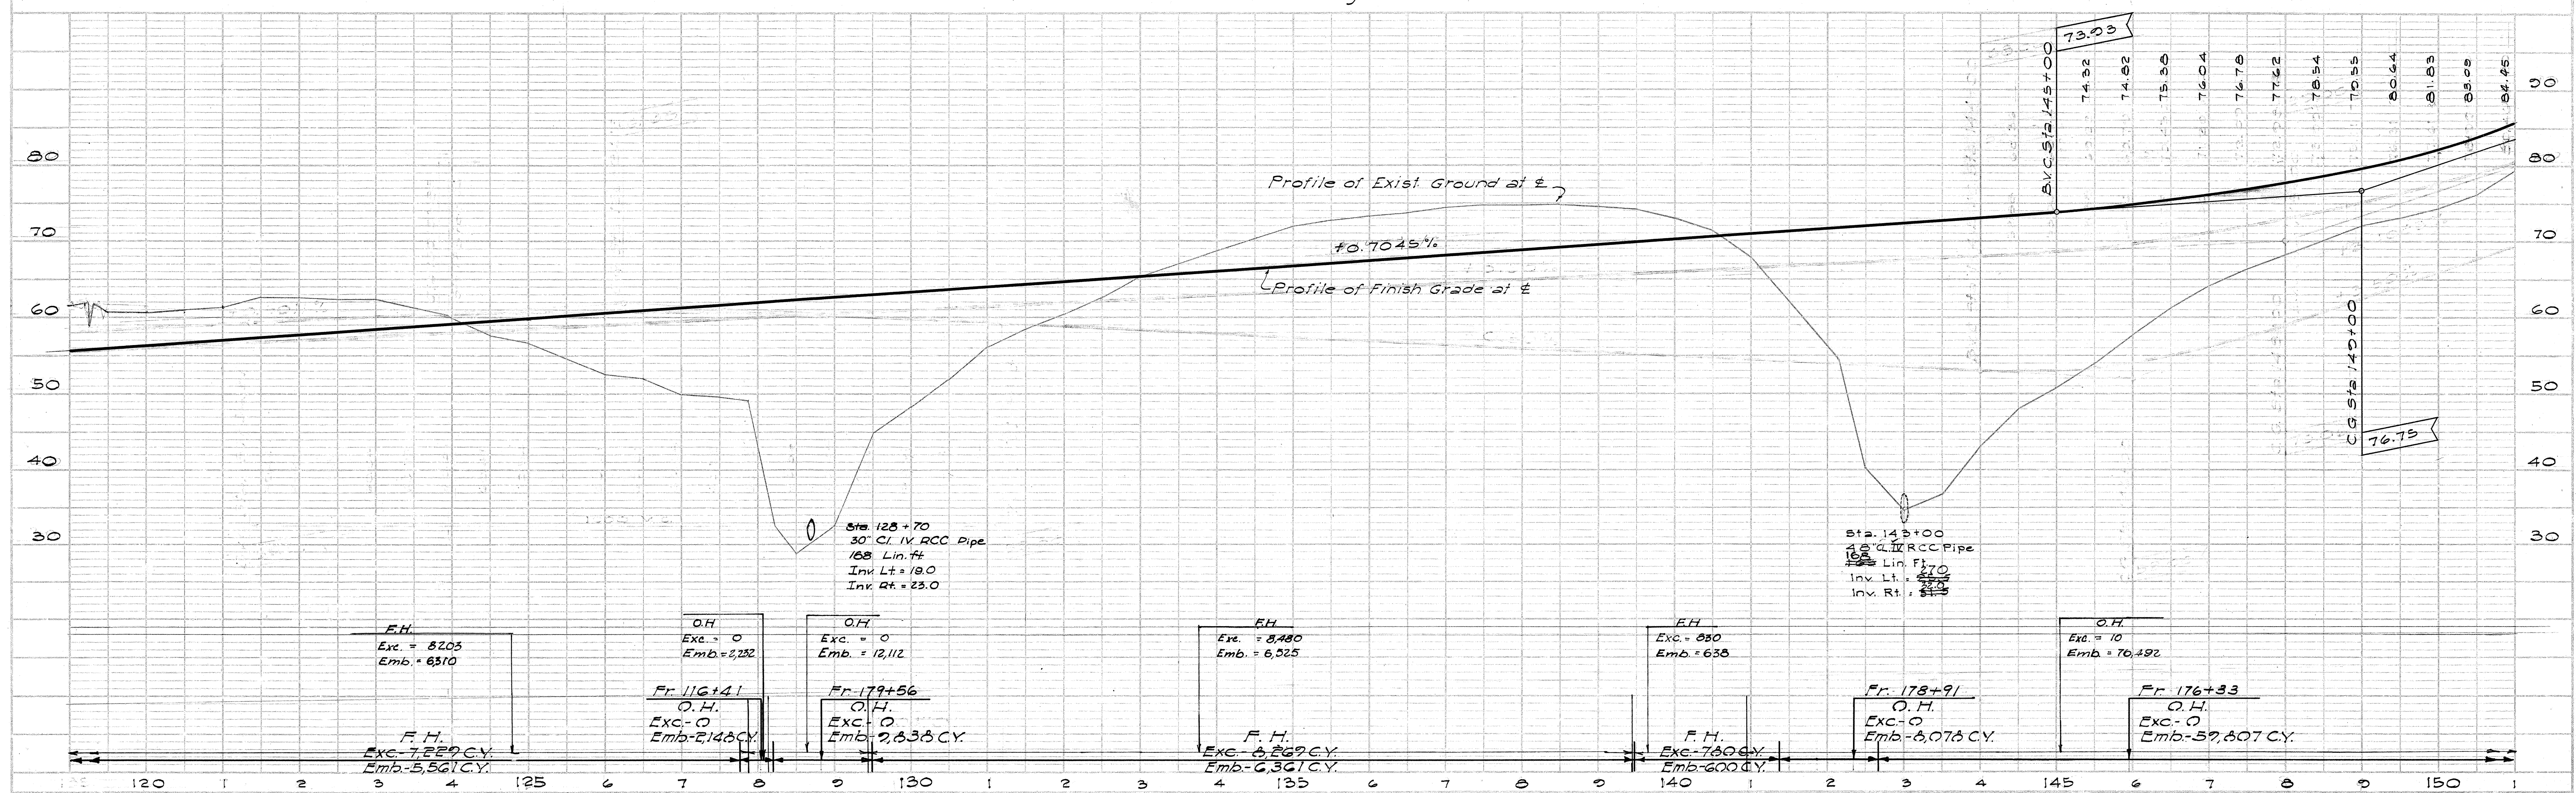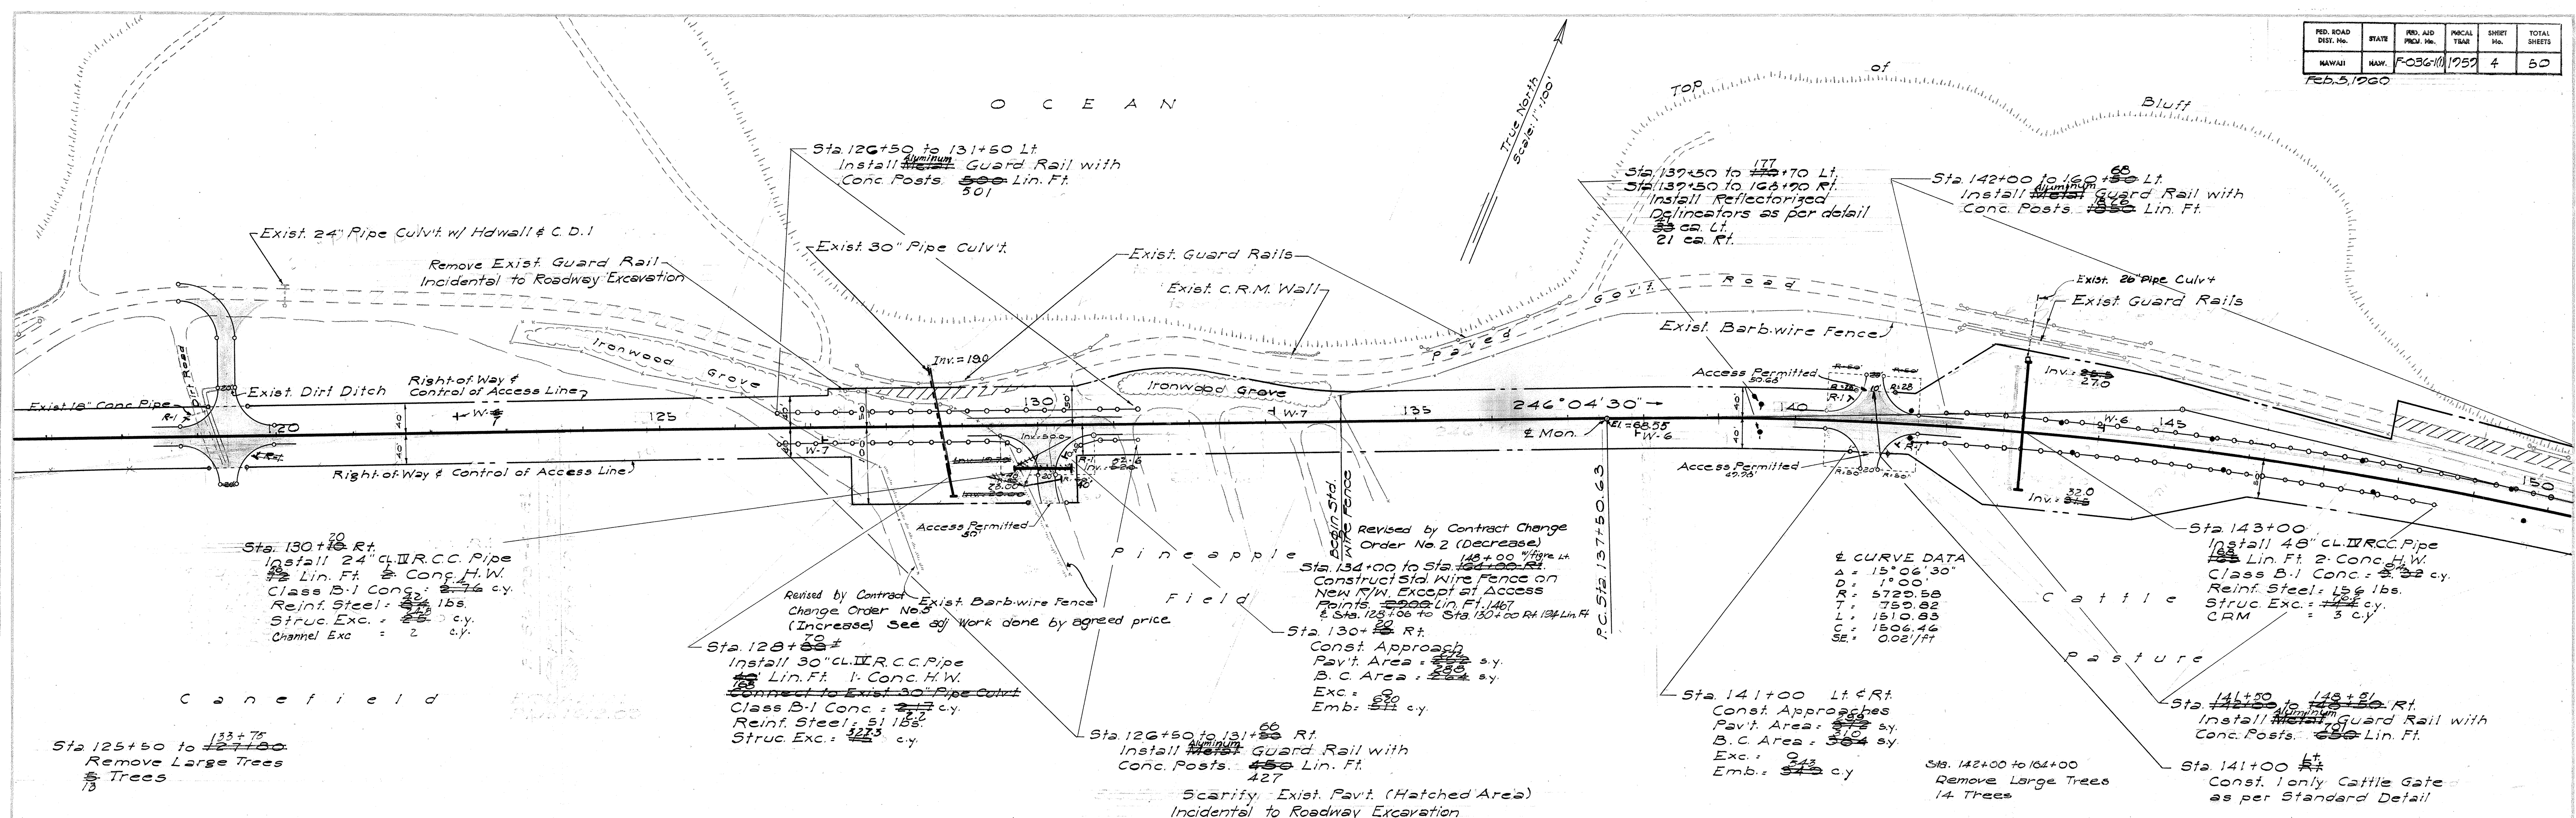

FED. ROAD DIST. No.	STATE	FED. AID PROJ. No.	FISCAL YEAR	SHEET No.	TOTAL SHEETS
HAWAII	HAW.	F-036(1)	1957	5	50

Feb. 5, 1960

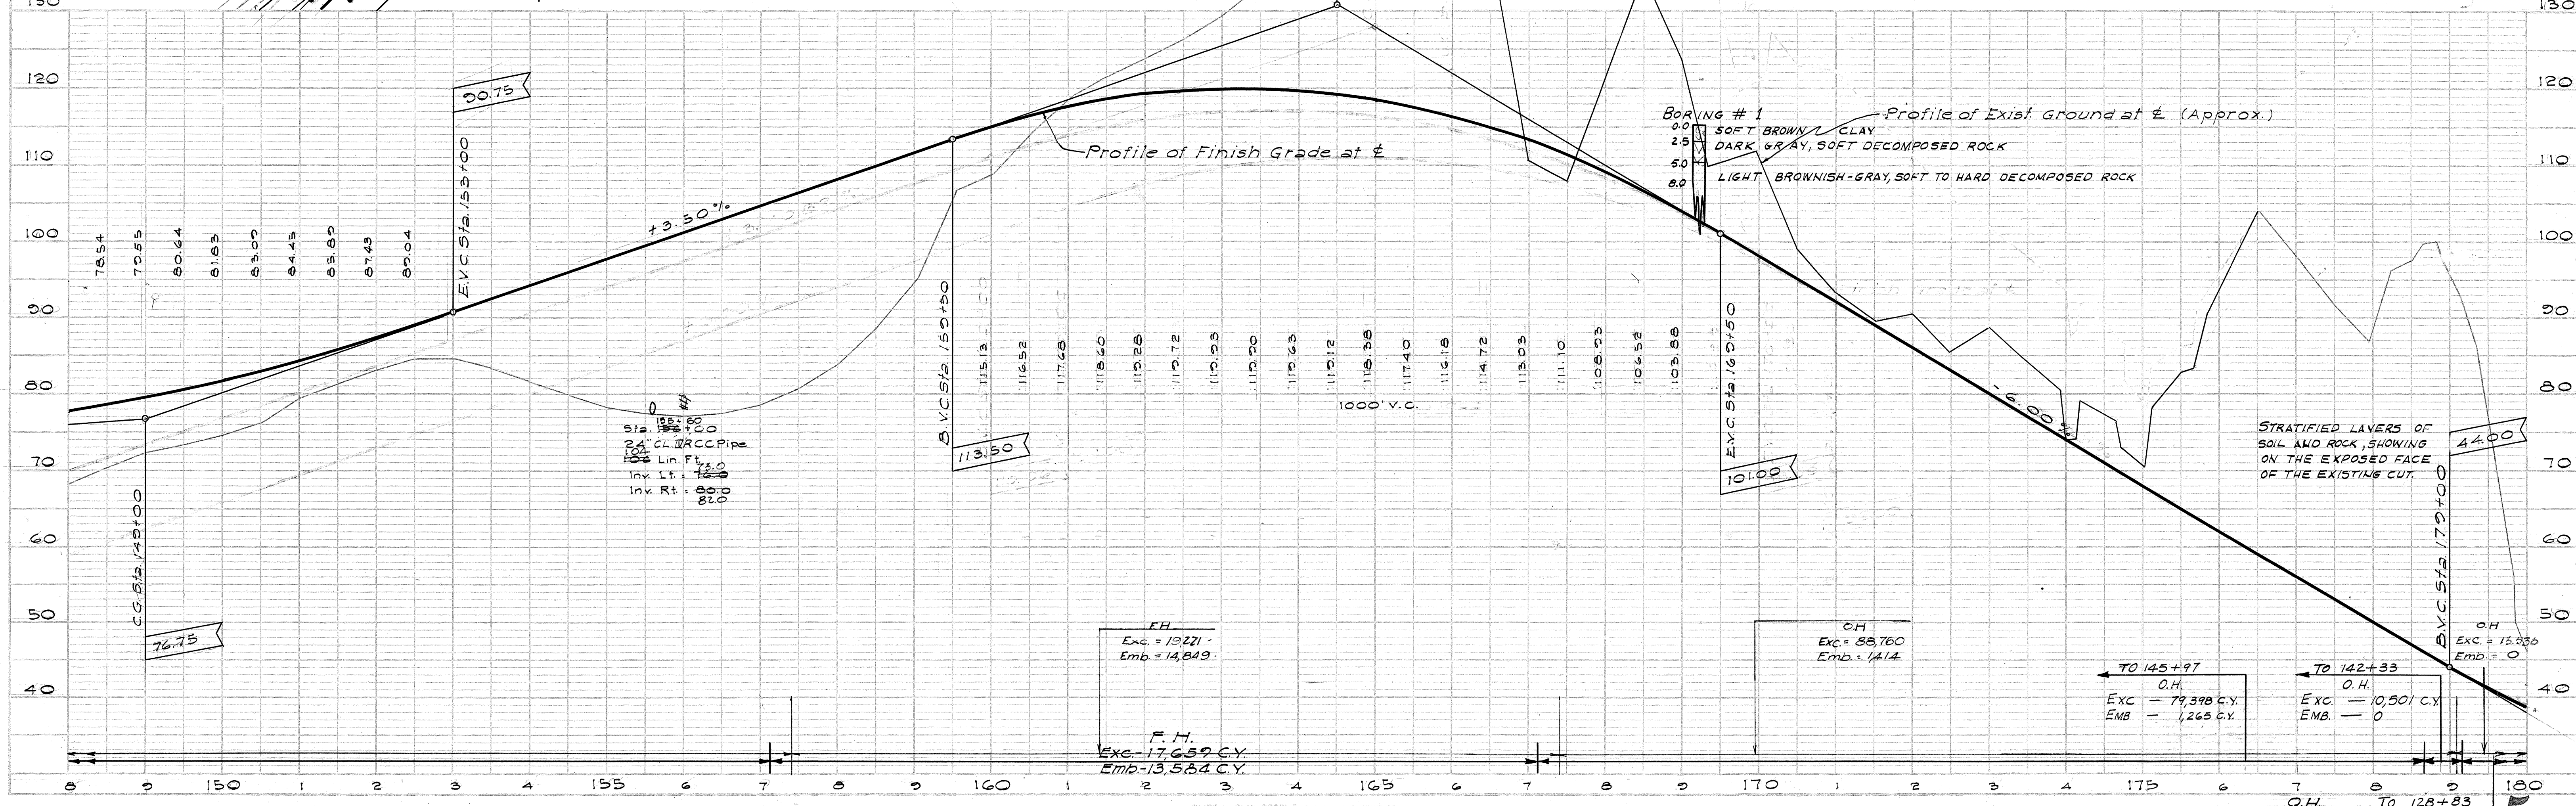
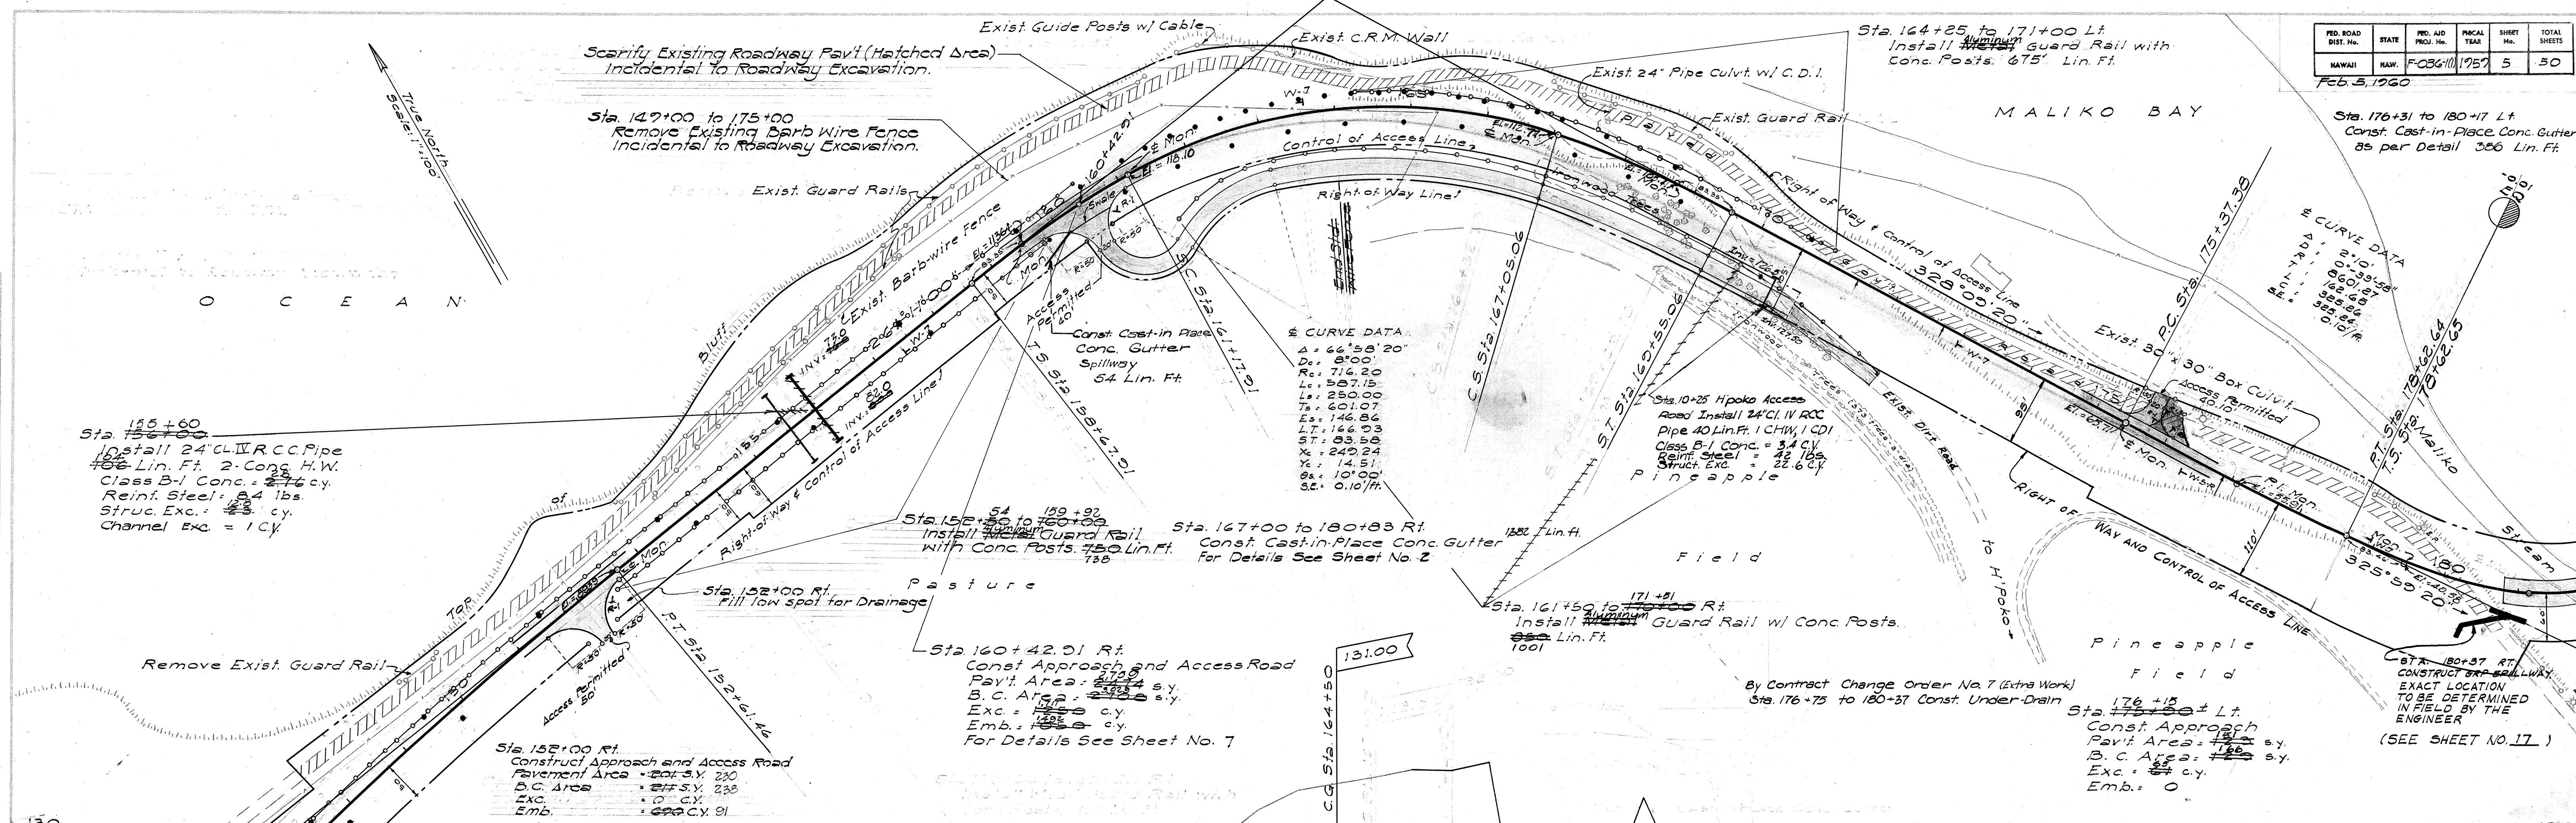


PLATE 1-PLAN-PROFILE O.P.R. & R.E. STANDARD
REUNYER & KISSER CO., NEW YORK

4 & 5 Co. No. 348-10

FED. ROAD DIST. No.	STATE	FED. AID PROJ. No.	FISCAL YEAR	SHEET No.	TOTAL SHEETS
HAWAII	HAW.	F-036(1)	1959	7	50

PLAN	DATE	BY	NO.
SURVEYED			
PLOTTED			
NOTE BOOK, ALIGNMENT CHECKED			
STRUCTURE NOTATIONS CHECKED			

PROFILE	DATE	BY	NO.
SURVEYED			
PLOTTED			
NOTE BOOK, GRADES CHECKED			
STRUCTURE NOTATIONS CHECKED			

