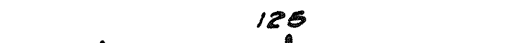
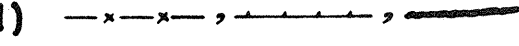
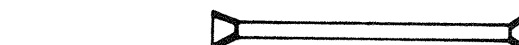
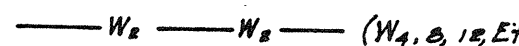


INDEX TO DRAWINGS	
SHEET NO	DESCRIPTION
1	TITLE SHEET
2	TYPICAL SECTION
3-7	PLAN & PROFILE
8-14	BRIDGE DETAILS
15-22	MISCELLANEOUS DETAIL
23-50	CROSS SECTIONS

CONVENTIONAL SIGNS	
Centerline	
Boundary Lines	
Fences (Named)	
Existing Roadways	
Circular Culvert	
Box Culvert	
Bridge	
Telephone Pole	
Electric Power Pole	
Water Main	
Storm Drain	
Concrete Drop Intake	
Standard Catch Basin	
Standard Manhole	
Sewer Manhole	
Telephone Manhole	
Fire Hydrant	
Trees (Named)	
Railroad	

STATE OF HAWAII

HAWAII STATE HIGHWAY DEPARTMENT

HONOLULU , HAWAII

AS BUILT

PLANS OF

HANA BELT ROAD

MALIKO SECTION


FEDERAL AID PROJECT No F-036-I(1)

DISTRICT OF MAKAWAO

ISLAND OF MAUI

SCALE

PLAN	1 IN. = 100 FT.
PROFILE	HOR. 1 IN. = 100 FT.
	VER. 1 IN. = 10 FT.
X-SECTIONS	HOR. 1 IN. = 10 FT.
	VER. 1 IN. = 10 FT.

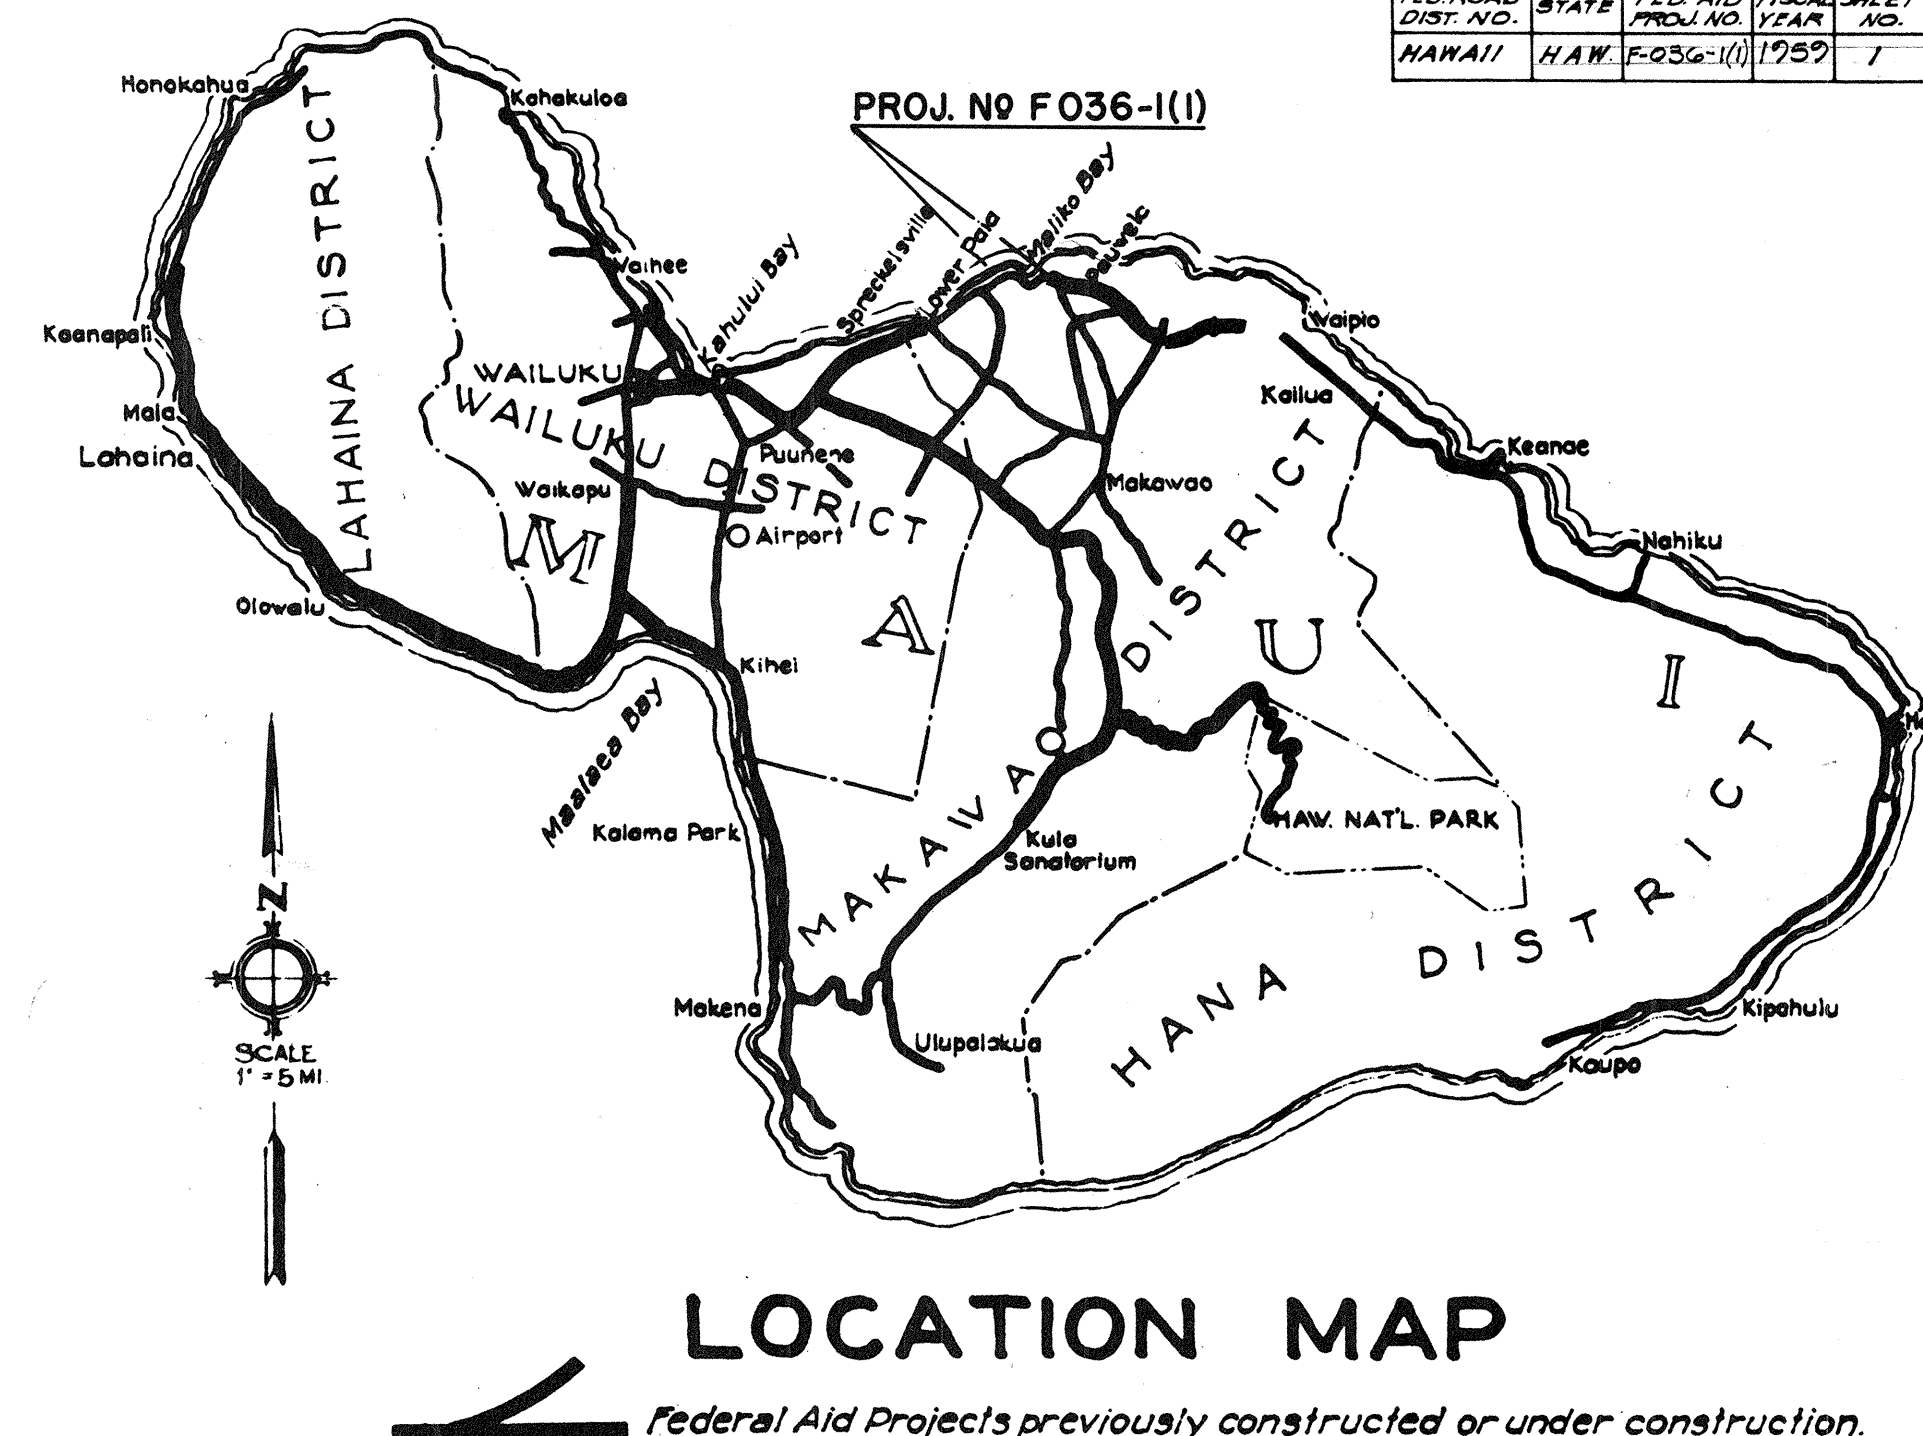

NOTE :

ALL CHANGES MADE DURING CONSTRUCTION HAVE BEEN NOTED IN THESE TRACINGS IN RED AND CHECKED BY

W.T. Juwada
RESIDENT ENGINEER

7/12/61
DATE

APPROVED: *[Signature]* DATE 1/18/60
STATE HIGHWAY ENGINEER

DEPARTMENT OF COMMERCE
BUREAU OF PUBLIC ROADS
APPROVED: *[Signature]*
DIVISION ENGINEER DATE

GROSS LENGTH OF PROJECT	1.662	Mi.
BRIDGES OVER 20-FT. SPAN	0.039	"
NET LENGTH OF ROADWAY	1.623	"

F. 036101.1