DESCRIPTION TLE AN-DETAILS
AN-DETAILS
AN ULIMILO
ANDARD DETAILS
OJECT INFORMATION SIGN
OSS SECTION

STATE OF HAWAII DEPARTMENT OF TRANSPORTATION HIGHWAYS DIVISION HONOLULU, HAWAII


"AS BUILT" PLANS OF

DRAINAGE IMPROVEMENT

HANA HIGHWAY

(VICINITY OF PAUWELA) PROJECT NO. 36C-01-71

> DISTRICT OF MAKAWAO ISLAND OF MAUI

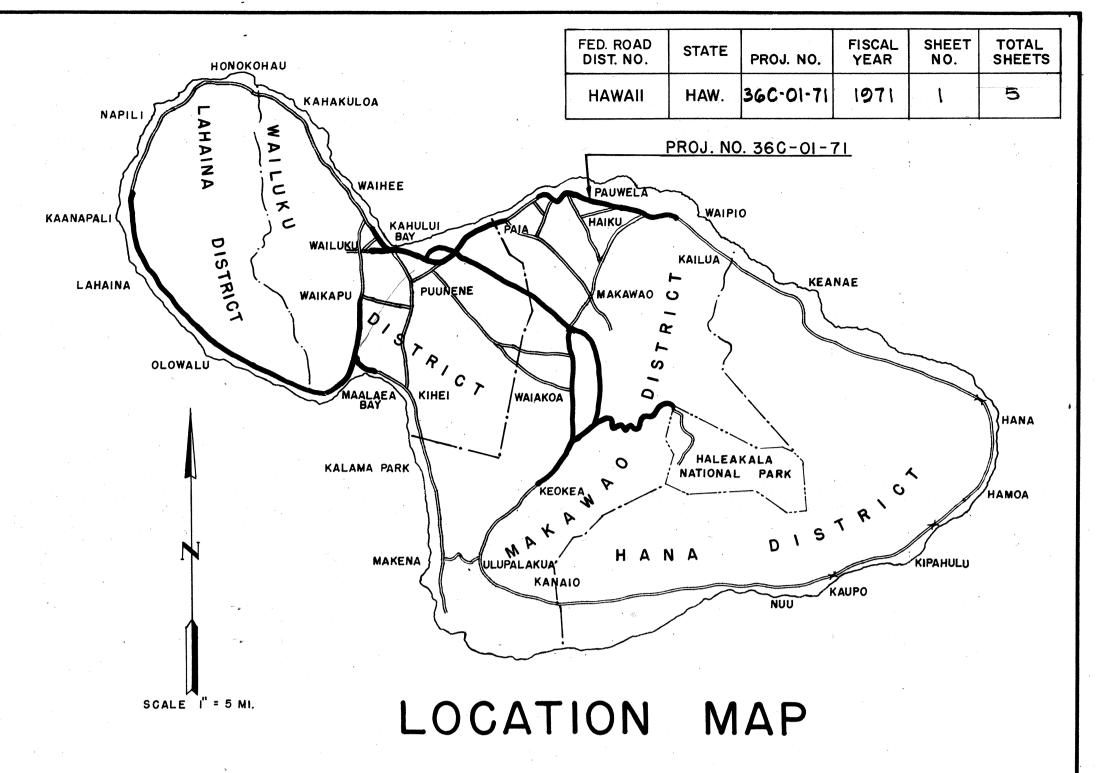


NOTE:

ALL CHANGES MADE DURING CONSTRUCTION HAVE BEEN NOTED ON THESE TRACINGS IN RED AND CHECKED BY:

> Am Tahamste . Dept. 7-1972 PROJECT ENGINEER

All the quantities shown on these plans are original theoretical quantities. For actual quantities, refer to project ledger and/or computation book.

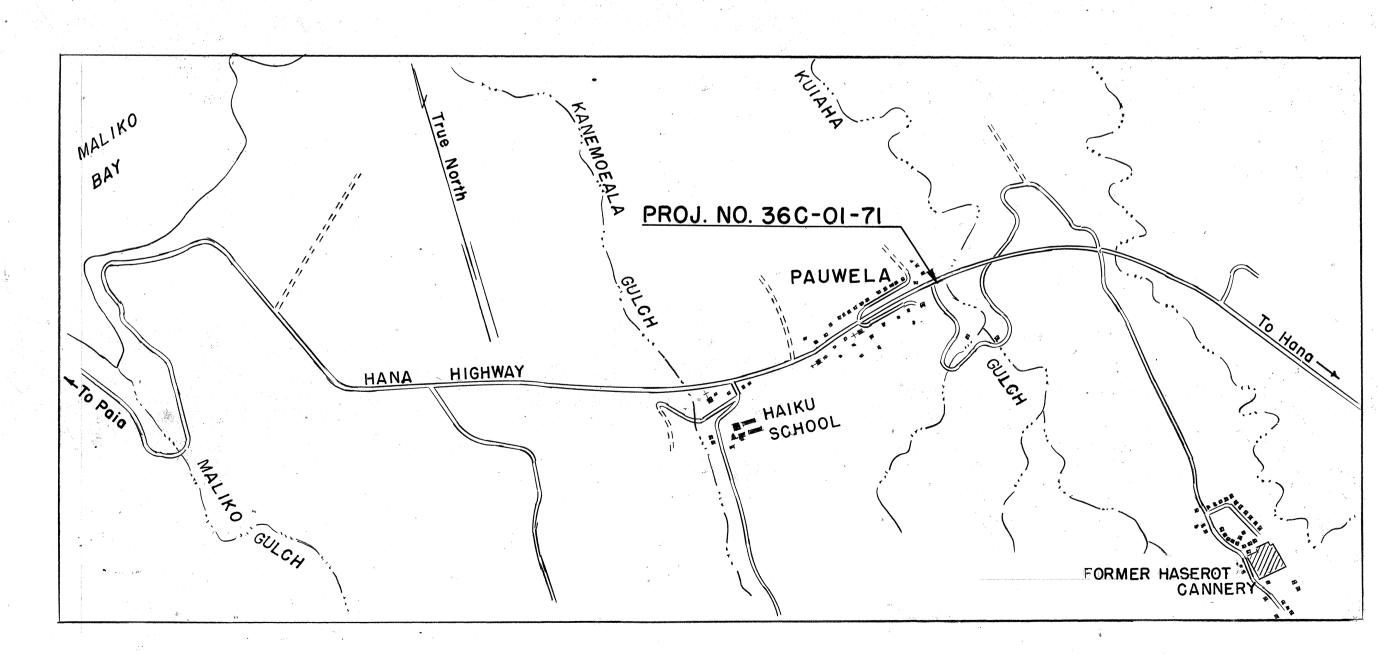

LAYOUT OF PROJECT

SCALE: 1"= 1000"

DEPARTMENT OF TRANSPORTATION STATE OF HAWAII APPROVED: DIR. OF TRANSPORTATION

MAUI DISTRICT OFFICE STATE HIGHWAY DIVISION JANUARY 1971

Mike Miura P.S.& E. BY: