

INDEX TO DRAWINGS	
SHEET NO	DESCRIPTION
1	TITLE SHEET
2	PLAN
3	MISCELLANEOUS DETAILS
4-9	STANDARD DETAILS

STATE OF HAWAII

DEPARTMENT OF TRANSPORTATION

HIGHWAYS DIVISION

HONOLULU, HAWAII

"AS BUILT"

PLANS FOR

THE INSTALLATION OF TRAFFIC SIGNALS

ON


HANA HIGHWAY

AT HALEAKALA HIGHWAY

PROJECT NO.36A - 01 - 71

DISTRICT OF WAILUKU

ISLAND OF MAUI

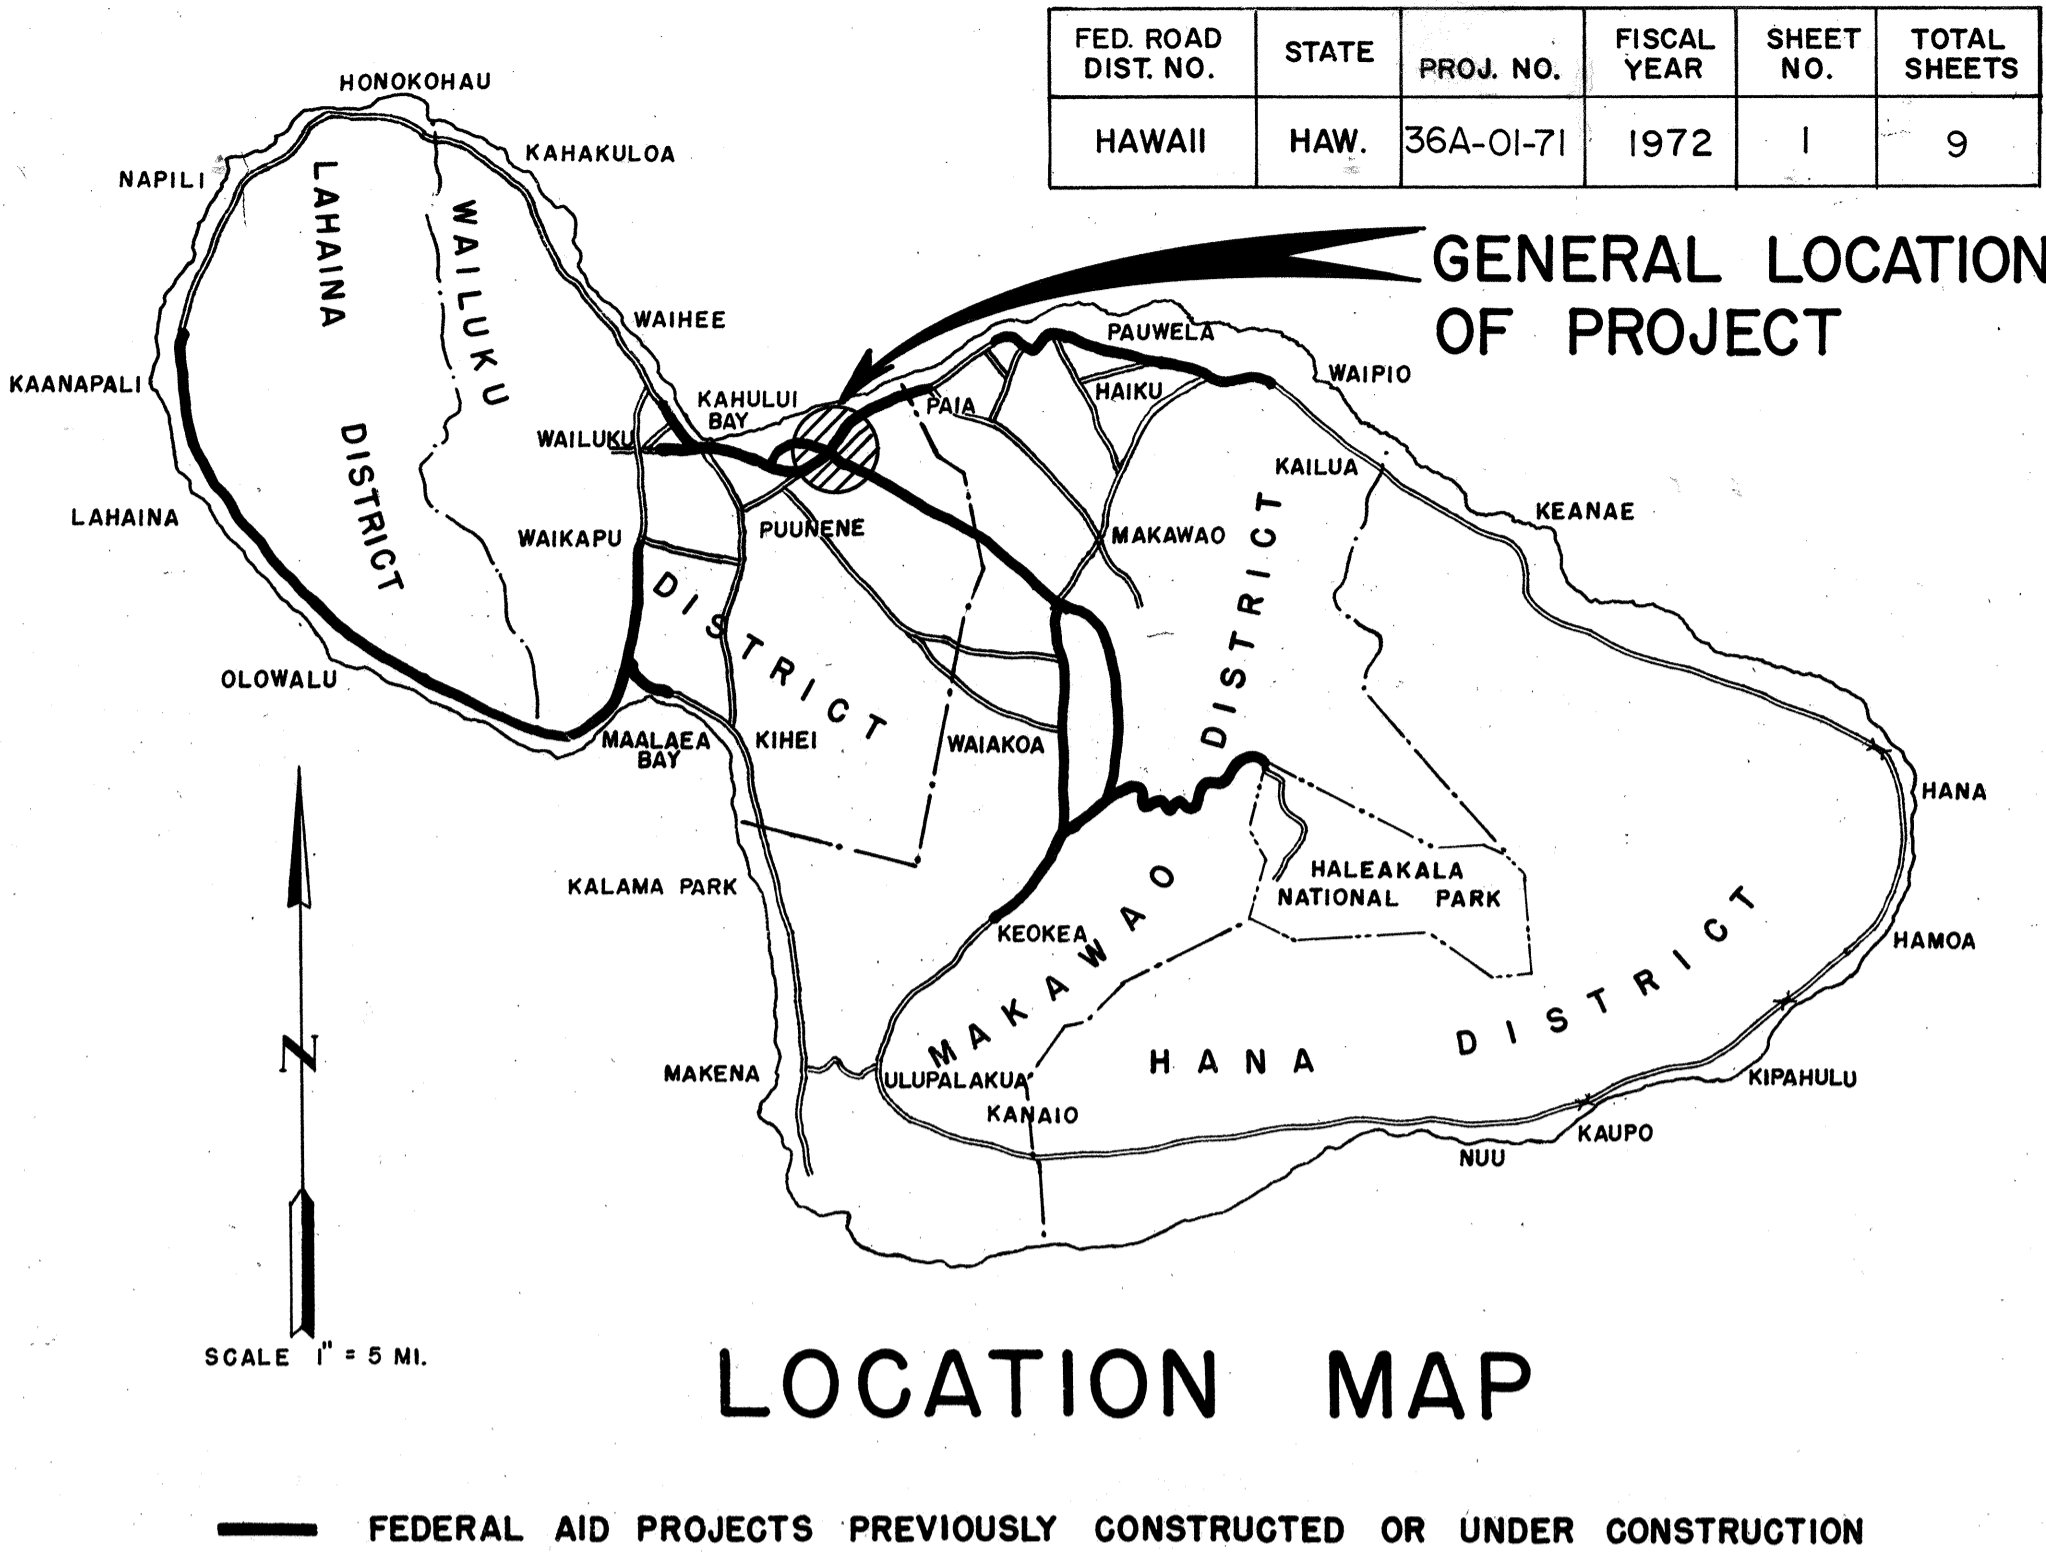

- EXISTING EDGE OF PAVEMENT
- =====

EXISTING CONCRETE CURB
- PP 23

EXISTING POWER POLE (#23) WITH STREET LIGHT
- HT

EXISTING UNDERGROUND TELEPHONE LINE
- D 24"

EXISTING DRAIN LINE ( 24")
- |||||

EXISTING TRAFFIC MARKINGS
- =====

NEW TRAFFIC MARKINGS
- d

EXISTING TRAFFIC SIGN AND POST
- d

NEW TRAFFIC SIGN AND POST
- =====

NEW BITUMINOUS (A/C) CURB, TYPE 6
- LOOP

NEW VEHICLE DETECTOR ( LOOP INDICATED )
- C 1-2"

NEW TRAFFIC SIGNAL PULL-BOX (TYPE "C") WITH NEW CONDUIT (1-2" CONDUIT).
- ⊠

CONTROLLER, TYPE "G" CABINET, ACCESSORIES AND AUXILIARY EQUIPMENT ON 4' TYPE I STANDARD.
- Y

Y

R

G

NEW TYPE II TRAFFIC SIGNAL STANDARD WITH MAST ARM (ARM SPREAD INDICATED) WITH STANDARD VEHICULAR SIGNAL HEADS R-Y-G
- PPB

R

Y

G

NEW TYPE I TRAFFIC SIGNAL STANDARD (10' HEIGHT) WITH STANDARD VEHICULAR SIGNAL HEAD R-Y-G, PEDESTRIAN SIGNAL HEAD DW-W AND PEDESTRIAN PUSH-BUTTON WITH INSTRUCTION SIGN (PPB), ARROW AS INDICATED.

PPB

PEDESTRIAN PUSH-BUTTON WITH SIGN ON 2 1/2" GALV. PIPE STANDARD.
- NORTH

KAHULUI BAY

KAHULUI AIRPORT

HALEAKALA HIGHWAY

HANA HIGHWAY

LOCATION OF PROJECT

GRAPHIC SCALE

0 0.5 1 MILE

GENERAL LAYOUT PLAN
- NO AS-BUILT CHANGES

MADE DURING CONSTRUCTION.
- Manuel J. Silva

PROJECT ENGINEER

1 Dec 81

DATE
- 
- THIS WORK WAS PREPARED BY

ME OR UNDER MY SUPERVISION
- William C. Hong
- DEPARTMENT OF TRANSPORTATION

STATE OF HAWAII

APPROVED:

Murray Lee

12/26/72

FOR DIR. OF TRANSPORTATION

DATE