

INDEX TO DRAWINGS	
SHEET NO	DESCRIPTION
1	TITLE SHEET
2	DETAIL PLAN

STATE OF HAWAII

DEPARTMENT OF TRANSPORTATION

HIGHWAYS DIVISION

HONOLULU, HAWAII

" AS BUILT " PLANS FOR



INSTALLATION OF TRAFFIC SIGNALS

ON HANA HIGHWAY AT DAIRY ROAD

PROJECT NO. 36A-01-74

DISTRICT OF WAILUKU

ISLAND OF MAUI

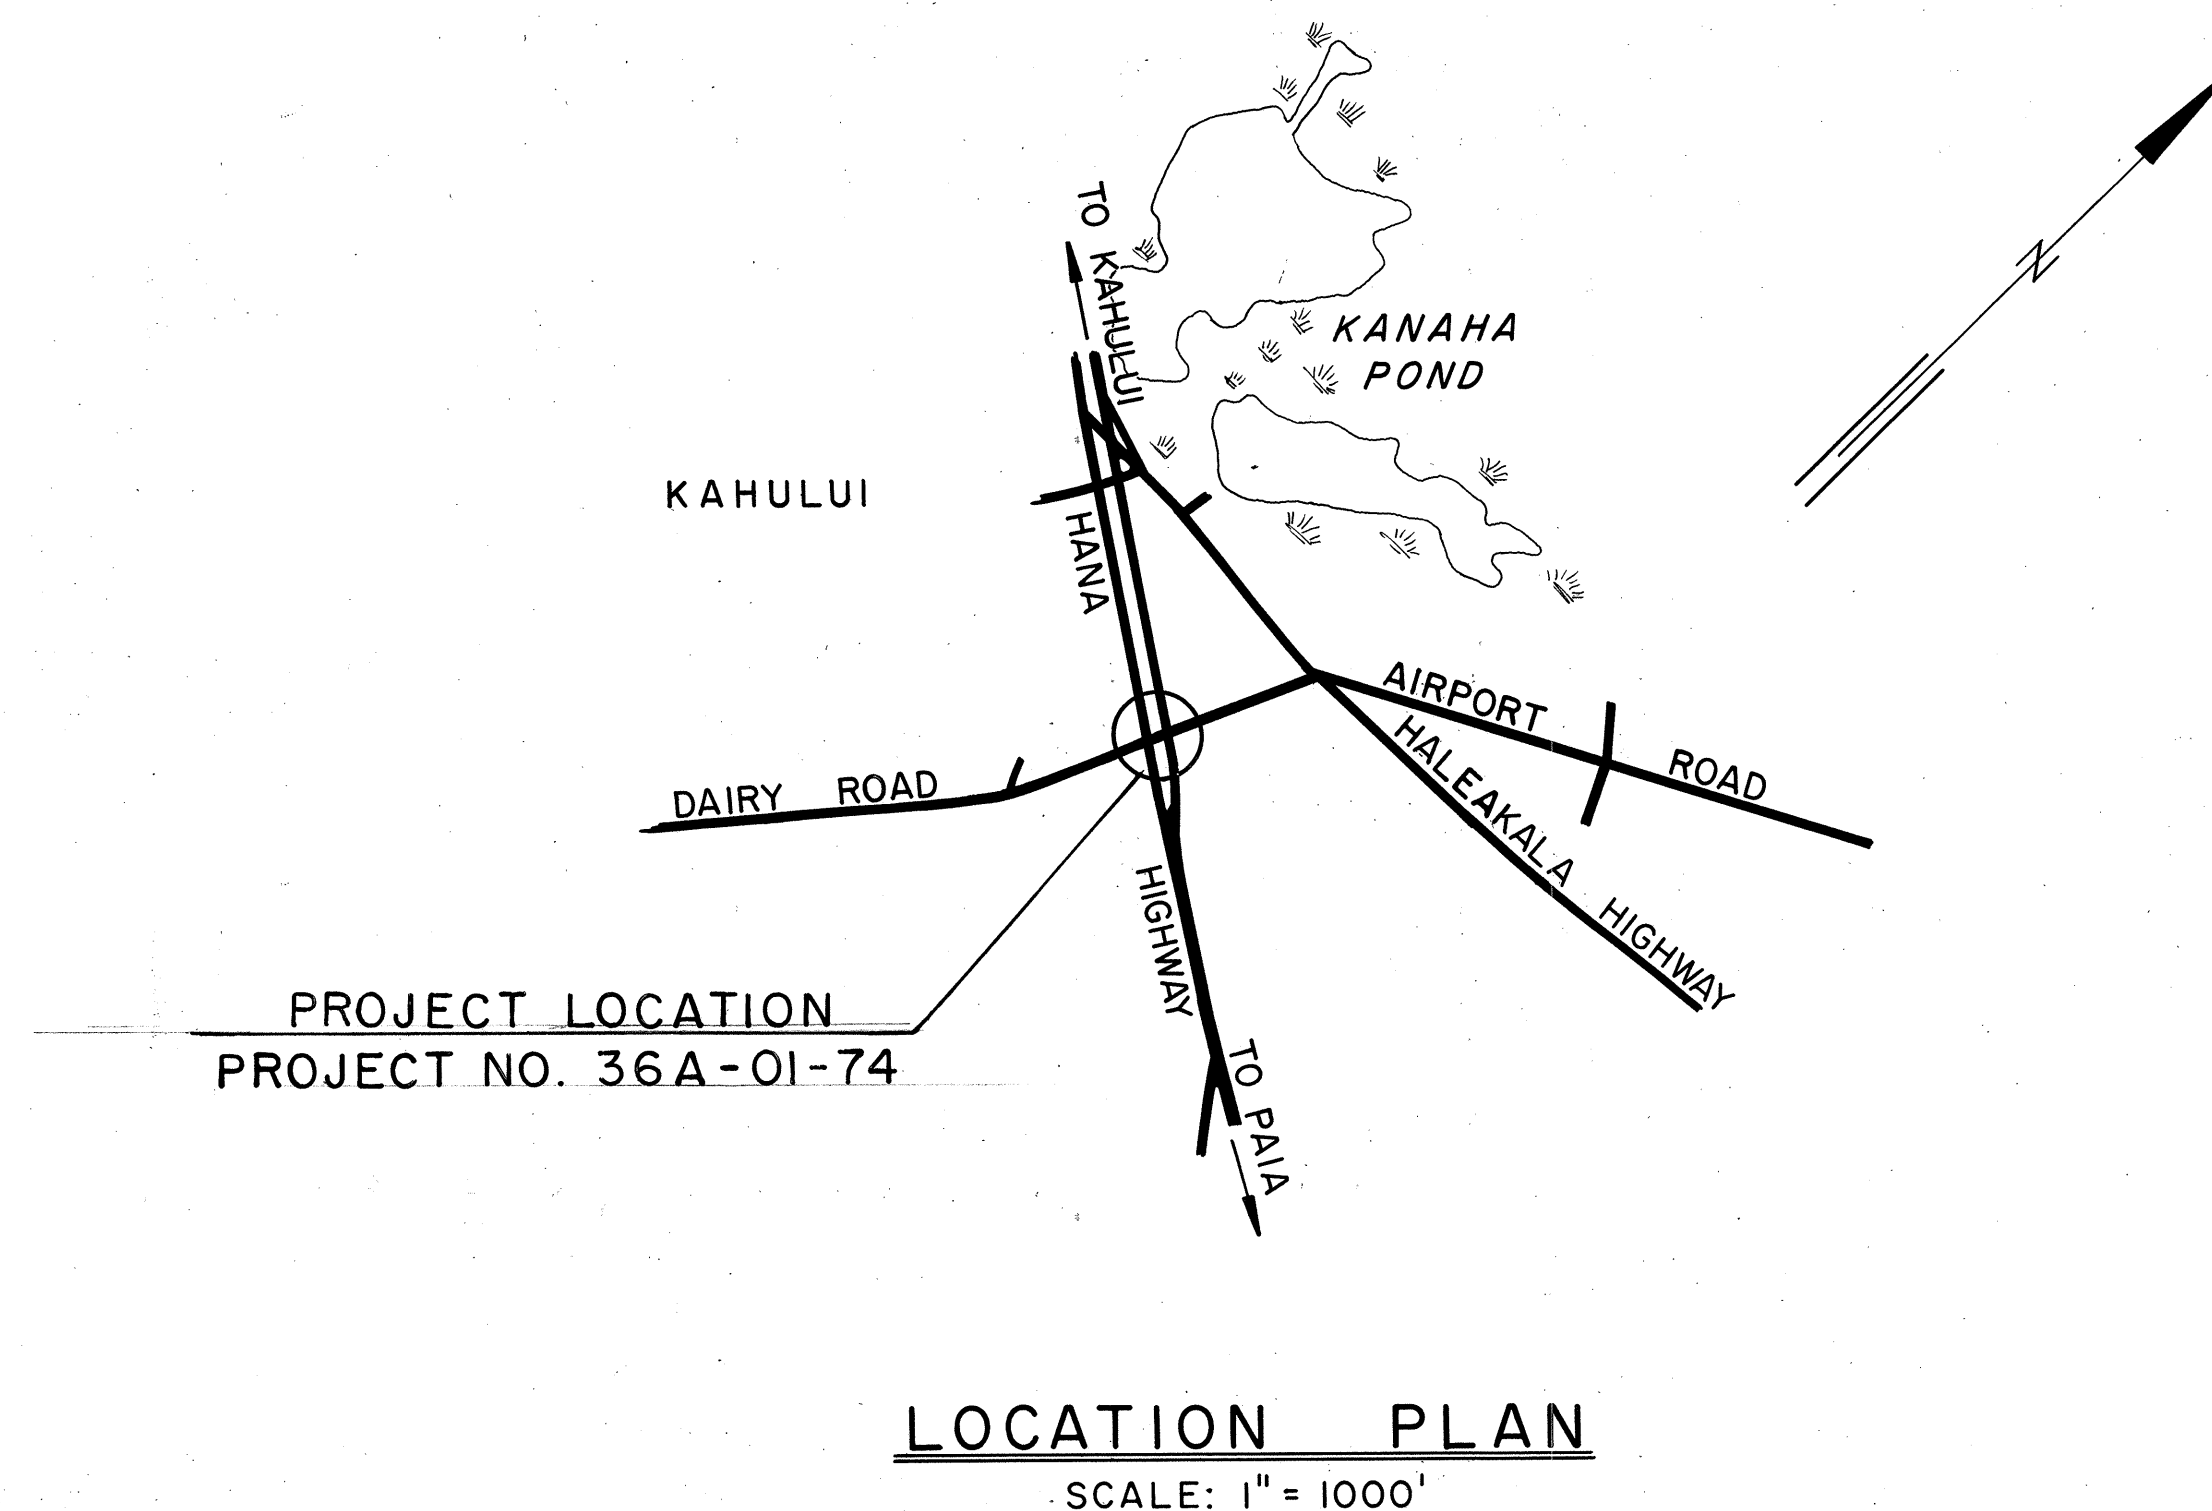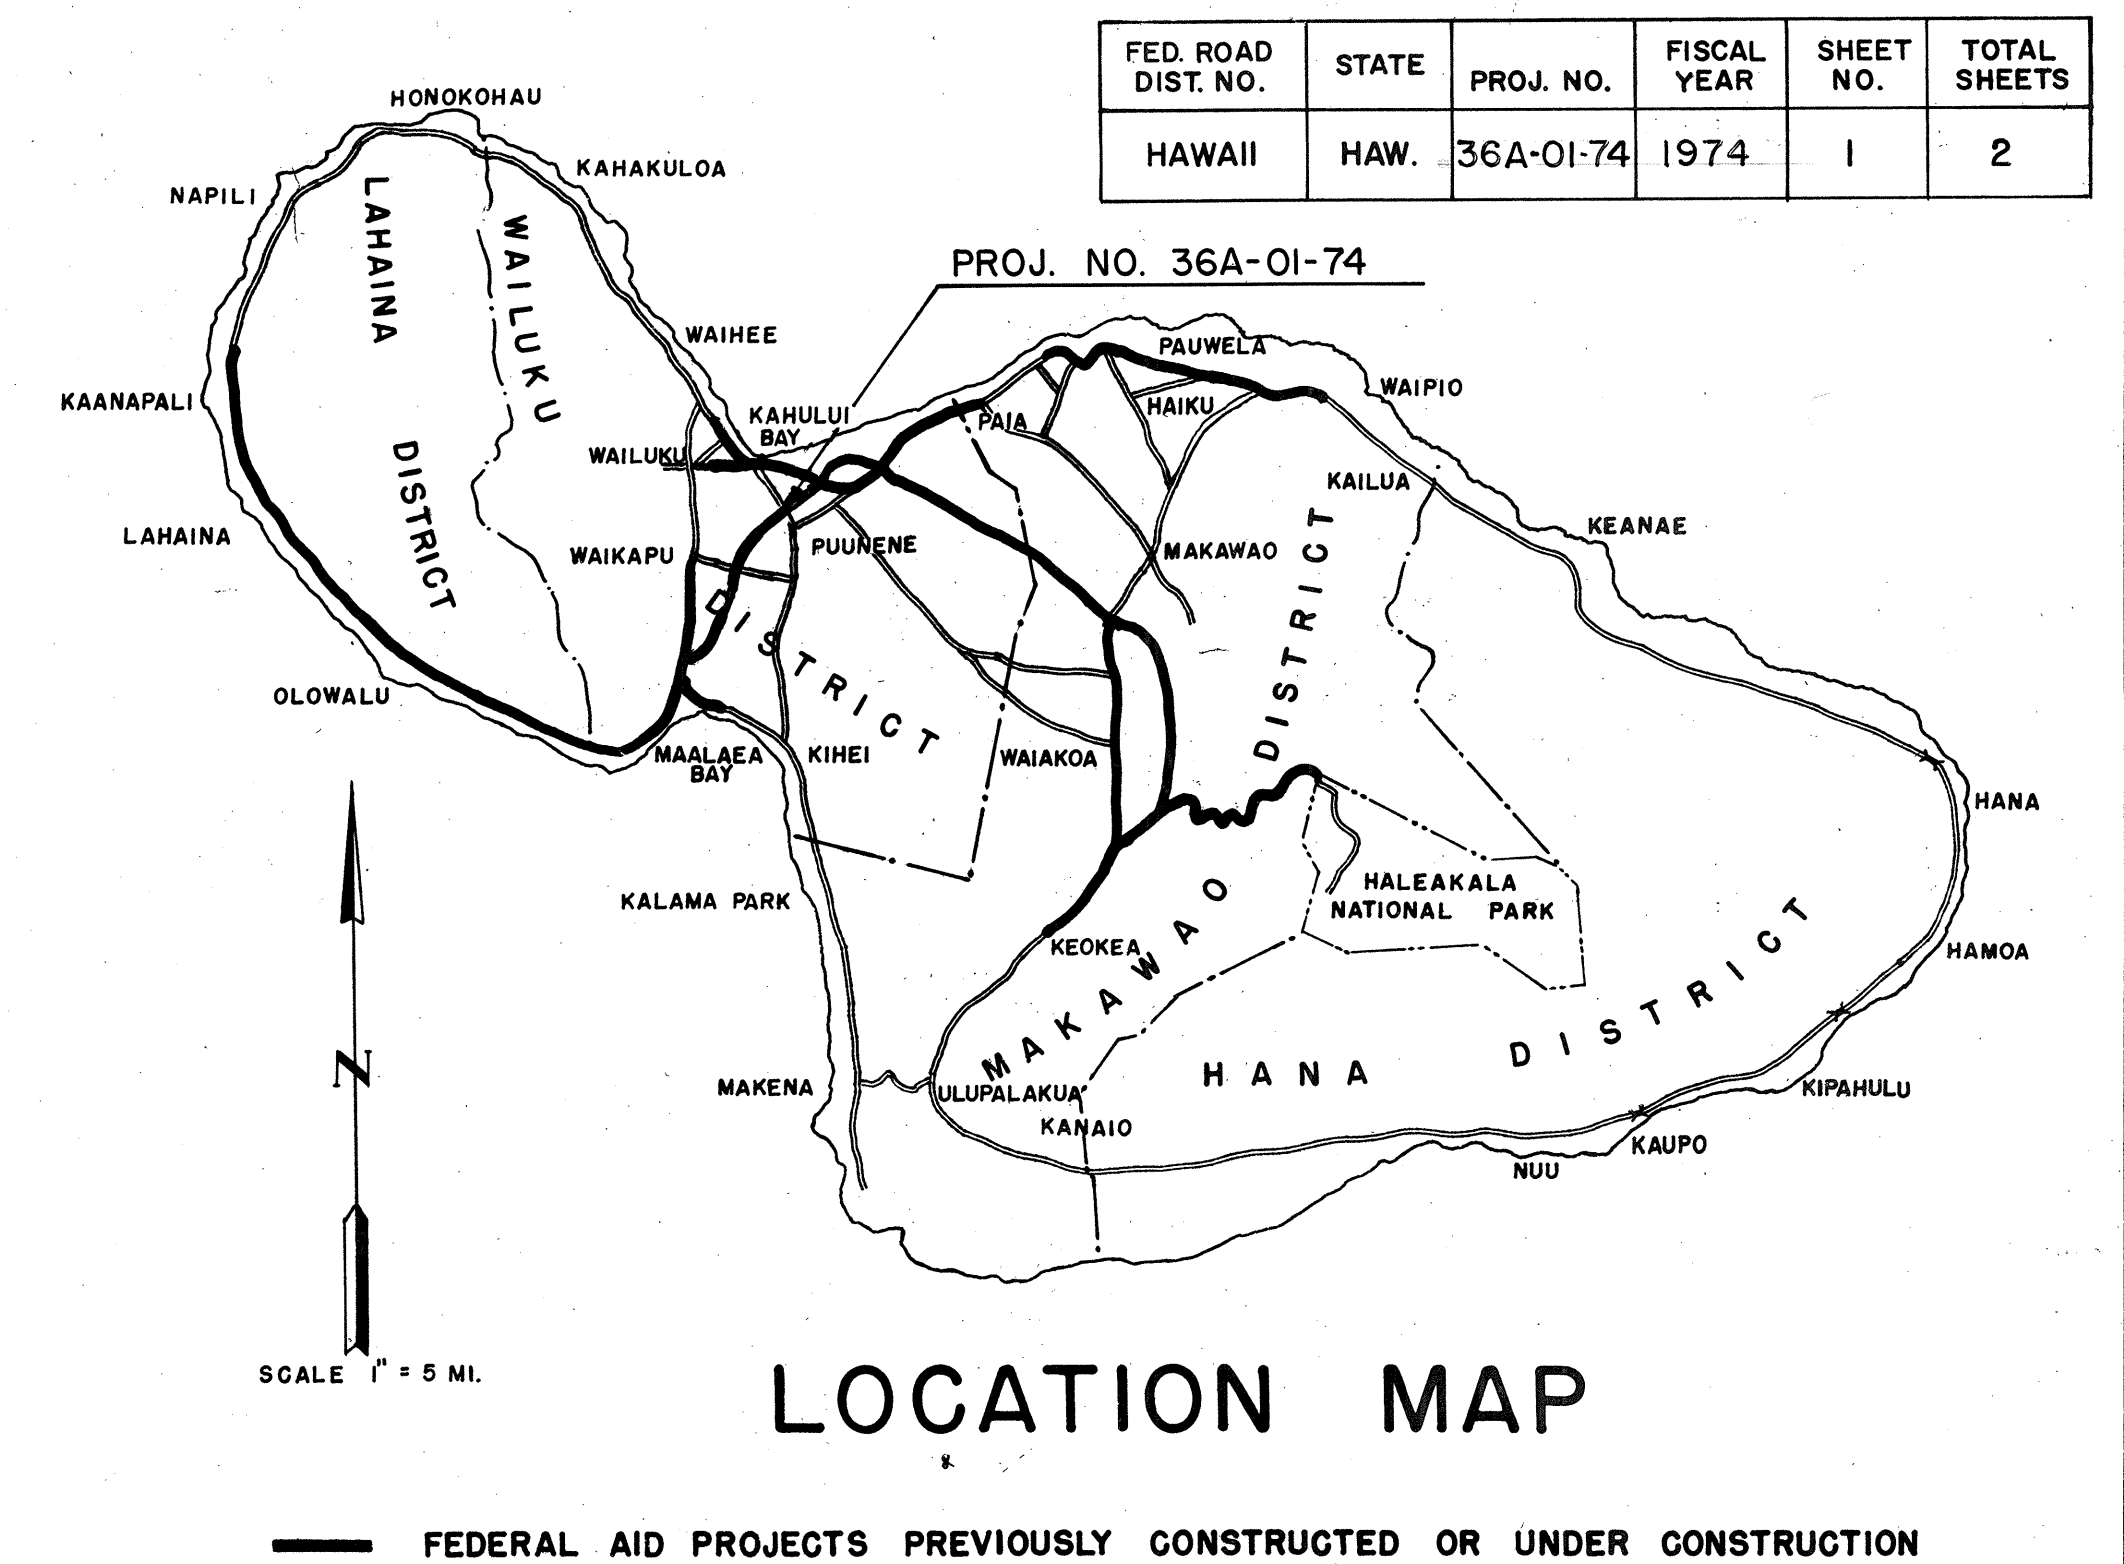

NOTE:

ALL CHANGES MADE DURING CONSTRUCTION

HAVE BEEN NOTED IN RED ON THESE TRACINGS

AND CHECKED BY:

Manuel J. Silva

PROJECT ENGINEER

DATE

DEPARTMENT OF TRANSPORTATION STATE OF HAWAII	
APPROVED:	
<i>Murray Lee</i>	10/9/73
FOR DIR. OF TRANSPORTATION	DATE

DESIGNED BY: TRAFFIC SECTION

PS & E: R. Mikami

548-7534

Phone

Design Unit

0-7-10