


INDEX TO DRAWINGS	
SHEET NO	DESCRIPTION
1	TITLE SHEET
2	TYPICAL SECTIONS
3-5	PLAN
6-9	STANDARD DETAILS

STATE OF HAWAII
DEPARTMENT OF TRANSPORTATION
HIGHWAYS DIVISION
HONOLULU, HAWAII

"AS BUILT" PLANS FOR
HANA HIGHWAY RESURFACING
(SPRECKELSVILLE TO HOOKIPA PARK)
PROJECT NO. 36AB-01-75
DISTRICT OF WAILUKU & MAKAWAO
ISLAND OF MAUI

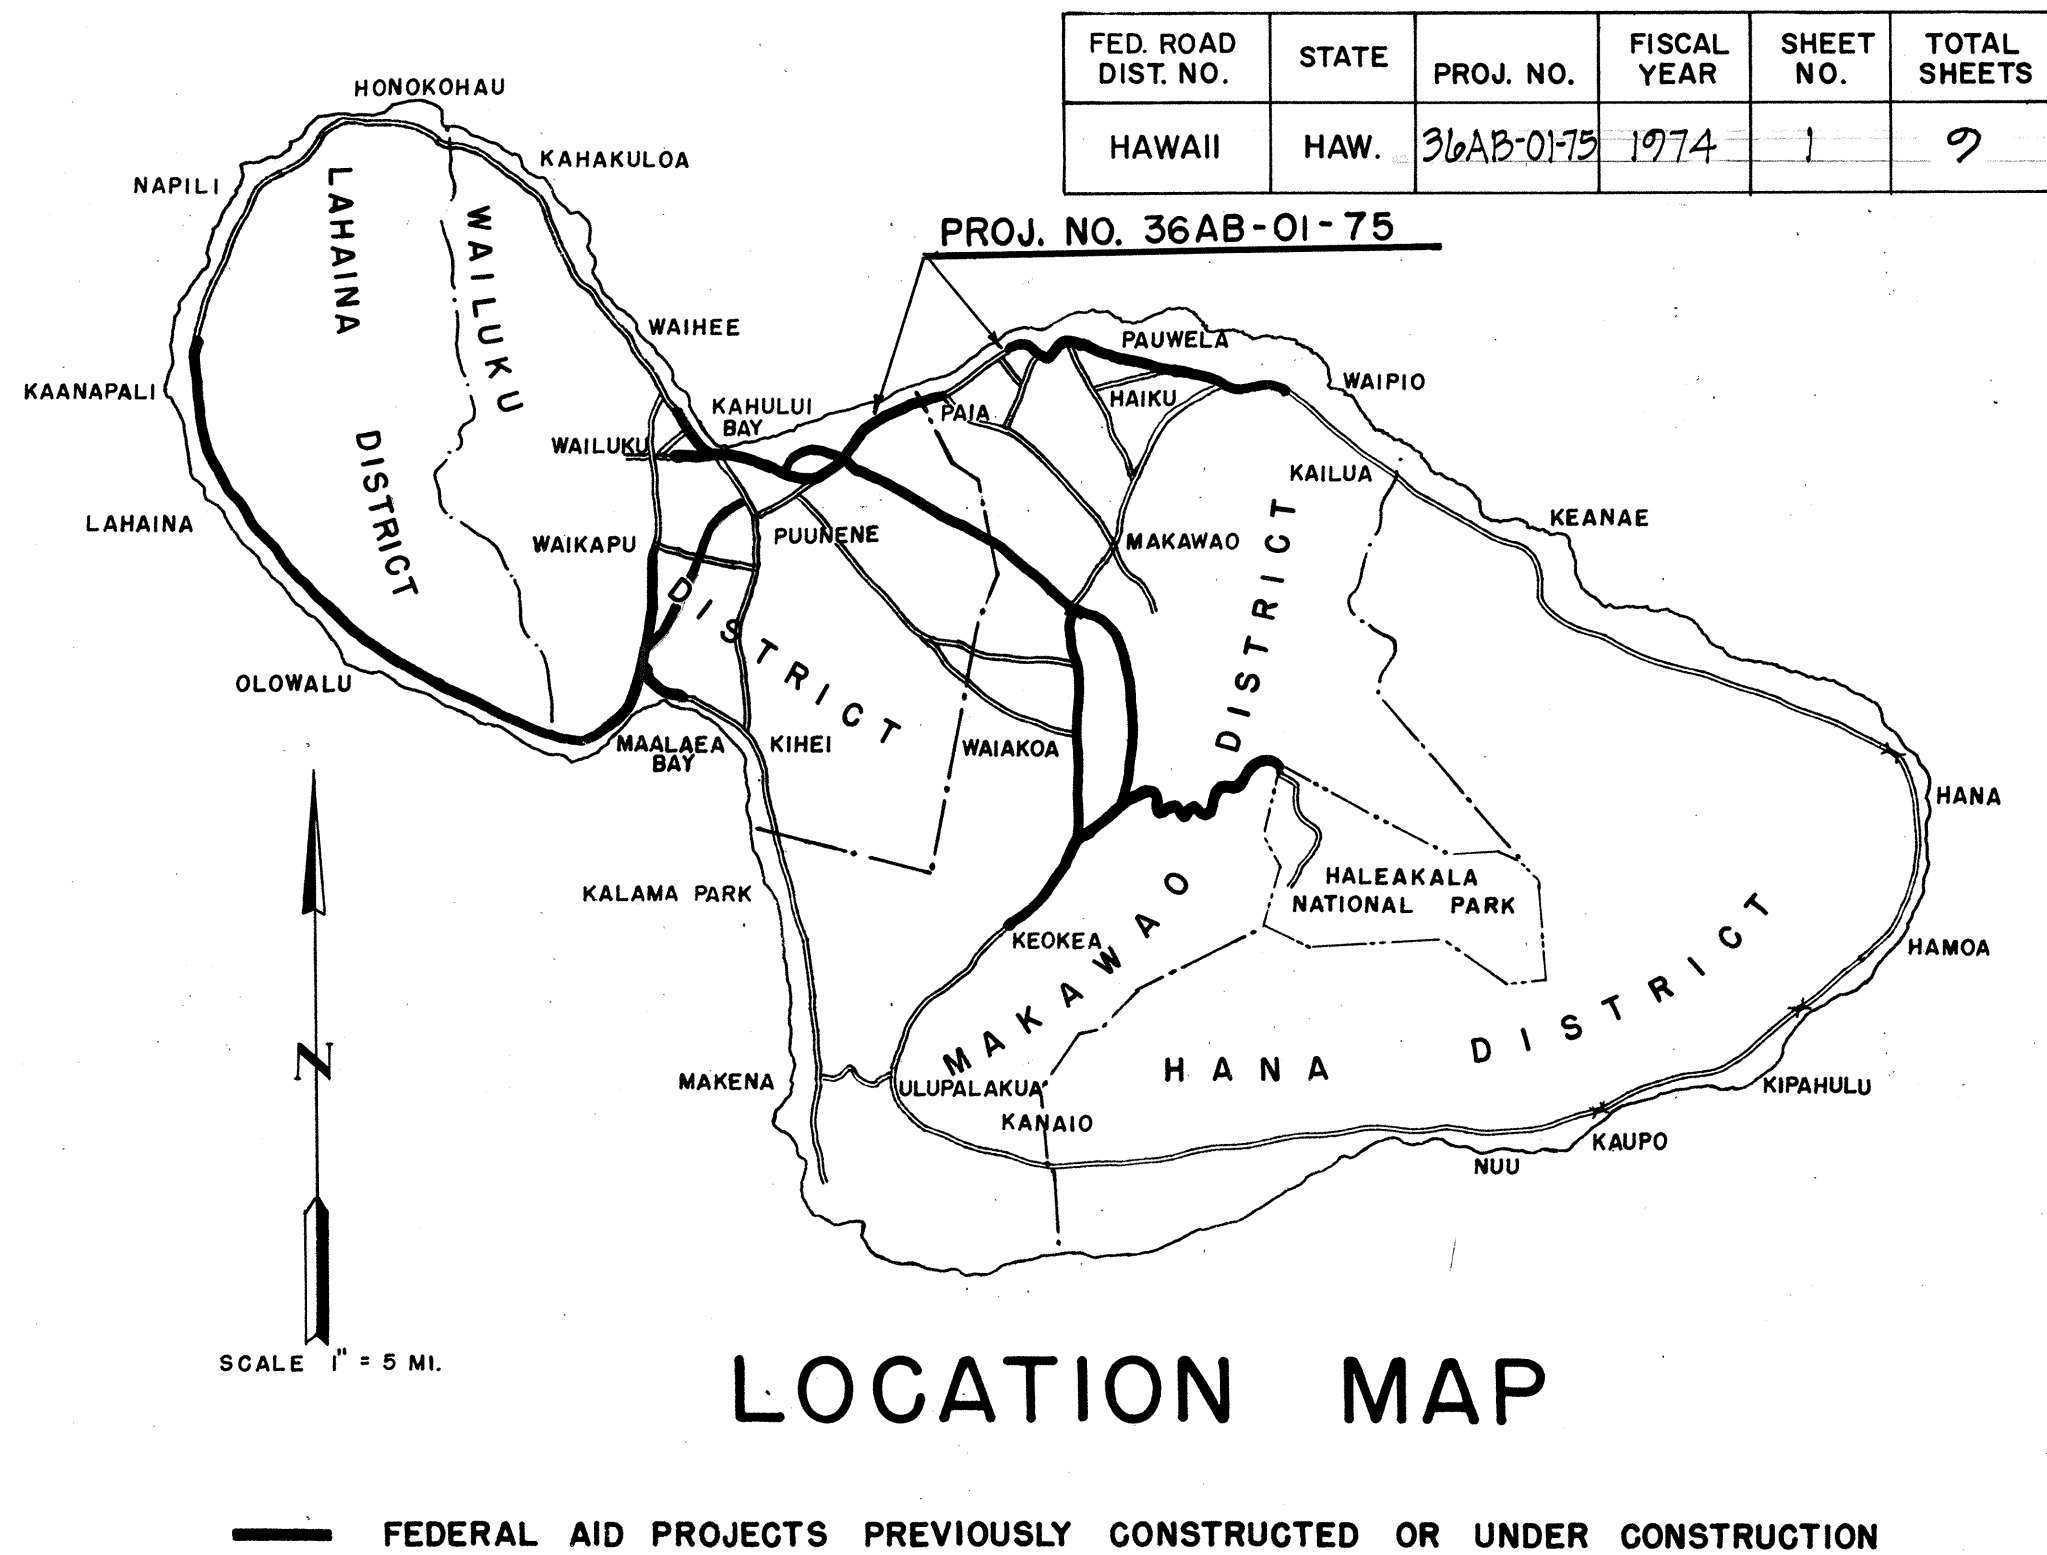


NOTE:

ALL CHANGES MADE DURING CONSTRUCTION HAVE BEEN INCORPORATED ON THESE PLANS INCLUDING CHANGES IN THE ORIGINAL THEORETICAL QUANTITIES.

George N. Kaya
RESIDENT ENGINEER

Jan. 19, 1976
DATE

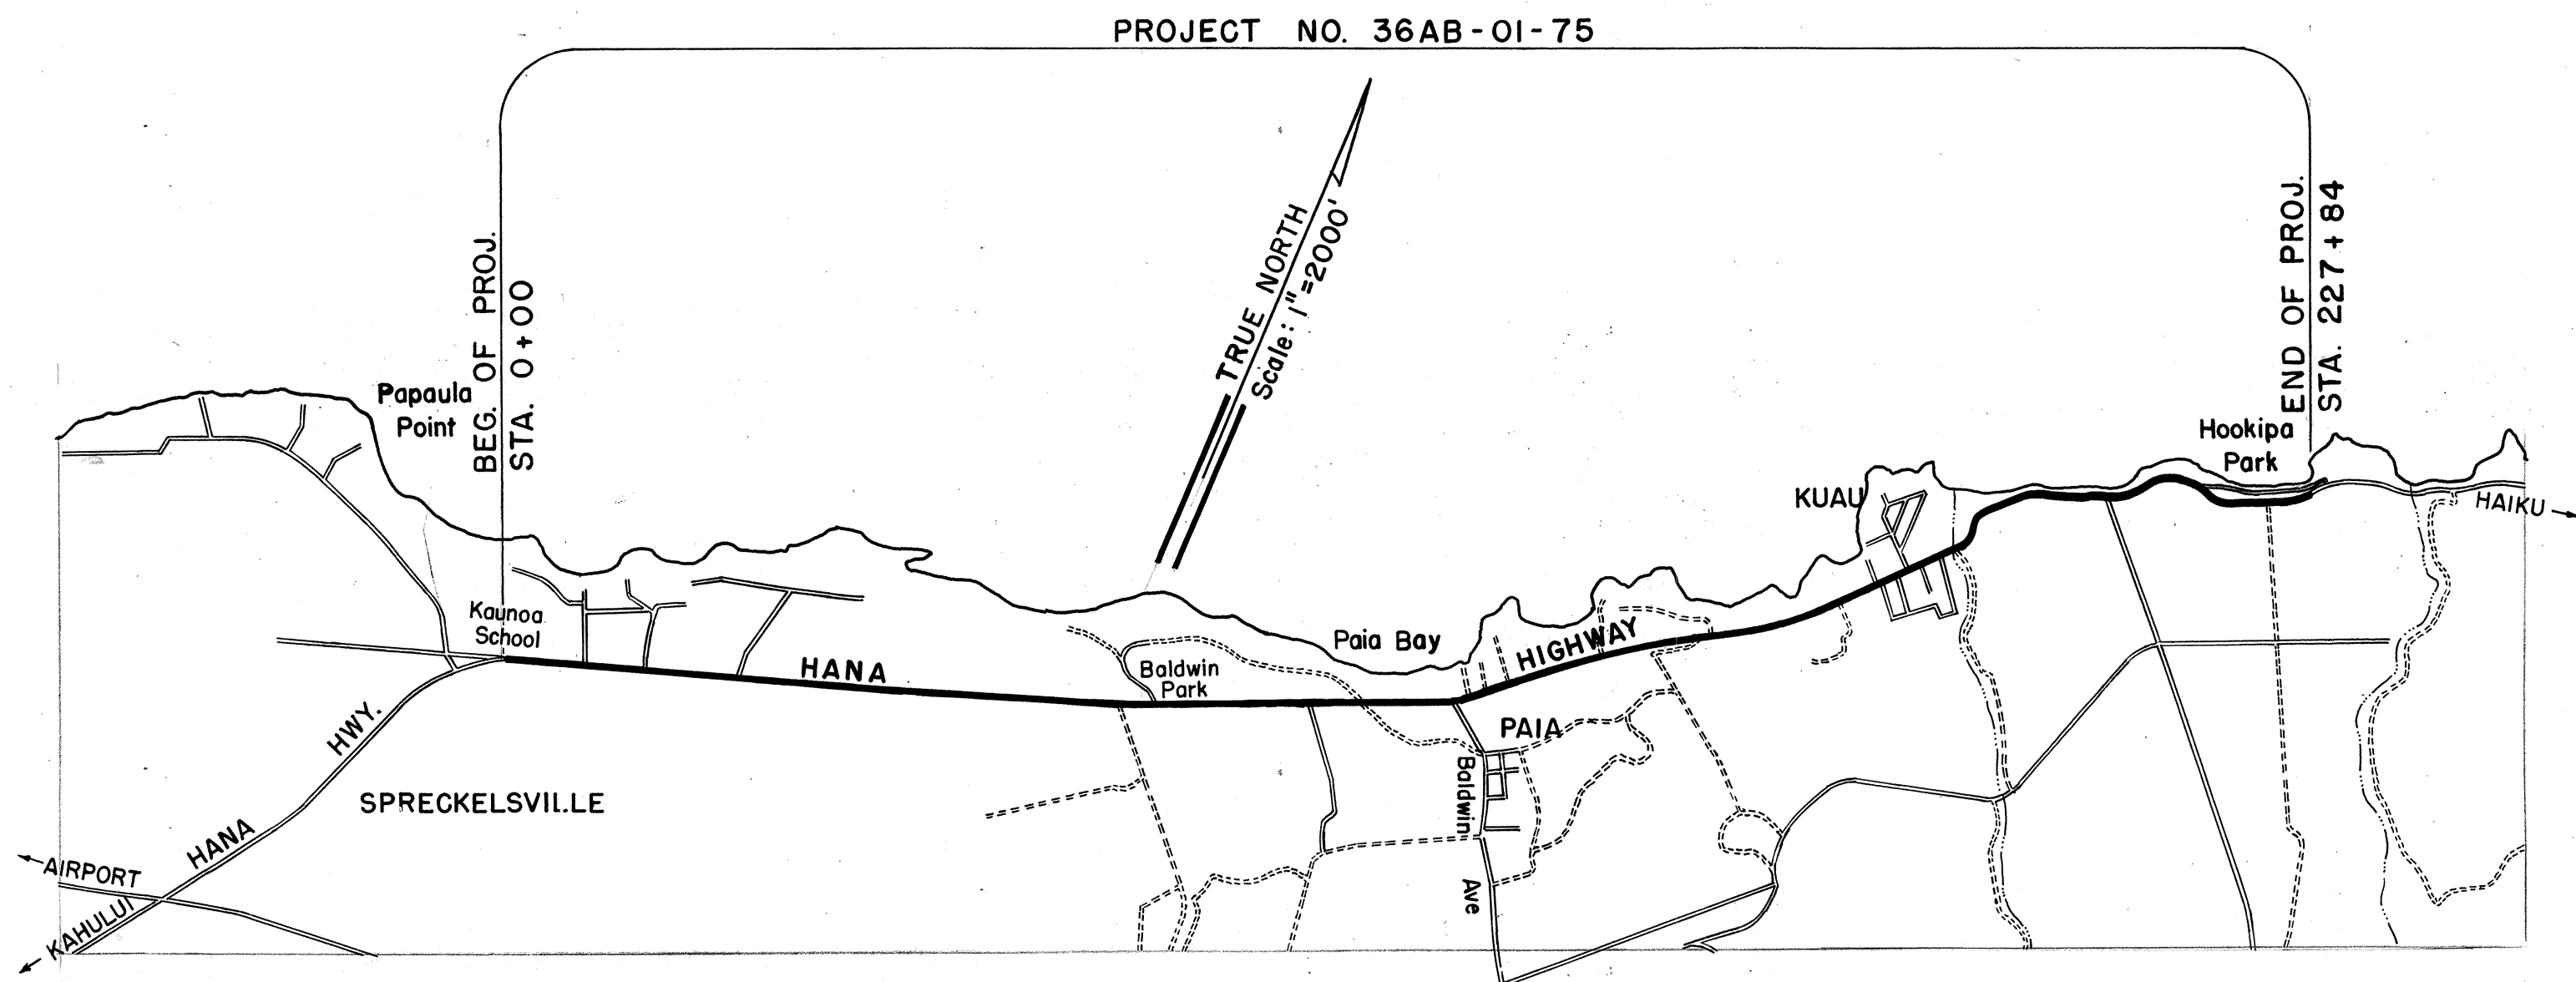

LAYOUT OF PROJECT
Scale: 1" = 2000'

LENGTH OF PROJECT 4.315 MI.

APPROVED: _____ DATE 11/19/74

FOR DIRECTOR OF TRANSPORTATION

P.S. & E.: D. BEVIER
DESIGNED BY: MAUI DISTRICT OFFICE
STATE HIGHWAYS DIVISION
DATE: SEPT. 1974