


FED. ROAD DIST. NO.	STATE	PROJ. NO.	FISCAL YEAR	SHEET NO.	TOTAL SHEETS
HAWAII	HAW.	HWY-M-02-76M	1976	3	5

True North
Scale: 1"=100'


MATCH LINE STA. 26+00

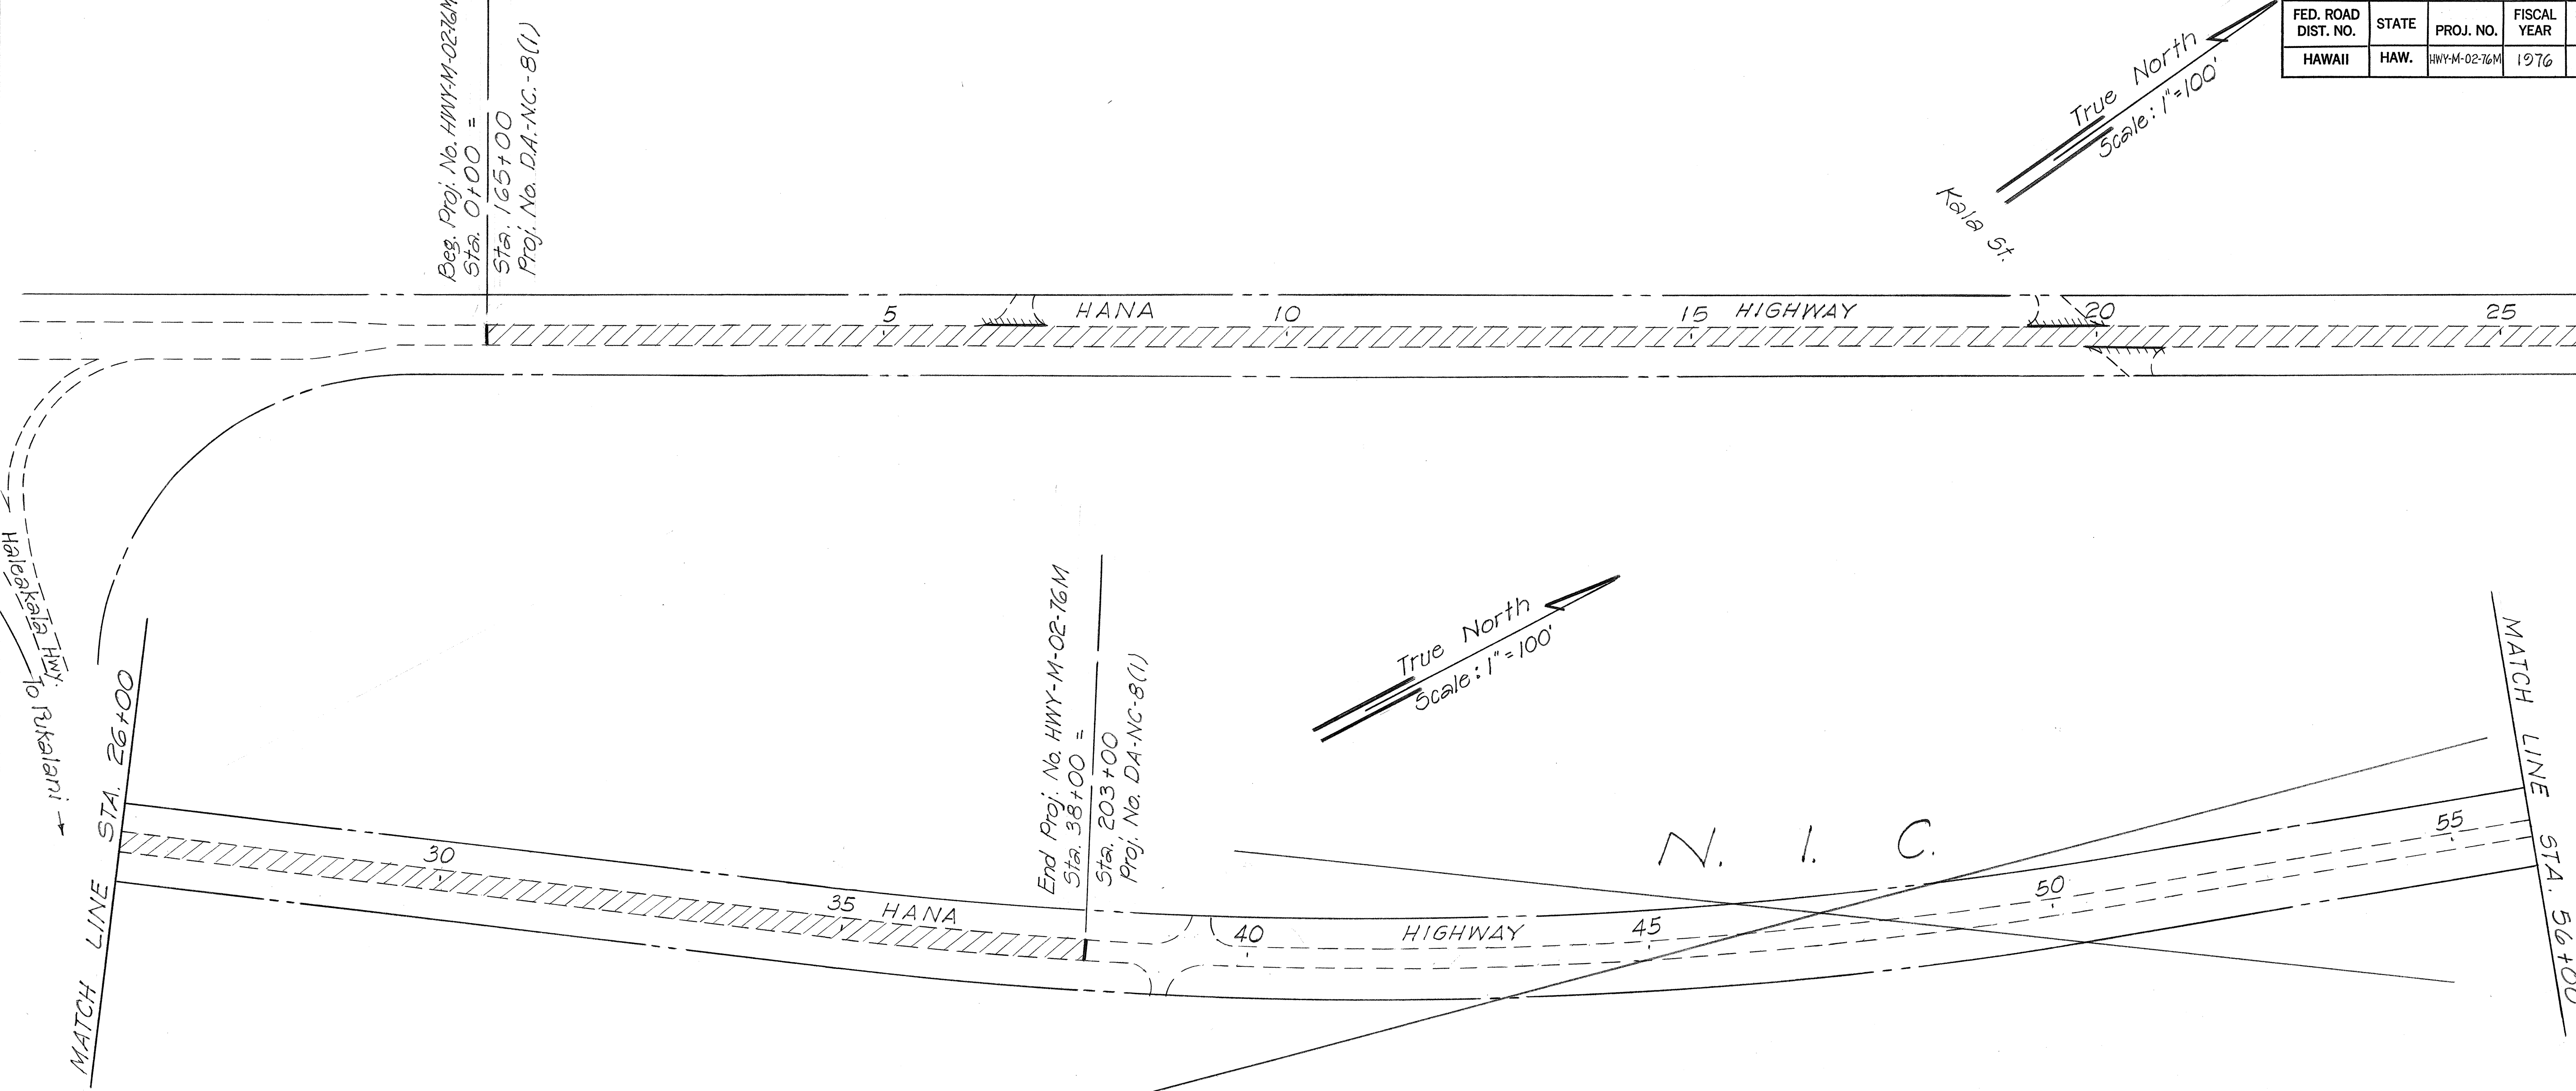

True North
Scale: 1"=100'

End Proj. No. HWY-M-02-76M
Sta. 38+00 =
Sta. 203+00
Proj. No. DA-NC-8(1)

MATCH LINE STA. 56+00

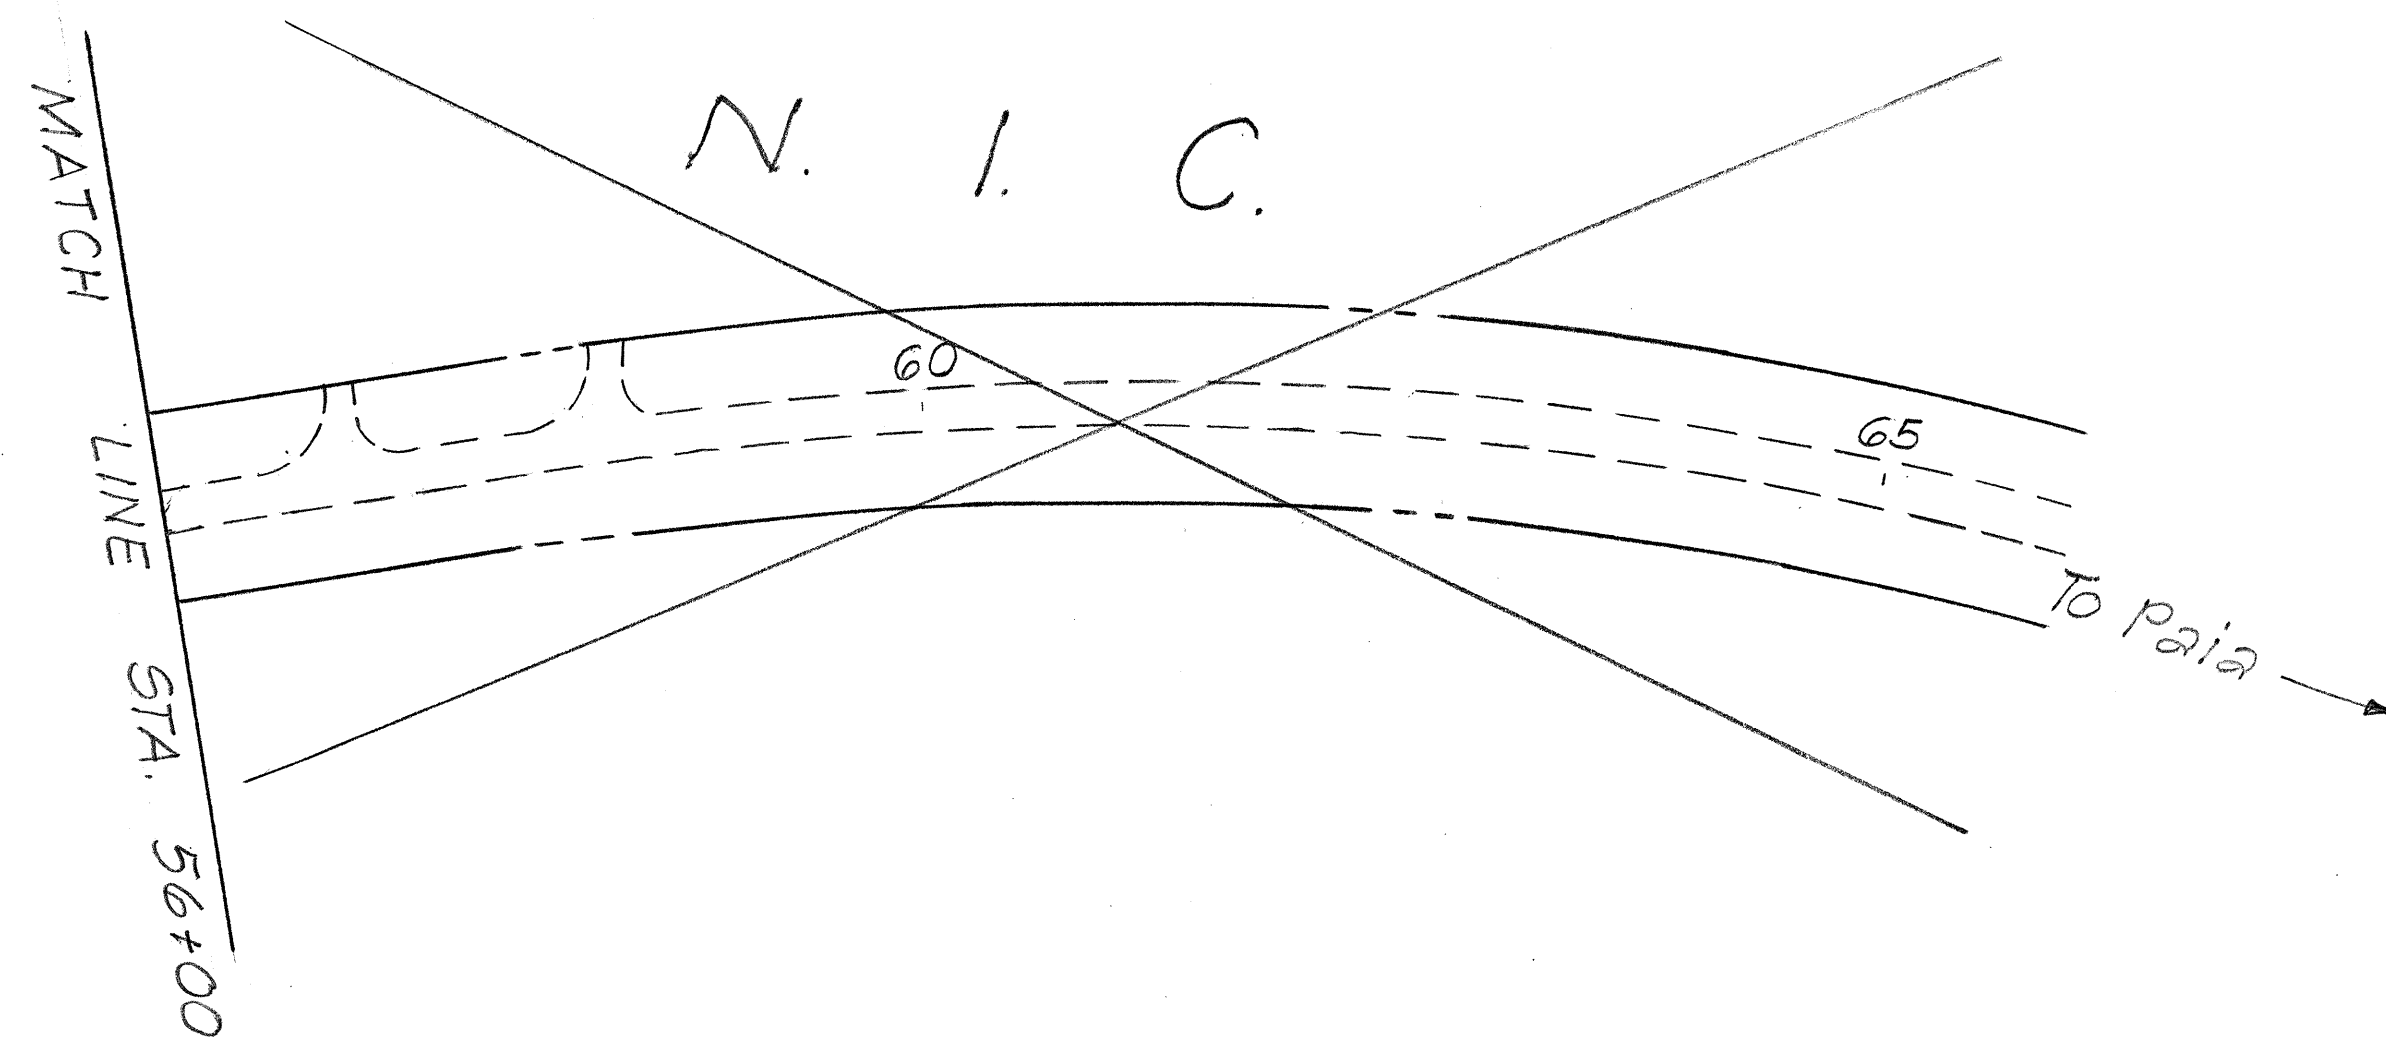

STATE OF HAWAII
DEPARTMENT OF TRANSPORTATION
HIGHWAYS DIVISION

PLAN
36A HANA HIGHWAY
HALEAKALA HIGHWAY
JUNCTION TO SPRECKELSVILLE
PROJ. NO. HWY-M-02-76M
SCALE: 1"=100'
MAR. 1976

SHEET NO. 1 OF 1 SHEETS

ORIGINAL PLAN	SURVEY PLOTTED BY	DATE
NOTE BOOK	DRAWN BY	"
No.	DESIGNED BY	"
	QUANTITIES BY	"
	CHECKED BY	"