


FED. ROAD DIST. NO.	STATE	FED-AID-PROJ. NO.	FISCAL YEAR	SHEET NO.	TOTAL SHEETS
HAWAII	HAW.	366-02-79	1979	5	17

NOTE:
Roadway resurfaced from Station 0+00 to 9+00, and left shoulder ends at Station 9+00 (see plan view).

DATE	
BY	
SURVEYED	
PLOTTED	
NOTE BOOK	
NO.	

DATE	
BY	
SURVEYED	
PLOTTED	
NOTE BOOK	
NO.	

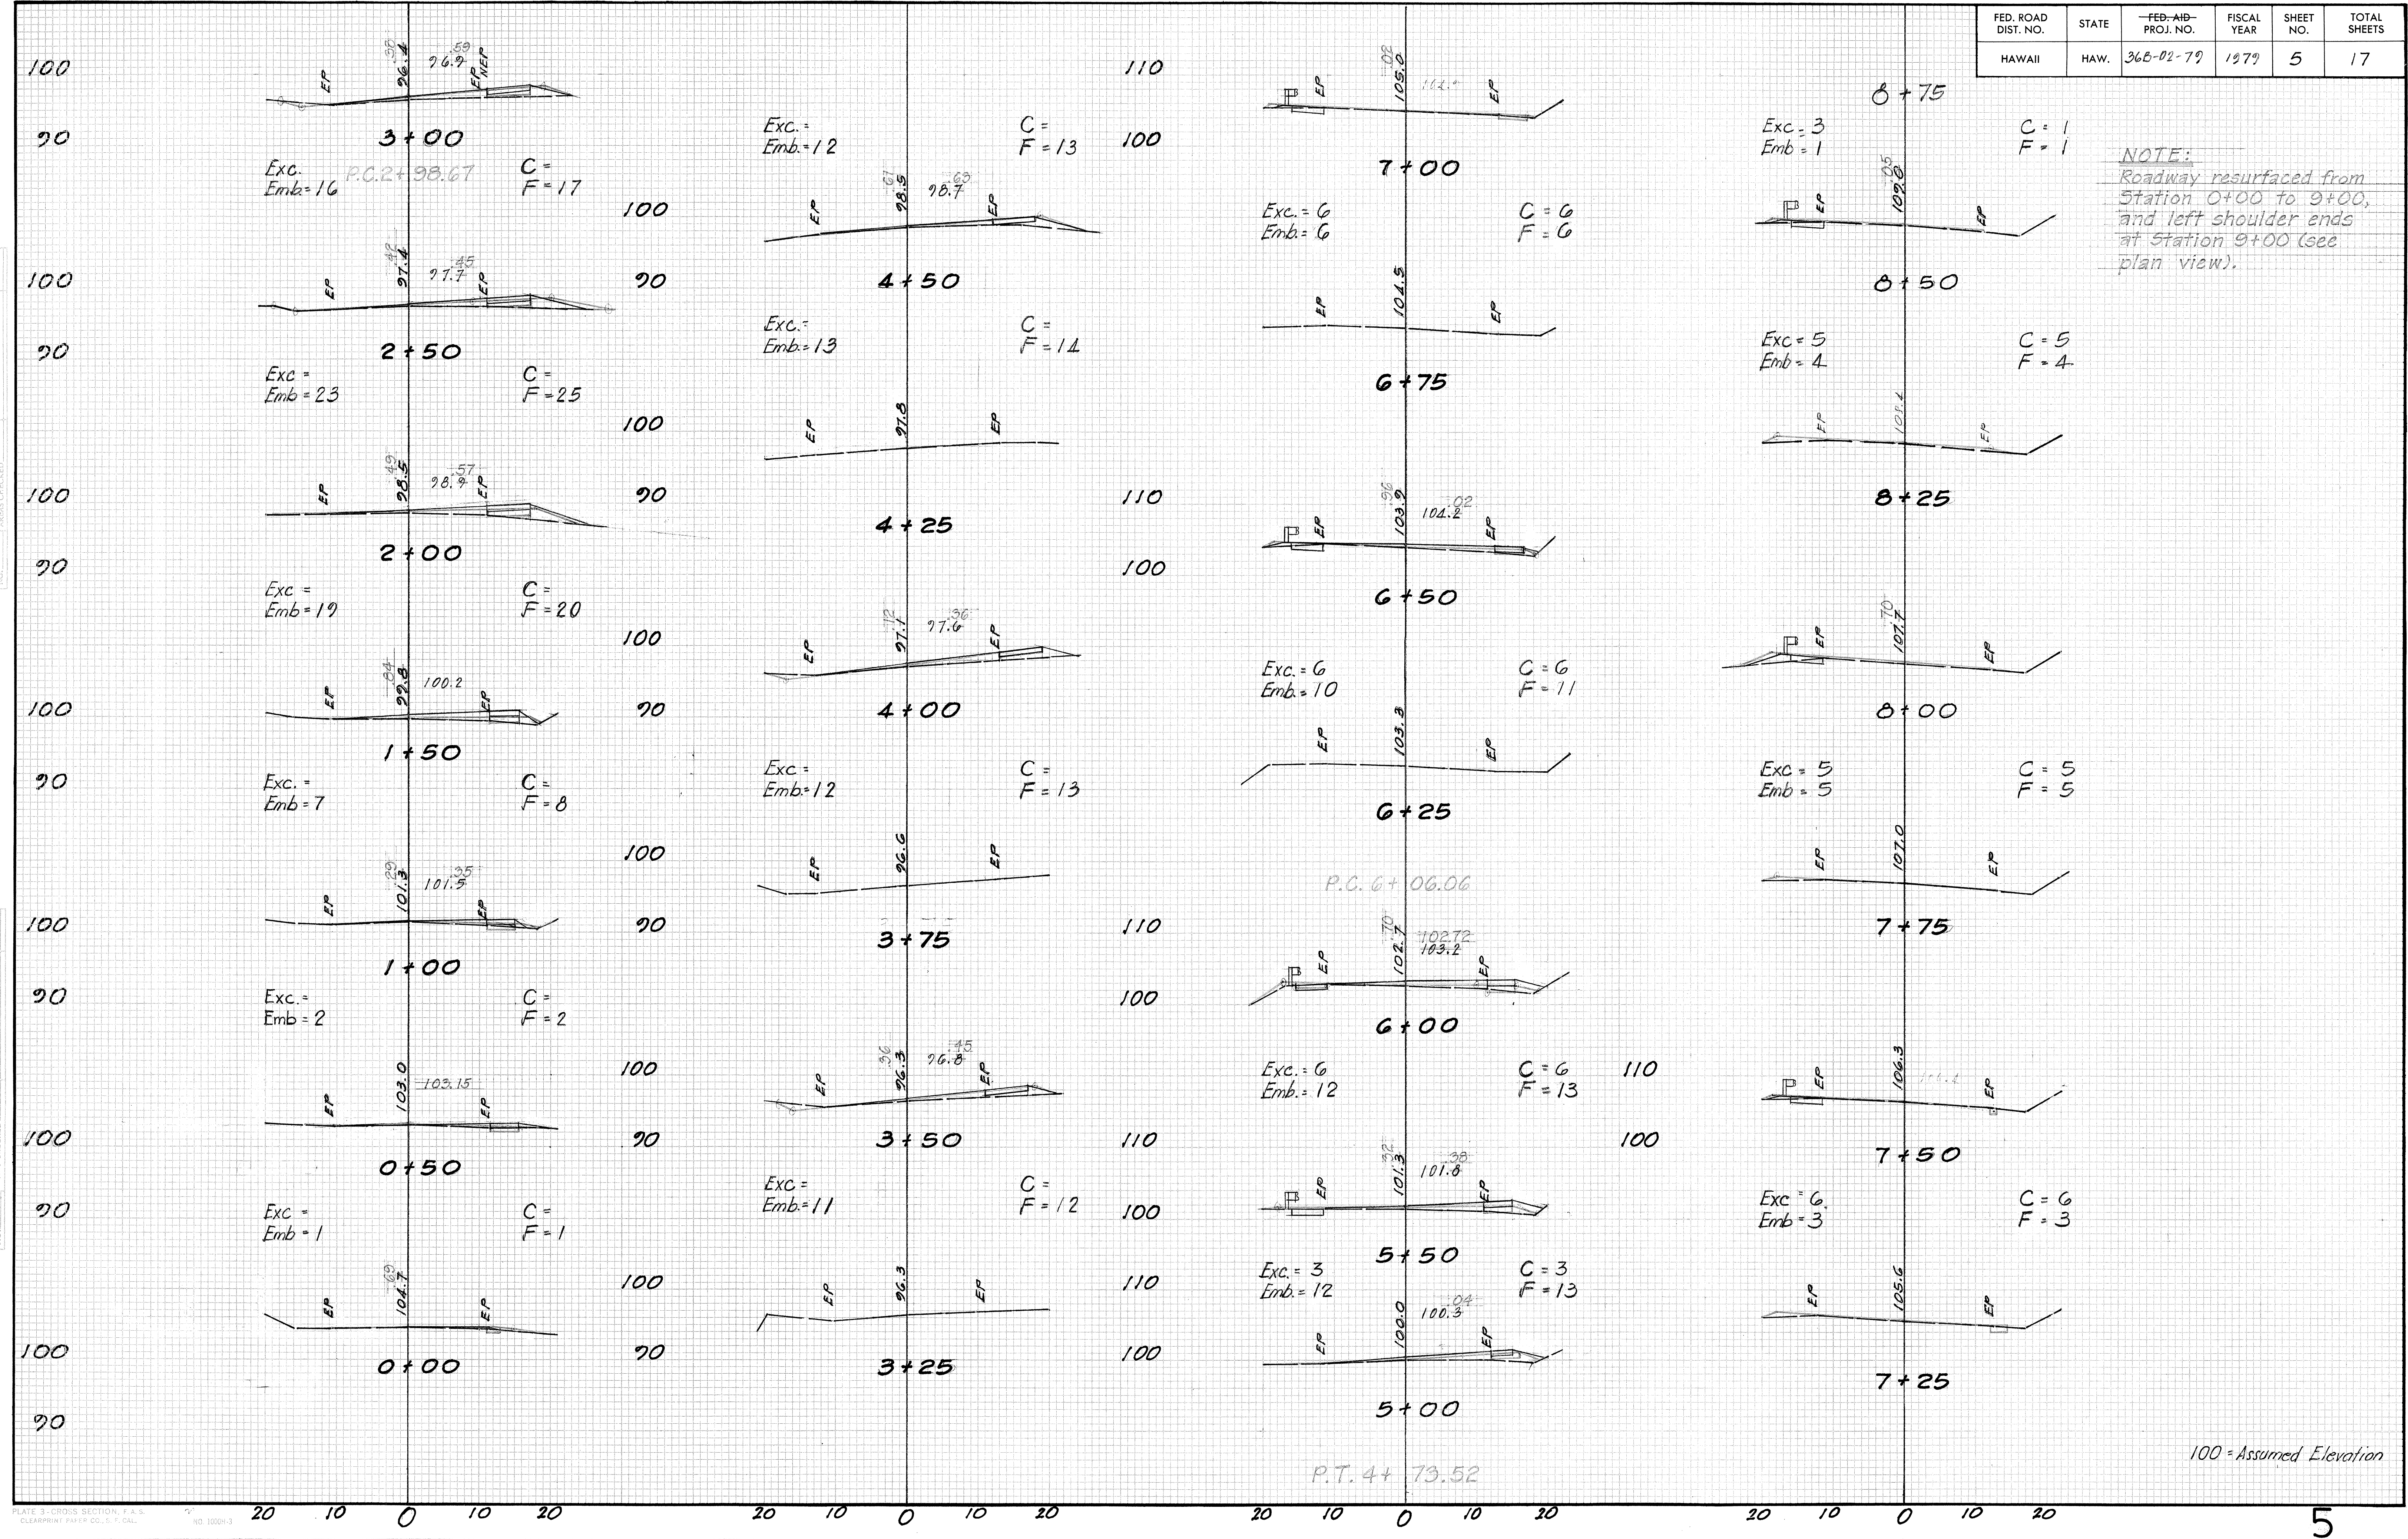

100 = Assumed Elevation