
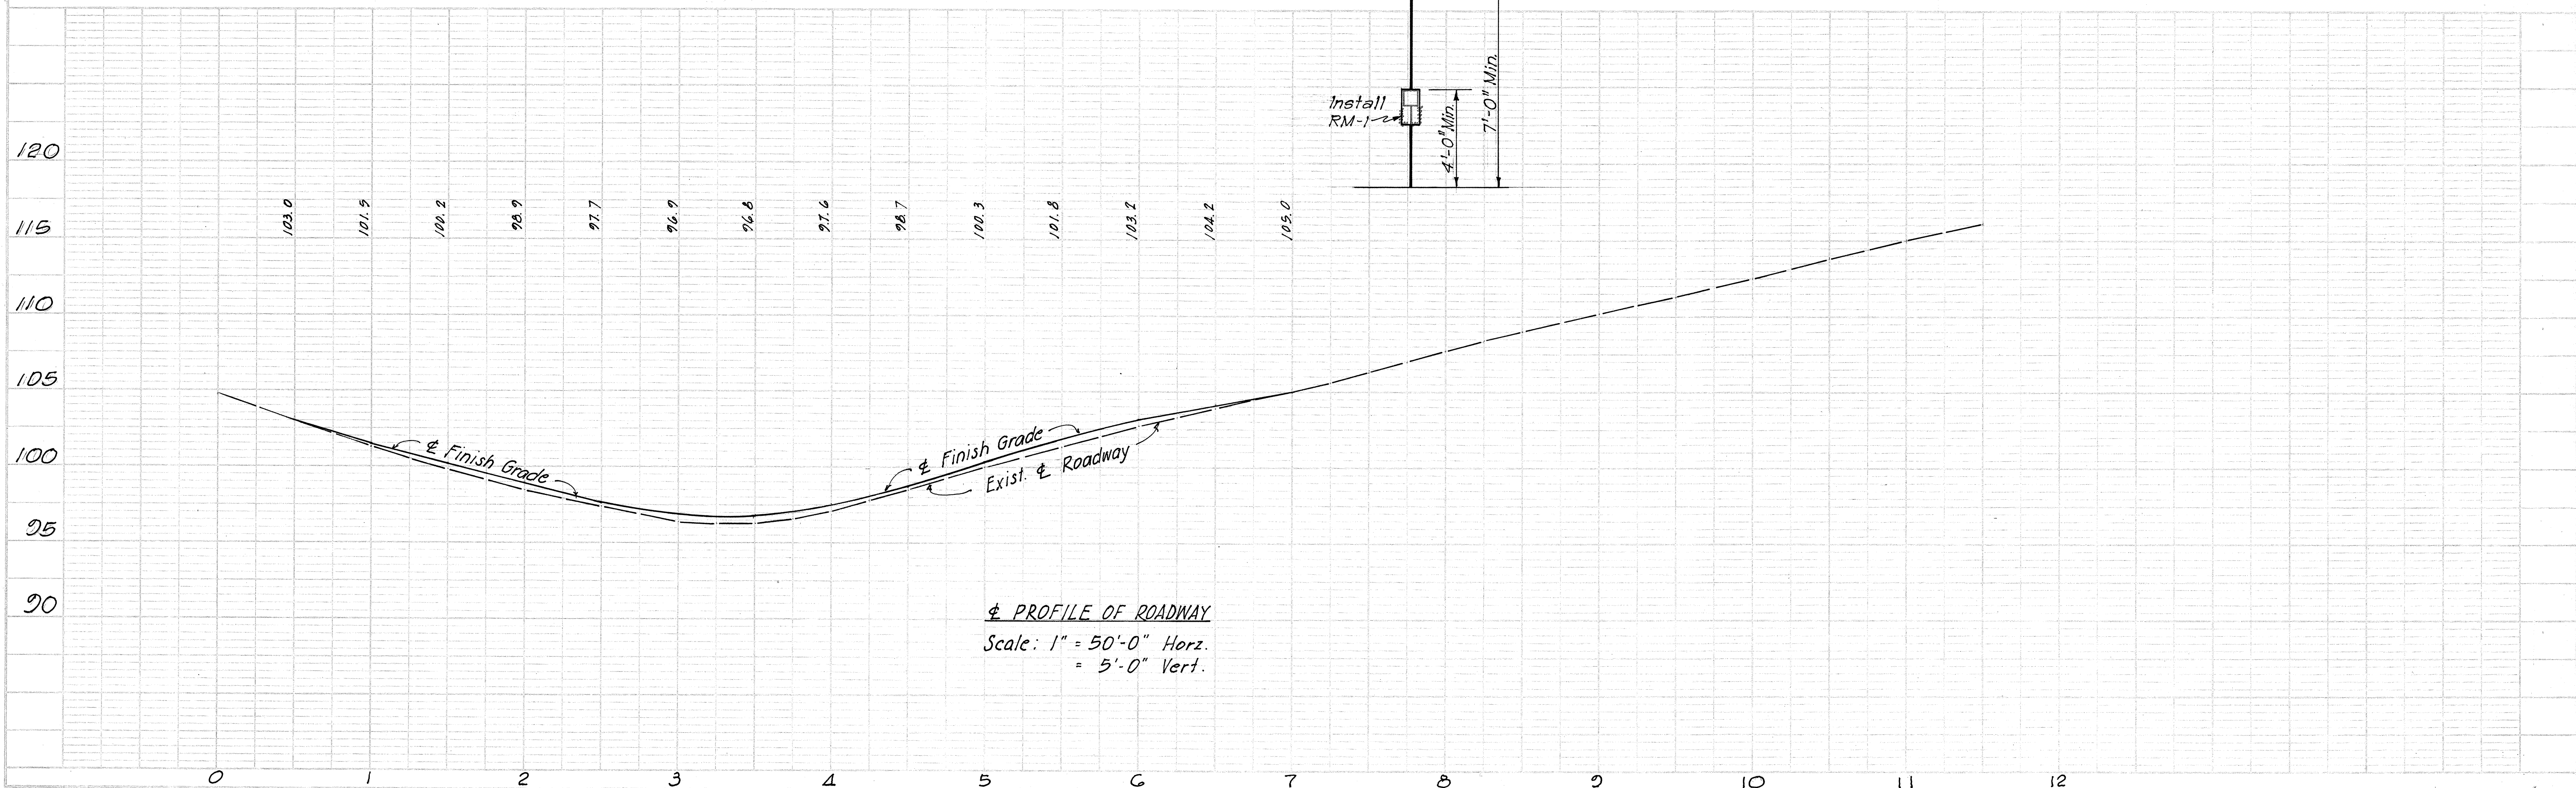


FED. ROAD DIST. NO.	STATE	FED.-AID PROJ. NO.	FISCAL YEAR	SHEET NO.	TOTAL SHEETS
HAWAII	HAW.	36B-02-79	1979	3	17

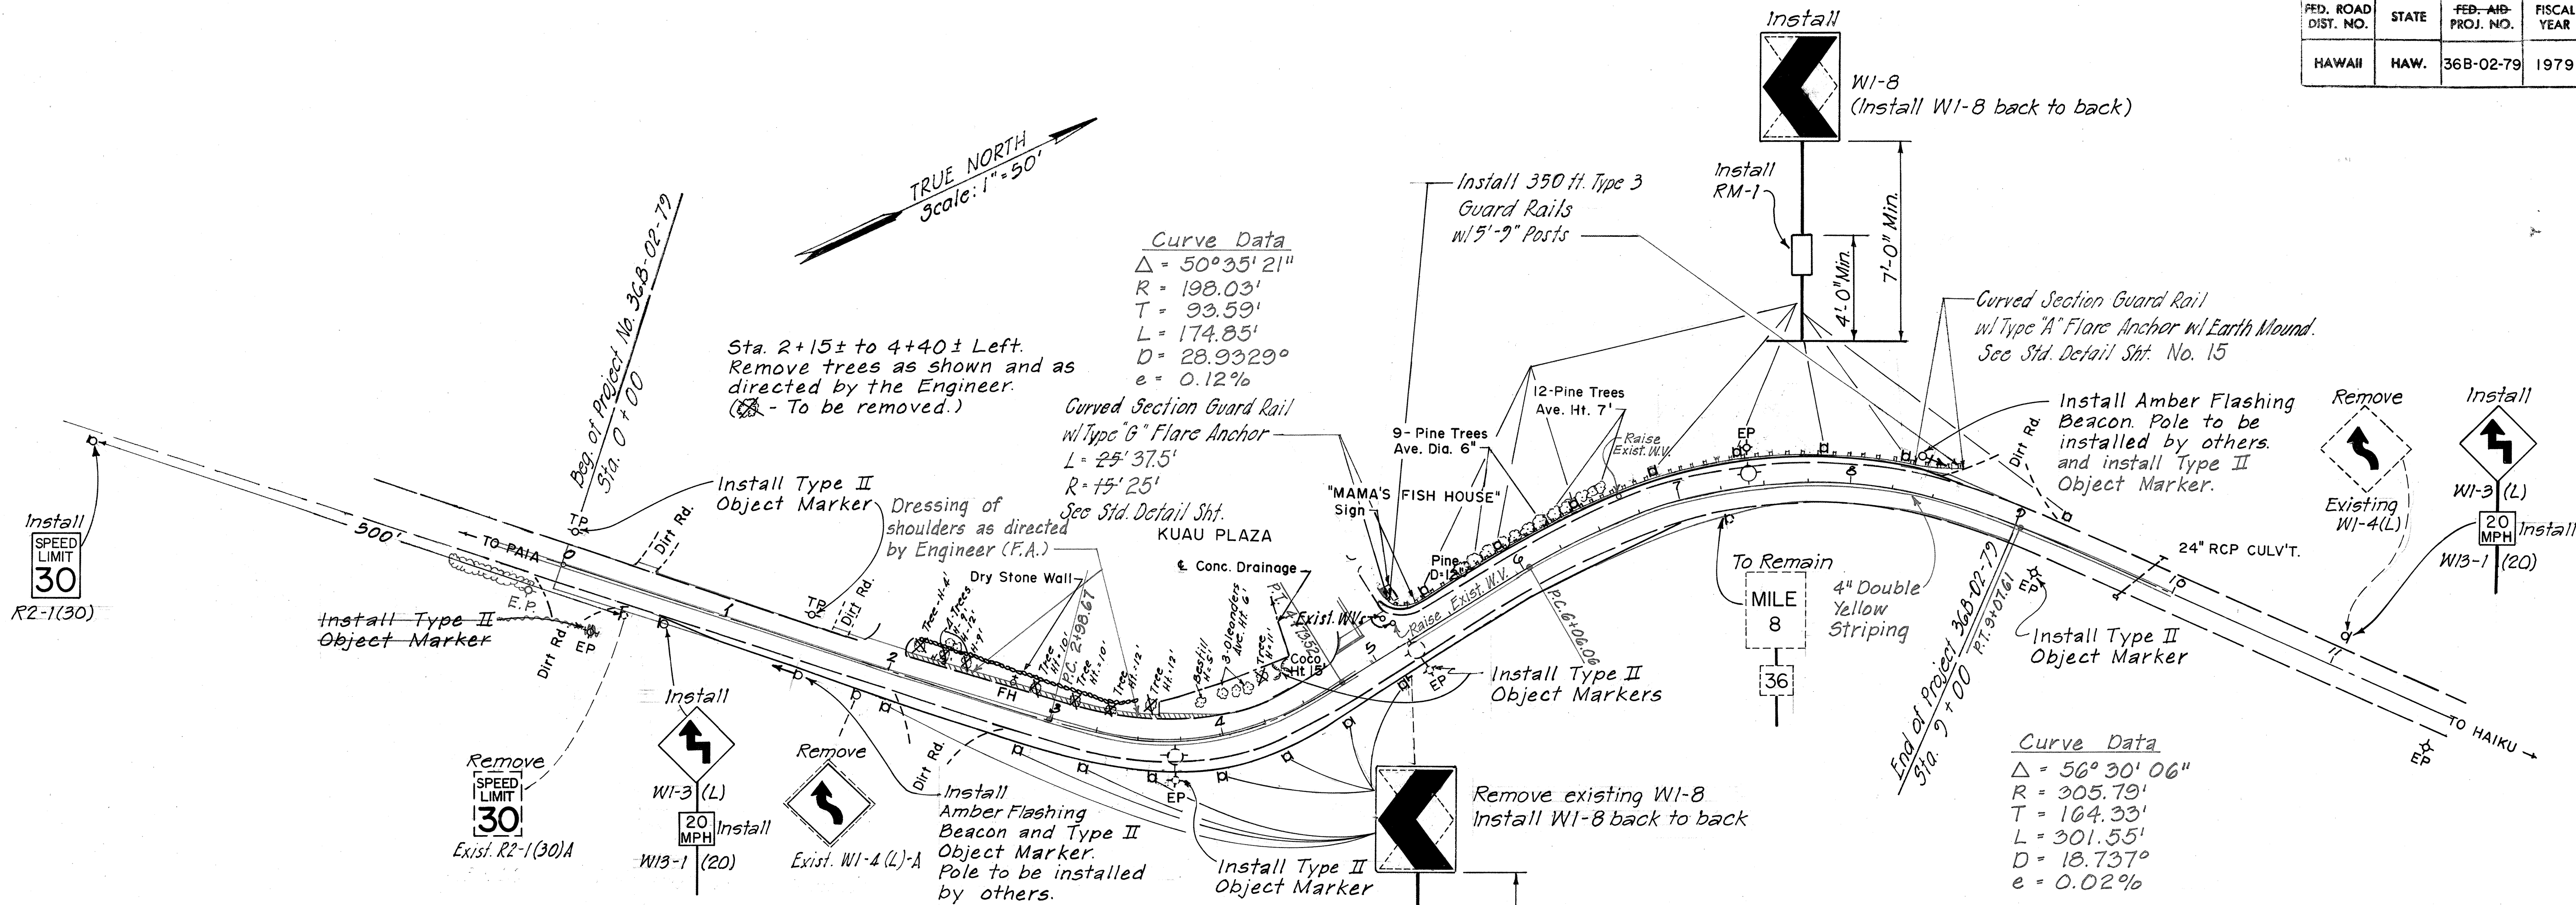

PLAN	DATE	BY	CHKD.	DATE
SURVEYED				
PLOTTED				
ALIGNED				
CHECKED				
NO. OF WKS. ORG.				
NO.				

PROFILE	DATE	BY	CHKD.	DATE
SURVEYED				
PLOTTED				
CHECKED				
NO. OF WKS. ORG.				
NO.				