



FED. ROAD DIST. NO.	STATE	FED. AID PROJ. NO.	FISCAL YEAR	SHEET NO.	TOTAL SHEETS
HAWAII	HAW.	36B-02-79	1979	4	17

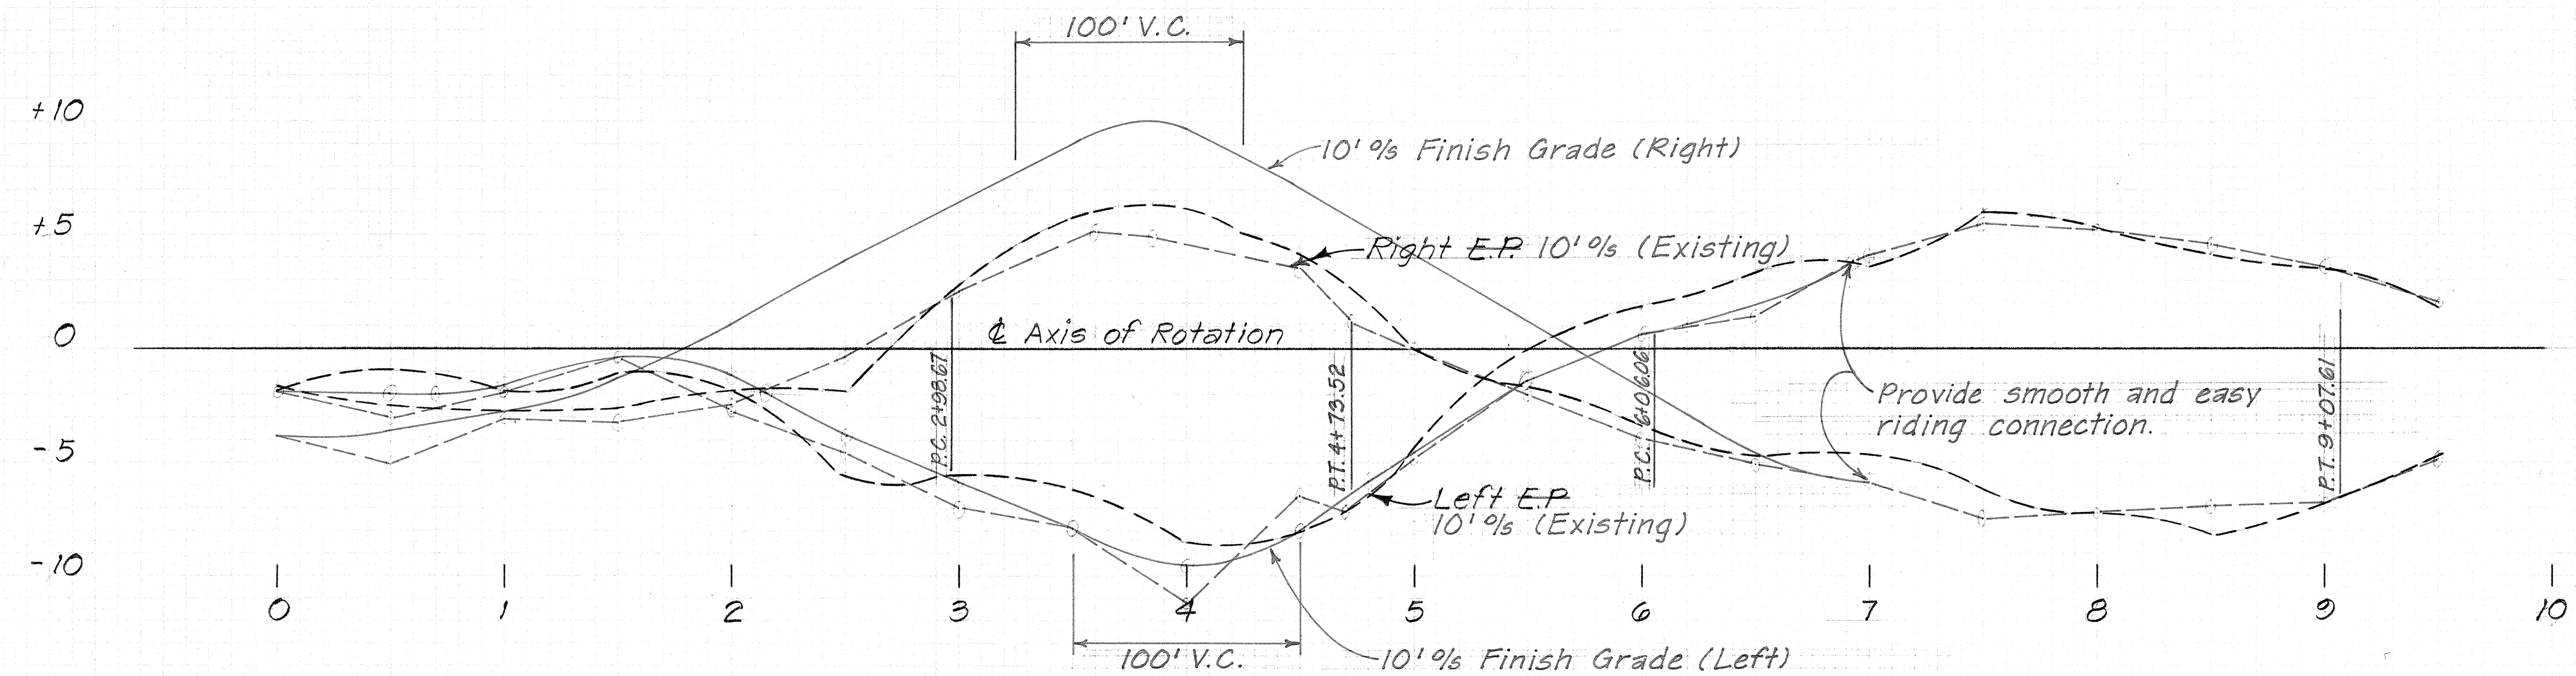

EXISTING SUPERELEVATION (EXISTING AND DESIGN FINISH GRADES)

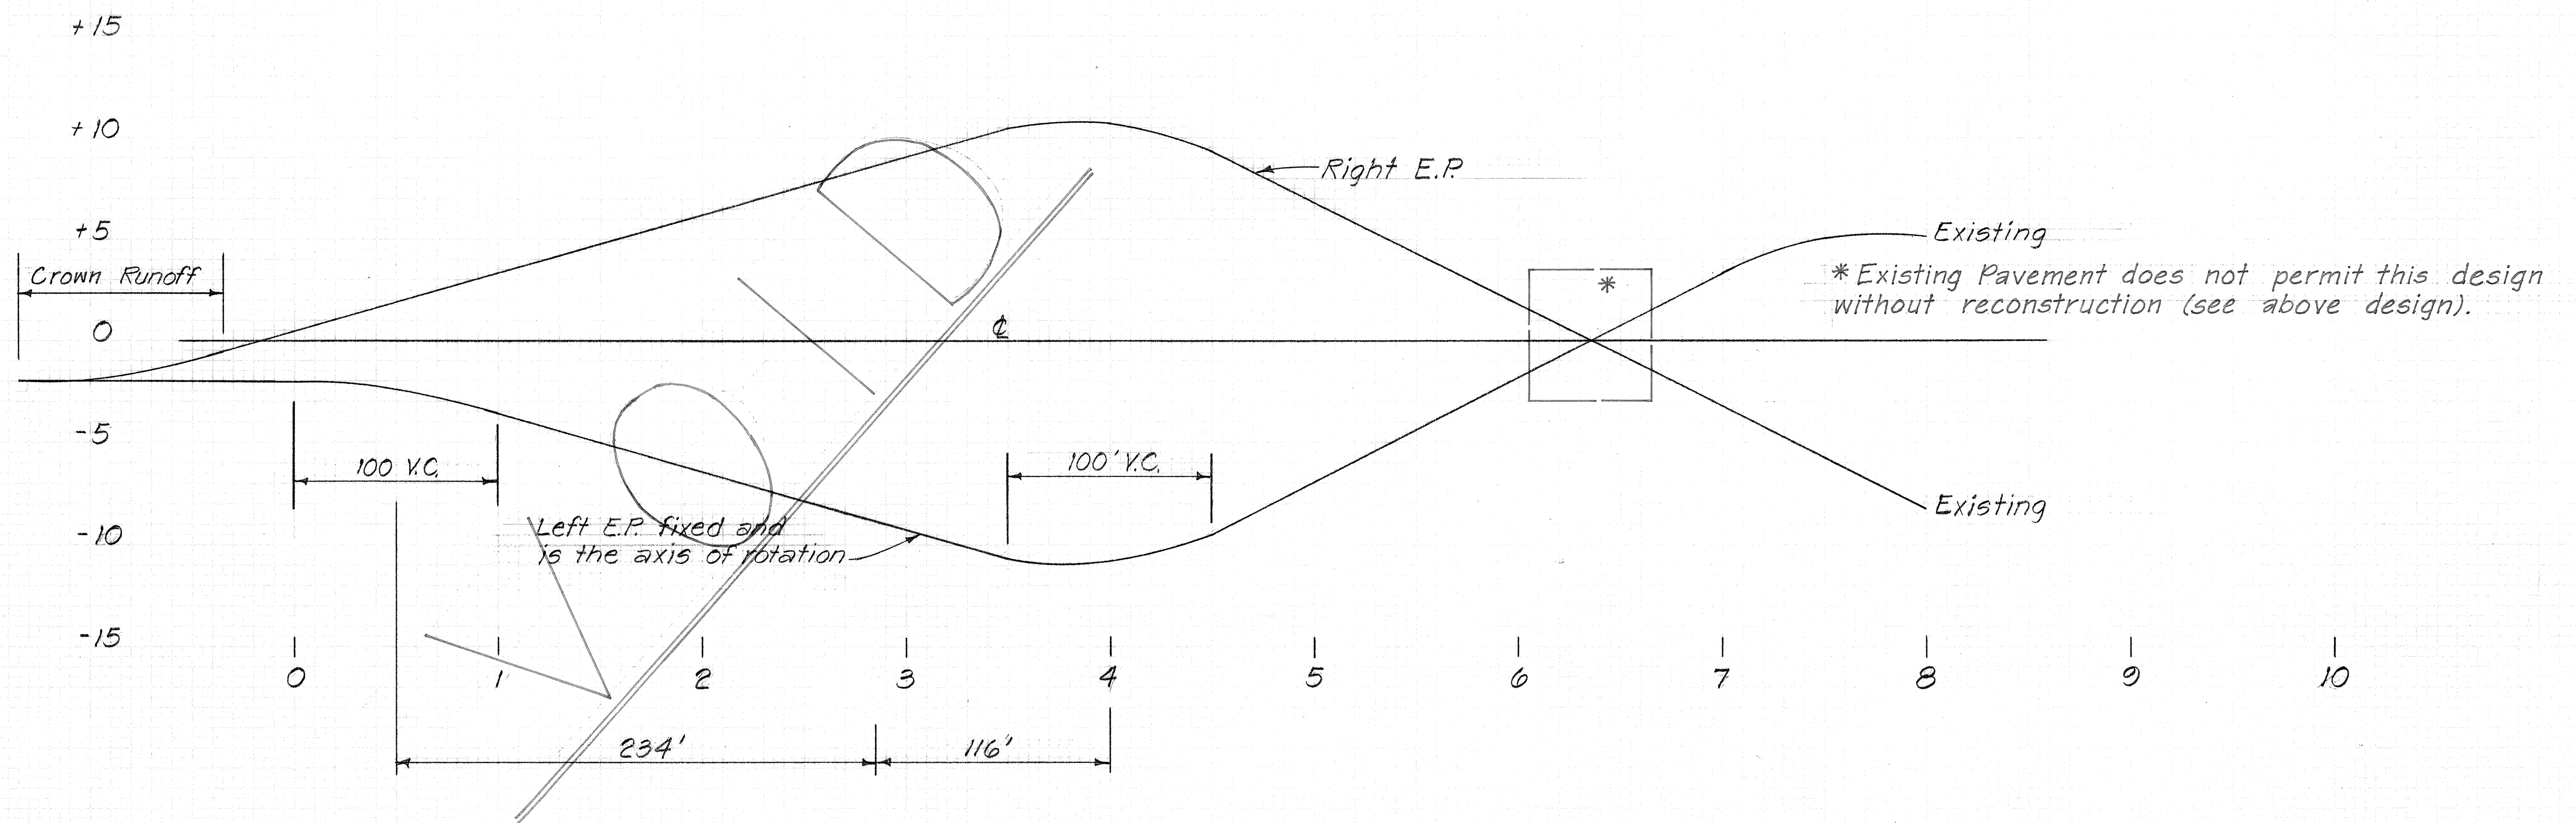

STATE OF HAWAII
DEPARTMENT OF TRANSPORTATION
HIGHWAYS DIVISION

SUPER-ELEVATION DIAGRAM

HANA HIGHWAY
IMPROVEMENT AT KUAU
PROJECT NO. 36B-02-79

AUGUST, 1979