
INDEX TO DRAWINGS	
SHEET NO	DESCRIPTION
1	TITLE SHEET
•	TYPICAL SECTION, MISC. DETAILS
2	AND SUMMARIES
3 .	PLAN AND PROFILE
4	SUPER ELEVATION DIAGRAM
5	CROSS SECTION
6	TYPICAL DETAILS (TYPE II
	OBJECT MARKERS)
7-17	STANDARD DETAILS

STATE OF HAWAII
DEPARTMENT OF TRANSPORTATION
HIGHWAYS DIVISION
HONOLULU, HAWAII
"AS BUILT" PLANS OF
HANA HIGHWAY
IMPROVEMENTS AT KUAU
PROJECT NO. 36B-02-79

DISTRICT OF MAKAWAO
COUNTY OF MAUI
ISLAND OF MAUI
SCALES


PLAN
PROFILE
HOR. | IN. = 50 FT. |
VER. | IN. = 10 FT. |
VER. | IN. = 10 FT. |

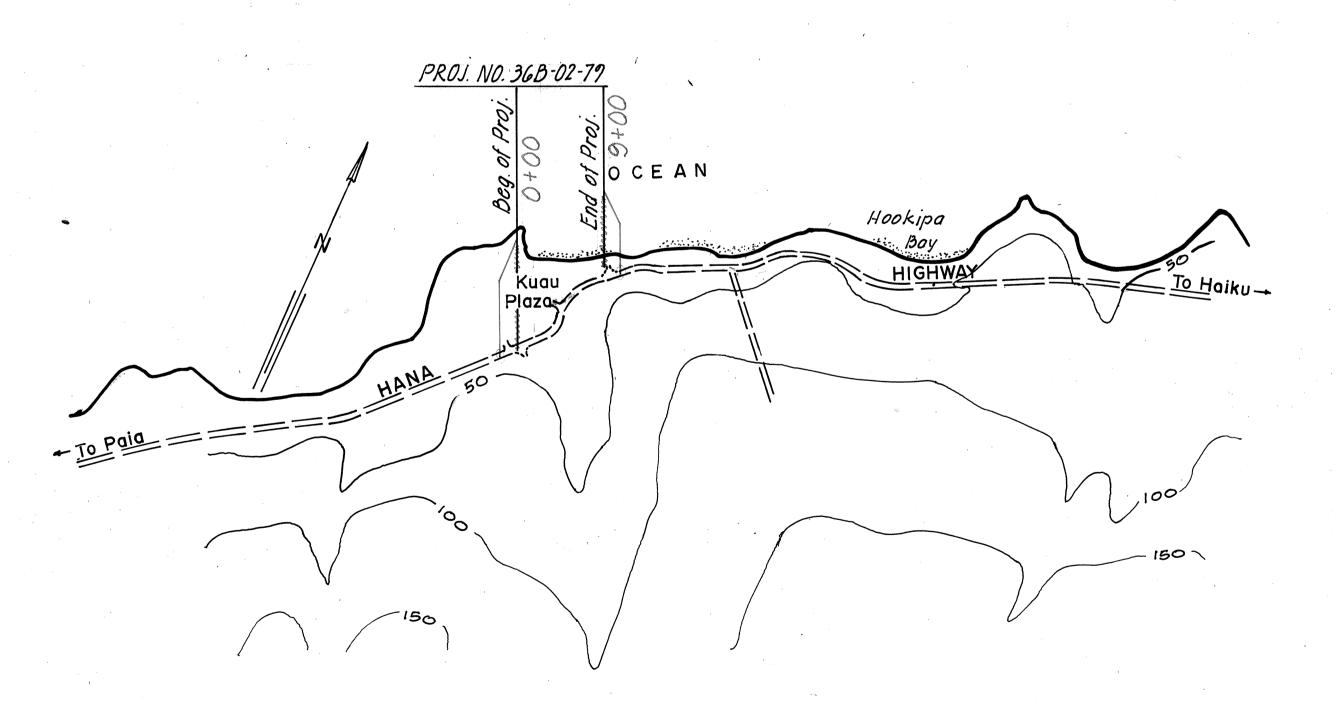

LAYOUT OF PROJECT

LENGTH OF PROJECT 0.1894 Mi
" " 0.2743 Km.

SCALE: I" = 1000'

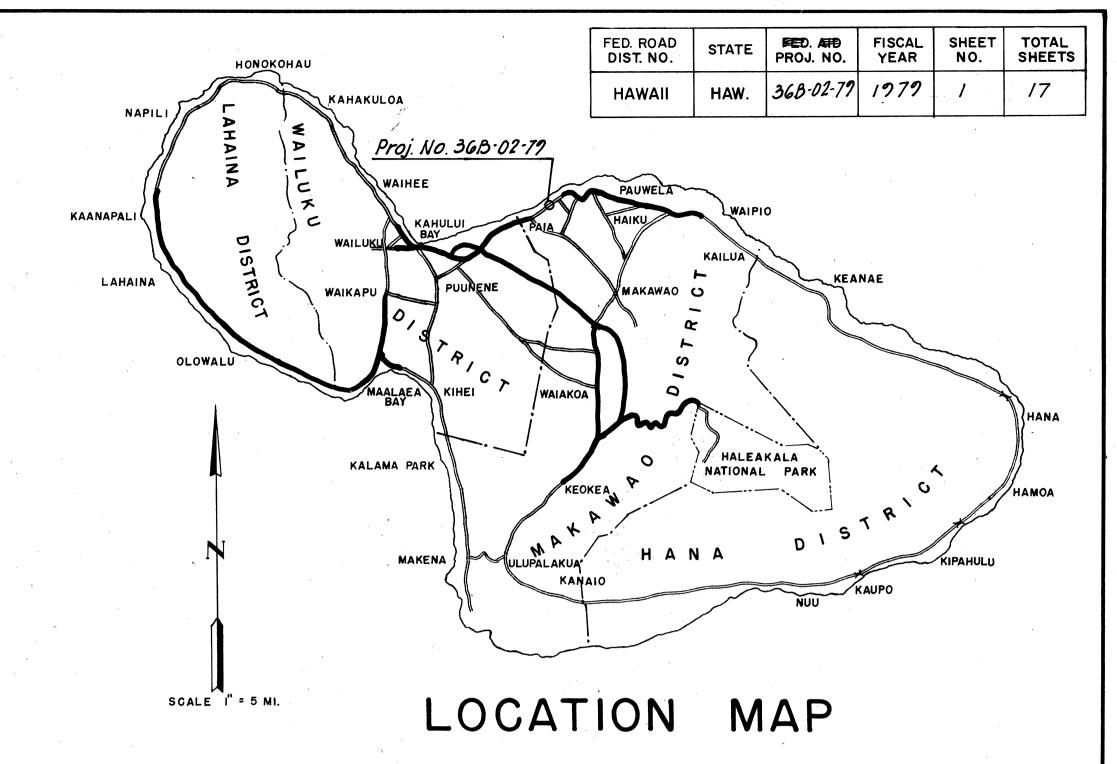


FEDERAL AID PROJECTS PREVIOUSLY CONSTRUCTED OR UNDER CONSTRUCTION

ALL CHANGES MADE DURING CONSTRUCTION HAVE BEEN INCORPORATED ON THESE PLANS EXCEPT CHANGES IN THE ORIGINAL THEORETICAL QUANTITIES.

Hoyd Dowfoe PROJECT ENGINEER

12-1-81 DATE

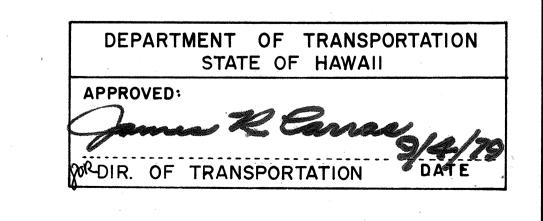

7 548-7534 SEPT 4,1979 Y PHONE DATE

R. MIKAMI

MAUL DISTRICT