



FED. ROAD DIST. NO.	STATE	PROJ. NO.	FISCAL YEAR	SHEET NO.	TOTAL SHEETS
HAWAII	HAW.	368-01-79	1980	3	9

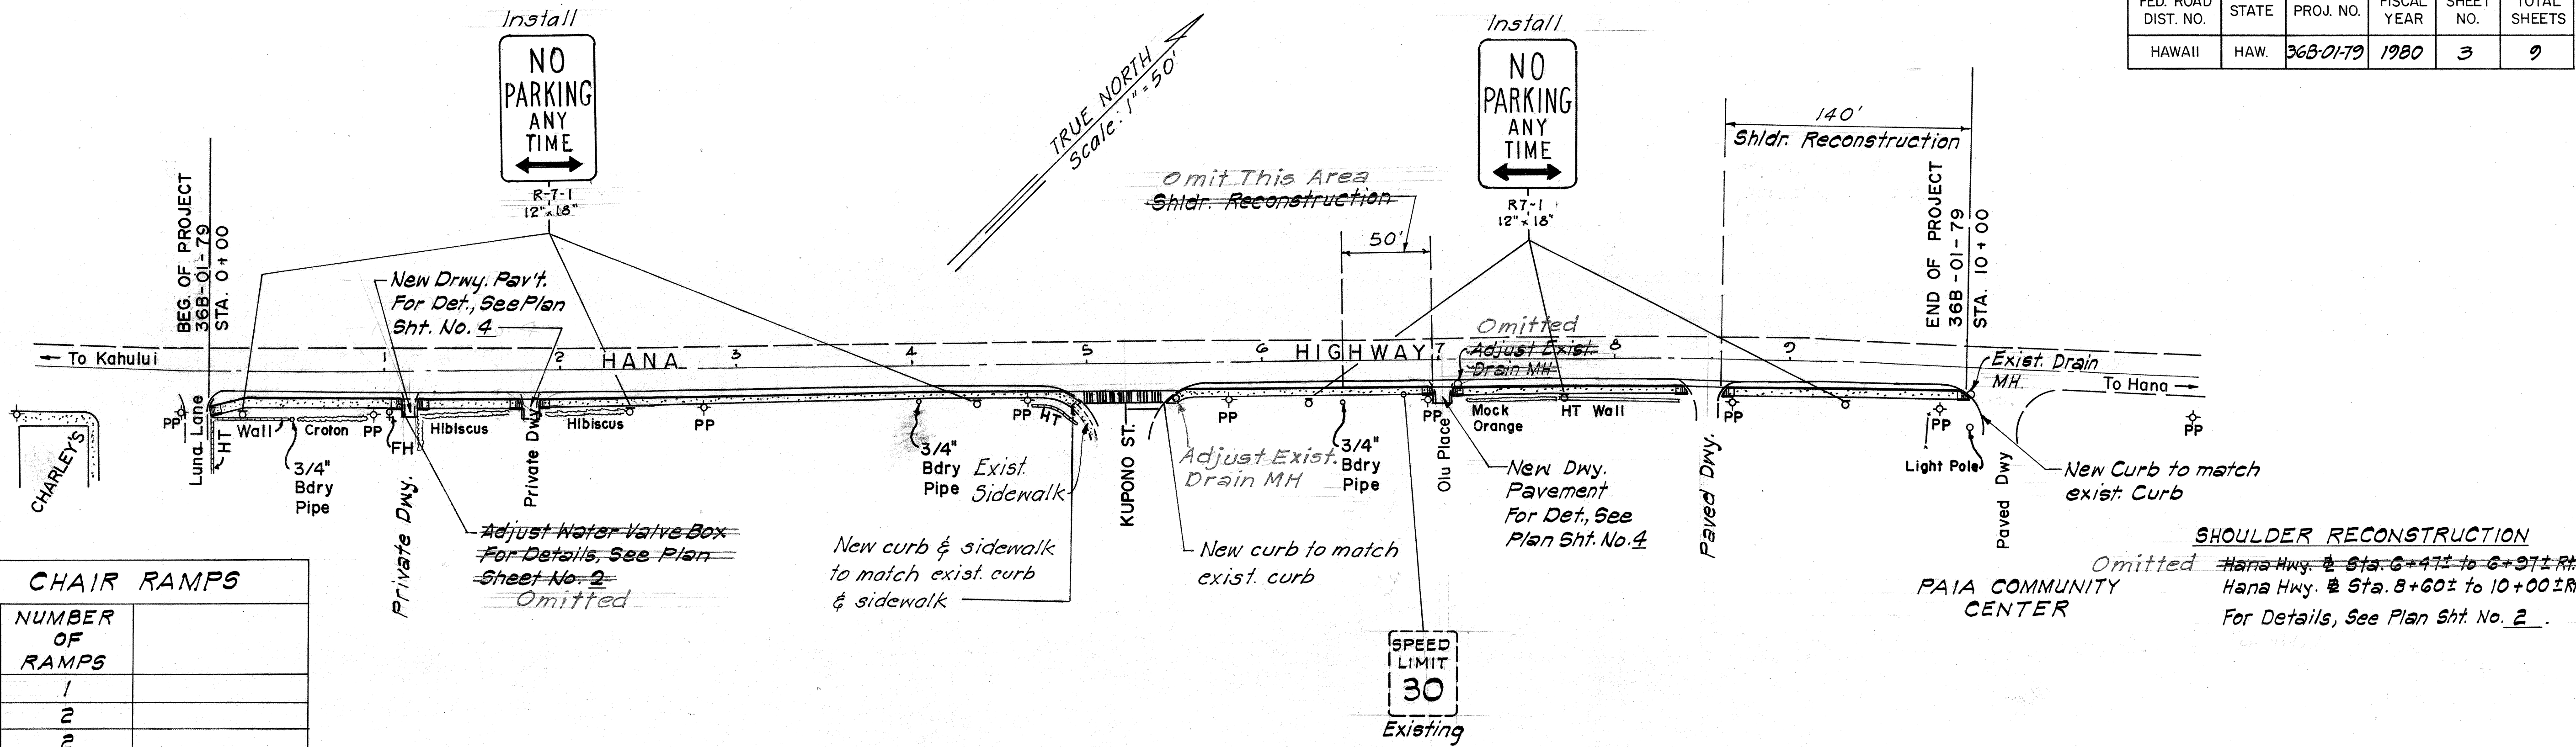

LIST OF WHEEL CHAIR RAMPS			
LOCATION		NUMBER OF RAMPS	
STATION RT. (±)	DESCRIPTION		
0+00	Luna Lane	1	
1+14	Private Dwy	2	
1+83	Private Dwy	2	
5+21	Kupono St.	2	
7+02	Olu Place	2	
8+53	Paved Dwy	2	
10+00	Paved Dwy	1	

For Details, See Plan Sht. No. 4

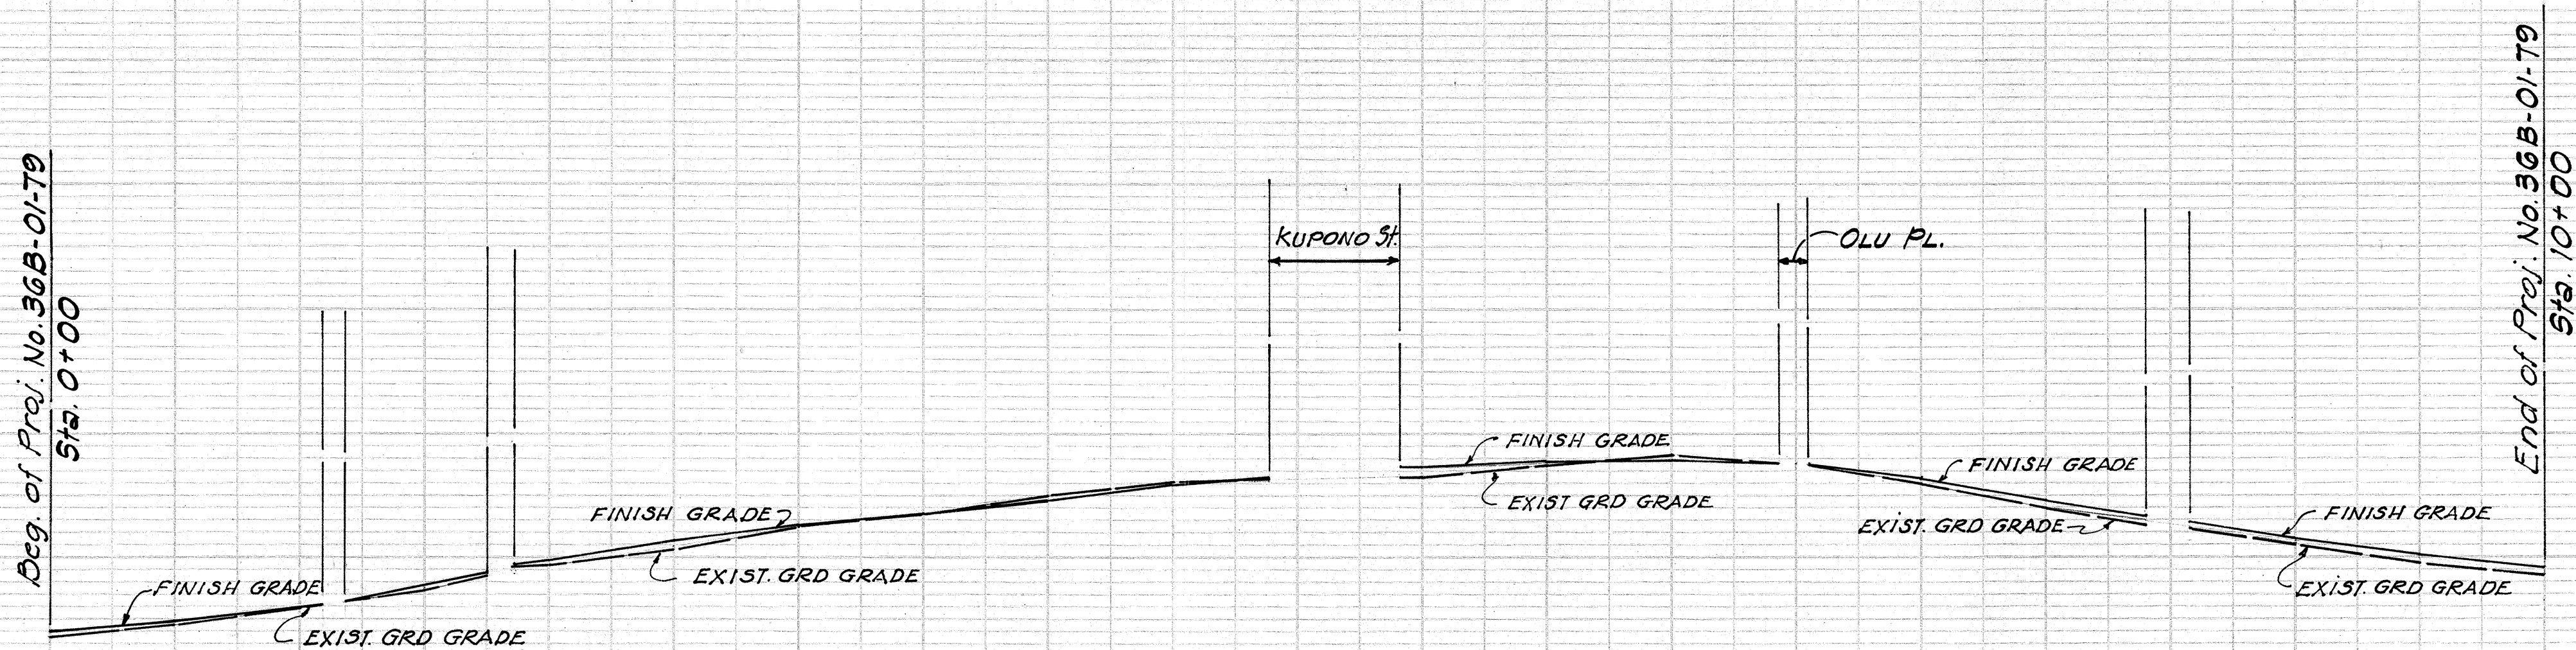

± PROFILE OF SIDEWALKS AT PAIA TOWN
Scale : 1" = 50'-0" Hor.
 = 10'-0" Vert.