

INDEX TO DRAWINGS	
SHEET NO	DESCRIPTION
1	TITLE SHEET
2	TYP. SECT., DET., GEN. NOTE
3	PLAN & PROFILE
4	WHEEL CHAIR RAMP DETAILS
5-9	STANDARD DETAILS

STATE OF HAWAII
DEPARTMENT OF TRANSPORTATION
HIGHWAYS DIVISION
HONOLULU, HAWAII
"AS - BUILT" PLANS OF
HANA HIGHWAY
SIDEWALKS AT PAIA TOWN
PROJECT NO. 36B-01-79
DISTRICT OF MAKAWAO
COUNTY OF MAUI
ISLAND OF MAUI


SCALES

PLAN

1 IN. = 50 FT.

PROFILE

HOR. 1 IN. = 50 FT.
VER. 1 IN. = 10 FT.

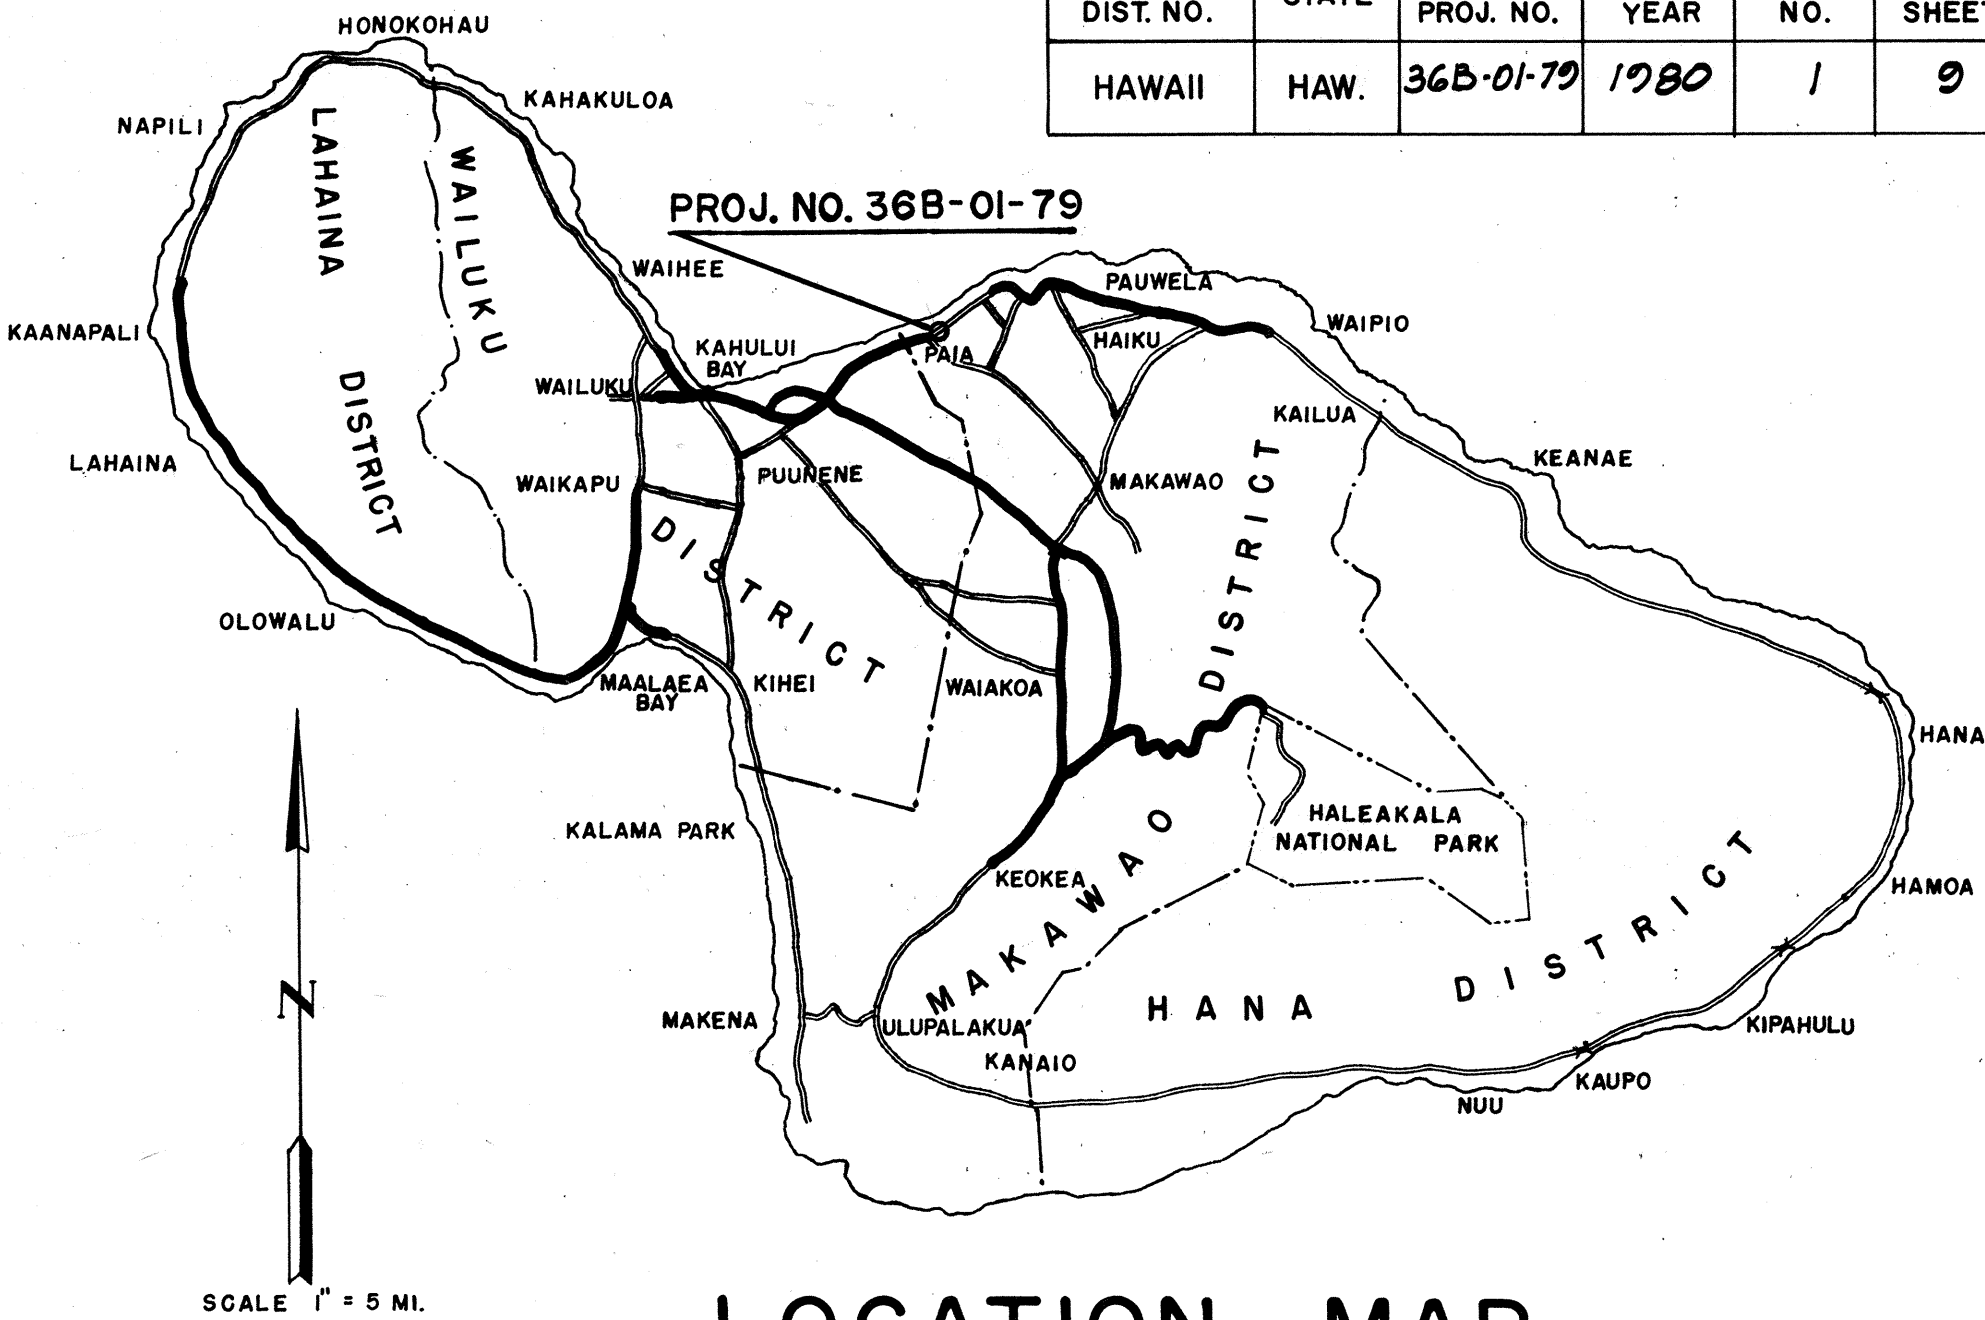


ALL CHANGES MADE DURING CONSTRUCTION
HAVE BEEN NOTED IN RED ON THESE TRACINGS
AND CHECKED BY

George N. Kaya

10/27/80

RESIDENT ENGINEER

DATE

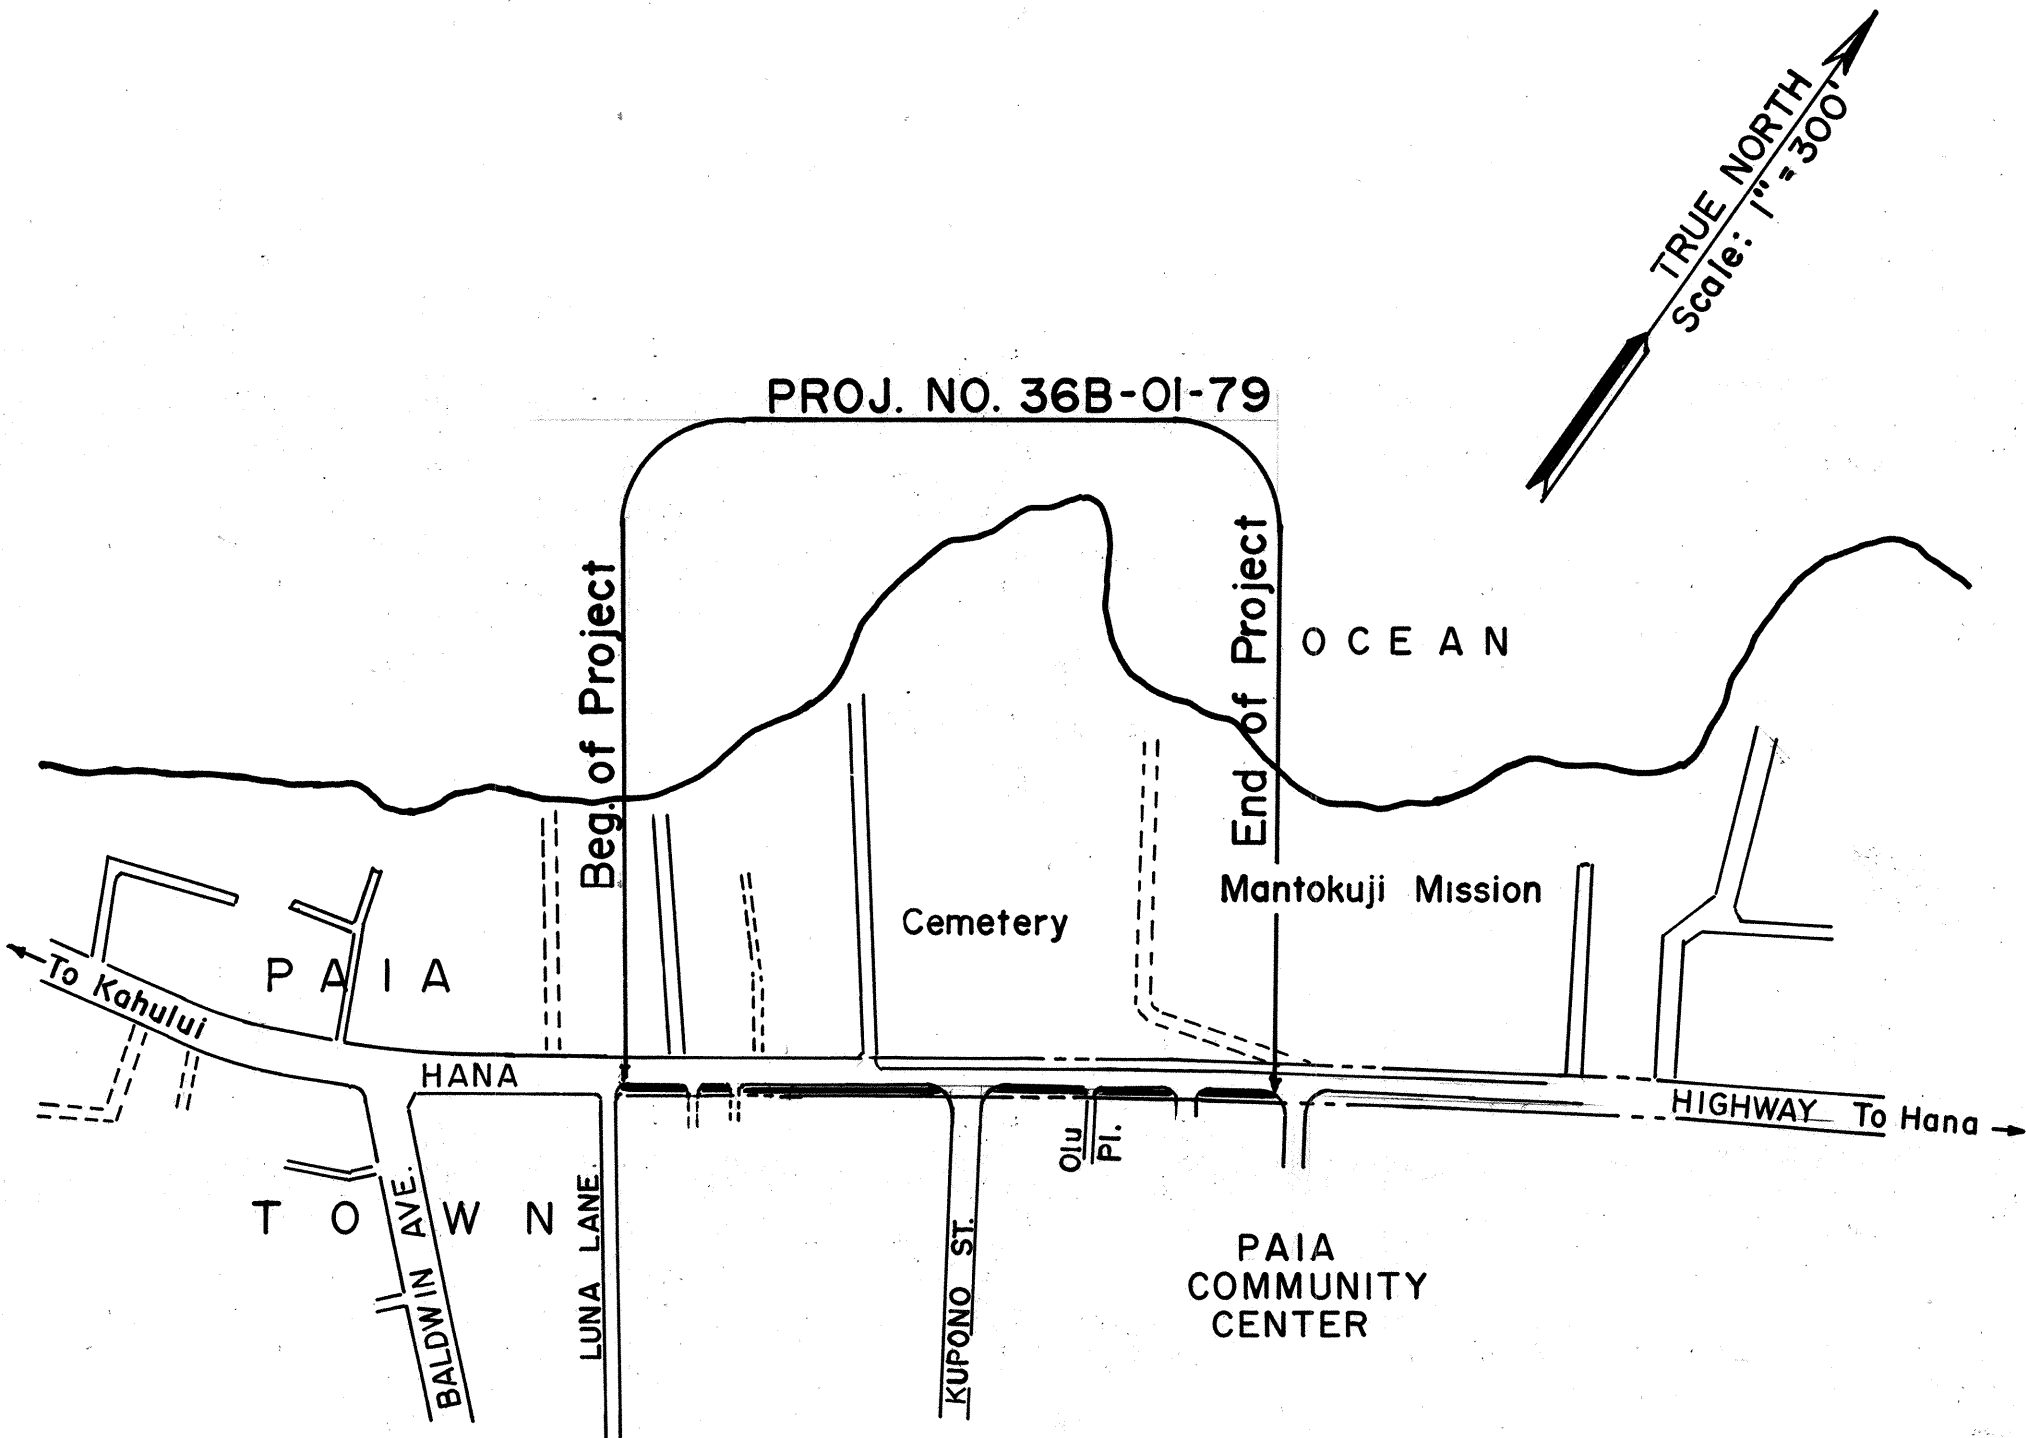

LAYOUT OF PROJECT
LENGTH OF PROJECT 0.189 MI.

DEPARTMENT OF TRANSPORTATION
STATE OF HAWAII

APPROVED:

James R. Caras

2/14/80

DIR. OF TRANSPORTATION

DATE

DESIGNED BY: MAUI DISTRICT OFFICE
STATE HWYS. DIVISION
DATE MAY 1979

" C "

HWY DESIGN UNIT

548-7490

PHONE

OCT. 1979

DATE