


ORIGINAL PLAN	SURVEY PLOTTED BY _____	DATE _____
	DRAWN BY _____	" _____
	TRACED BY _____	" _____
NOTE BOOK	DESIGNED BY _____	" _____
	QUANTITIES BY _____	" _____
No. _____	CHECKED BY _____	" _____

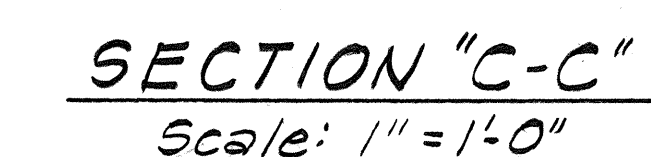

STATE OF HAWAII
DEPARTMENT OF TRANSPORTATION
LAND TRANSPORTATION FACILITIES DIVISION

WHEEL CHAIR RAMP DETAILS

HANA HIGHWAY
Sidewalks at Paia Town
Proj. No. 36B-01-79

Scale: As Shown Date: Oct, 1979

SHEET No. 1 OF 1 SHEETS