

FED. ROAD DIST. NO.	STATE	PROJ. NO.	FISCAL YEAR	SHEET NO.	TOTAL SHEETS
HAWAII	HAW.	378A-01-82M 368C-01-82M	1982	3	11

SPECIAL NOTE:

Under Proj. No. 378A-01-82M additional A.C. Paving shall be included (shaded area)
Sta. 0+00 to Sta. -3+20


Proj. No. FAP 5-B
Sta. 335+85
Beg. Proj. No. 378A-01-82M
Sta. 0+00

SPECIAL NOTE:

- Contractor shall pave Curves 3-5 according to the existing pavement width or as directed by the Engineer
- Sta. 0+00 to 33+50 was paved under this contract.

LEGEND:


- AC Driveway
- Conc. Driveway
- Gravel or Dirt Driveway
- Curve No.

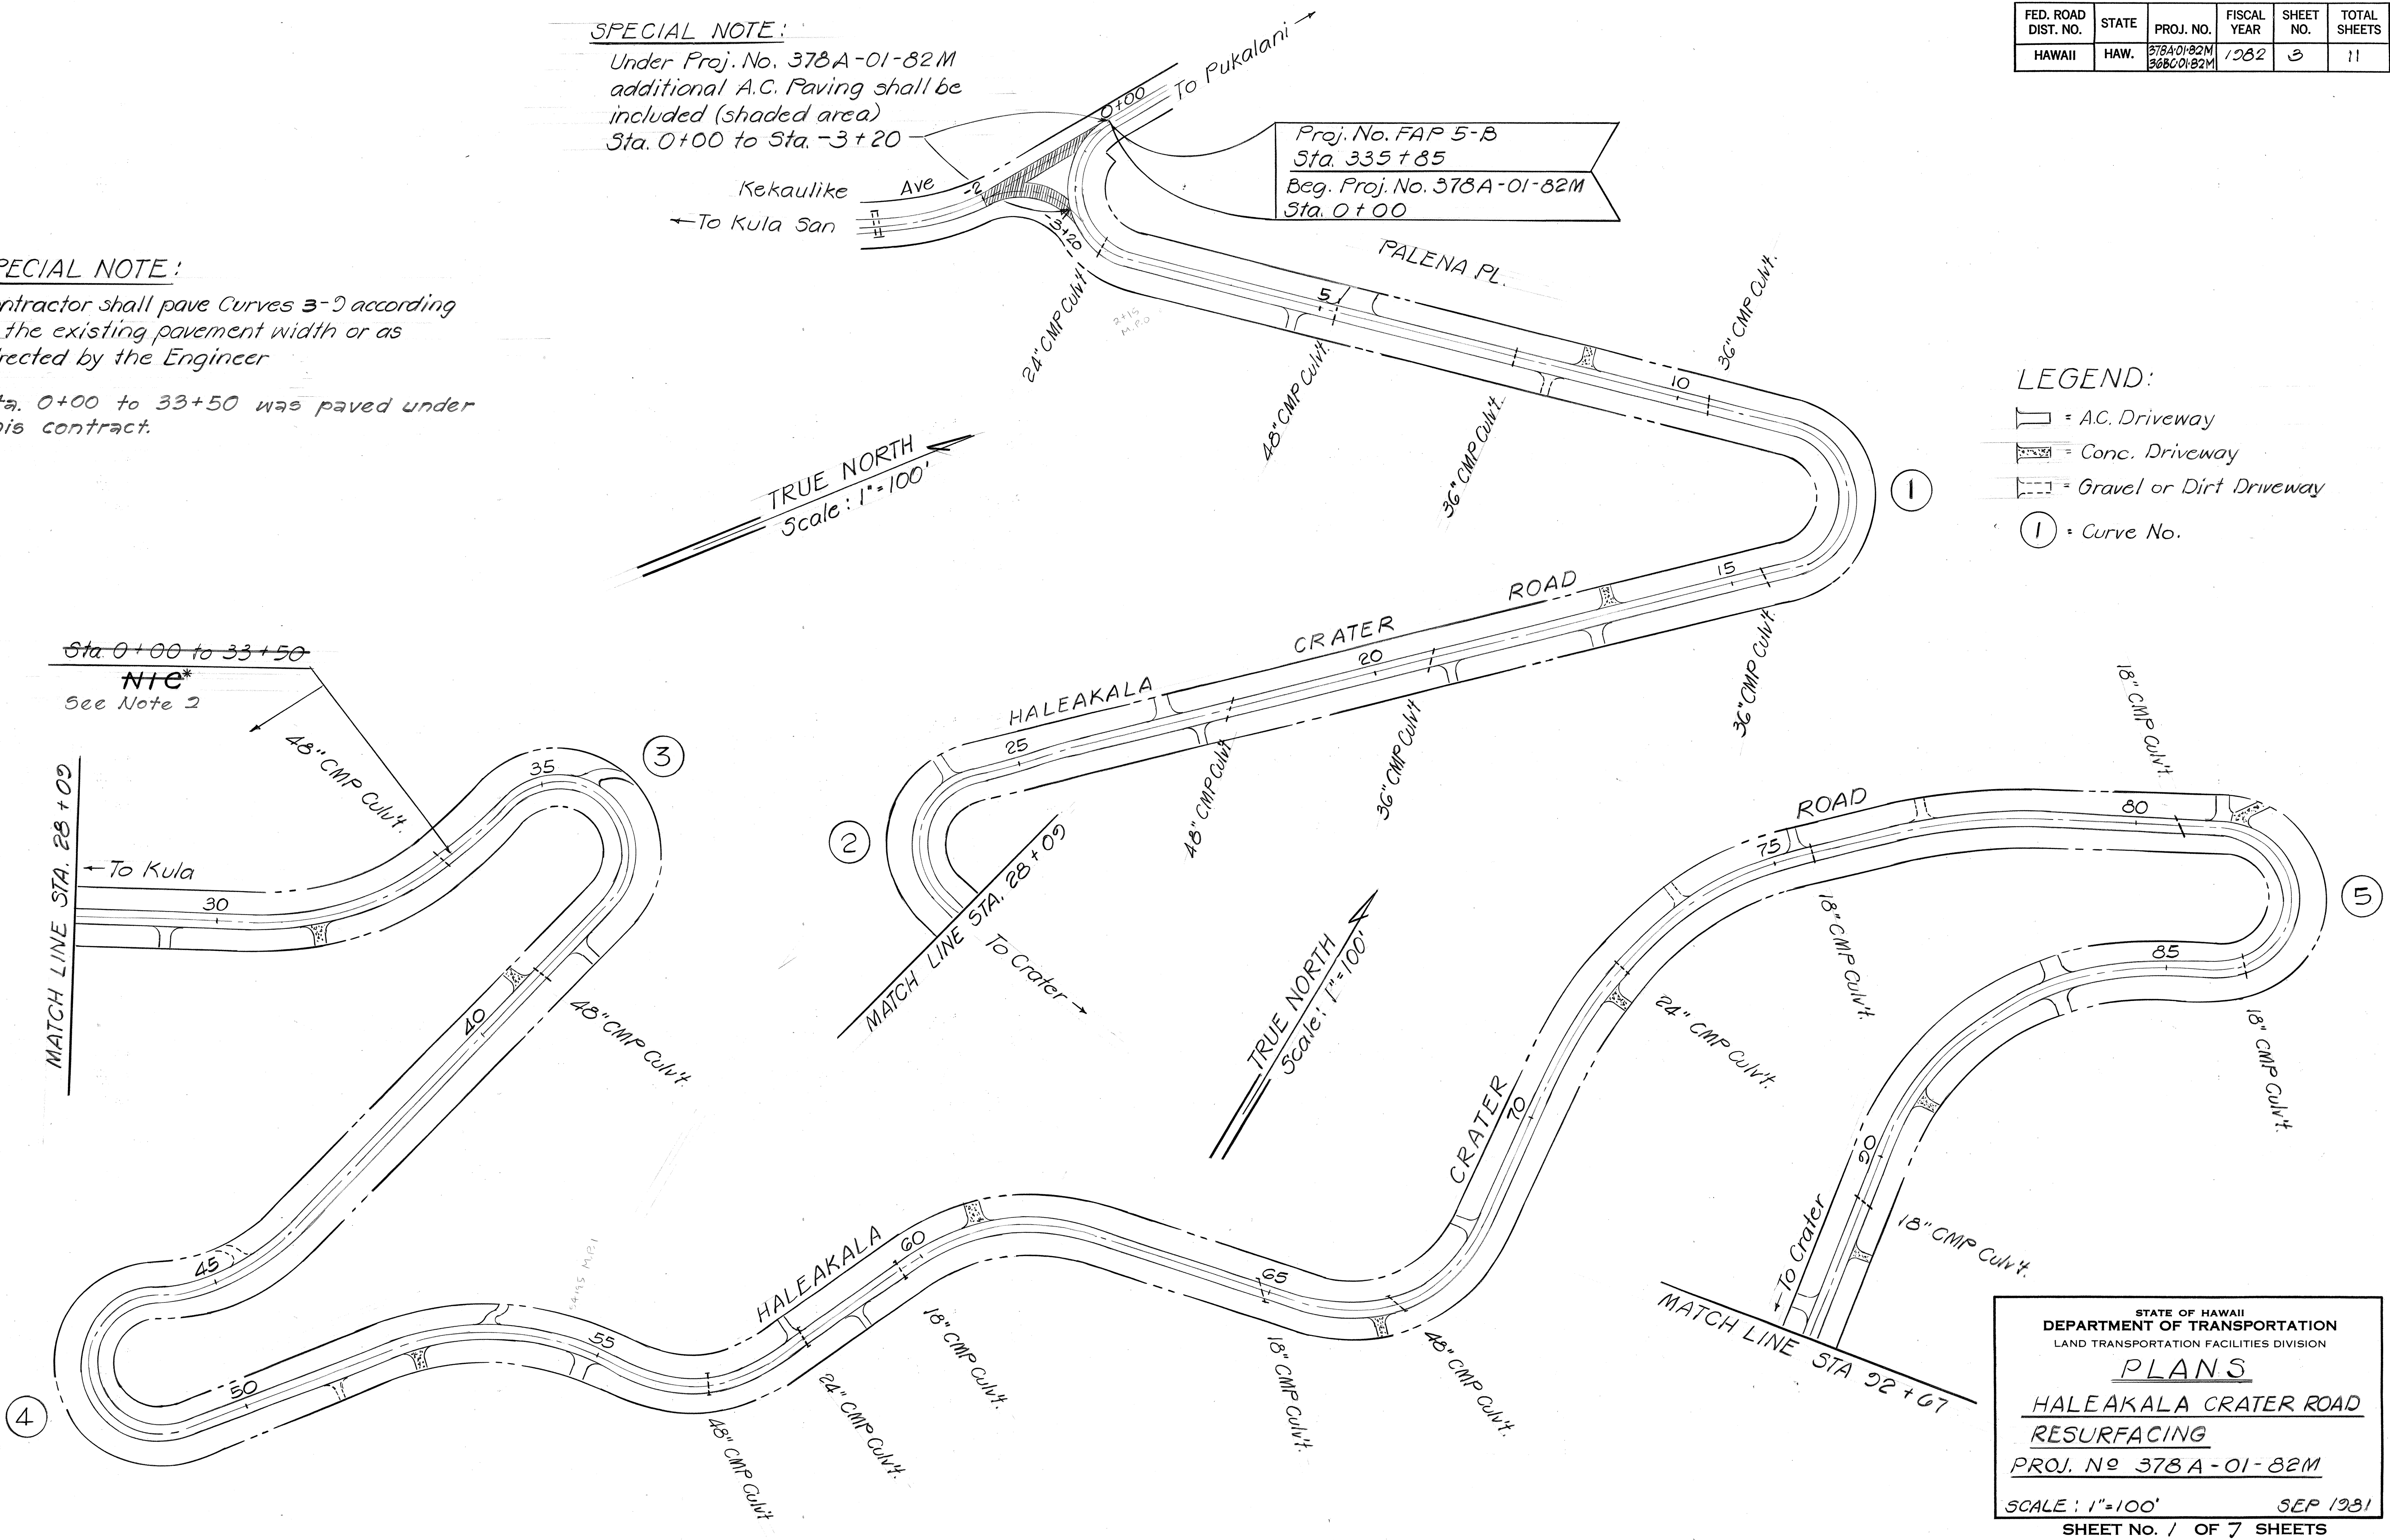

ORIGINAL PLAN	SURVEY PLOTTED BY	DATE
NOTE BOOK	DRAWN BY	7/81
QUANTITIES BY	DESIGNED BY	
CHECKED BY		

FED. ROAD DIST. NO.	STATE	PROJ. NO.	FISCAL YEAR	SHEET NO.	TOTAL SHEETS
HAWAII	HAW.	378A-01-82M 322BC-01-82M	1982	4	11

TRUE NORTH
Scale: 1" = 100'

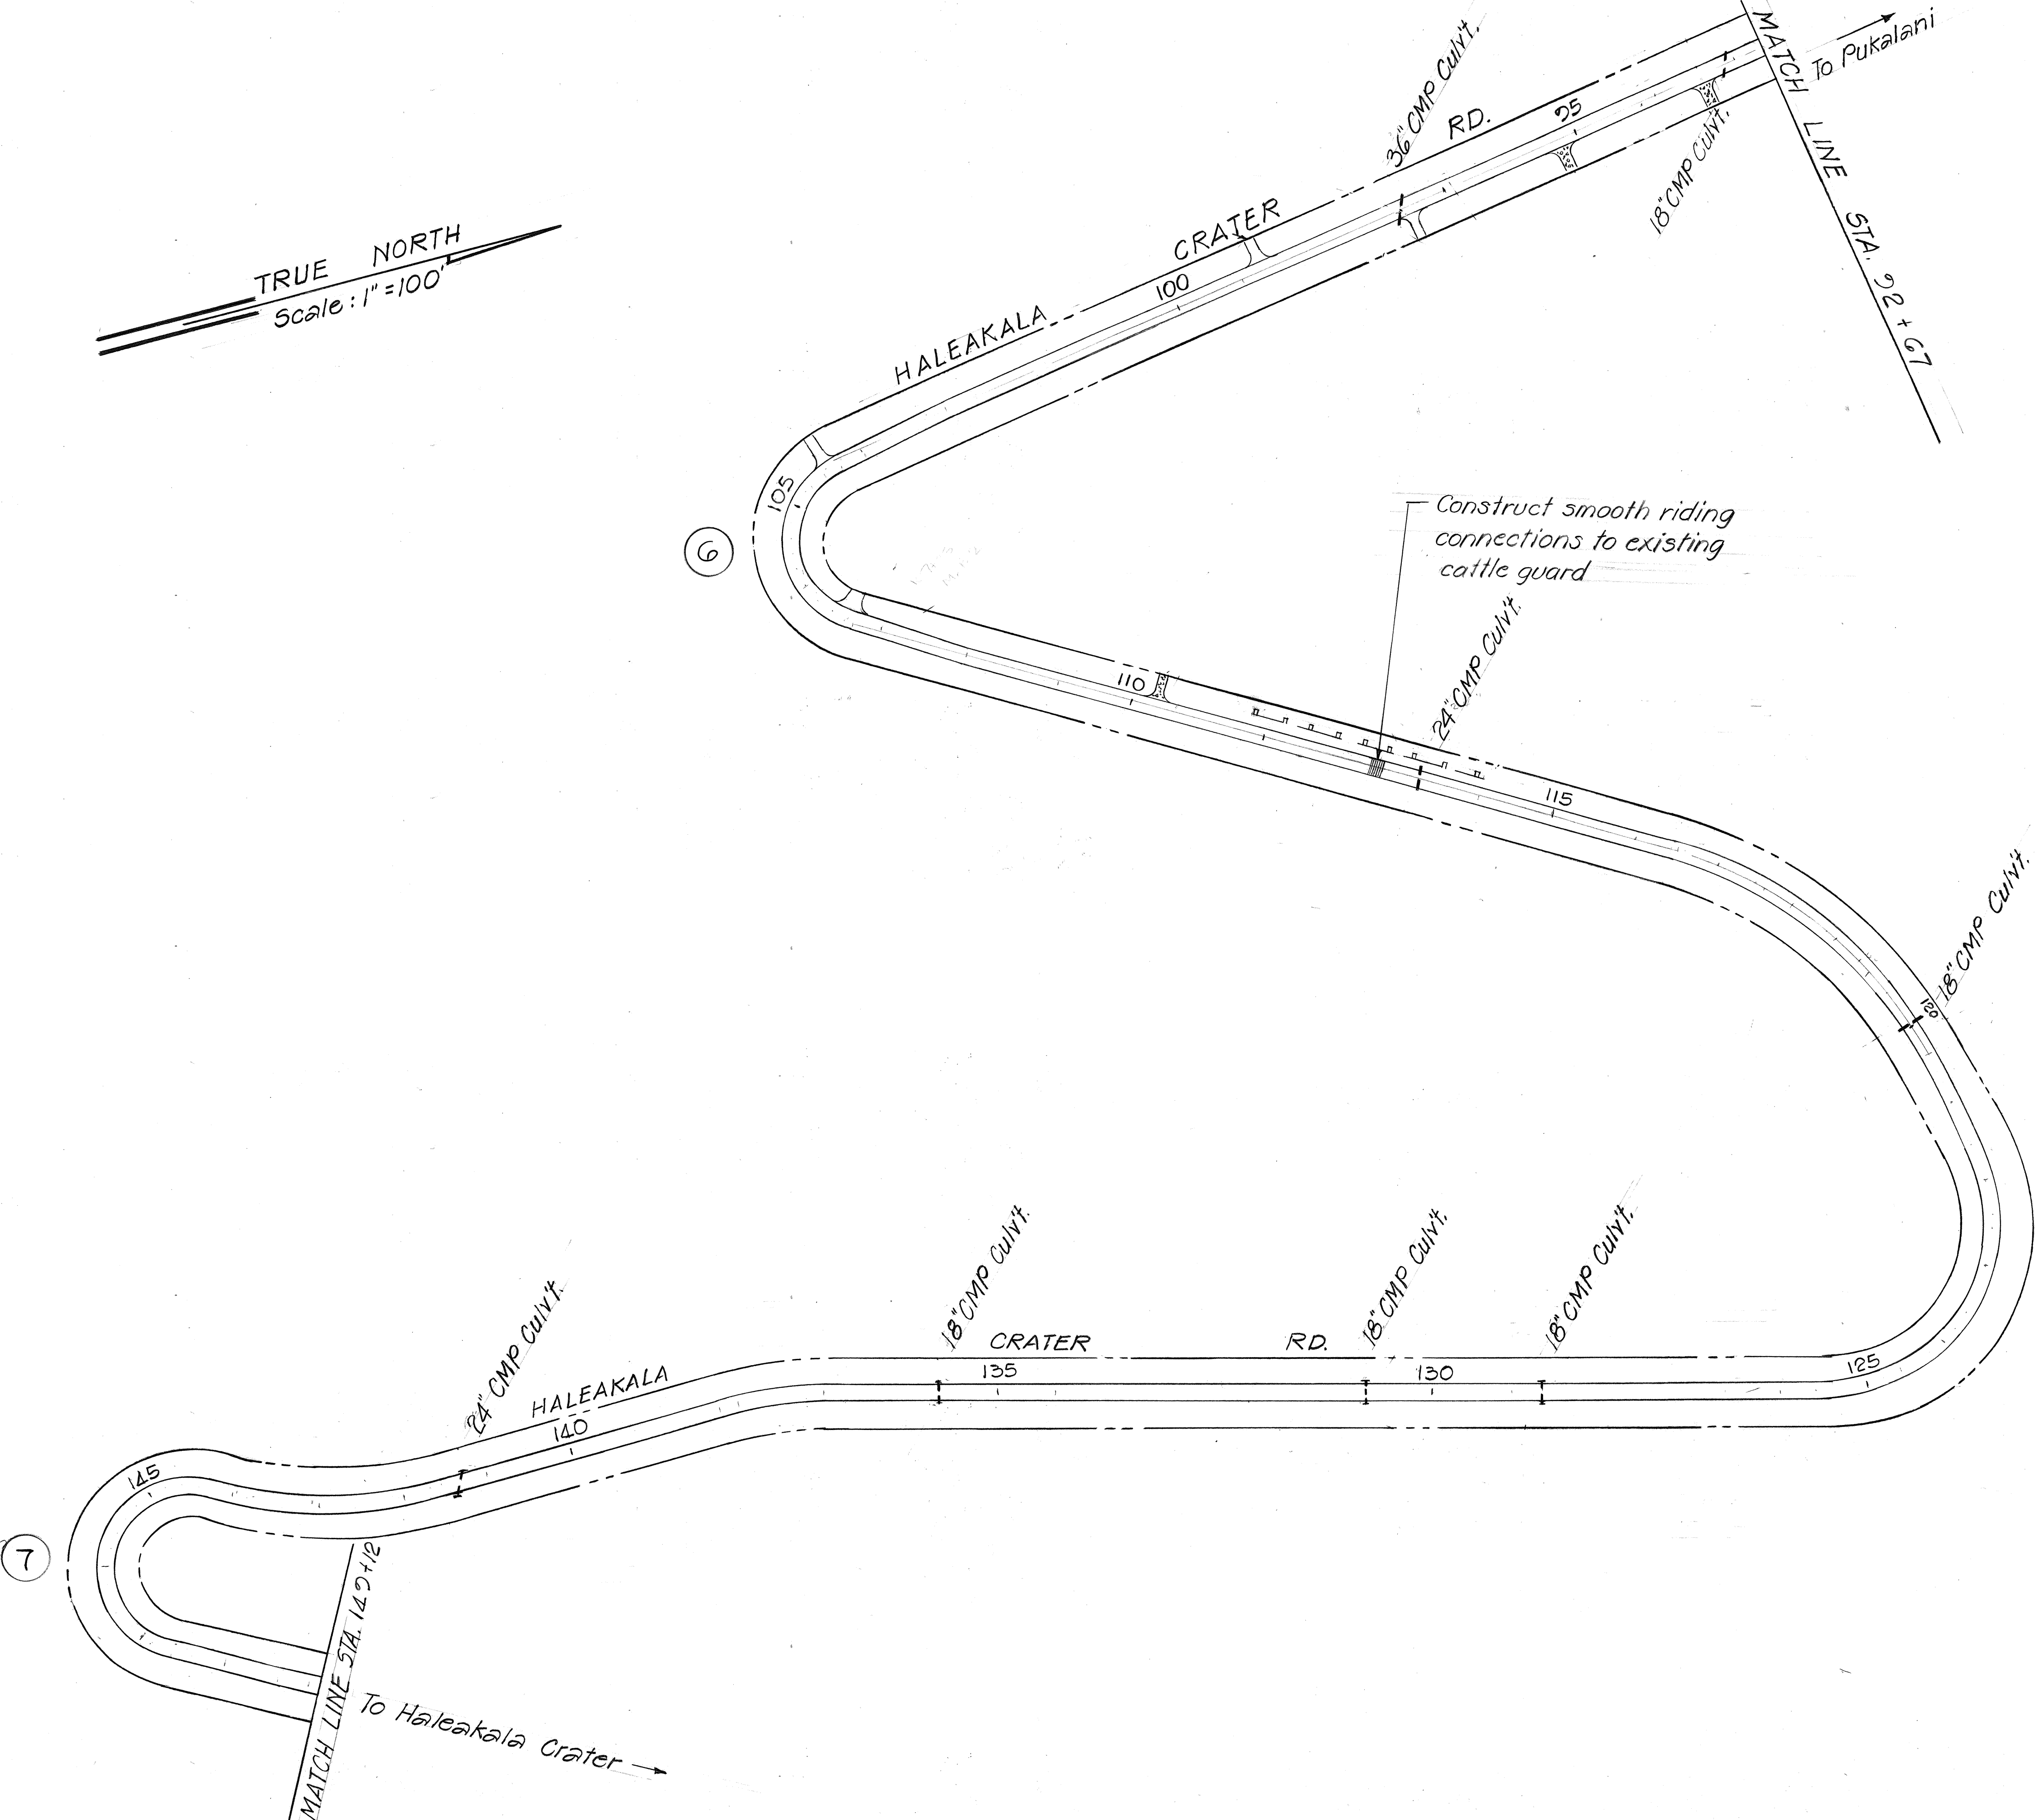


ORIGINAL PLAN	SURVEY PLOTTED BY	DATE
NOTE BOOK	DRAWN BY	1/7/79
No.	DESIGNED BY	
	CHECKED BY	

STATE OF HAWAII
DEPARTMENT OF TRANSPORTATION
LAND TRANSPORTATION FACILITIES DIVISION

PLANS

HALEAKALA CRATER ROAD
RESURFACING
PROJ. NO. 378A-01-82M
SCALE: 1" = 100' SEP. 1981
SHEET NO. 2 OF 7 SHEETS

FED. ROAD DIST. NO.	STATE	PROJ. NO.	FISCAL YEAR	SHEET NO.	TOTAL SHEETS
HAWAII	HAW.	378A-01-82M 385C-01-82M	1982	5	11

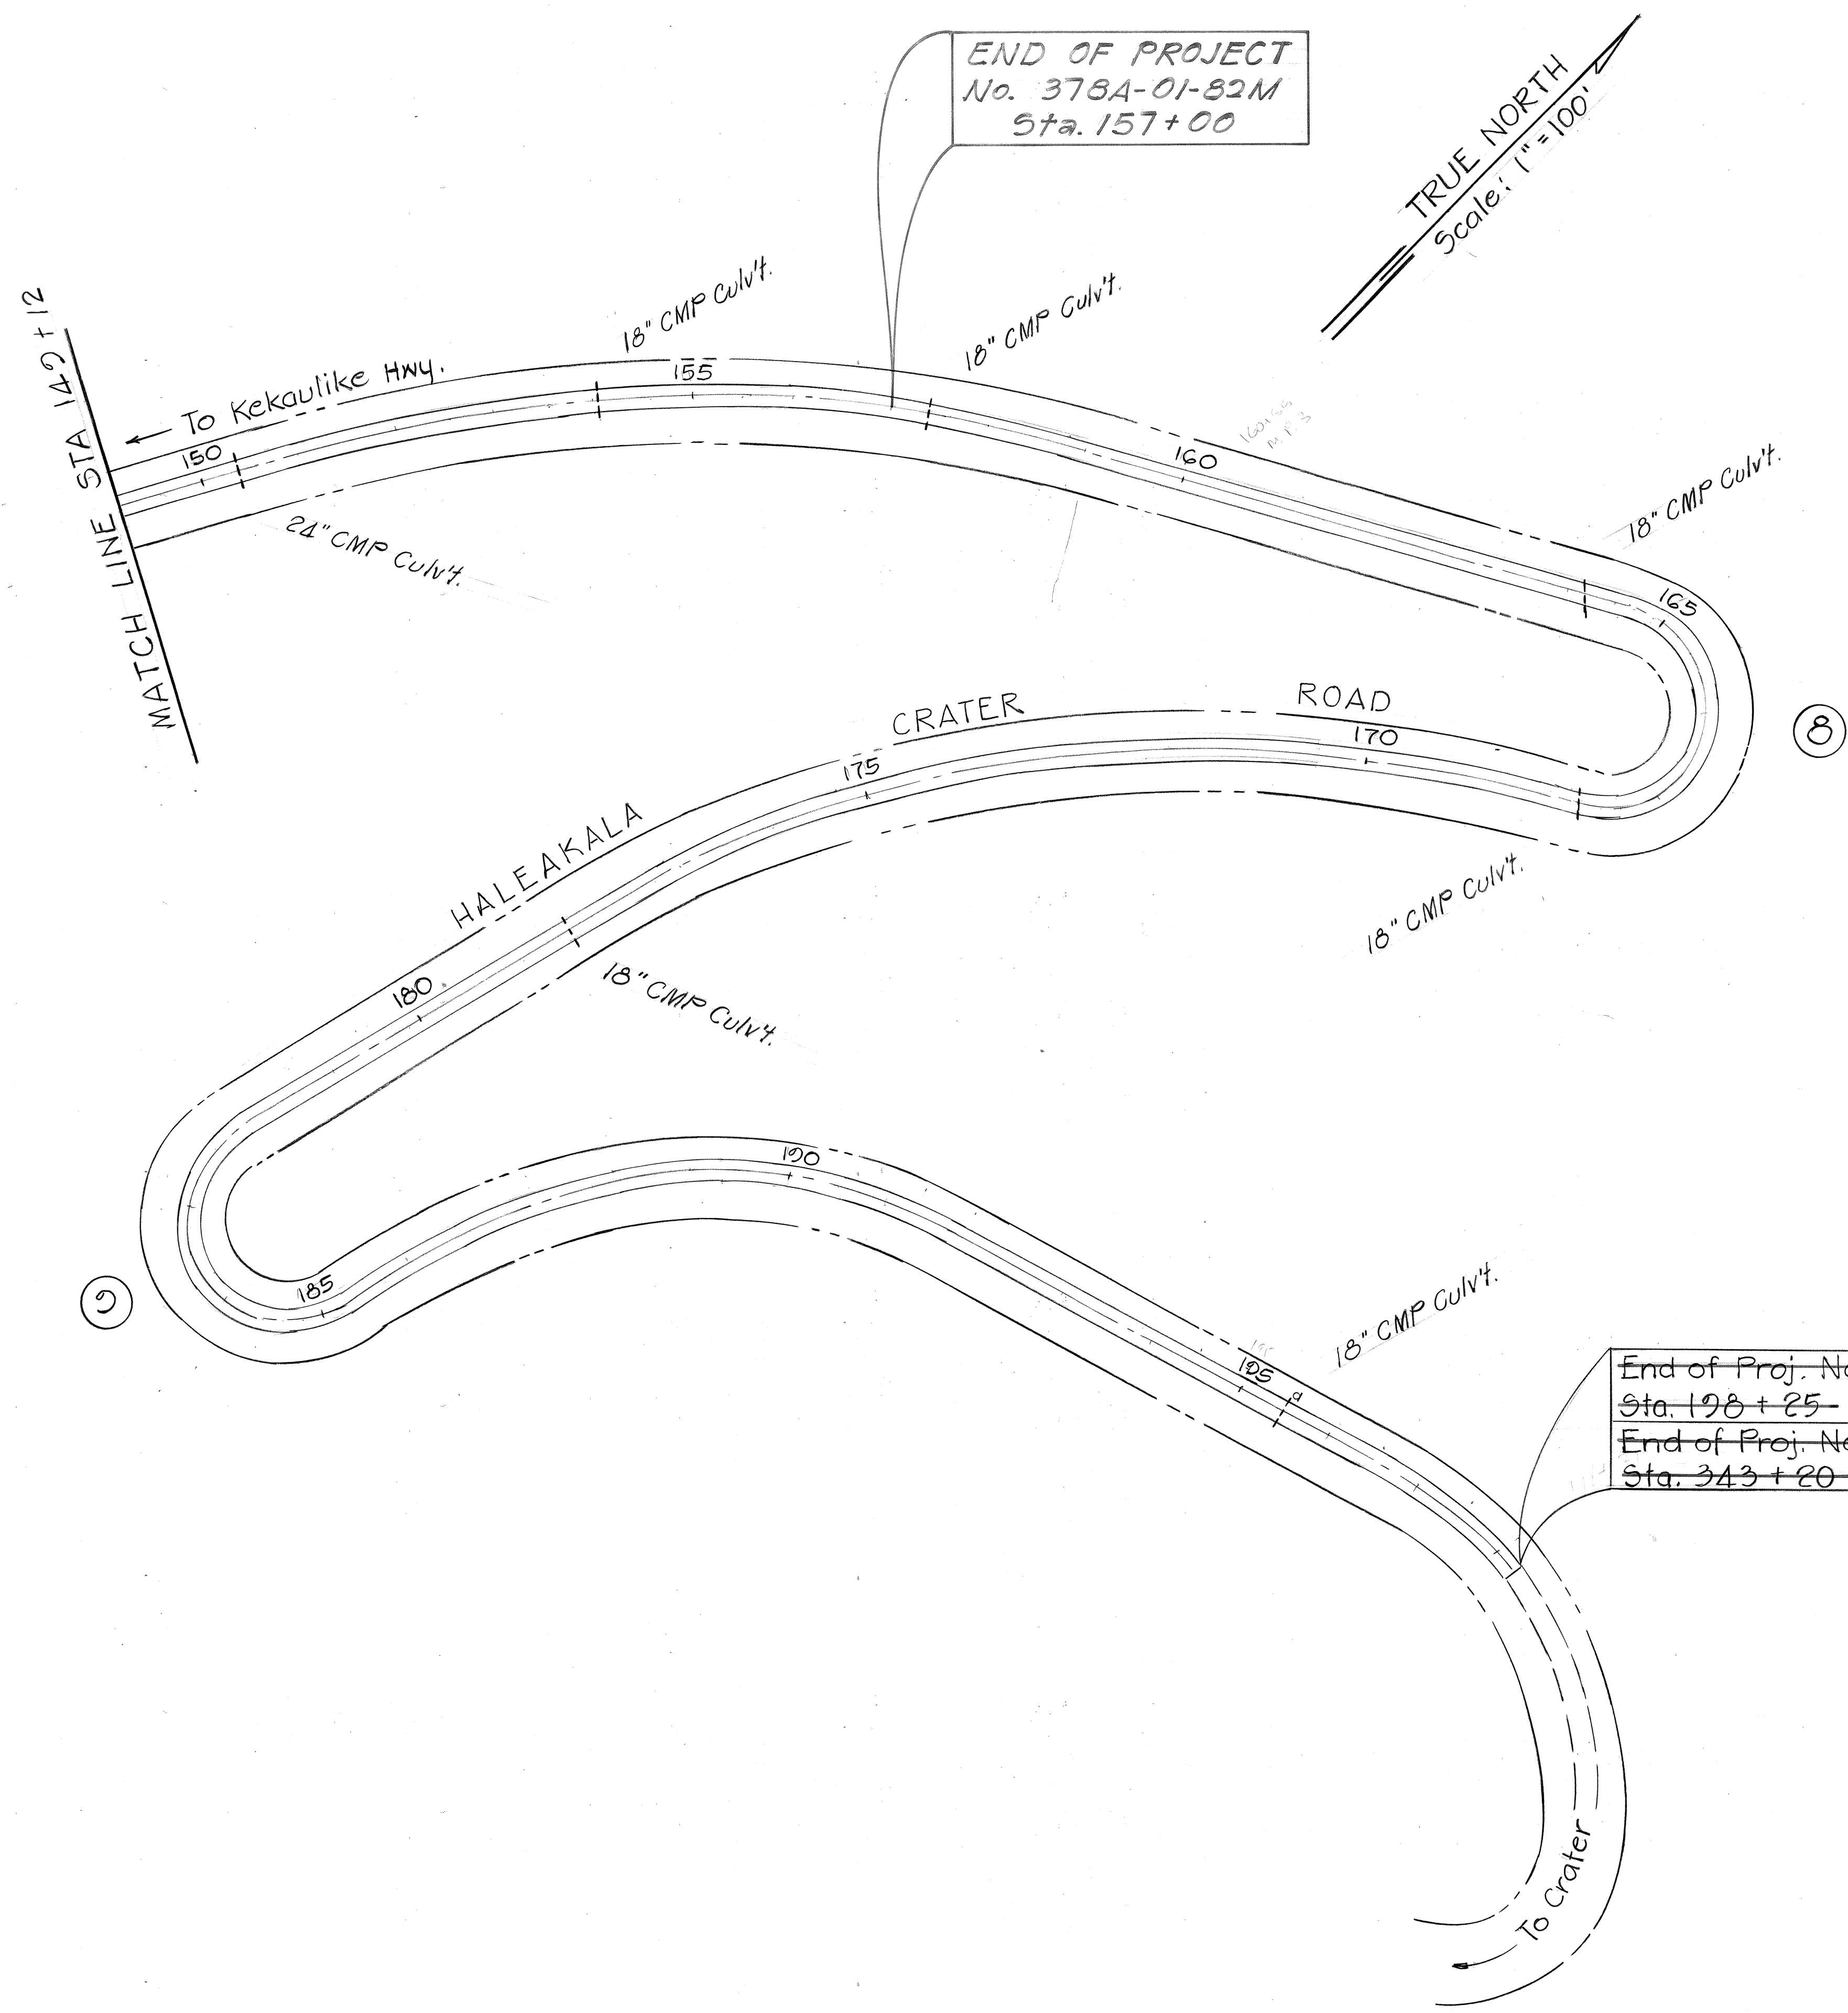



ORIGINAL PLAN	SURVEY PLOTTED BY	DATE
NOTE BOOK	DRAWN BY	" 1979
No.	DESIGNED BY	"
	QUANTITIES BY	"
	CHECKED BY	"

STATE OF HAWAII
DEPARTMENT OF TRANSPORTATION
LAND TRANSPORTATION FACILITIES DIVISION

PLAN
HALEAKALA CRATER ROAD
RESURFACING
PROJ. No. 378A-01-82M
SCALE: 1"=100' SEP. 1981
SHEET No. 3 OF 7 SHEETS

FED. ROAD DIST. NO.	STATE	PROJ. NO.	FISCAL YEAR	SHEET NO.	TOTAL SHEETS
HAWAII	HAW.	378A-01-82M 36BC-01-82M	1982	6	11

TRUE NORTH
Scale: 1"=100'

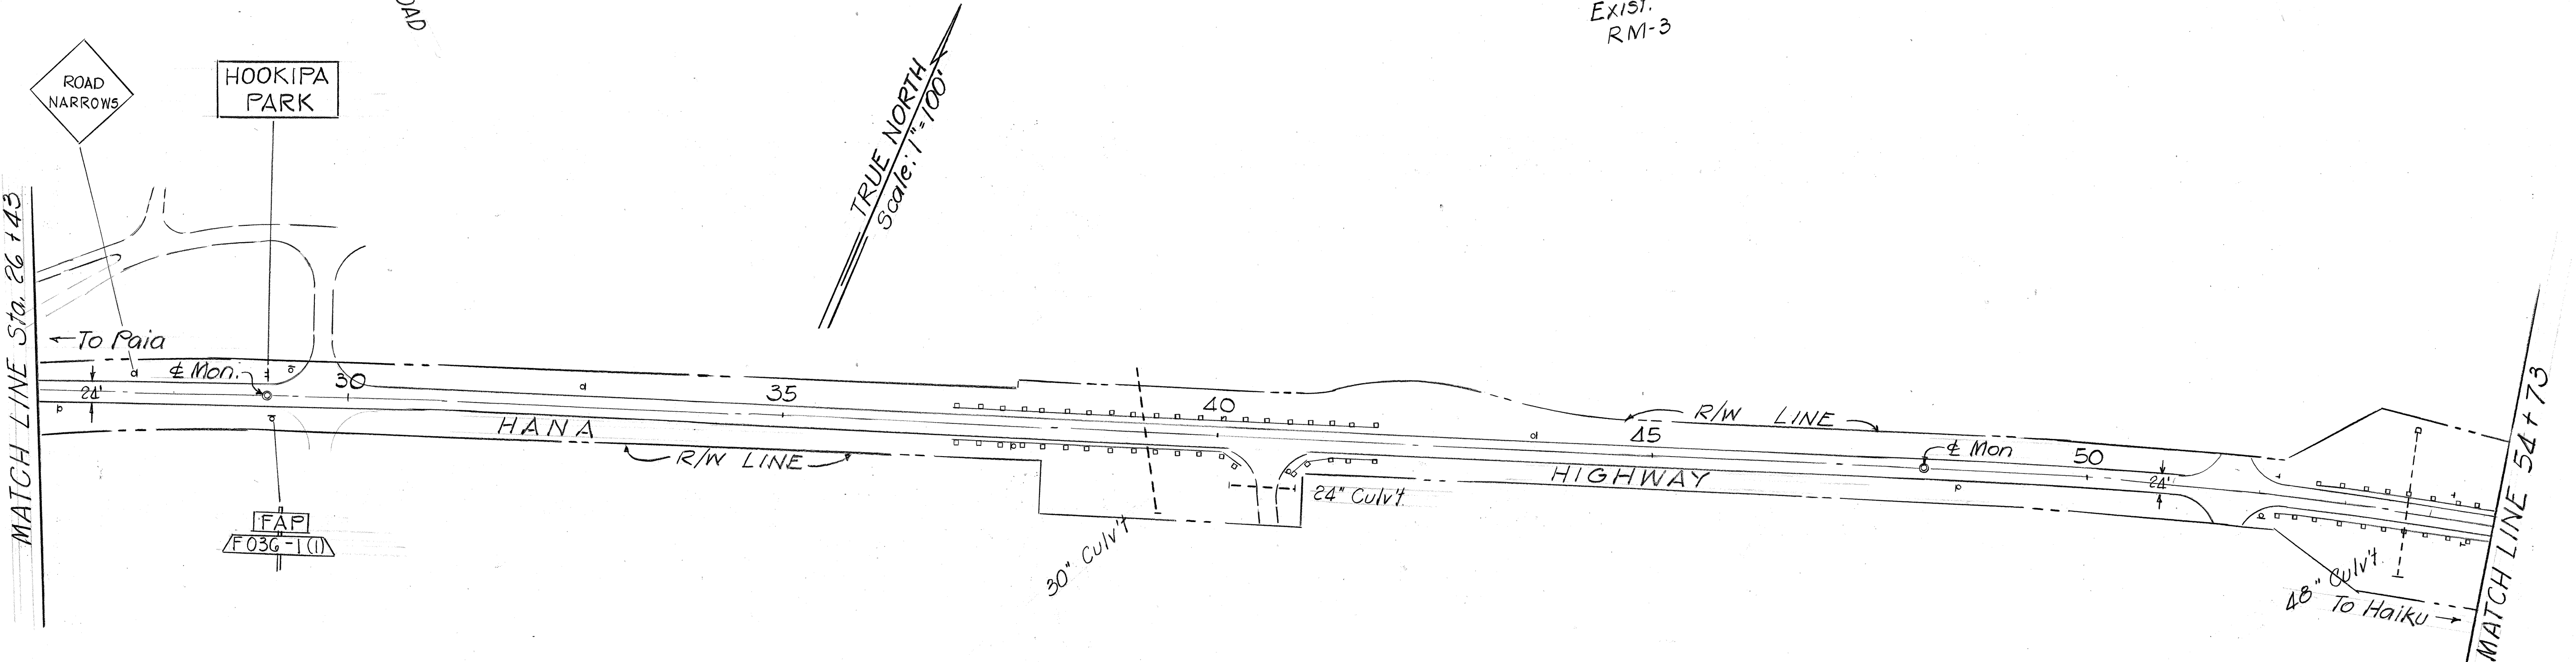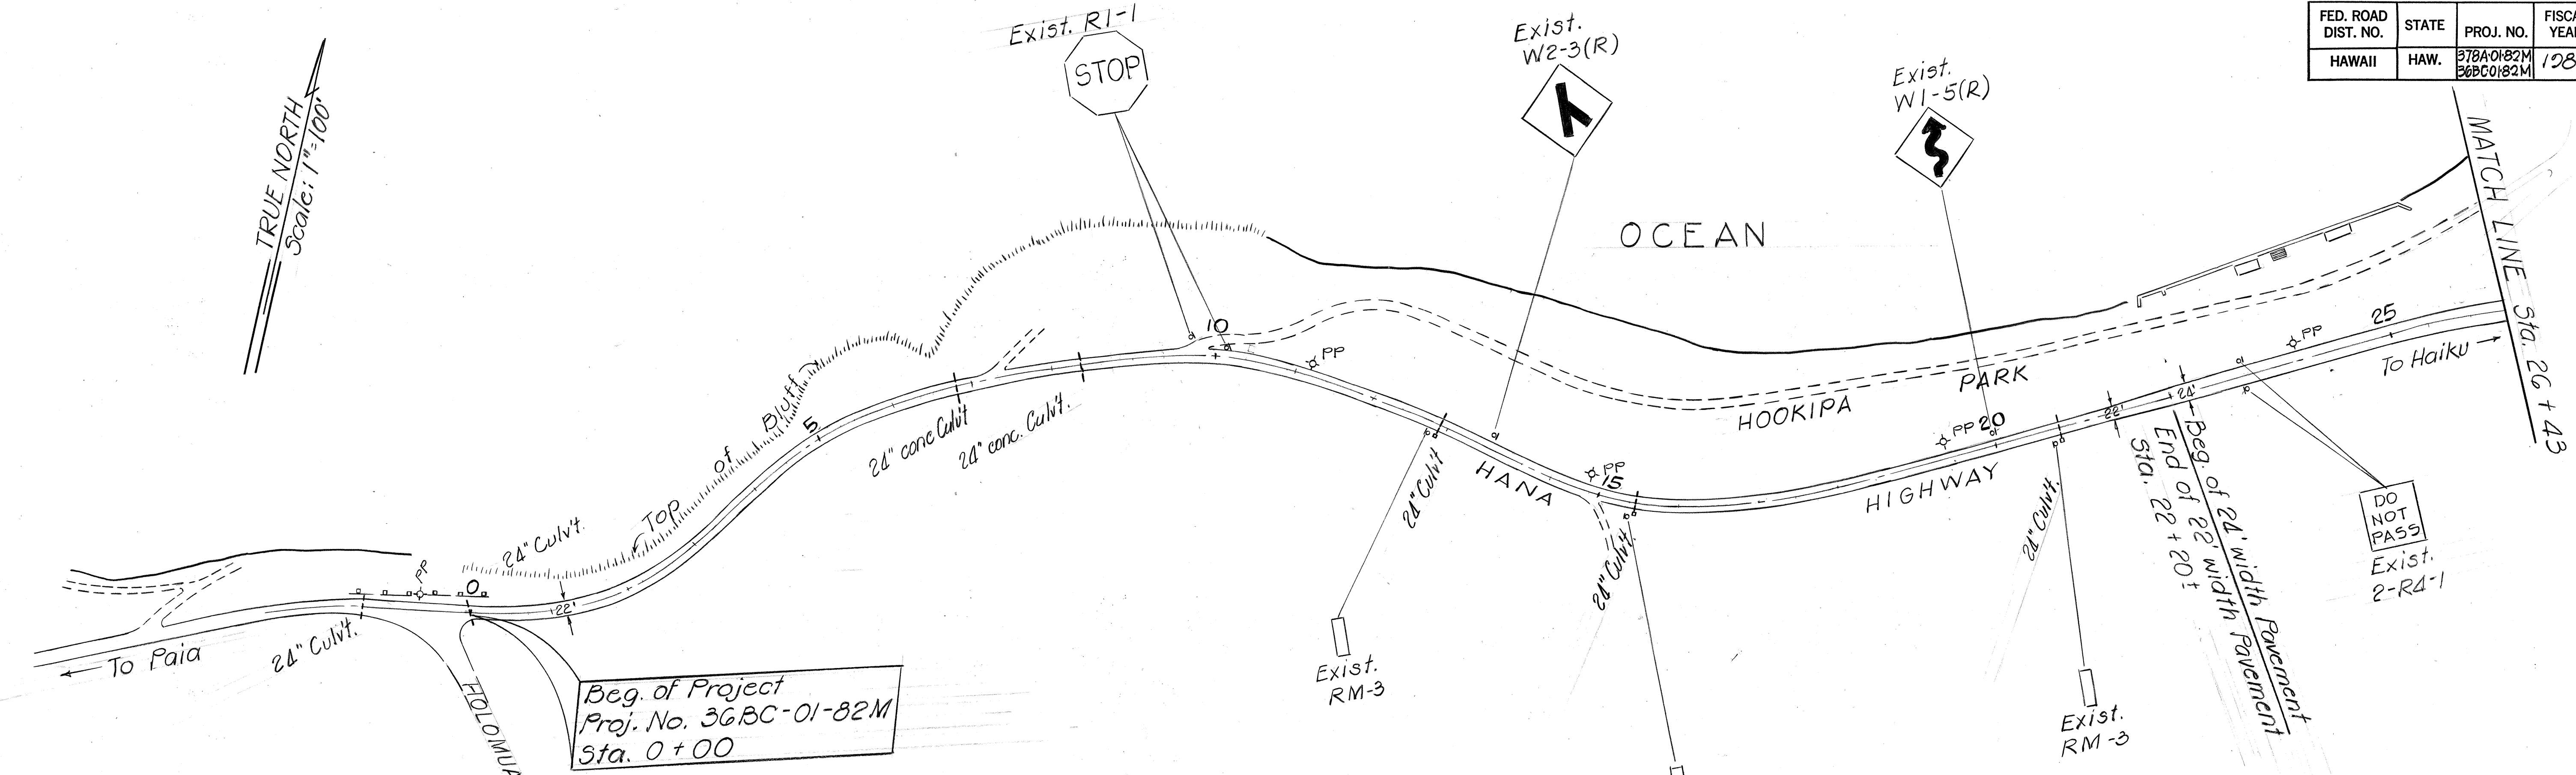

STATE OF HAWAII
DEPARTMENT OF TRANSPORTATION
LAND TRANSPORTATION FACILITIES DIVISION


PLAN

HANA HIGHWAY RESURFACING
Holomua Road twd Haiku Road
PROJ. No. 36BC-01-82M
SCALE: 1"=100' SEP. 1981
SHEET No. 4 OF 7 SHEETS

ORIGINAL PLAN	DATE
SURVEY PLOTTED BY	7/81
DRAWN BY	O. W. K.
DESIGNED BY	
QUANTITIES BY	
CHECKED BY	

FED. ROAD DIST. NO.	STATE	PROJ. NO.	FISCAL YEAR	SHEET NO.	TOTAL SHEETS
HAWAII	HAW.	378A-0182M 36BC-0182M	1982	7	11


ORIGINAL PLAN	SURVEY PLOTTED BY	DATE
NOTE BOOK	DRAWN BY	7/81
	DESIGNED BY	
	QUANTITIES BY	
	CHECKED BY	

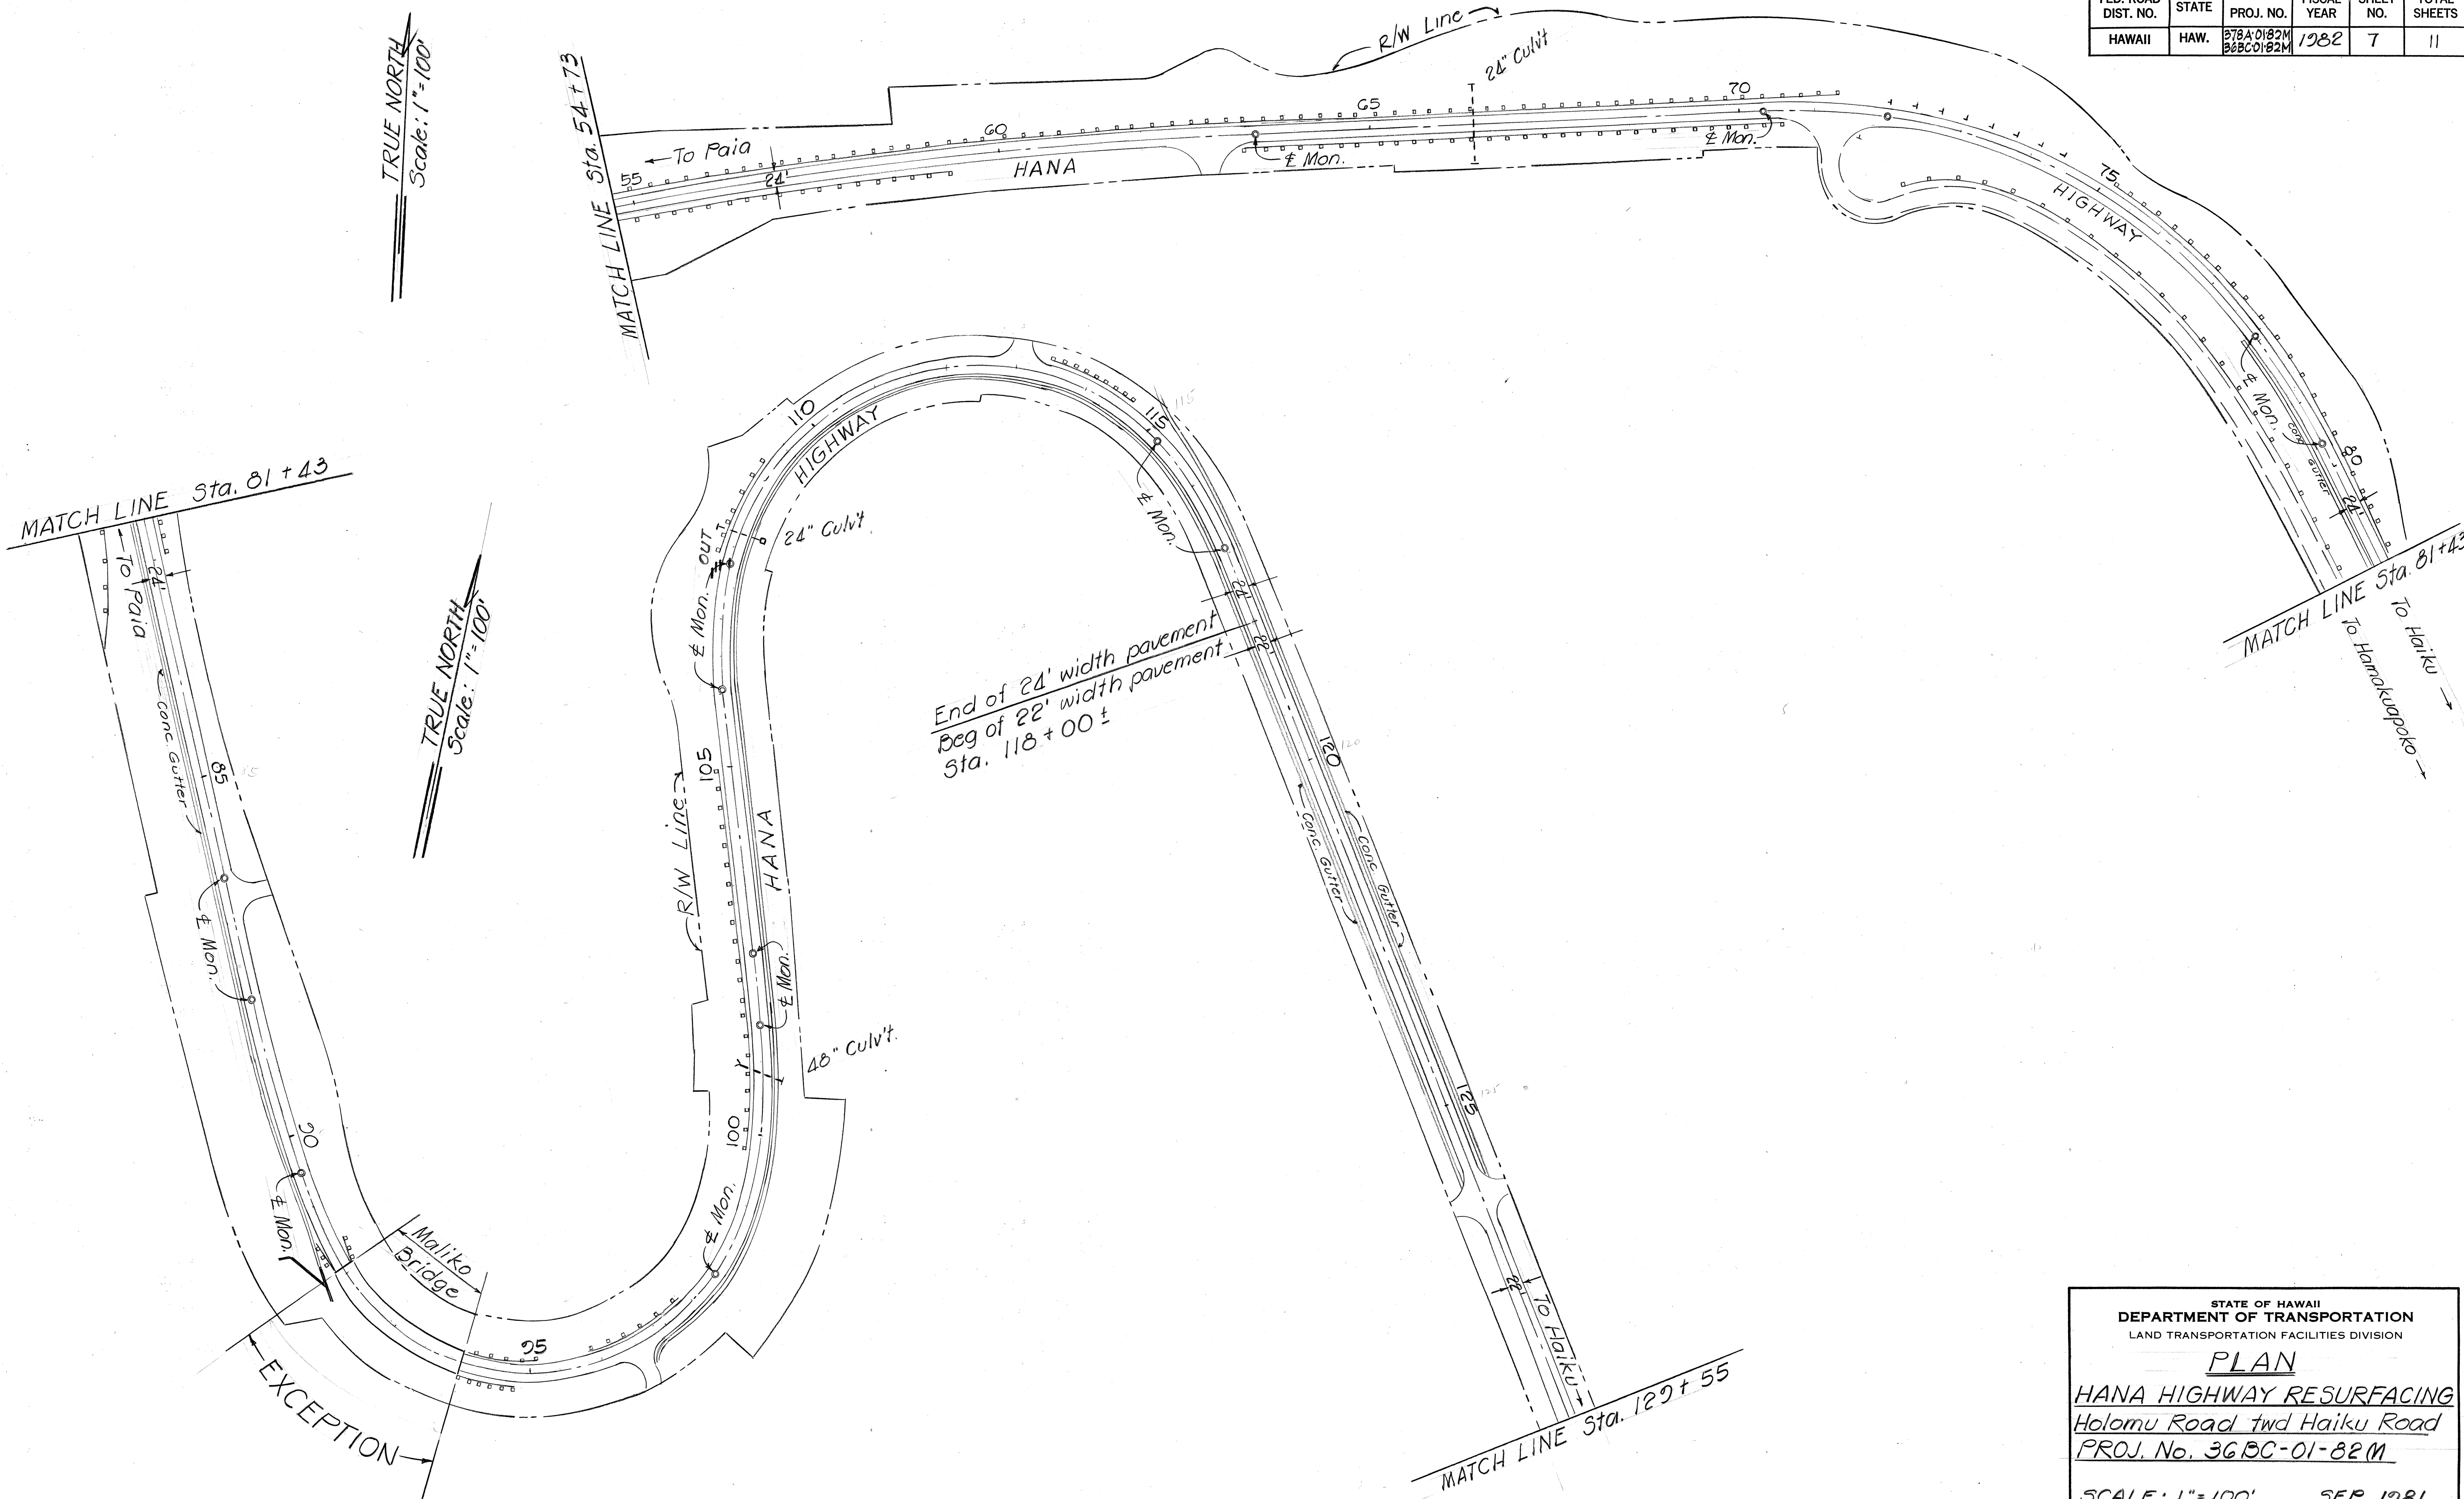


STATE OF HAWAII
DEPARTMENT OF TRANSPORTATION
LAND TRANSPORTATION FACILITIES DIVISION

PLAN
HANA HIGHWAY RESURFACING
Holomu Road twd Haiku Road
PROJ. No. 36BC-01-82M
SCALE: 1"=100' SEP. 1981
SHEET No. 5 OF 7 SHEETS

FED. ROAD DIST. NO.	STATE	PROJ. NO.	FISCAL YEAR	SHEET NO.	TOTAL SHEETS
HAWAII	HAW.	378A0182M 388C0182M	1982	8	11

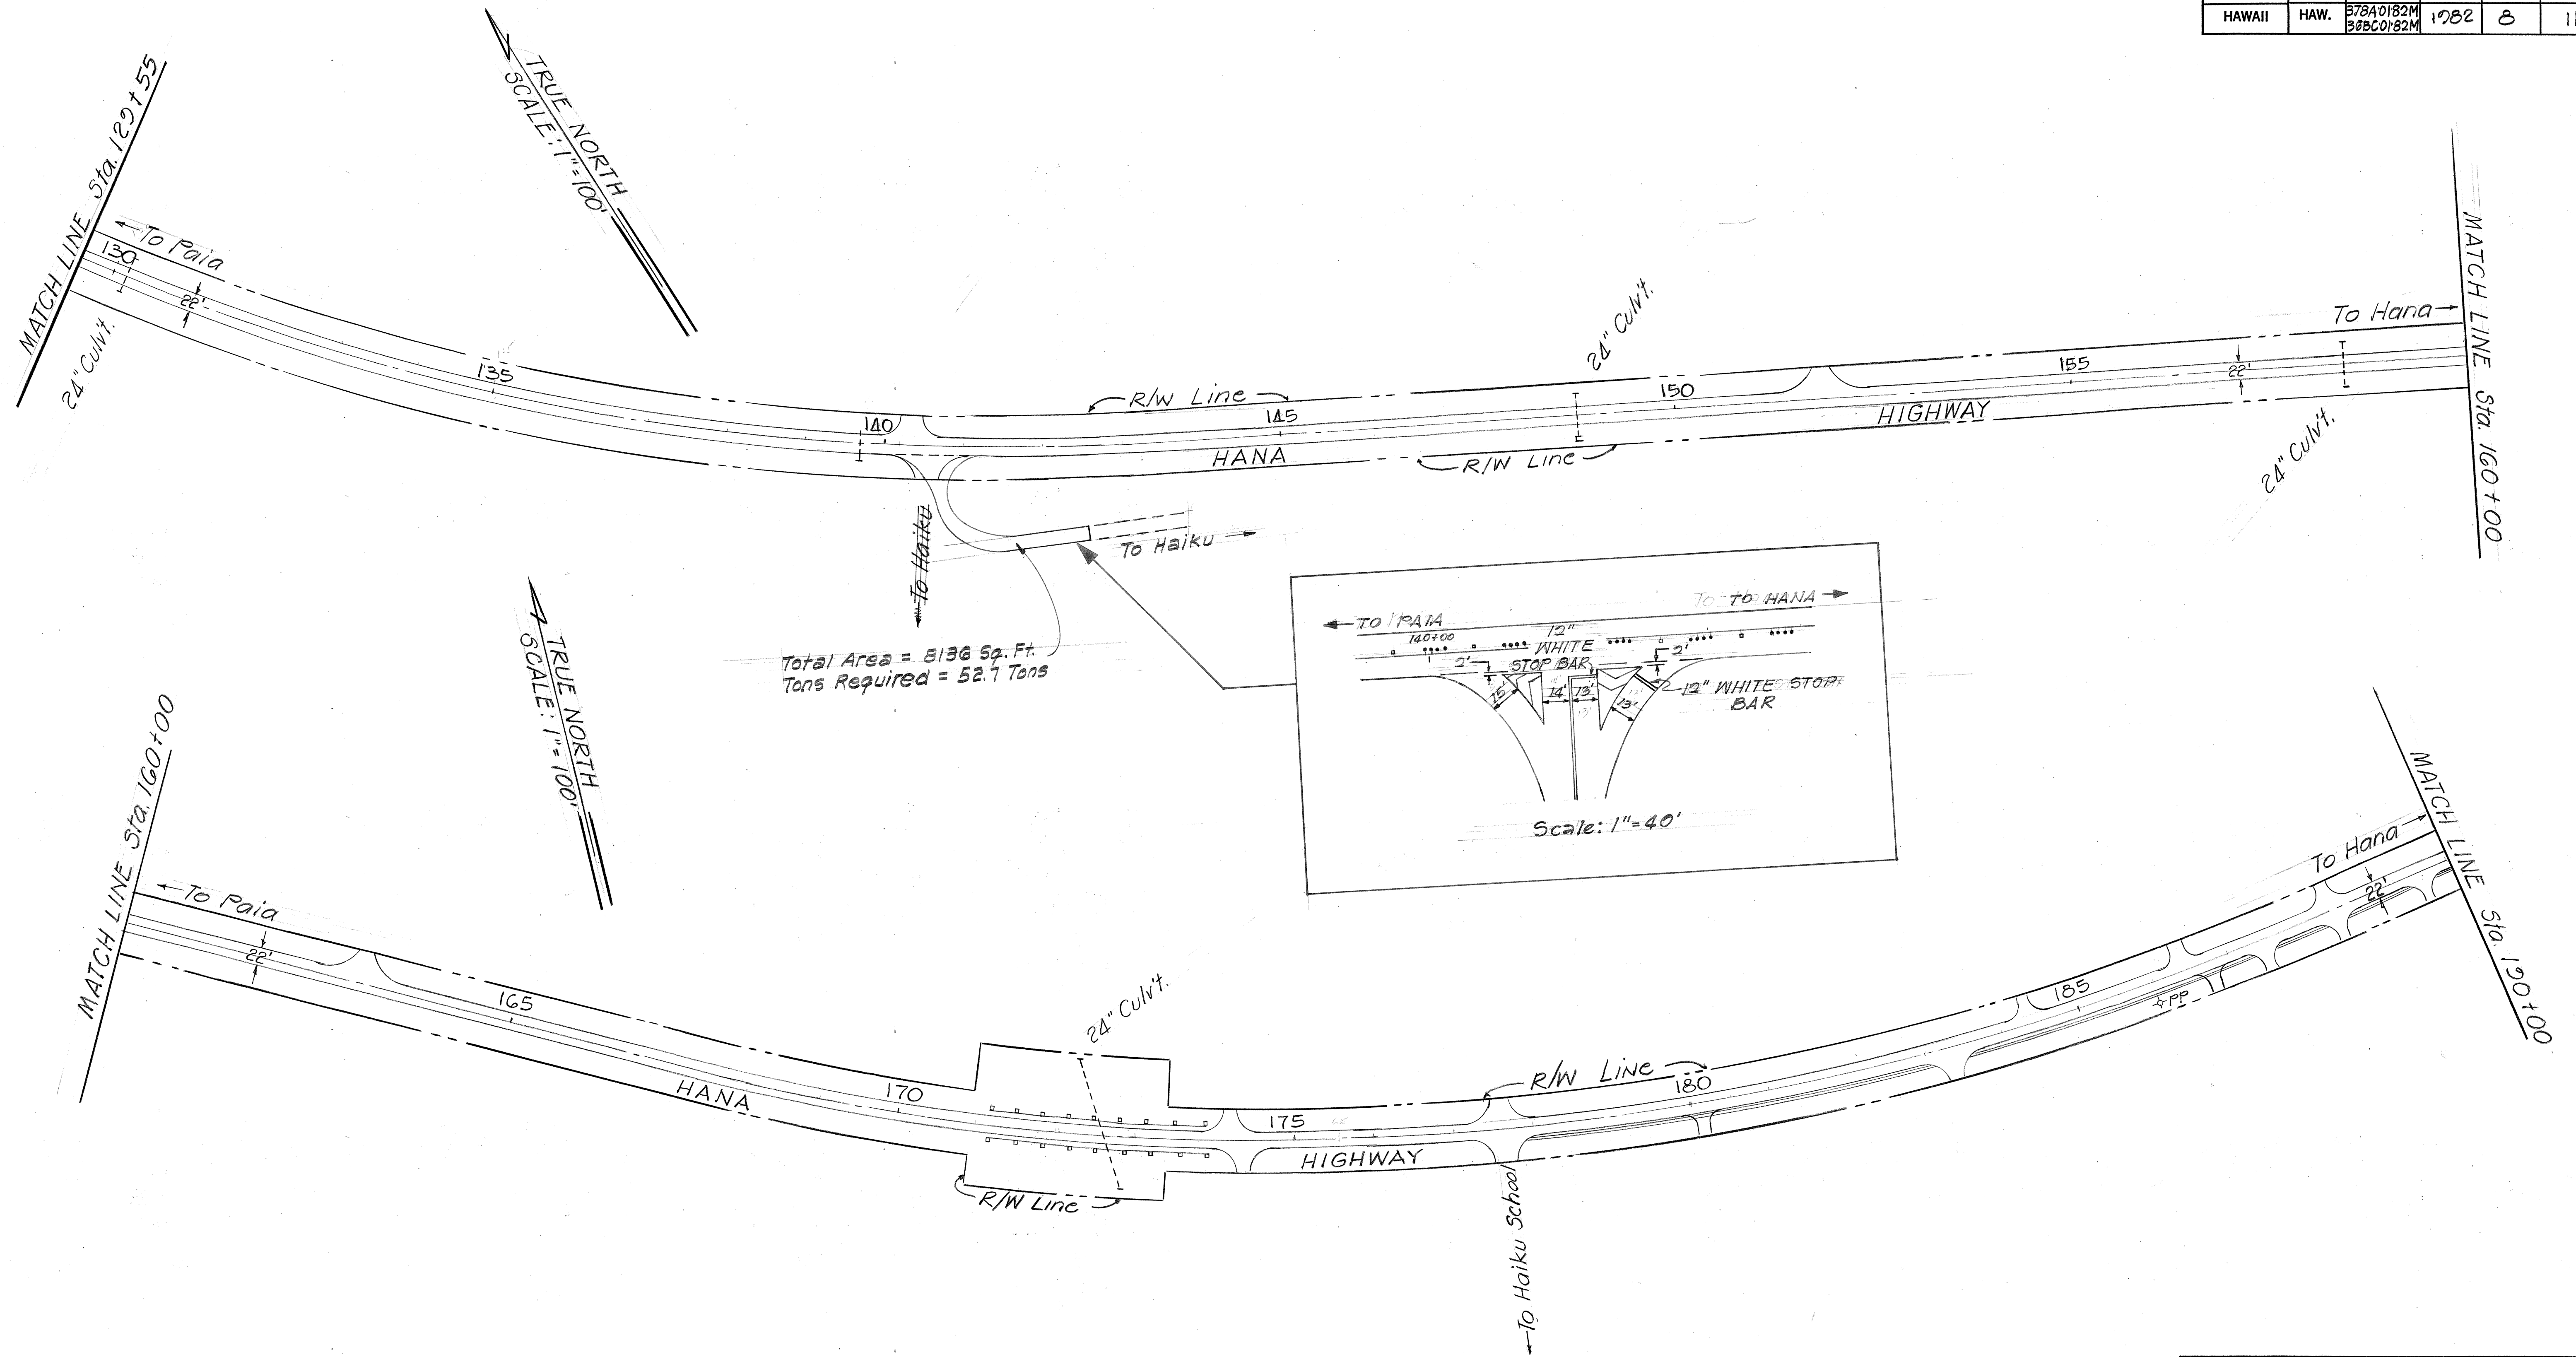

Total Area = 8136 Sq. Ft.
Tons Required = 52.7 Tons

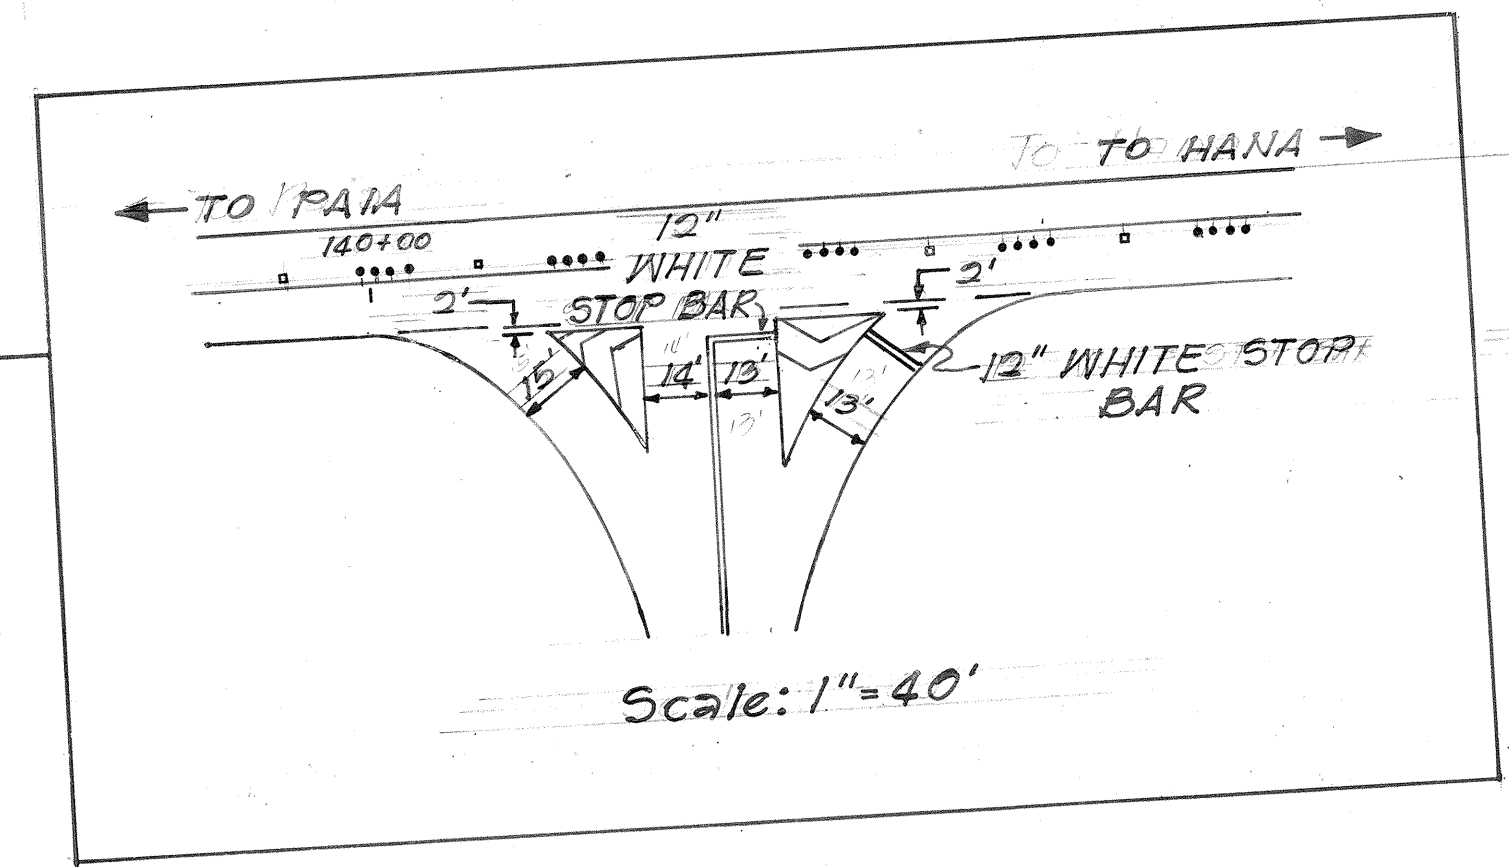


ORIGINAL PLAN	SURVEY PLOTTED BY	DATE
NOTE BOOK	DRAWN BY	7/81
No.	DESIGNED BY	
	CHECKED BY	

STATE OF HAWAII
DEPARTMENT OF TRANSPORTATION
LAND TRANSPORTATION FACILITIES DIVISION

PLAN

HANA HIGHWAY RESURFACING
Holomu Road fwd Haiku Road
PROJ. No. 388C-01-82M
SCALE: 1"=100' SEP. 1981
SHEET NO. 8 OF 7 SHEETS

FED. ROAD DIST. NO.	STATE	PROJ. NO.	FISCAL YEAR	SHEET NO.	TOTAL SHEETS
HAWAII	HAW.	378A0182M 36BC0182M	1982	7	11

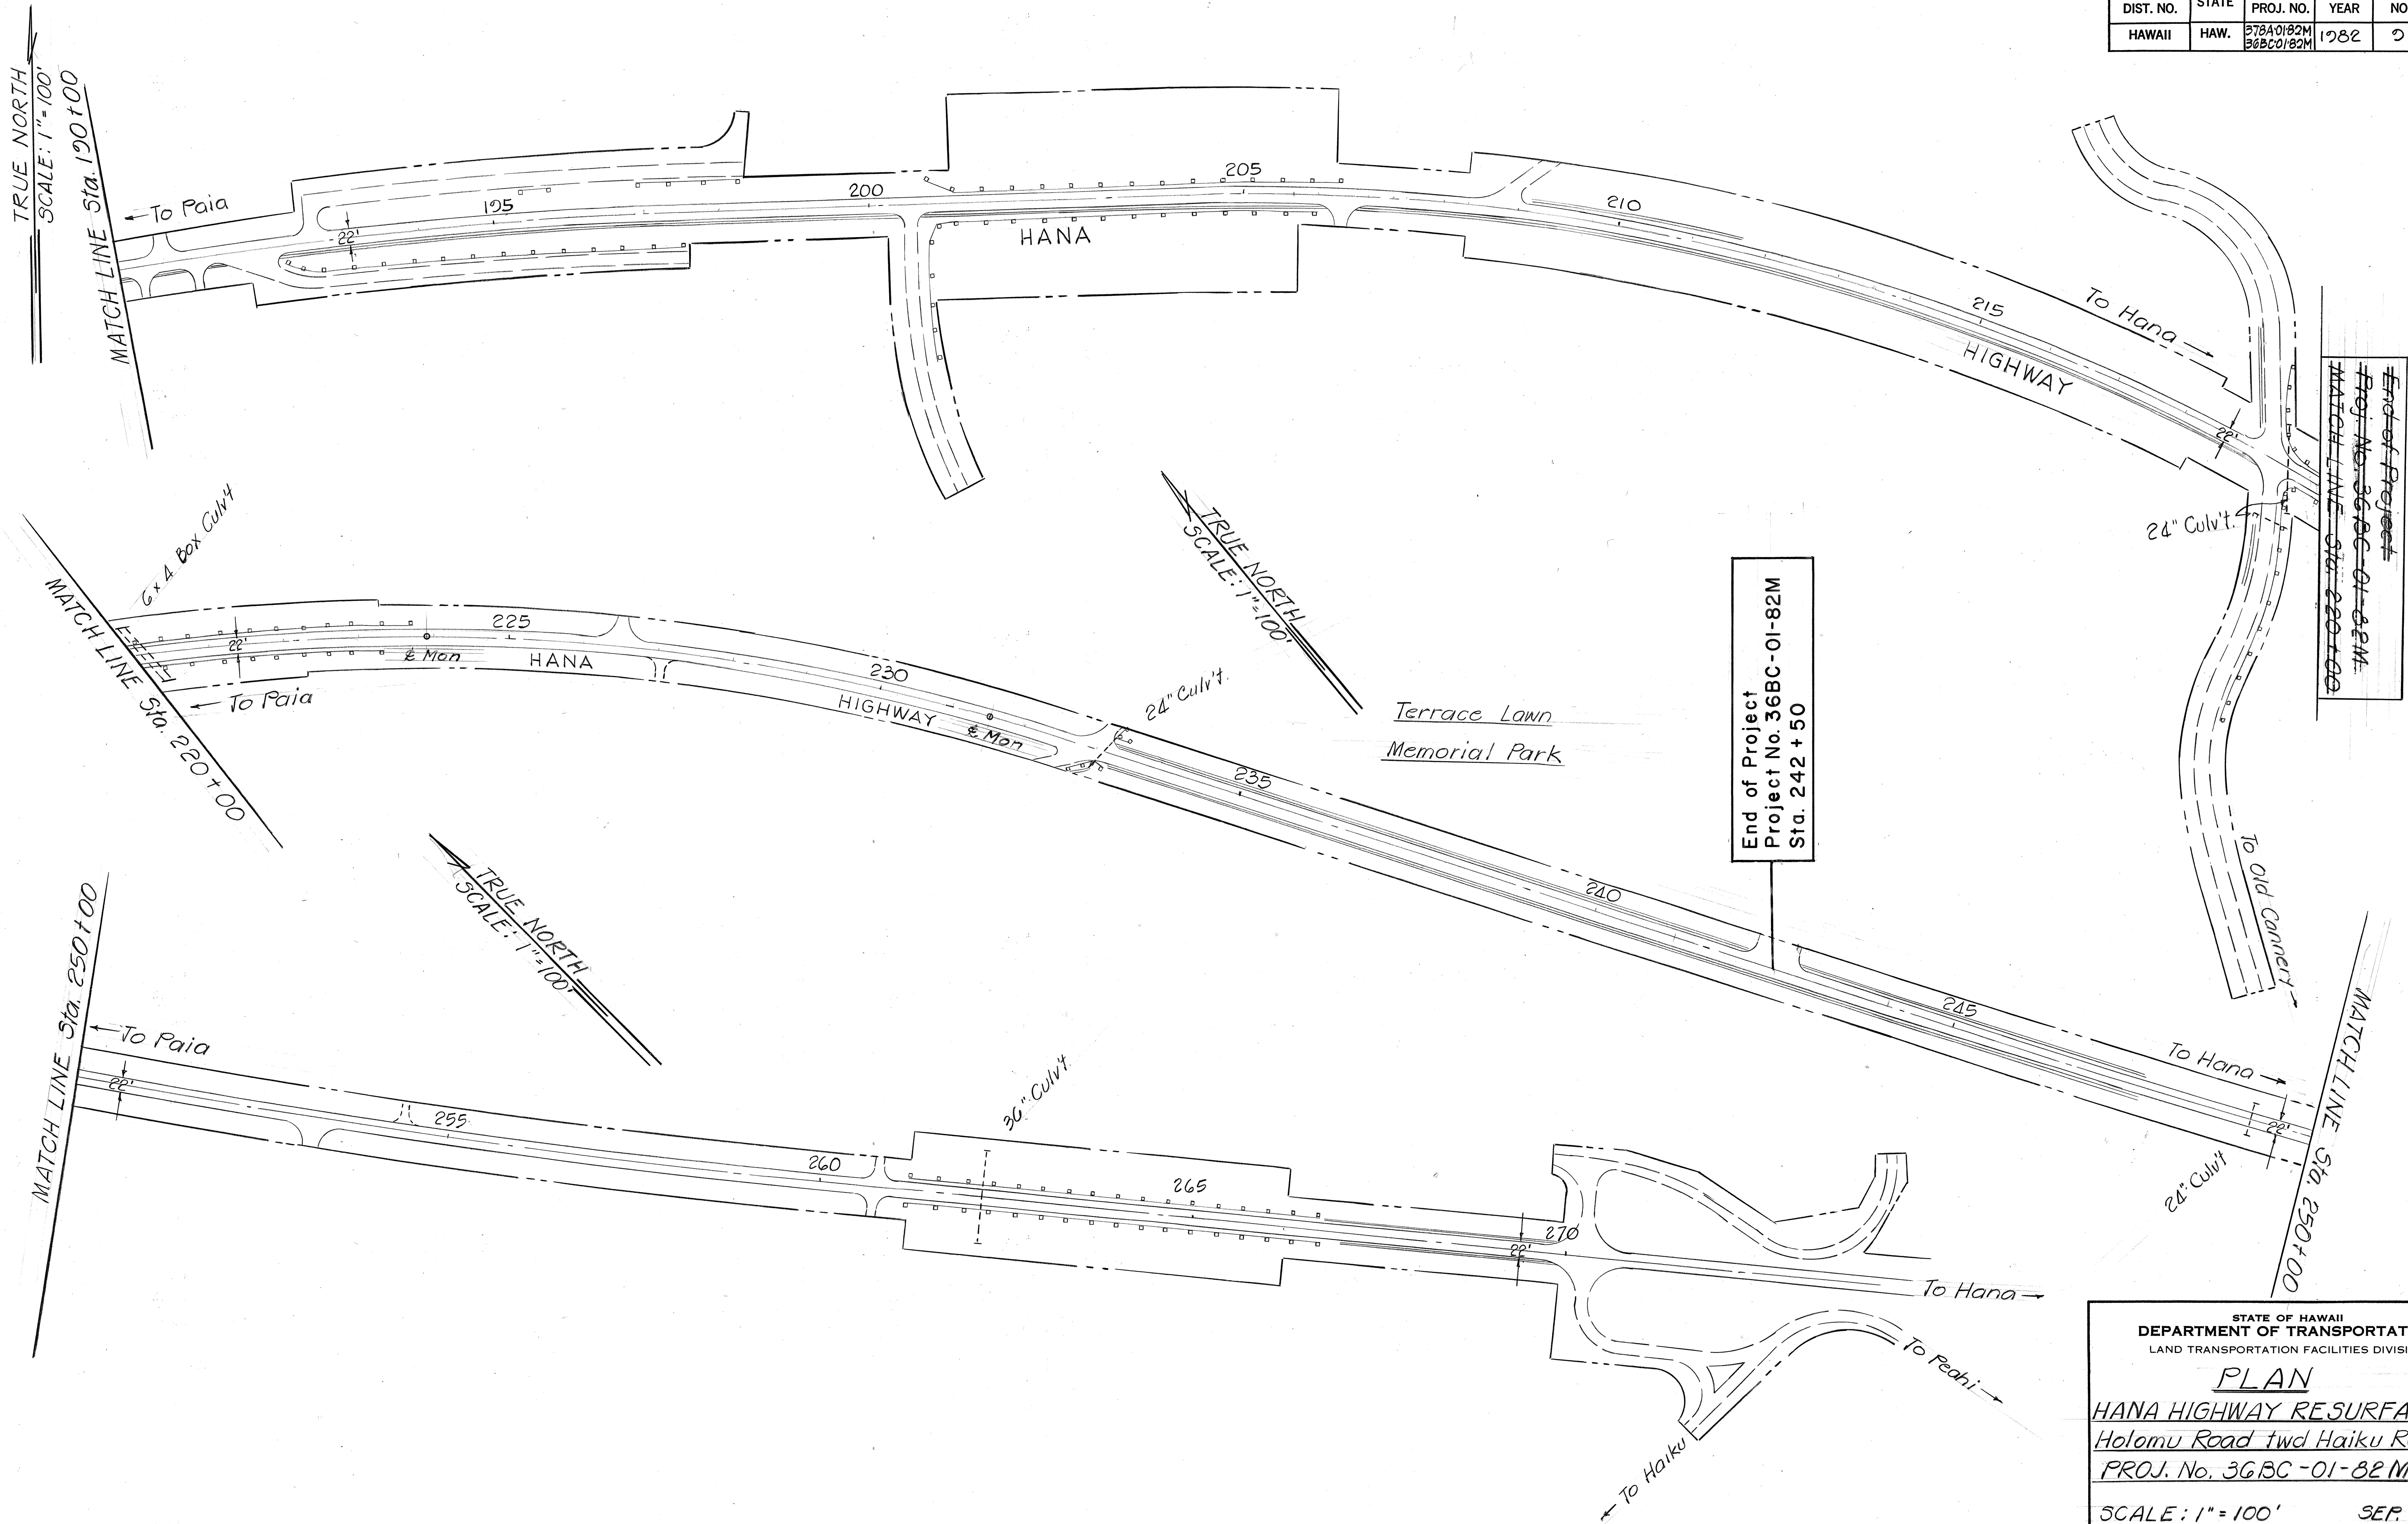

ORIGINAL PLAN	SURVEY PLOTTED BY	DATE
NOTE BOOK	DRAWN BY	" "
No.	TRACED BY	" "
	DESIGNED BY	" "
	QUANTITIES BY	" "
	CHECKED BY	" "

STATE OF HAWAII
DEPARTMENT OF TRANSPORTATION
LAND TRANSPORTATION FACILITIES DIVISION

PLAN
HANA HIGHWAY RESURFACING
Holomu Road twd Haiku Road
PROJ. No. 36BC-01-82M
SCALE: 1"=100' SEP. 1981
SHEET No. 7 OF 7 SHEETS