	INDEX TO DRAWINGS
SHEET NO.	DESCRIPTION
1	TITLE SHEET
2	DRAINAGE PLAN & DETAILS
,	,
	,
	;



STATE OF HAWAII

DEPARTMENT OF TRANSPORTATION


HIGHWAYS DIVISION

HONOLULU, HAWAII

PLANS FOR

HANA HIGHWAY DRAINAGE IMPROVEMENTS NEAR PAUWELA PROJECT NO. 36C-01-82


DISTRICT OF MAKAWAO
ISLAND OF MAUI

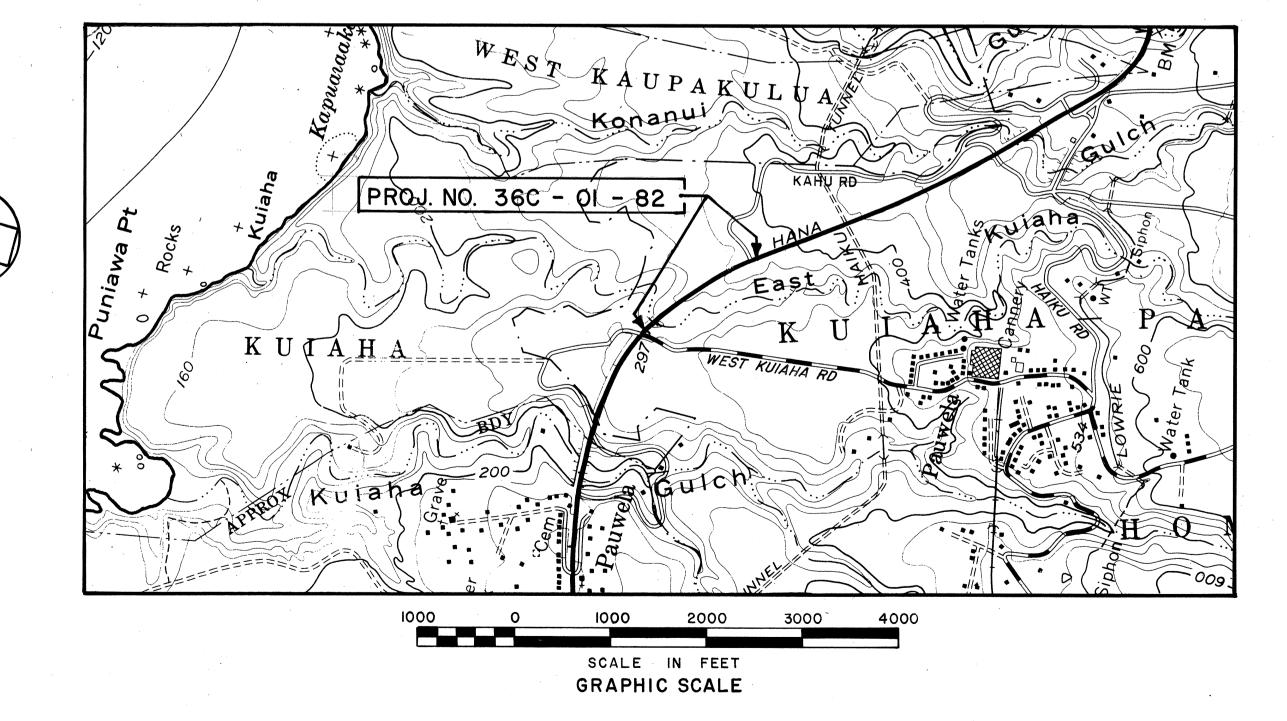

LAYOUT PLAN
LENGTH OF PROJECT 0.266 miles

FED. ROAD DIST. NO. STATE PROJ. NO. FISCAL SHEET NO. SHEETS

HAWAII HAW. 36C-01-82 1982 1 2

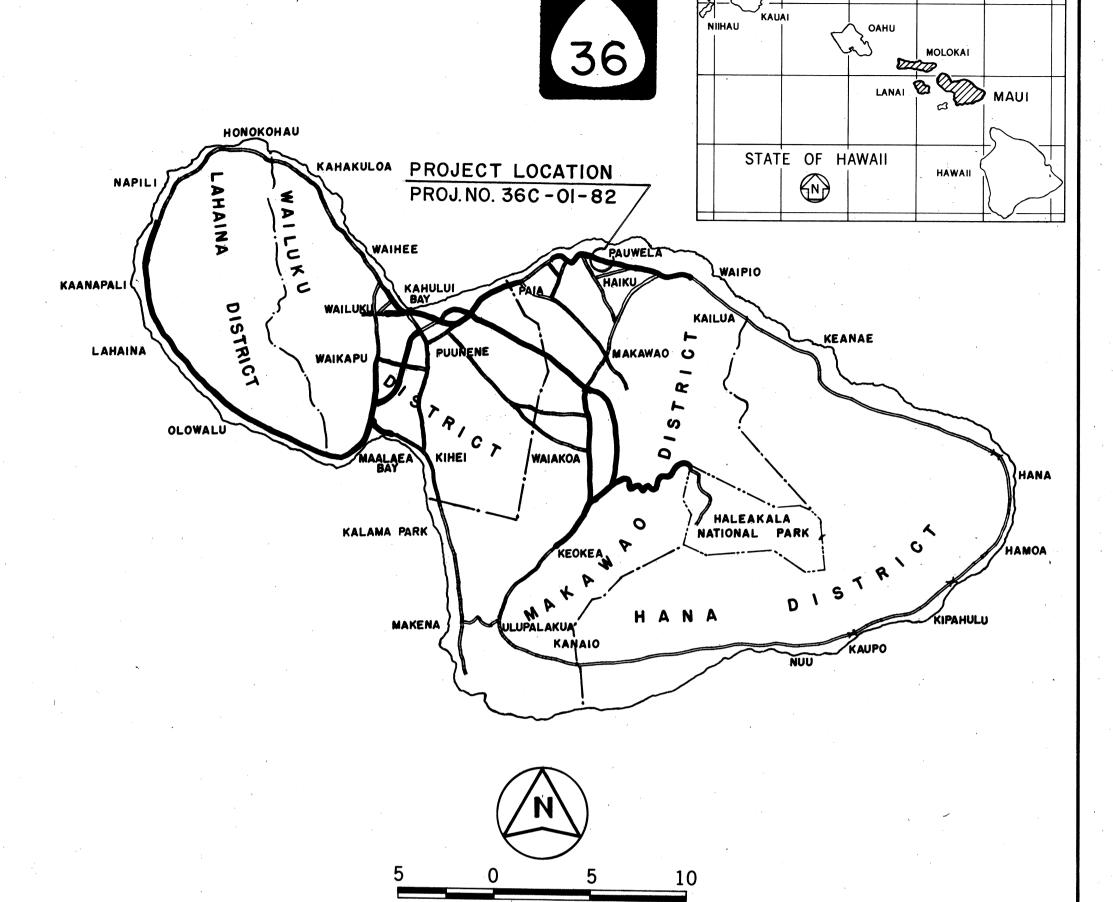

OR UNDER CONSTRUCTION

ALL CHANGES MADE DURING CONSTRUCTION HAVE BEEN INCORPORATED ON THESE PLANS IN RED EXCEPT CHANGES IN THE ORIGINAL THEORETICAL QUANTITIES. FOR ACTUAL QUANTITIES, REFER TO PROJECT LEDGER AND/OR COMPUTATION BOOK.

Jany & Bake 11/5/82
RESIDENT ENGINEER DAT

DEPARTMENT OF TRANSPORTATION
STATE OF HAWAII

APPROVED:

Carras 6/3/82

Finding Of Transportation Date