
	INDEX TO DRAWINGS
SHEET NO.	DESCRIPTION
I	TITLE SHEET
2	GENERAL NOTES, TYPICAL
	SECTIONS & DETAILS
3	MONUMENT, STRIPING, PAV'T.
	MARK'G. & G. RAIL SUMMARIES
4-14	PLANS
15	STANDARD PLANS SUMMARY

STATE OF HAWAII

DEPARTMENT OF TRANSPORTATION
HIGHWAYS DIVISION
HONOLULU, HAWAII
"AS-BUILT"
PLANS FOR

HANA HIGHWAY RESURFACING
VALLEY ISLE MEMORIAL
CEMETERY TO KAUPAKALUA ROAD
PROJECT NO. 36C-01-87M

DISTRICT OF MAKAWAO ISLAND OF MAUI

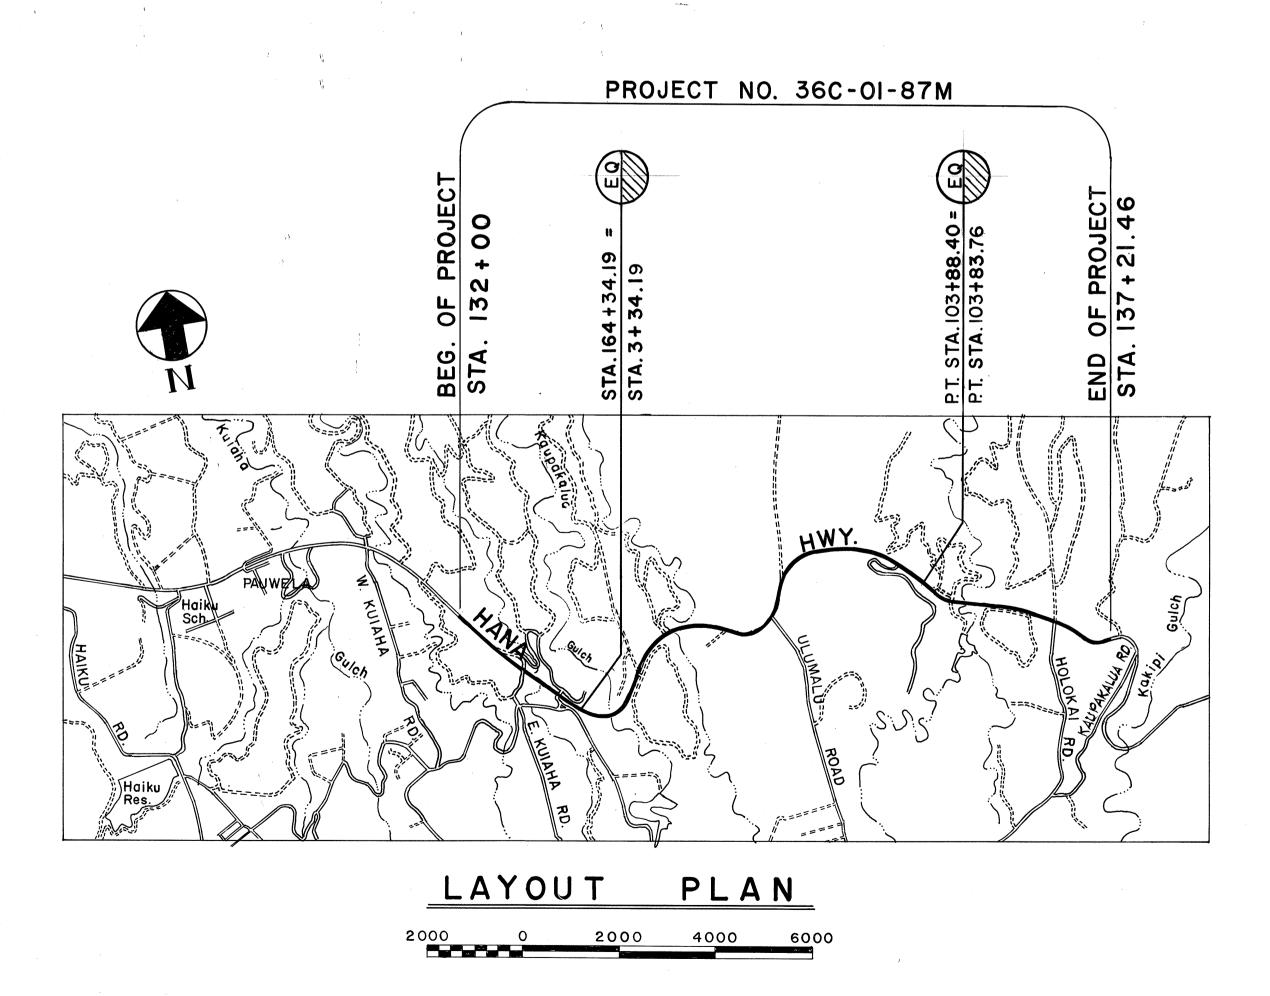

3.149 MILES

LENGTH OF PROJECT

HAWAII HAW. 36C-01-87M 1987 I 15

TO STATE OF HAWAII HAWAI

FED. ROAD DIST. NO.

PROJ. NO.

FEDERAL AID PROJECTS PREVIOUSLY CONSTRUCTED OR, UNDER CONSTRUCTION

CHANGES MADE DURING CONSTRUCTION HAVE
BEEN INCORPORATED ON THESE PLANS EXCEPT
CHANGES IN THE ORIGINAL THEORETICAL
QUANTITIES. FOR ACTUAL QUANTITIES, REFER TO
PROJECT LEDGER AND/OR COMPUTATION BOOK.

RESIDENT ENGINEER

8-18-87 DATE SHEET TOTAL NO. SHEETS

DEPARTMENT OF TRANSPORTATION STATE OF HAWAII
APPROVED:

9/29/86

DATE

Cheres & Boon OrDIR. OF TRANSPORTATION

Oct, 1986 DATE

548-2456PHONE

ROY T. NAGASAKO P. S. & E. BY

t \