
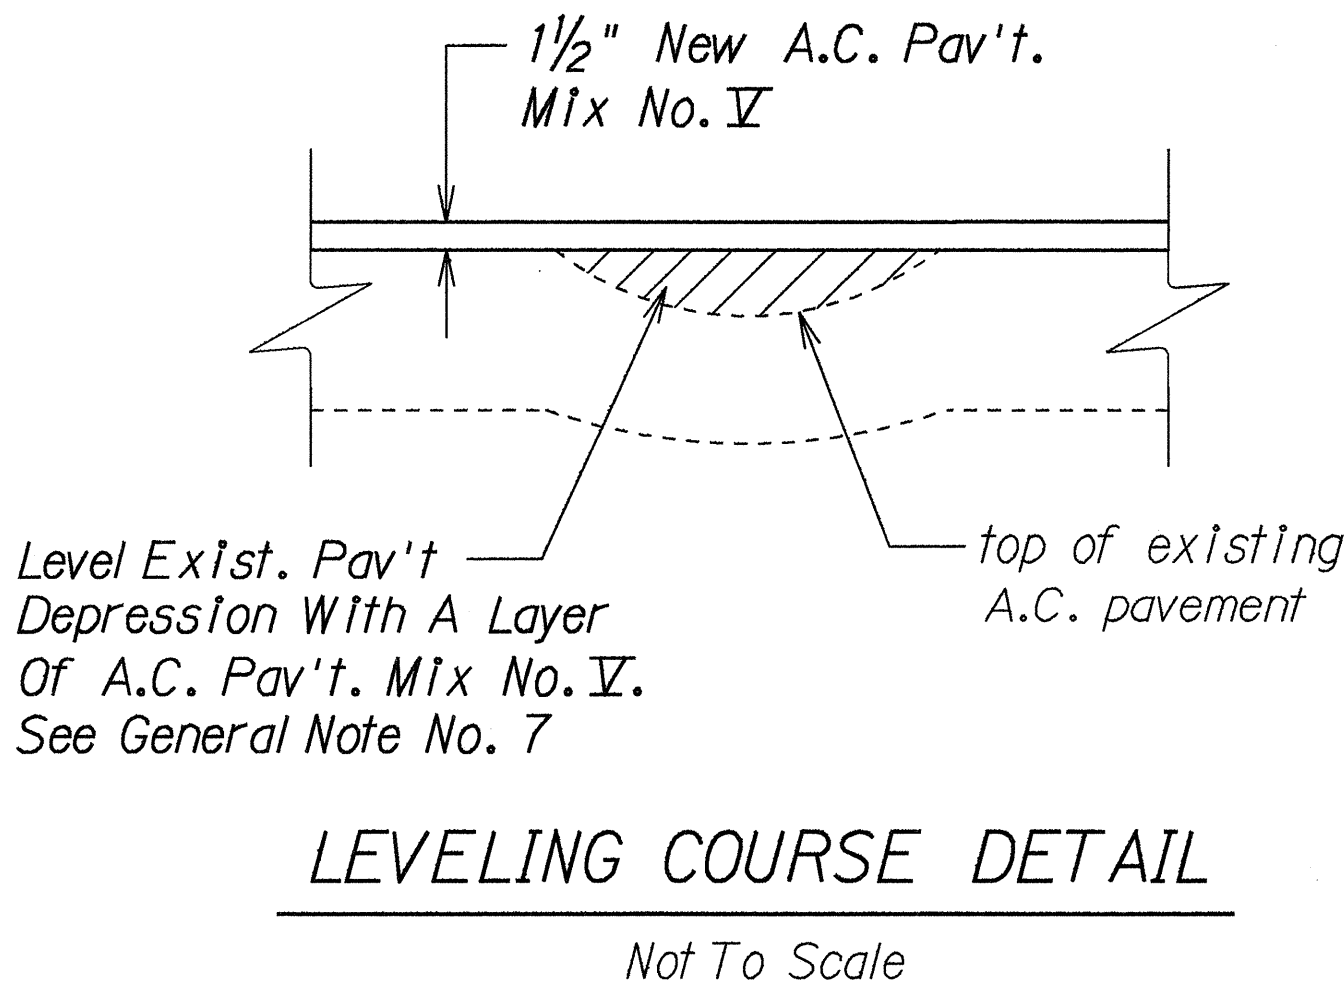
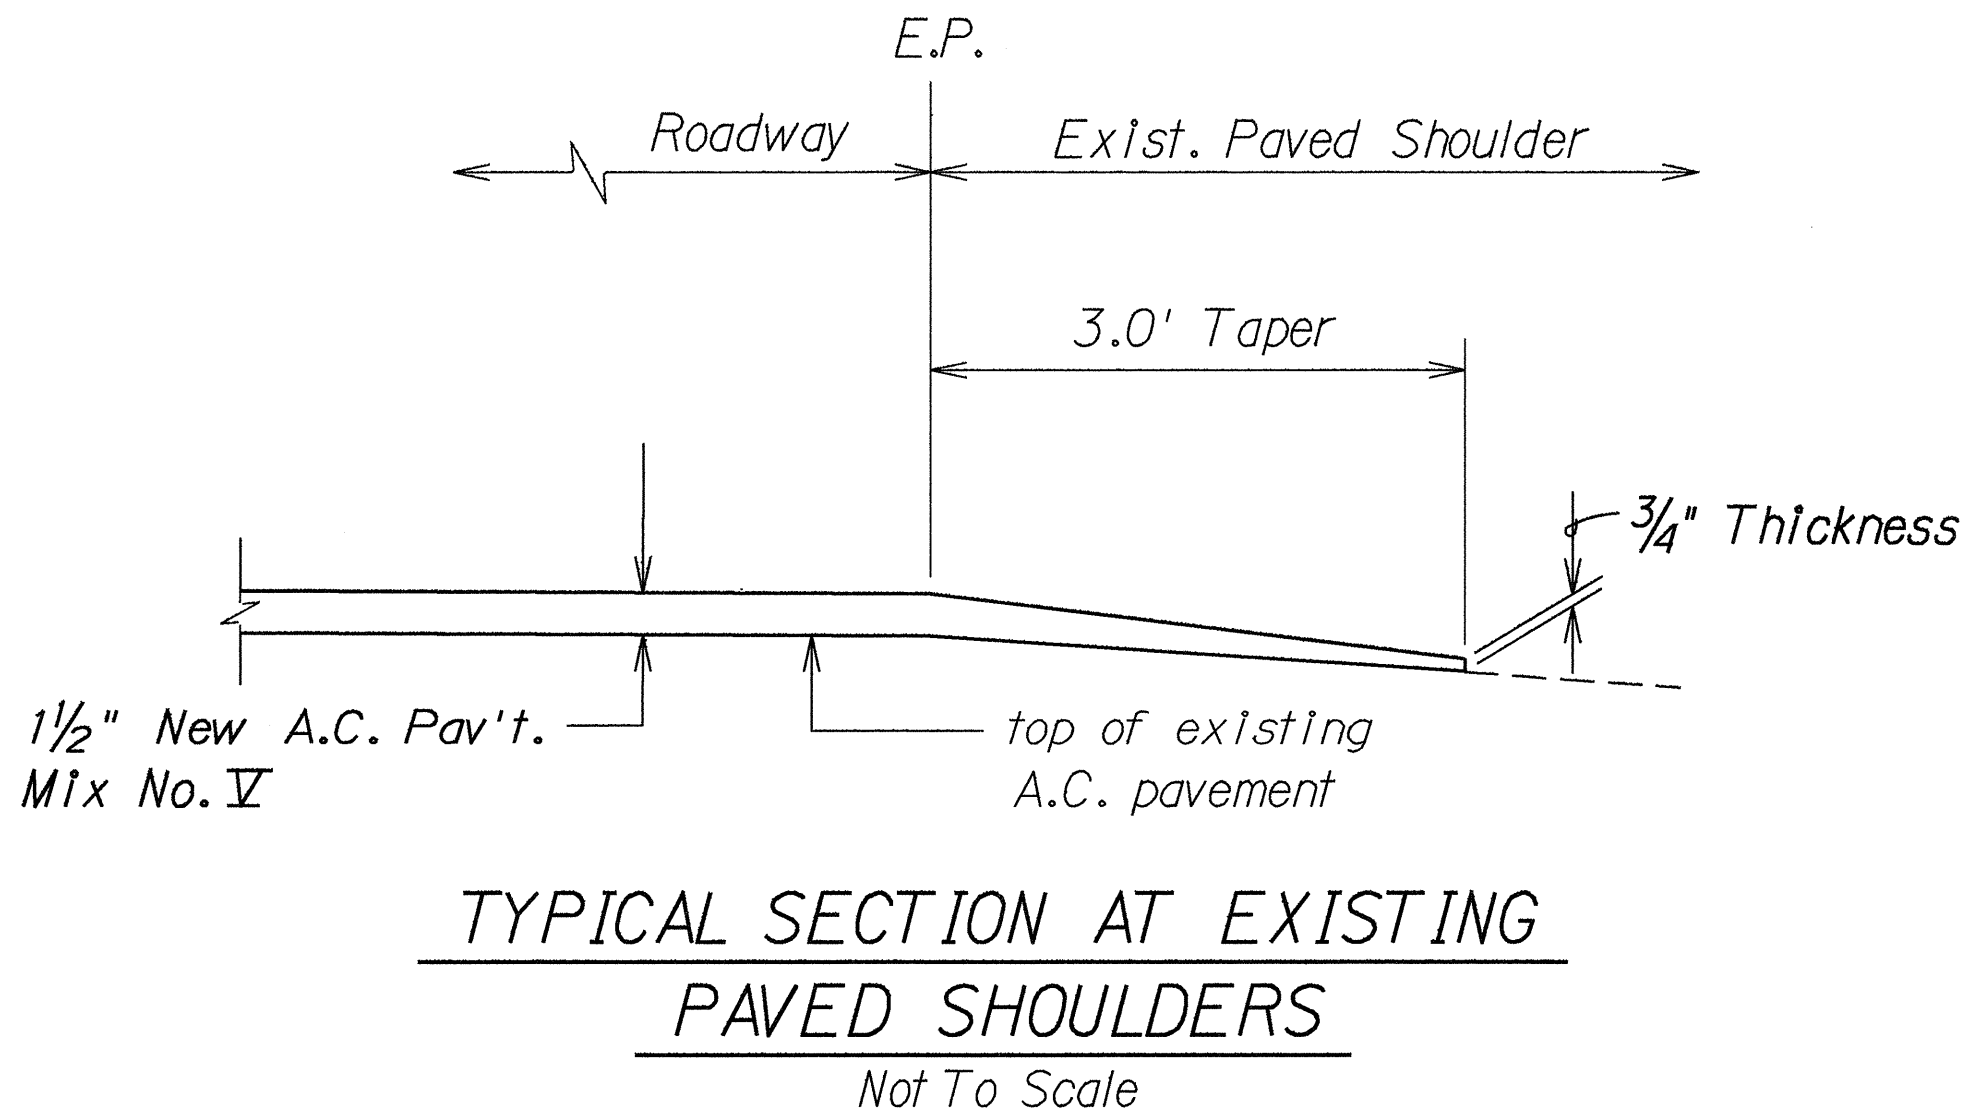
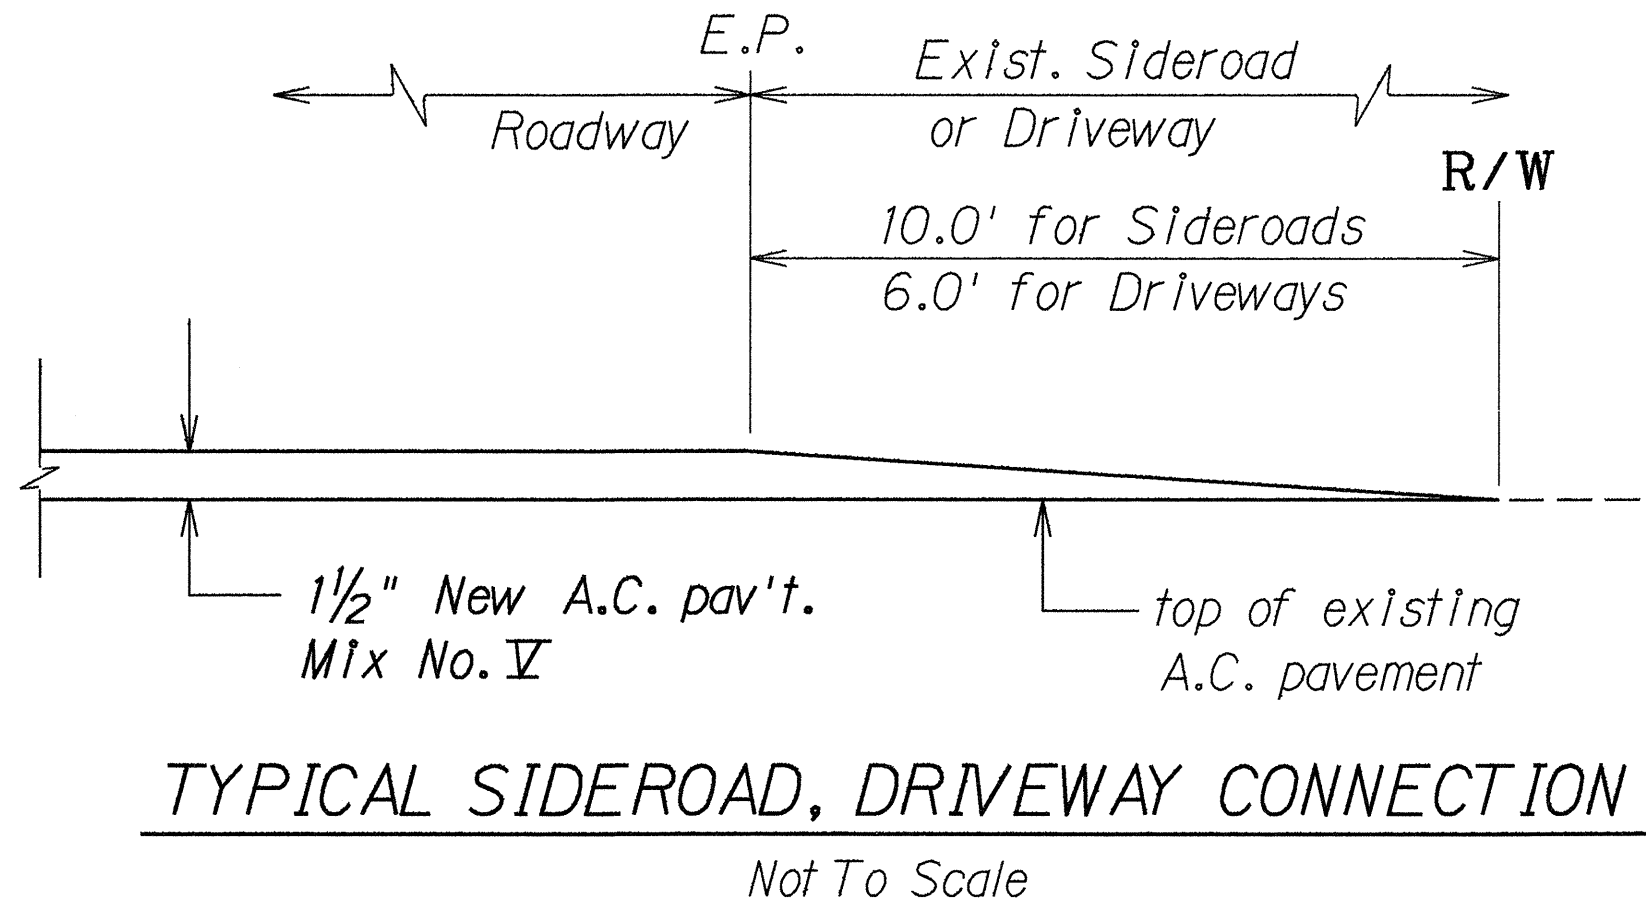


FED. ROAD DIST. NO.	STATE	FED. AID PROJ. NO.	FISCAL YEAR	SHEET NO.	TOTAL SHEETS
HAWAII	HAW.	36AB-01-90M	1990	3	16

### GENERAL NOTES

- Improvements consist of resurfacing with asphalt concrete, constructing paved shoulders, adjusting manhole frames and covers and installing pavement markings.
- Prior to placing leveling course or resurfacing, the existing surface shall be cleaned as described in Section 310 of the Standard Specifications and as amended. Payment shall be considered incidental to Item No. 401.0500, Asphalt Concrete Pavement, Mix No. V.
- The Contractor's attention is directed to Subsection 107.21- Contractor's Responsibility for Utility Property and Service of the Special Provisions for the utility company notes which pertain to this project.
- At the end of each day's work, the Contractor shall remove all equipment and other obstructions to permit free and safe passage of public traffic.
- The existence and locations of manholes, monuments and underground utilities and structures as shown on the plans are based upon records of varying degrees of accuracy and completeness and, as such, the encountering of other obstructions is not guaranteed against. The Contractor shall be liable for any damage to the existing facilities, whether or not said facilities are shown on the plans.
- The Contractor shall remove and dispose of all existing raised pavement markers prior to the overlaying of Asphalt Concrete. This work shall be considered incidental to Asphalt Concrete Pavement, Mix No. V and will not be paid for seperately.
- All holes, depressions and wheel ruts shall be filled and compacted with Asphalt Concrete Pavement, Mix No. V prior to resurfacing. This work will be paid for under Asphalt Concrete Pavement, Mix No. V.
- Shoulder dressing shall consist of clearing and grubbing, backfilling, grading and reshaping and compacting with suitable excavated material, as directed by the Engineer. This work shall be considered incidental to the various contract items.
- Smooth riding connections shall be constructed at all limits of resurfacing, including the beginning and end of project, connecting approaches, side streets and driveways as shown on the plans and/or as directed by the Engineer.

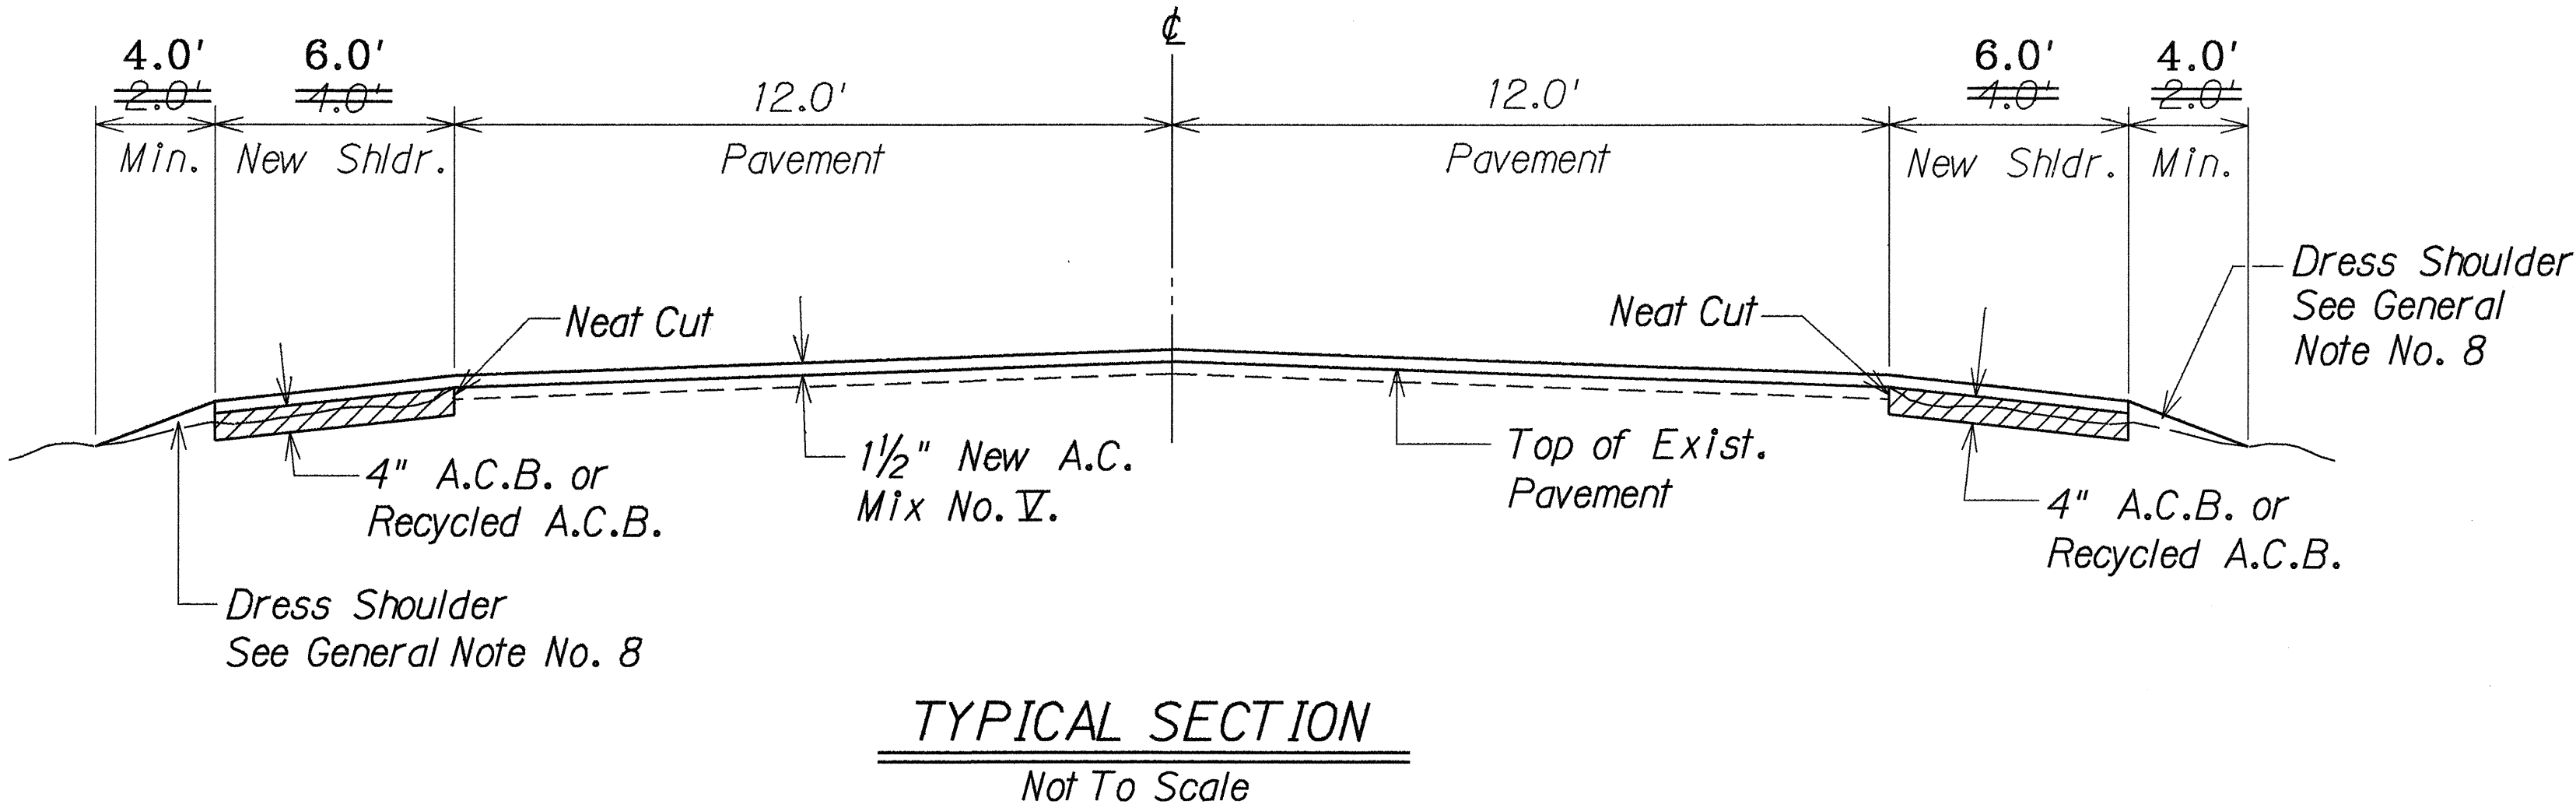

LEGEND FOR AS-BUILT POSTINGS	
	Squiggly line for as-built deletion
	Double line for as-built deletion
	Text for as-built posting

STATE OF HAWAII  
DEPARTMENT OF TRANSPORTATION  
HIGHWAYS DIVISION

GENERAL NOTES AND  
TYPICAL SECTIONS  
HANA HIGHWAY RESURFACING  
Haleakala Hwy. to Hookipa Park  
Project No. 36AB-01-90M

Scale: As Shown  
Date: May, 1990

SHEET No. 1 OF 1 SHEETS

SURVEY PLOTTED BY	DATE
DRAWN BY	10-25-91
DESIGNED BY	
CHECKED BY	
ORIGINAL PLAN	
NOTE BOOK	
QUANTITIES BY	
CHECKED BY	