


107-888

FED. ROAD DIST. NO.	STATE	FED. AID PROJ. NO.	FISCAL YEAR	SHEET NO.	TOTAL SHEETS
HAWAII	HAW.	30AB-01-90M	1990	4	10


BEGINNING OF PROJECT
@ STA. 173+05

TRUE NORTH
Scale: 1"=40'

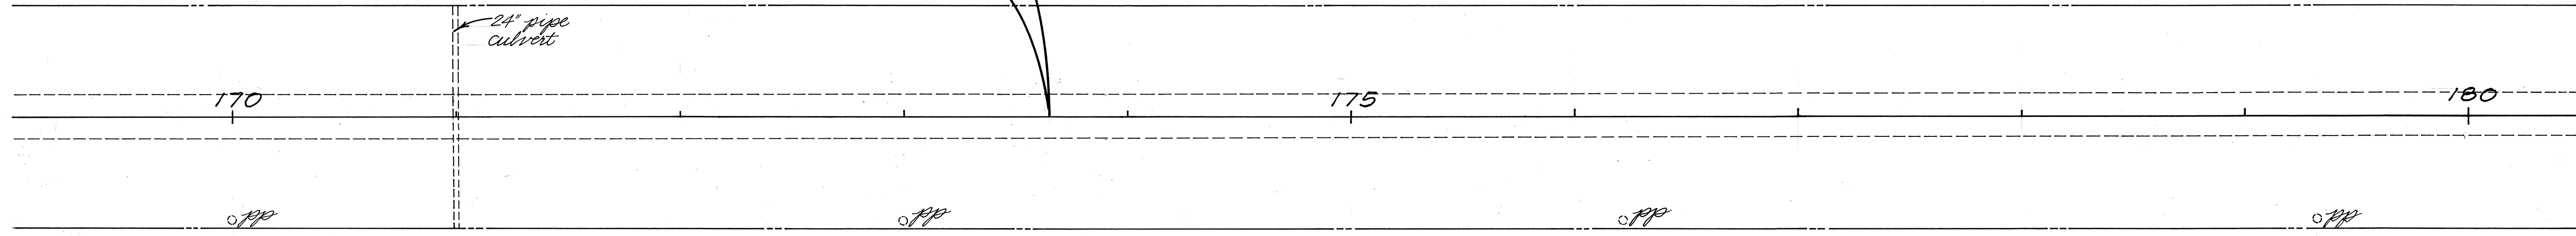

M.L. @ STA. 180+50

M.L. @ STA. 180+50

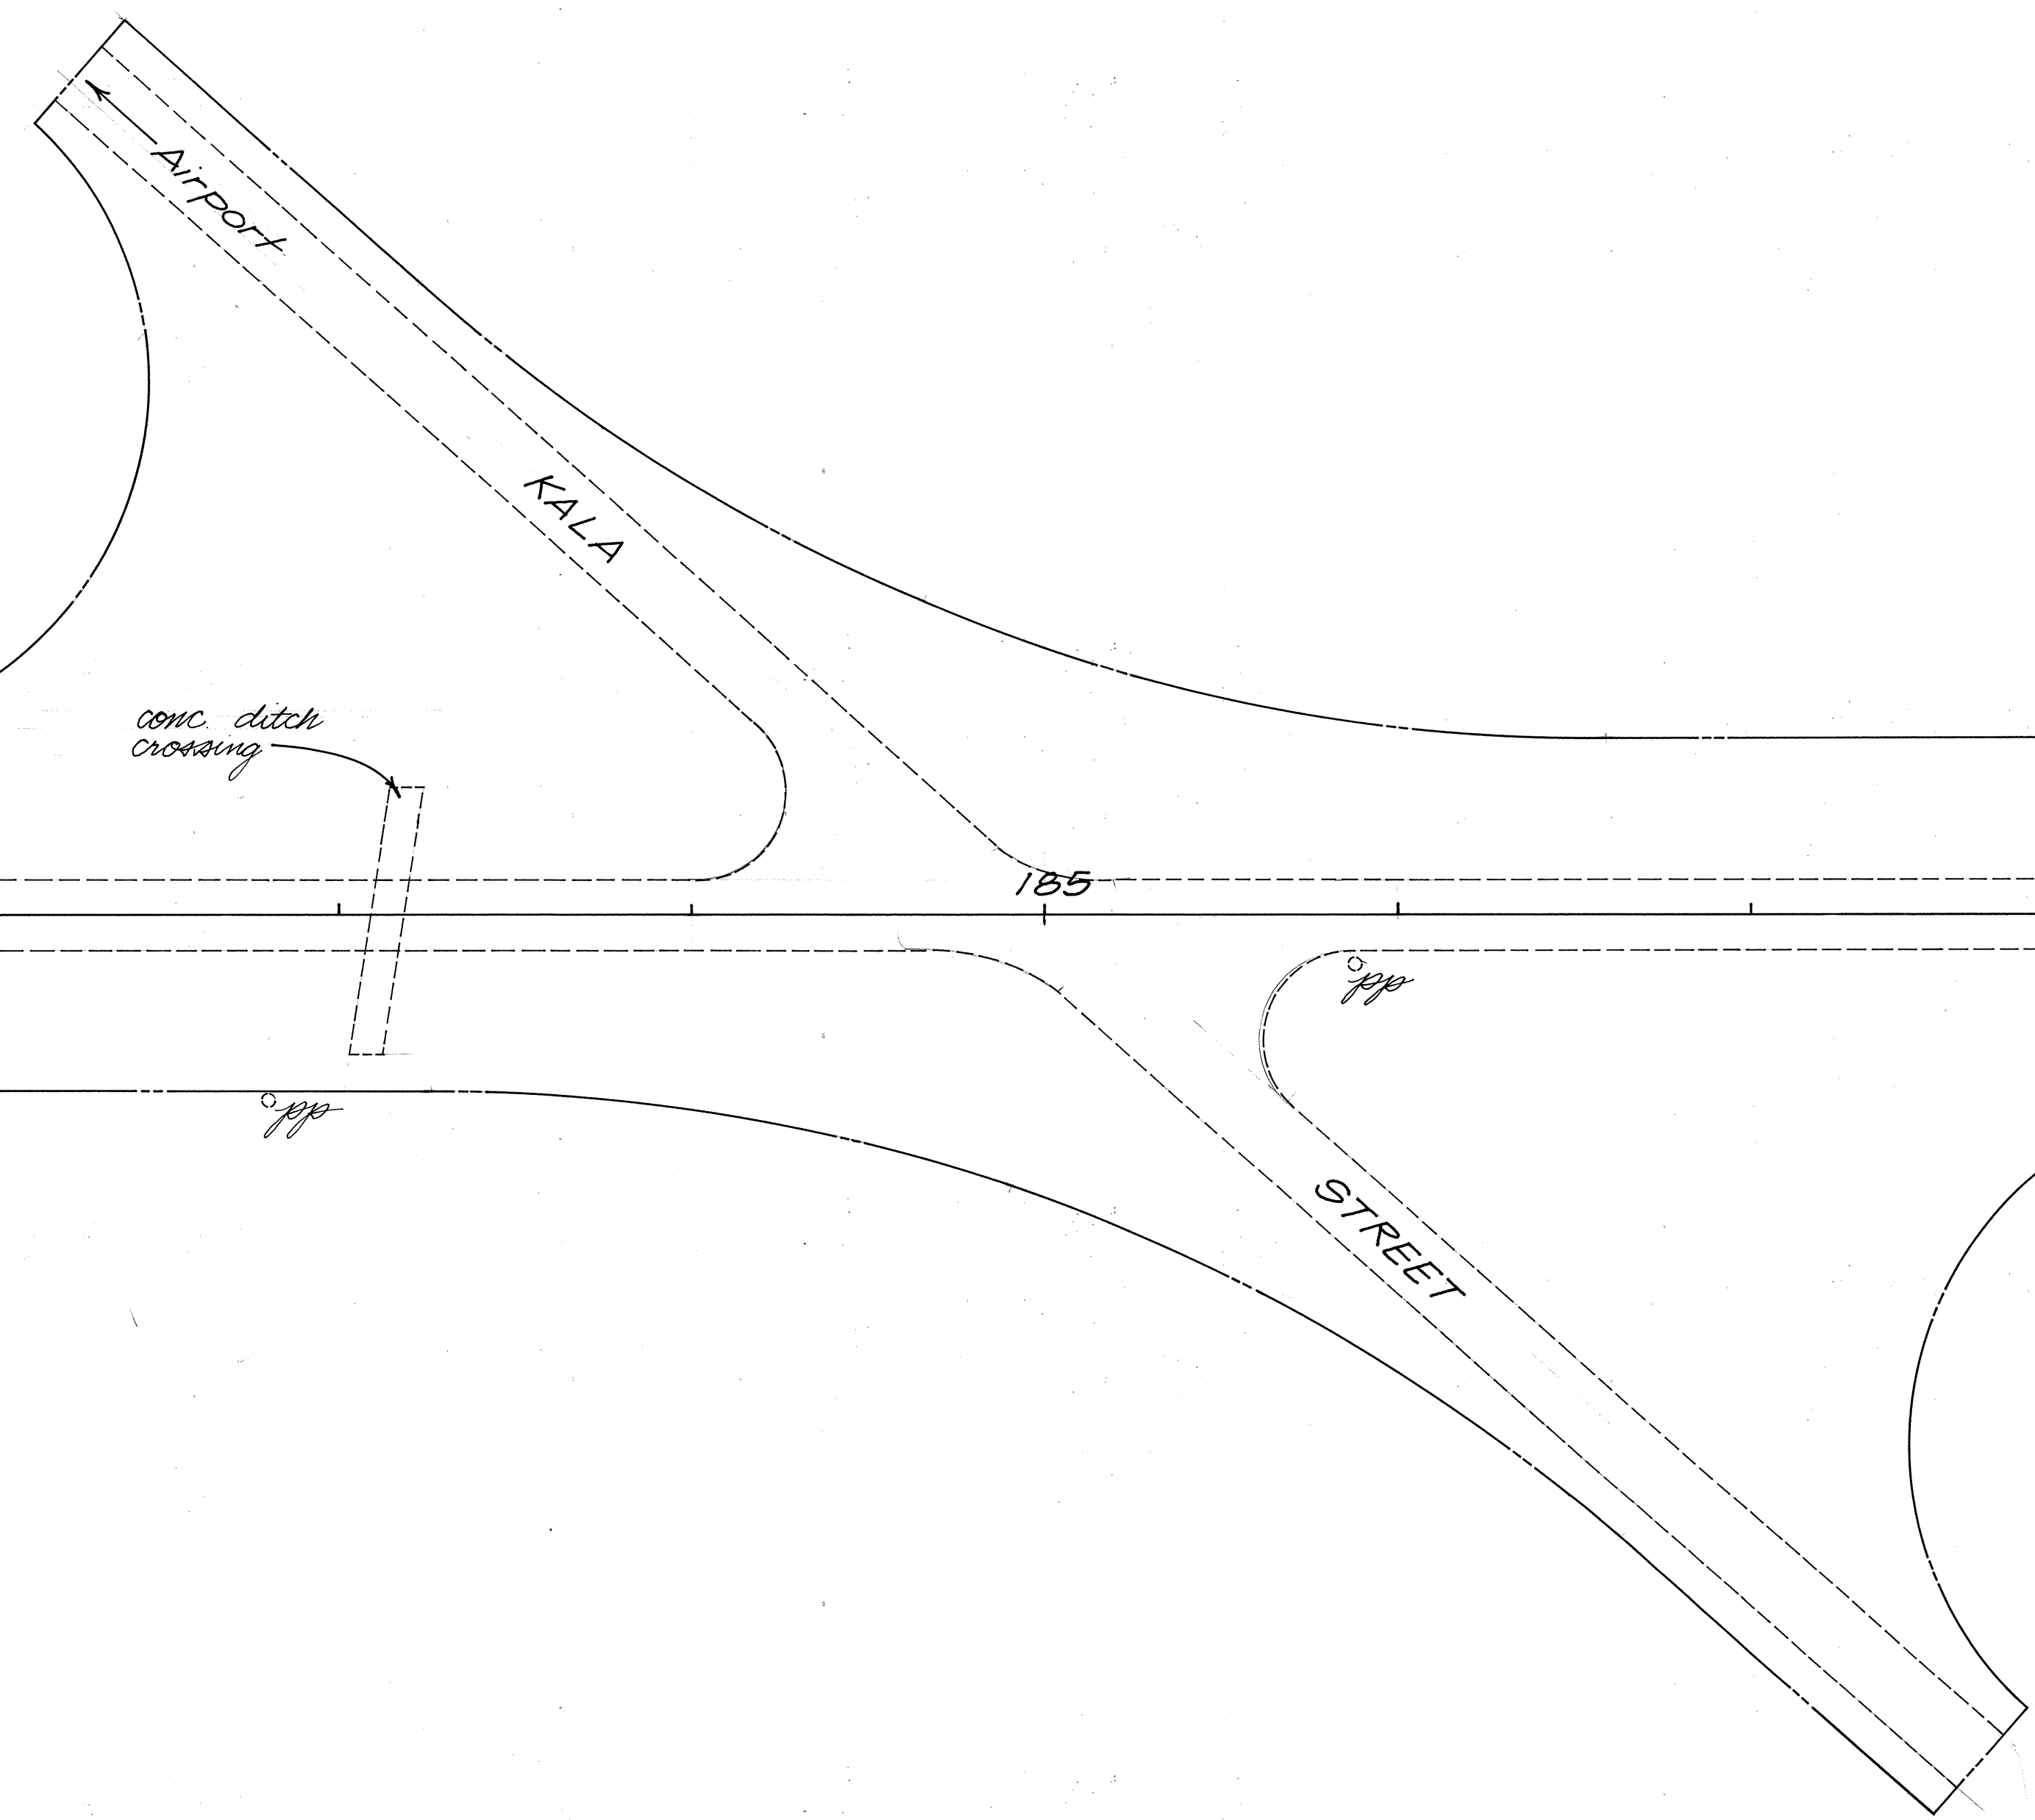

TRUE NORTH
Scale: 1"=40'

M.L. @ STA. 192+00

ORIGINAL PLAN	SURVEY PLOTTED BY	DATE
NOTE BOOK	DRAWN BY	
No.	DESIGNED BY	
	QUANTITIES BY	
	CHECKED BY	

STATE OF HAWAII
DEPARTMENT OF TRANSPORTATION
HIGHWAYS DIVISION

ROADWAY PLAN

HANA HIGHWAY RESURFACING
Haleakala Hwy. to Hookipa Park
Proj. No. 30AB-01-90M
Scale: 1"=40' Date: April, 1990

SHEET No. 1 OF 12 SHEETS

107688

FED. ROAD DIST. NO.	STATE	FED. AID PROJ. NO.	FISCAL YEAR	SHEET NO.	TOTAL SHEETS
HAWAII	HAW.	36AB-01-90M	1990	5	10

TRUE NORTH
Scale: 1"=40'

M.L. STA 192+00

M.L. STA 204+50

PC STA 199+29.76
R=5729.58'

PT STA 215+86.43
R=5729.58'

TRUE NORTH
Scale: 1"=40'

M.L. STA 204+50

M.L. STA 217+00

ORIGINAL PLAN	SURVEY PLOTTED BY	DATE
NOTE BOOK	DRAWN BY	
No.	DESIGNED BY	
	QUANTITIES BY	
	CHECKED BY	

STATE OF HAWAII
DEPARTMENT OF TRANSPORTATION
HIGHWAYS DIVISION

ROADWAY PLAN


HANA HIGHWAY RESURFACING
Haleakala Hwy. to Hookipa Park
Proj. No. 36AB-01-90M
Scale: 1"=40' Date: April, 1990

SHEET No. 2 OF 12 SHEETS

10788

FED. ROAD DIST. NO.	STATE	FED. AID PROJ. NO.	FISCAL YEAR	SHEET NO.	TOTAL SHEETS
HAWAII	HAW.	36AB-01-90M	1990	6	16

TRUE NORTH
Scale: 1"=40'

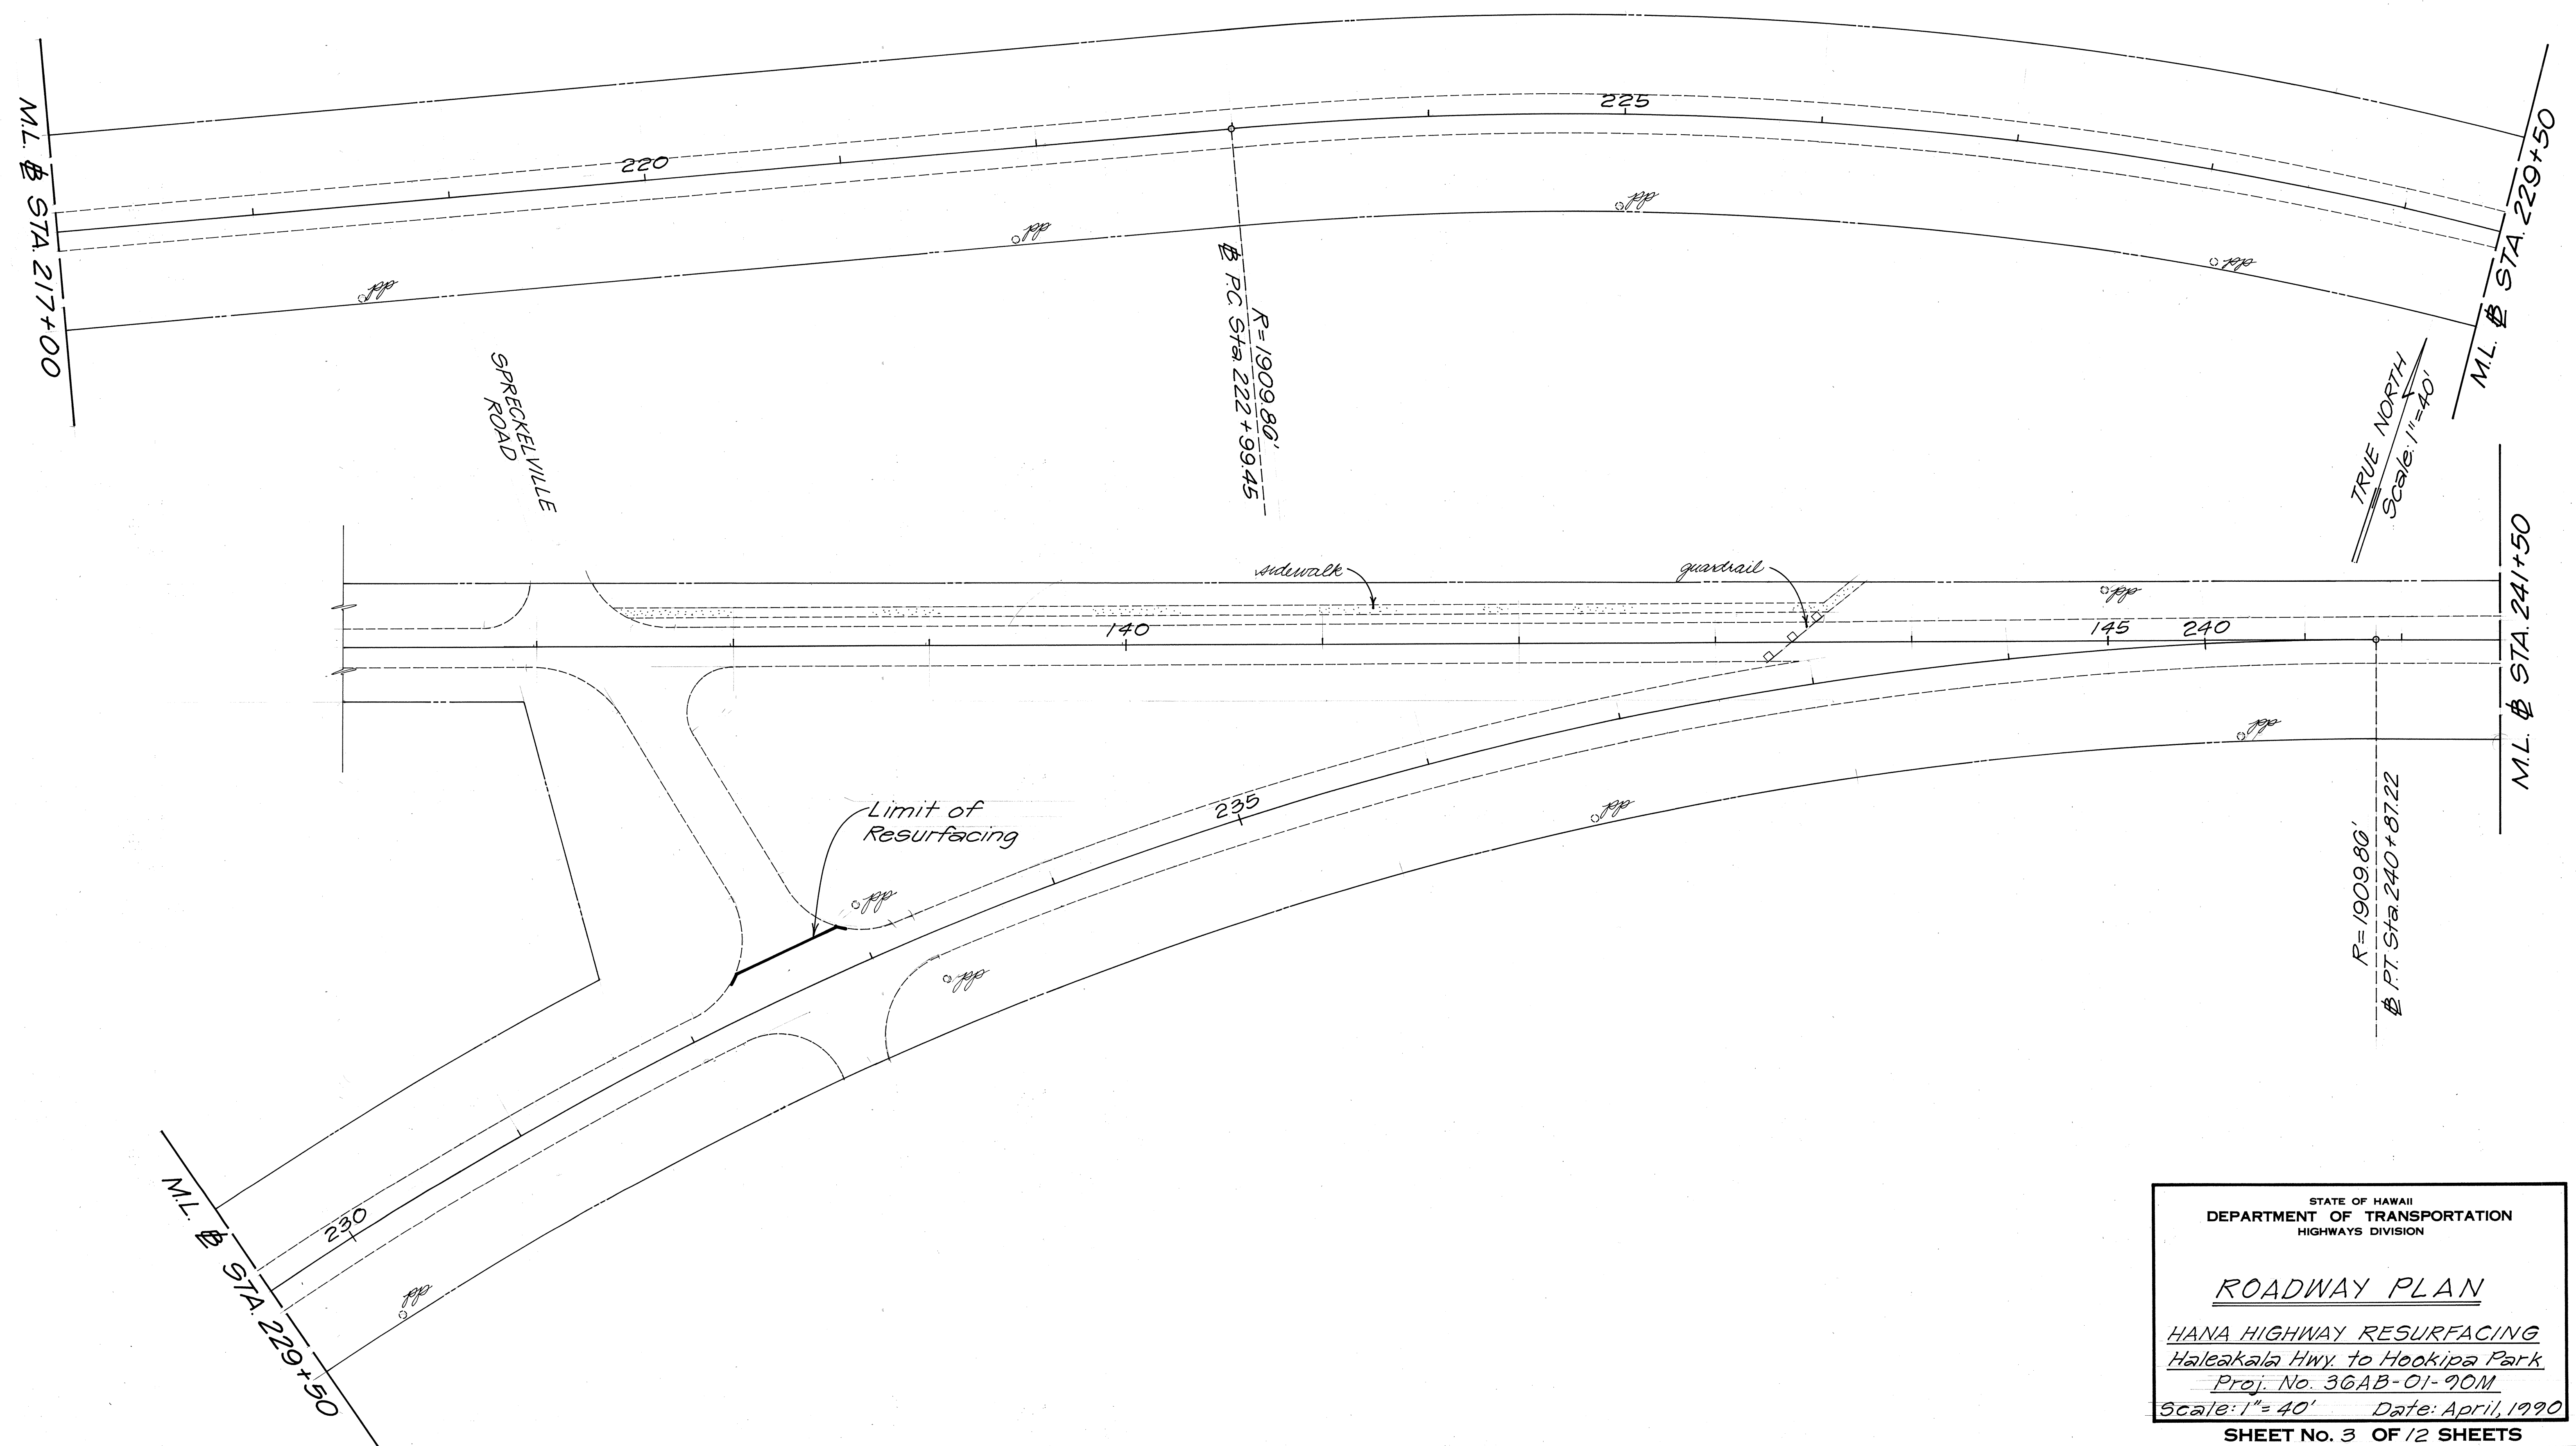

ORIGINAL PLAN	SURVEY PLOTTED BY	DATE
NOTE BOOK	DRAWN BY	
No.	DESIGNED BY	
	QUANTITIES BY	
	CHECKED BY	

STATE OF HAWAII
DEPARTMENT OF TRANSPORTATION
HIGHWAYS DIVISION

ROADWAY PLAN

HANA HIGHWAY RESURFACING
Haleakala Hwy. to Hookipa Park
Proj. No. 36AB-01-90M
Scale: 1"=40' Date: April, 1990

SHEET No. 3 OF 12 SHEETS

107688


ORIGINAL PLAN	SURVEY PLOTTED BY	DATE
NOTE BOOK No.	DRAWN BY	
	DESIGNED BY	
	QUANTITIES BY	
	CHECKED BY	

M.L. STA. 241+50

M.L. STA. 158+00

M.L. STA. 169+00

Sta 241+95.49 And EQ
= Sta 147+44.88 Bk

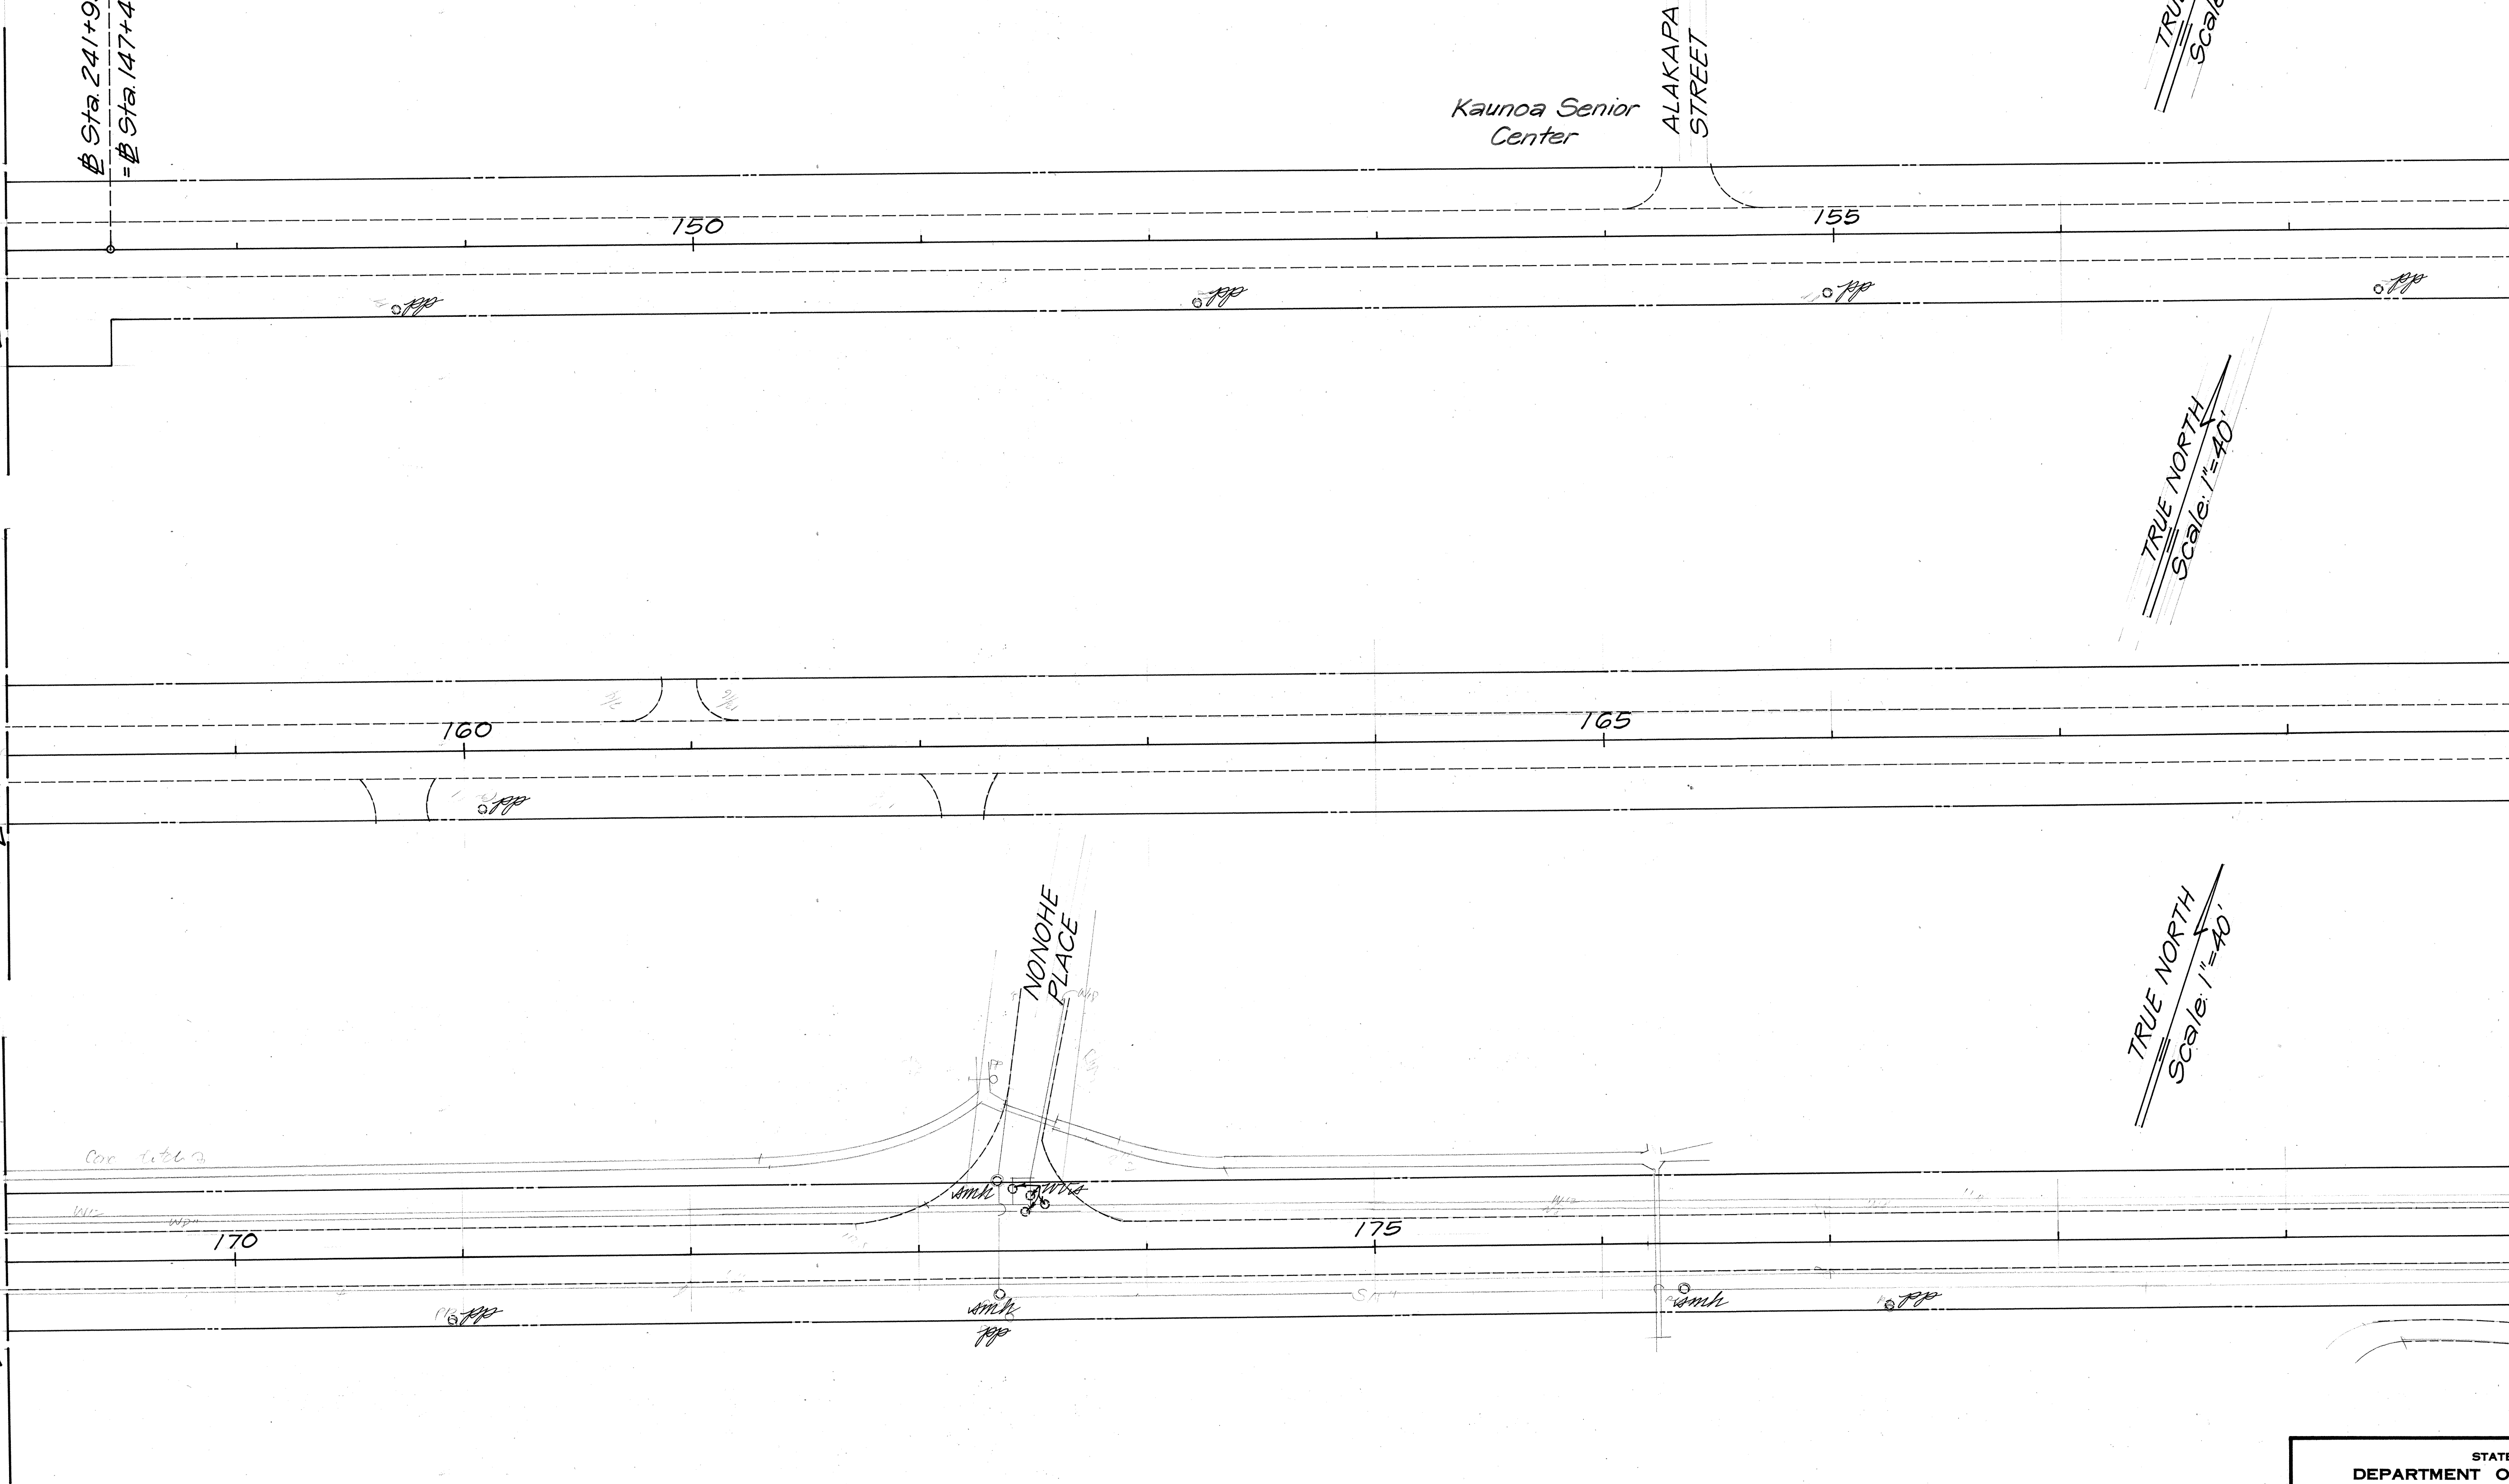

TRUE NORTH
Scale: 1"=40'

TRUE NORTH
Scale: 1"=40'

TRUE NORTH
Scale: 1"=40'

FED. ROAD DIST. NO.	STATE	FED. AID PROJ. NO.	FISCAL YEAR	SHEET NO.	TOTAL SHEETS
HAWAII	HAW.	36AB-01-90M	1990	7	10

STATE OF HAWAII
DEPARTMENT OF TRANSPORTATION
HIGHWAYS DIVISION

ROADWAY PLAN

HANA HIGHWAY RESURFACING
Haleakala Hwy. to Hookipa Park
Proj. No. 36AB-01-90M
Scale: 1"=40' Date: April, 1990


SHEET No. 4 OF 12 SHEETS

M.L. STA. 158+00

M.L. STA. 169+00

M.L. STA. 180+00

FED. ROAD DIST. NO.	STATE	FED. AID PROJ. NO.	FISCAL YEAR	SHEET NO.	TOTAL SHEETS
HAWAII	HAW.	36AB-01-90M	1990	7A	16

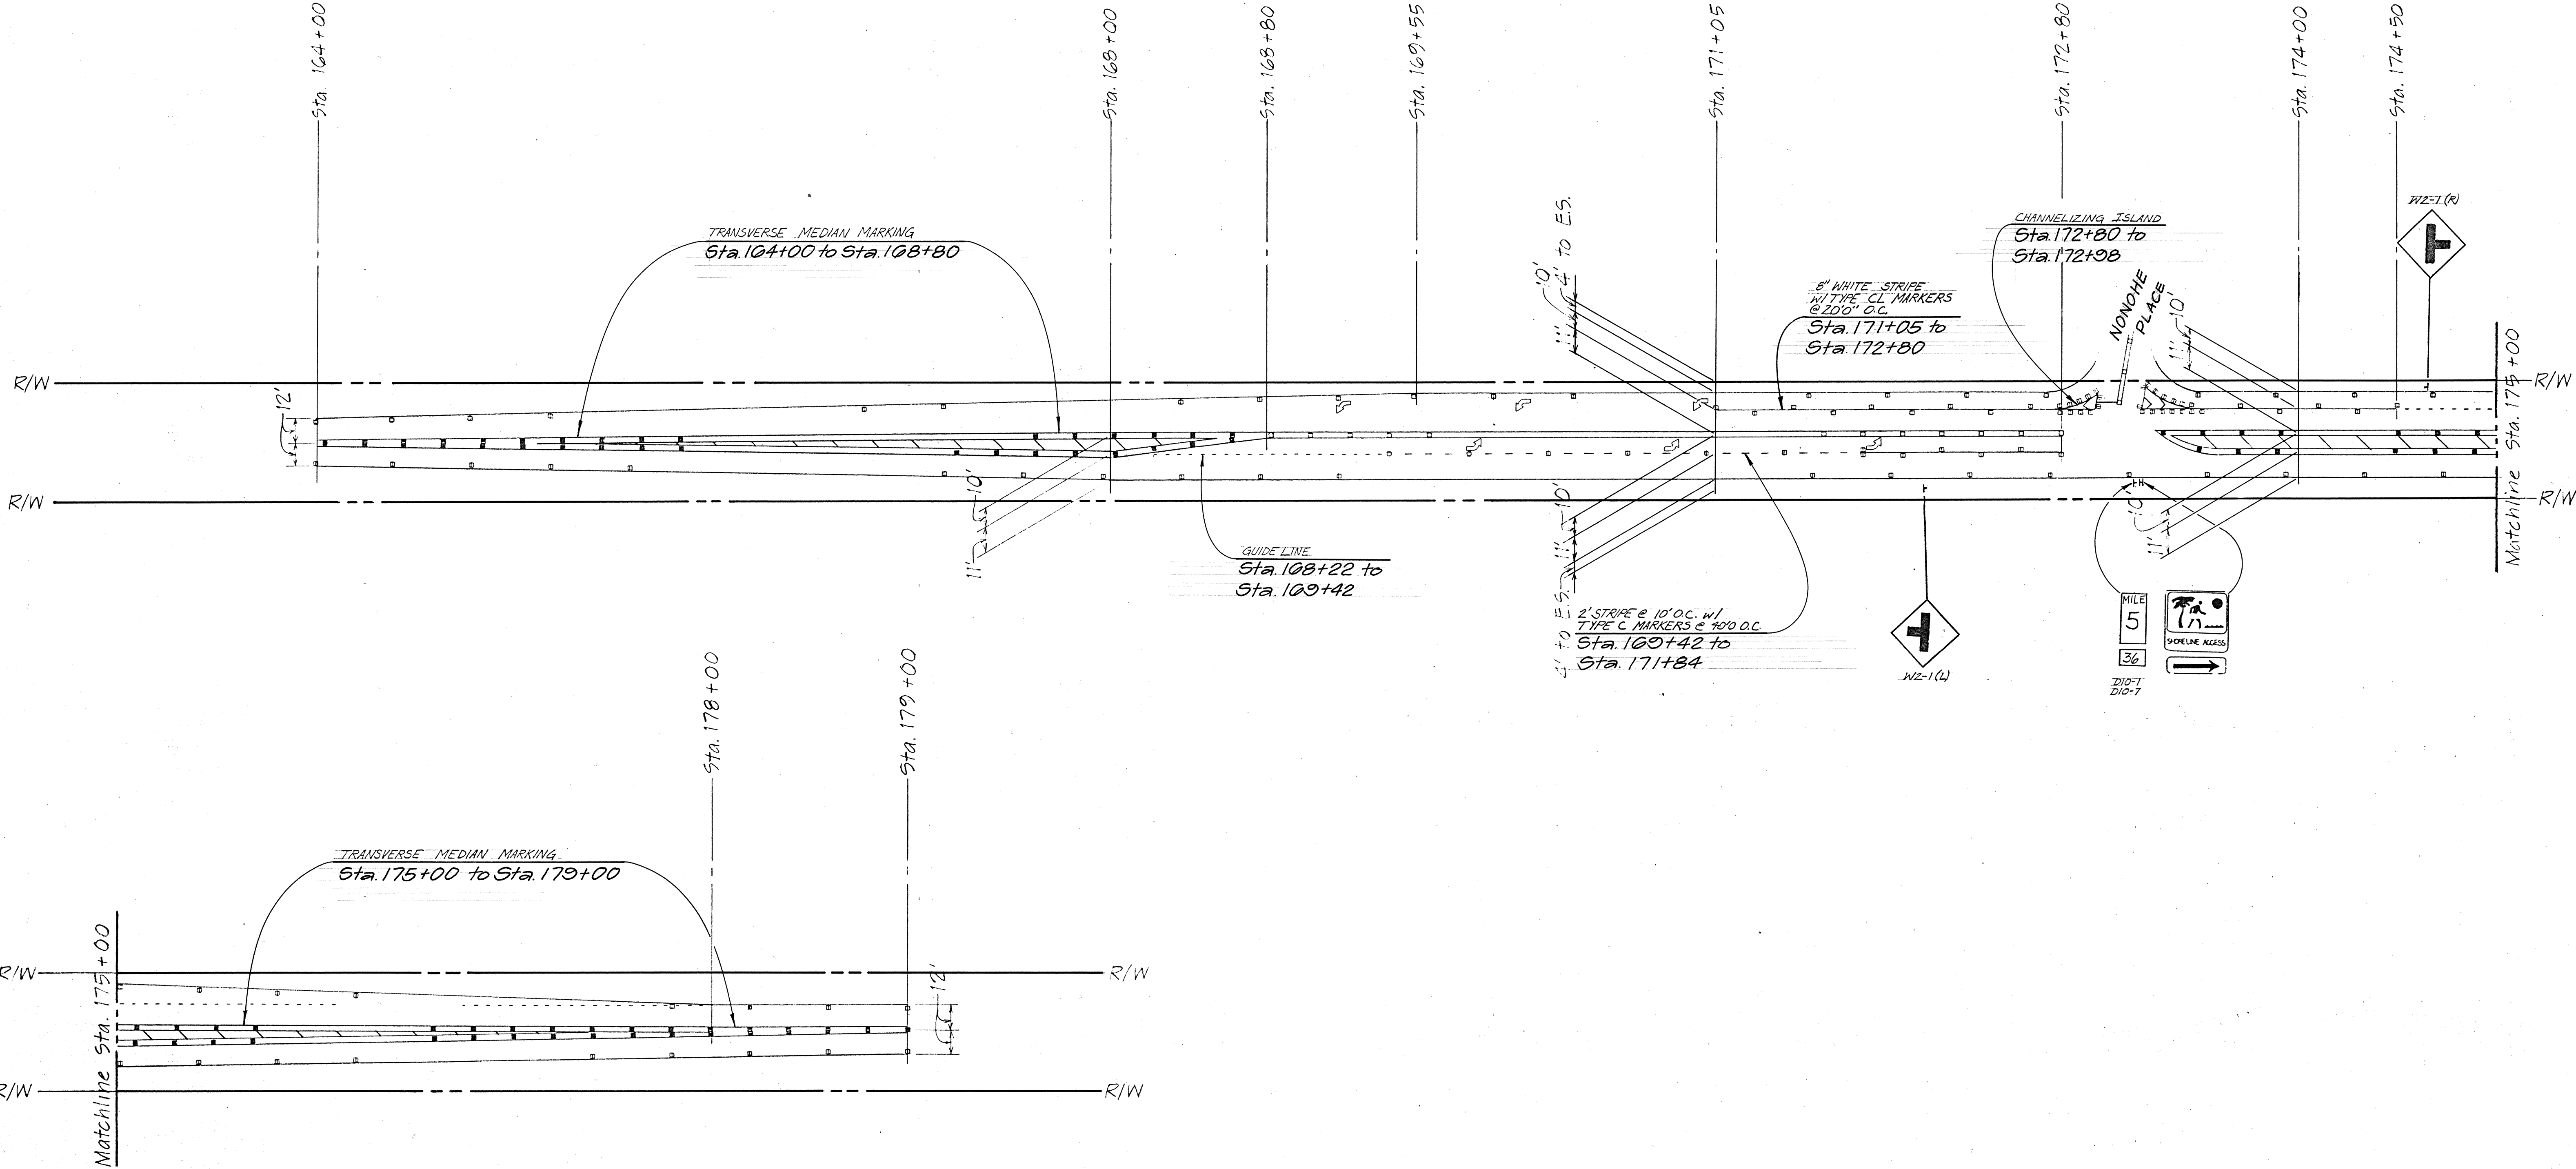

Note: This tracing prepared during "As-Built" Posting.


STATE OF HAWAII
DEPARTMENT OF TRANSPORTATION
HIGHWAYS DIVISION

STRIPING PLAN
HANA HIGHWAY RESURFACING
Haleakala Hwy. to Hookipa Park
Proj. No. 36AB-01-90M
C.C.O. No. 1
Scale: 1" = 40' Date:

SHEET No. 7A OF 16 SHEETS

ORIGINAL PLAN	SURVEY PLOTTED BY	DATE
NOTE BOOK	DRAWN BY	
No.	DESIGNED BY	
	CHECKED BY	

ORIGINAL PLAN	SURVEY PLOTTED BY	DATE
NOTE BOOK	DESIGNED BY	
No.	QUANTITIES BY	
	CHECKED BY	

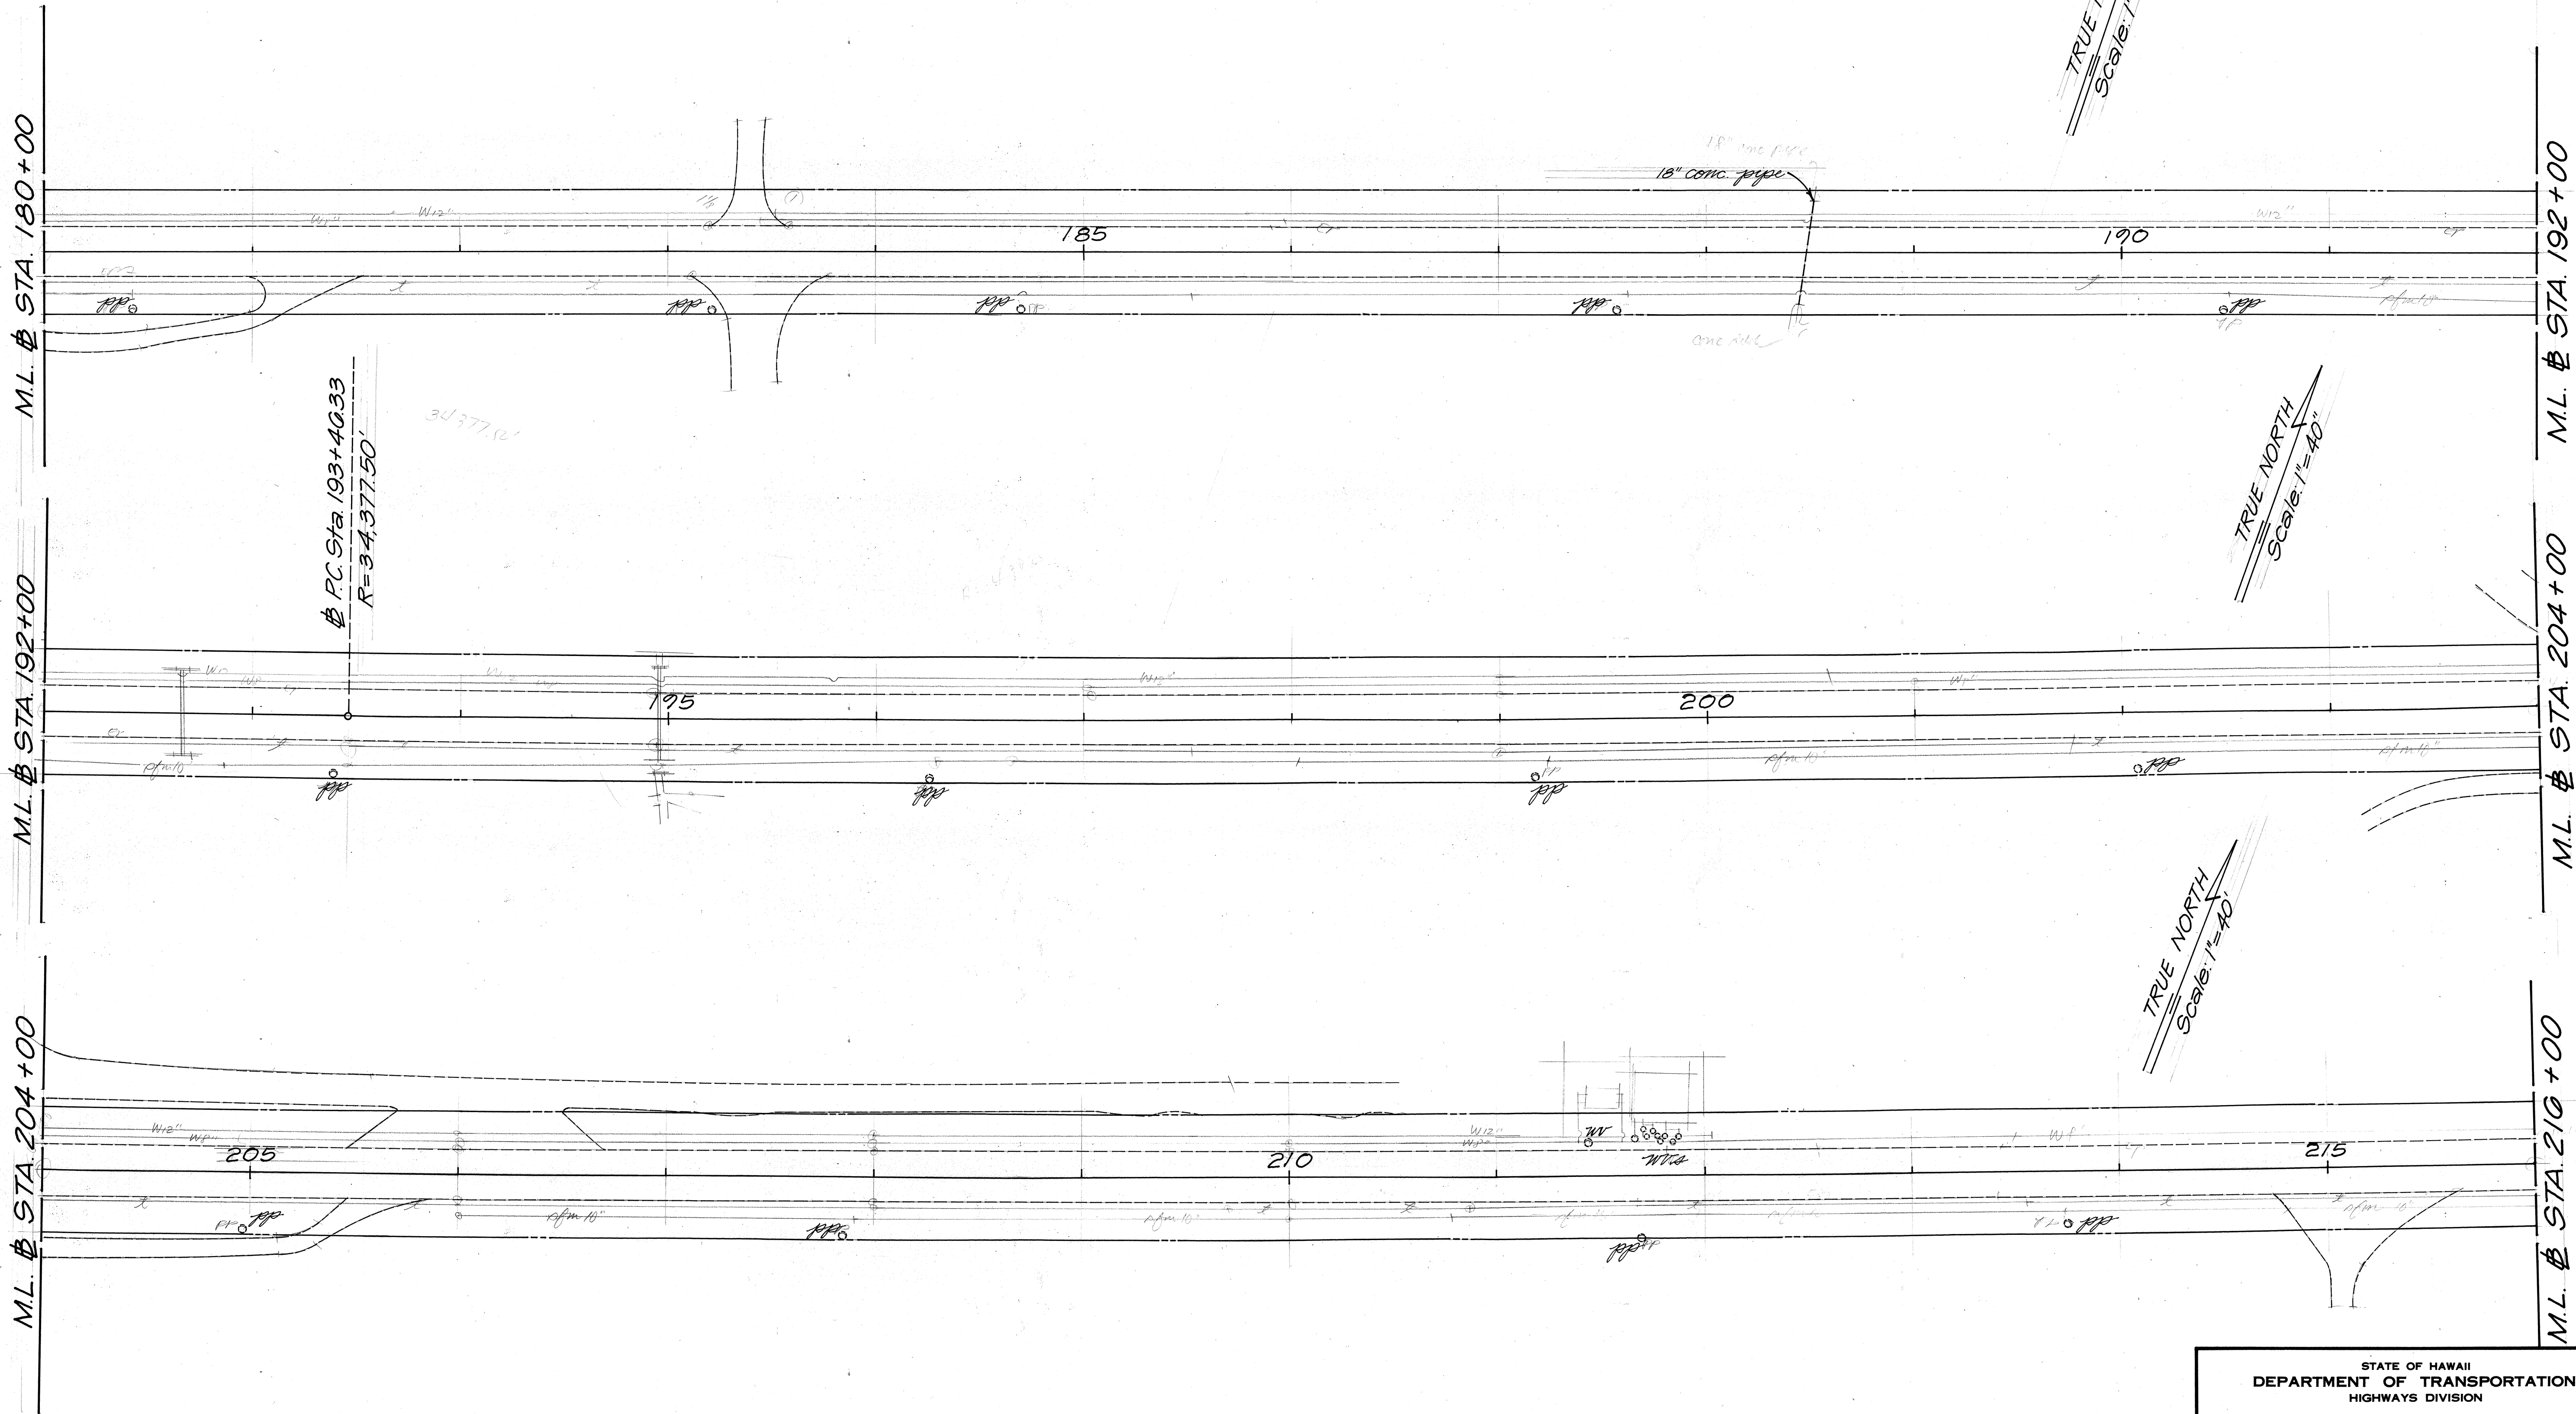

FED. ROAD DIST. NO.	STATE	FED-AID PROJ. NO.	FISCAL YEAR	SHEET NO.	TOTAL SHEETS
HAWAII	HAW.	36AB-01-90M	1990	8	10


STATE OF HAWAII
DEPARTMENT OF TRANSPORTATION
HIGHWAYS DIVISION

ROADWAY PLAN

HANA HIGHWAY RESURFACING
Haleakala Hwy. to Hookipa Park
Proj. No. 36AB-01-90M
Scale: 1"=40' Date: April, 1990

SHEET No. 5 OF 12 SHEETS

ORIGINAL PLAN	SURVEY PLOTTED BY	DATE
NOTE BOOK	DRAWN BY	
No.	DESIGNED BY	
	QUANTITIES BY	
	CHECKED BY	

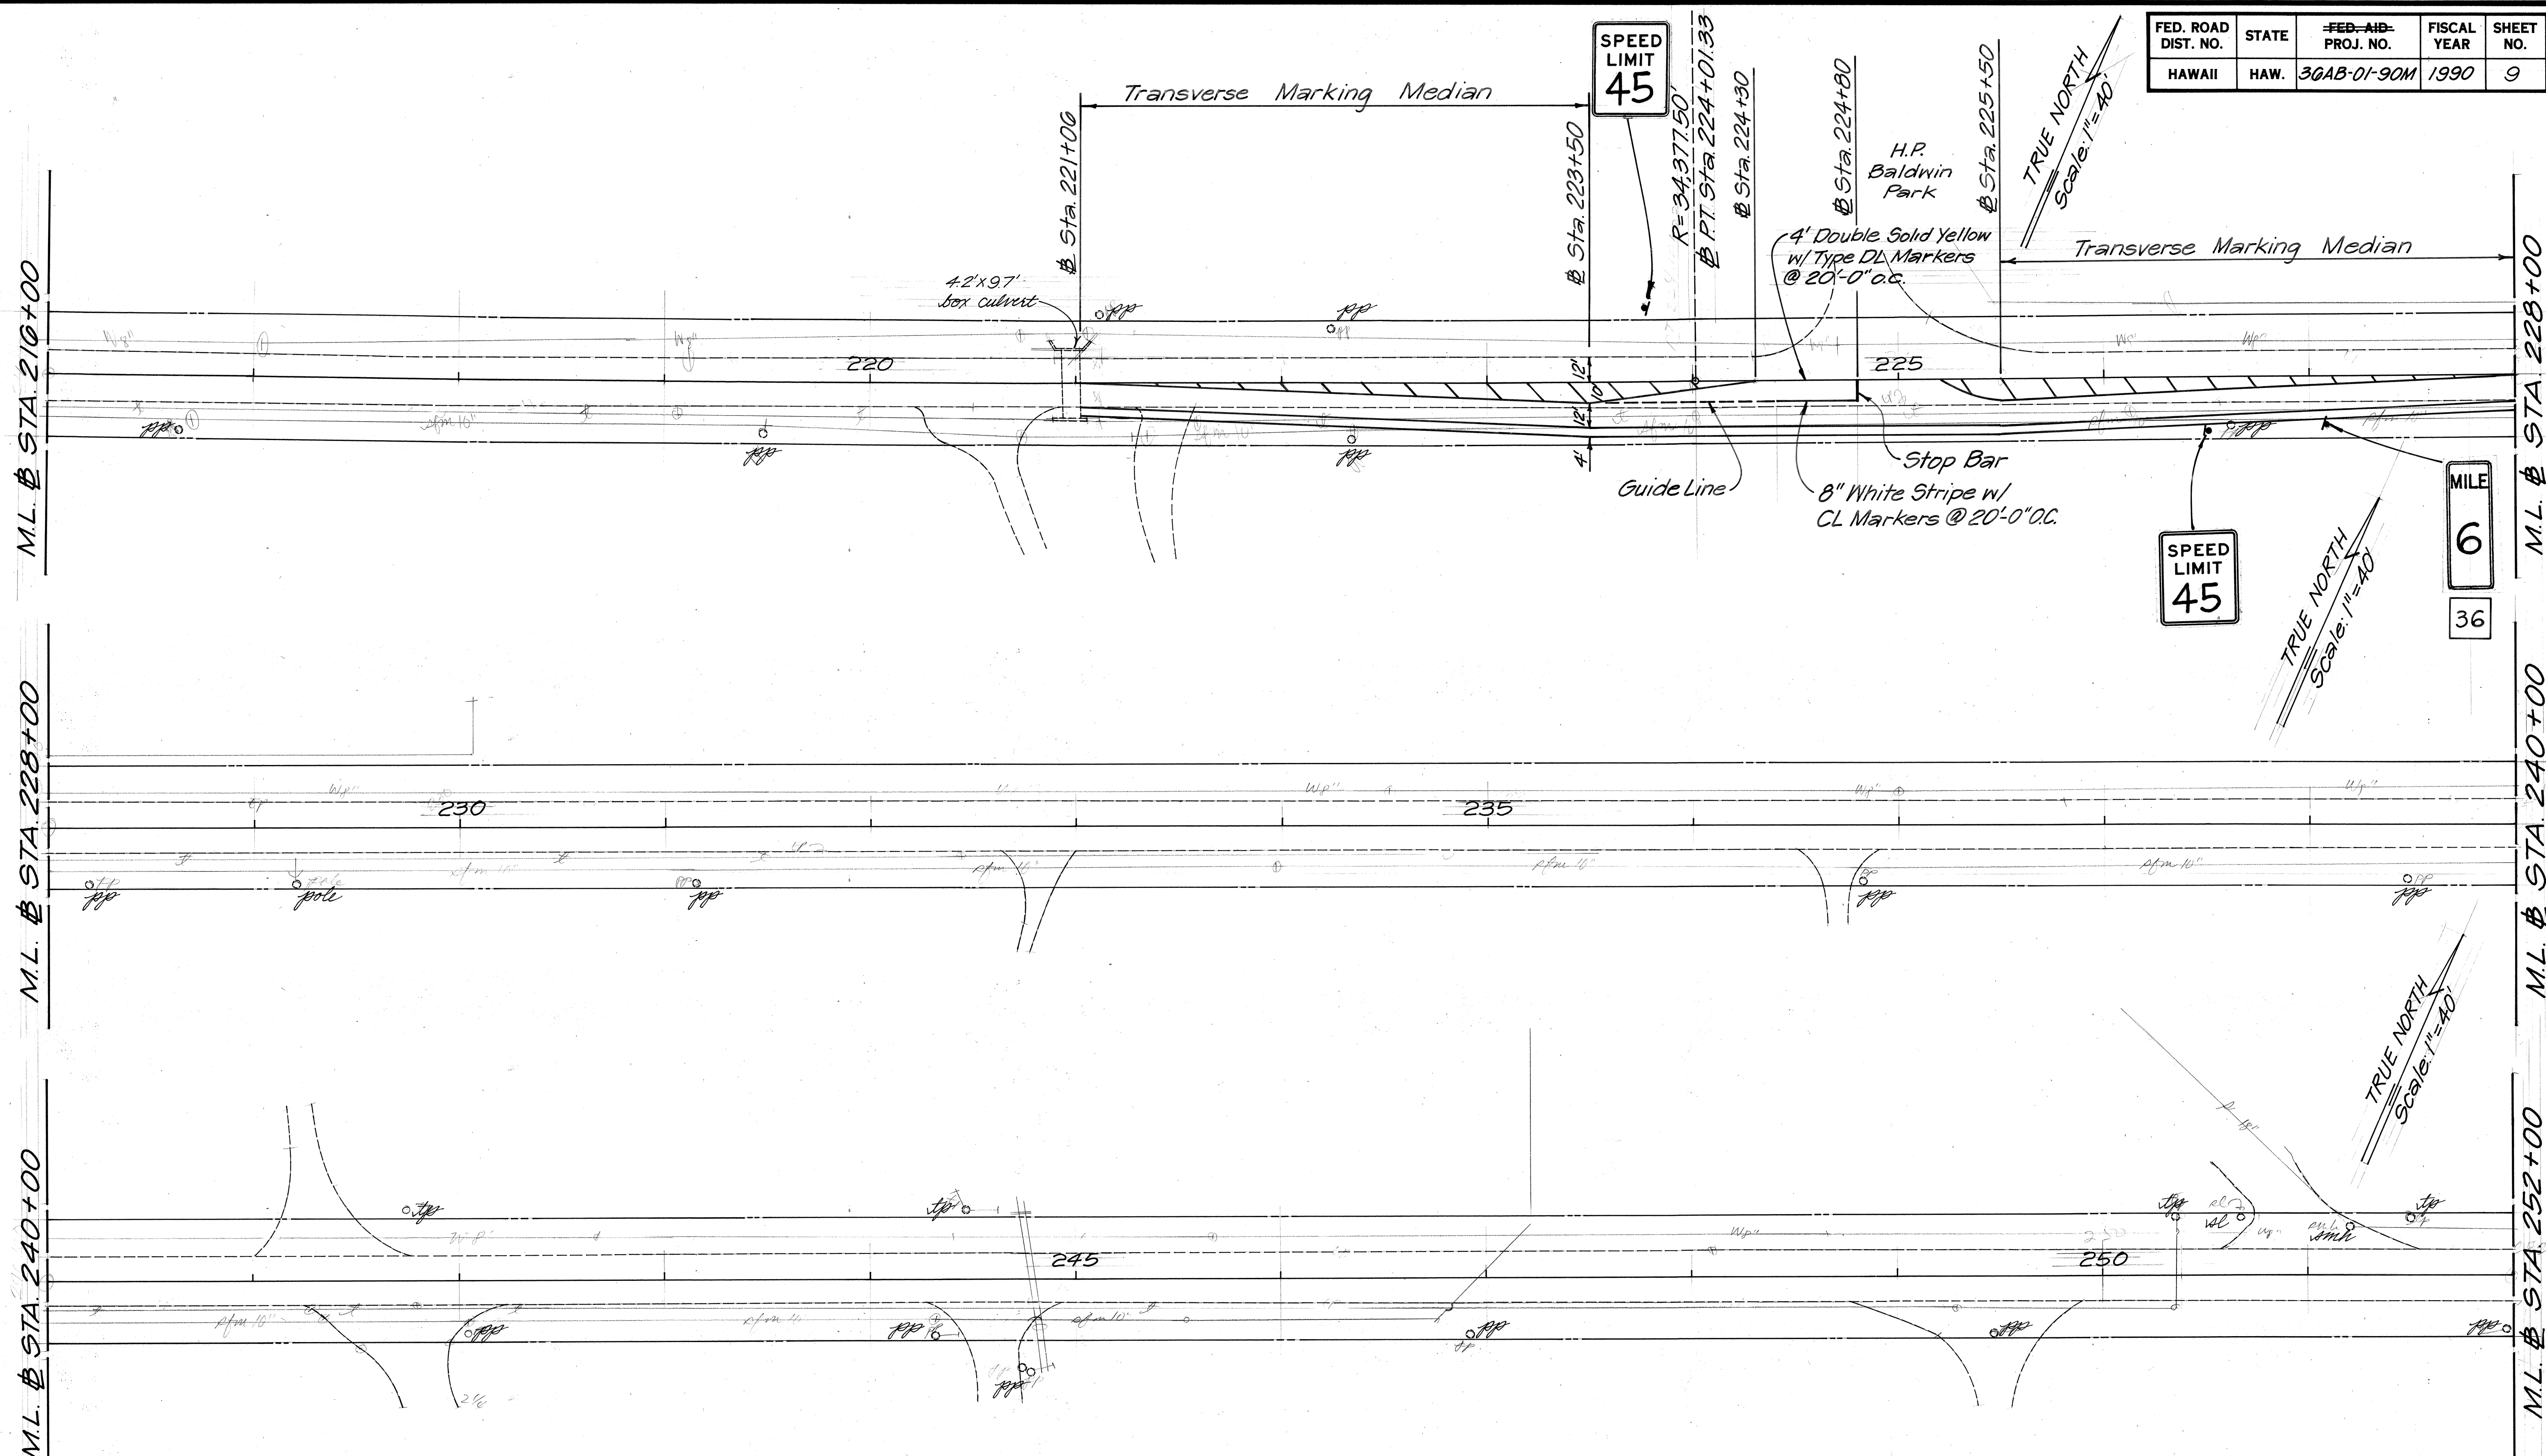


FED. ROAD DIST. NO.	STATE	FED. AID PROJ. NO.	FISCAL YEAR	SHEET NO.	TOTAL SHEETS
HAWAII	HAW.	36AB-01-90M	1990	9	10

STATE OF HAWAII
DEPARTMENT OF TRANSPORTATION
HIGHWAYS DIVISION

ROADWAY PLAN

HANA HIGHWAY RESURFACING
Haleakala Hwy to Hookipa Park
Proj. No. 36AB-01-90M
Scale: 1" = 40' Date: April, 1990
SHEET NO. 6 OF 12 SHEETS

ORIGINAL PLAN	SURVEY PLOTTED BY	DATE
NOTE BOOK	DRAWN BY	
No.	DESIGNED BY	
	QUANTITIES BY	
	CHECKED BY	

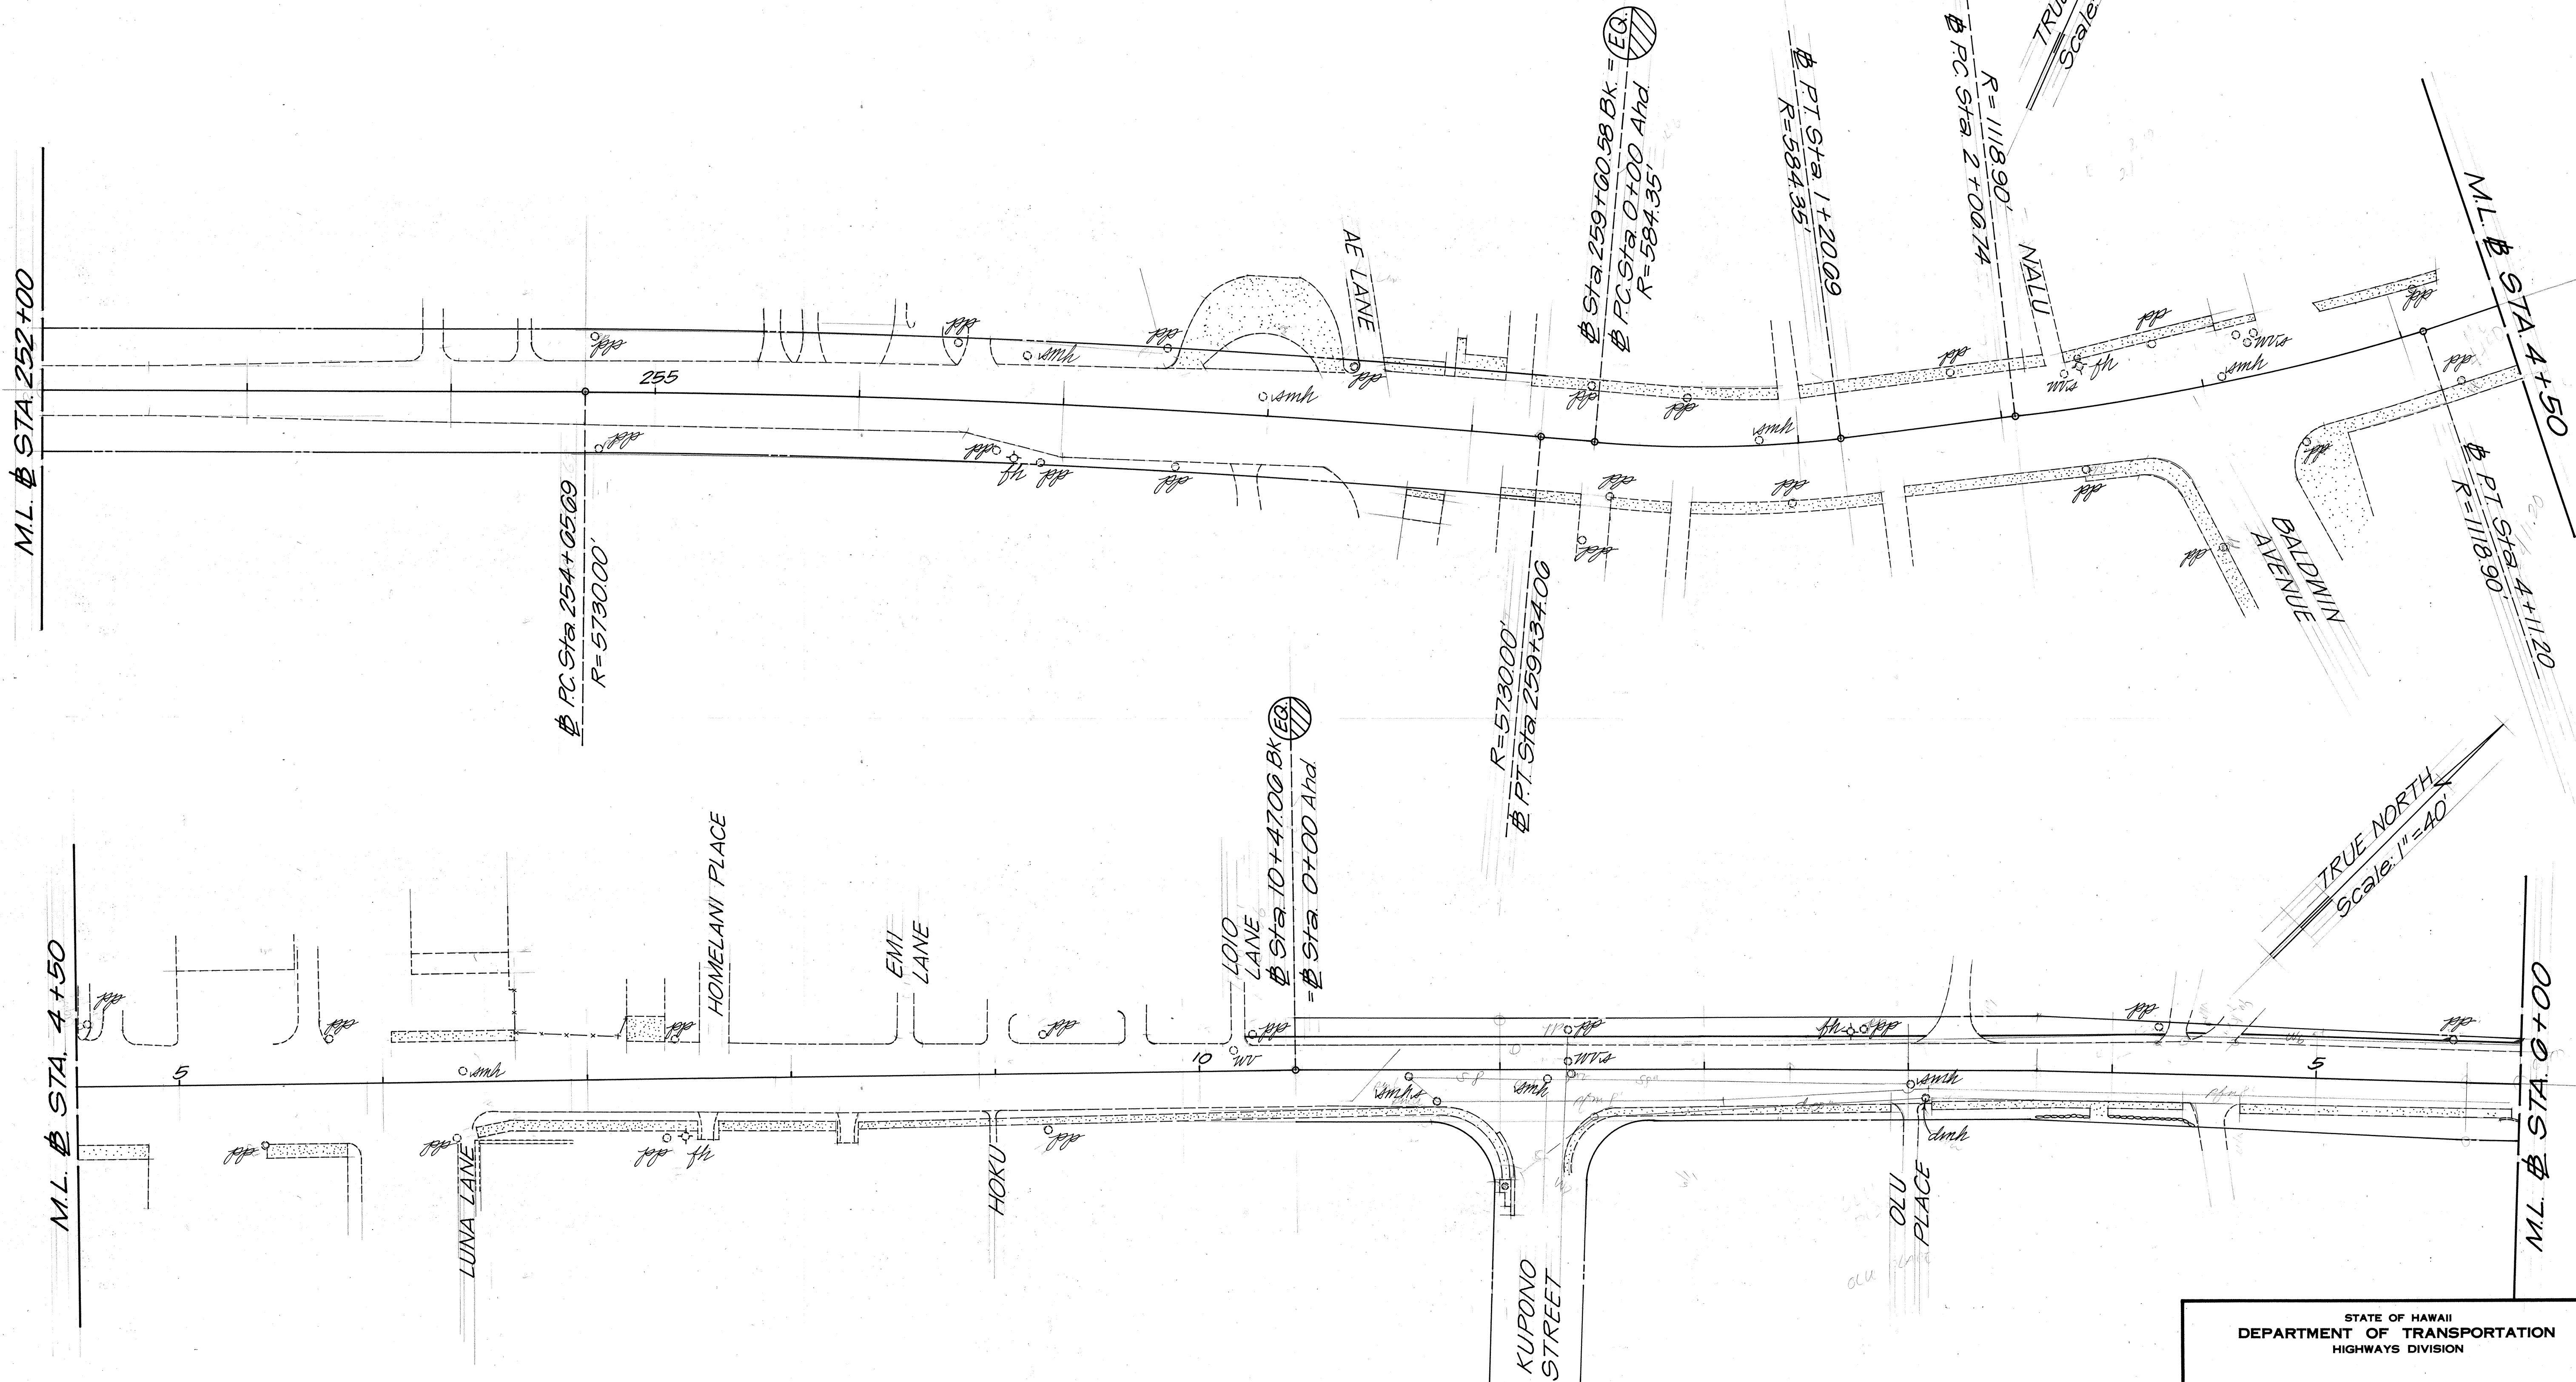

FED. ROAD DIST. NO.	STATE	FED-AID- PROJ. NO.	FISCAL YEAR	SHEET NO.	TOTAL SHEETS
HAWAII	HAW.	30AB-01-90M	1990	10	10


STATE OF HAWAII
DEPARTMENT OF TRANSPORTATION
HIGHWAYS DIVISION

ROADWAY PLAN

HANA HIGHWAY RESURFACING
 Haleakala Hwy to Hookipa Park
 Proj. No. 30AB-01-90M
 Scale: 1"=40' Date: April, 1990

SHEET No. 7 OF 12 SHEETS

FED. ROAD DIST. NO.	STATE	FED-AID PROJ. NO.	FISCAL YEAR	SHEET NO.	TOTAL SHEETS
HAWAII	HAW.	3GAB-01-90M	1990	11	10

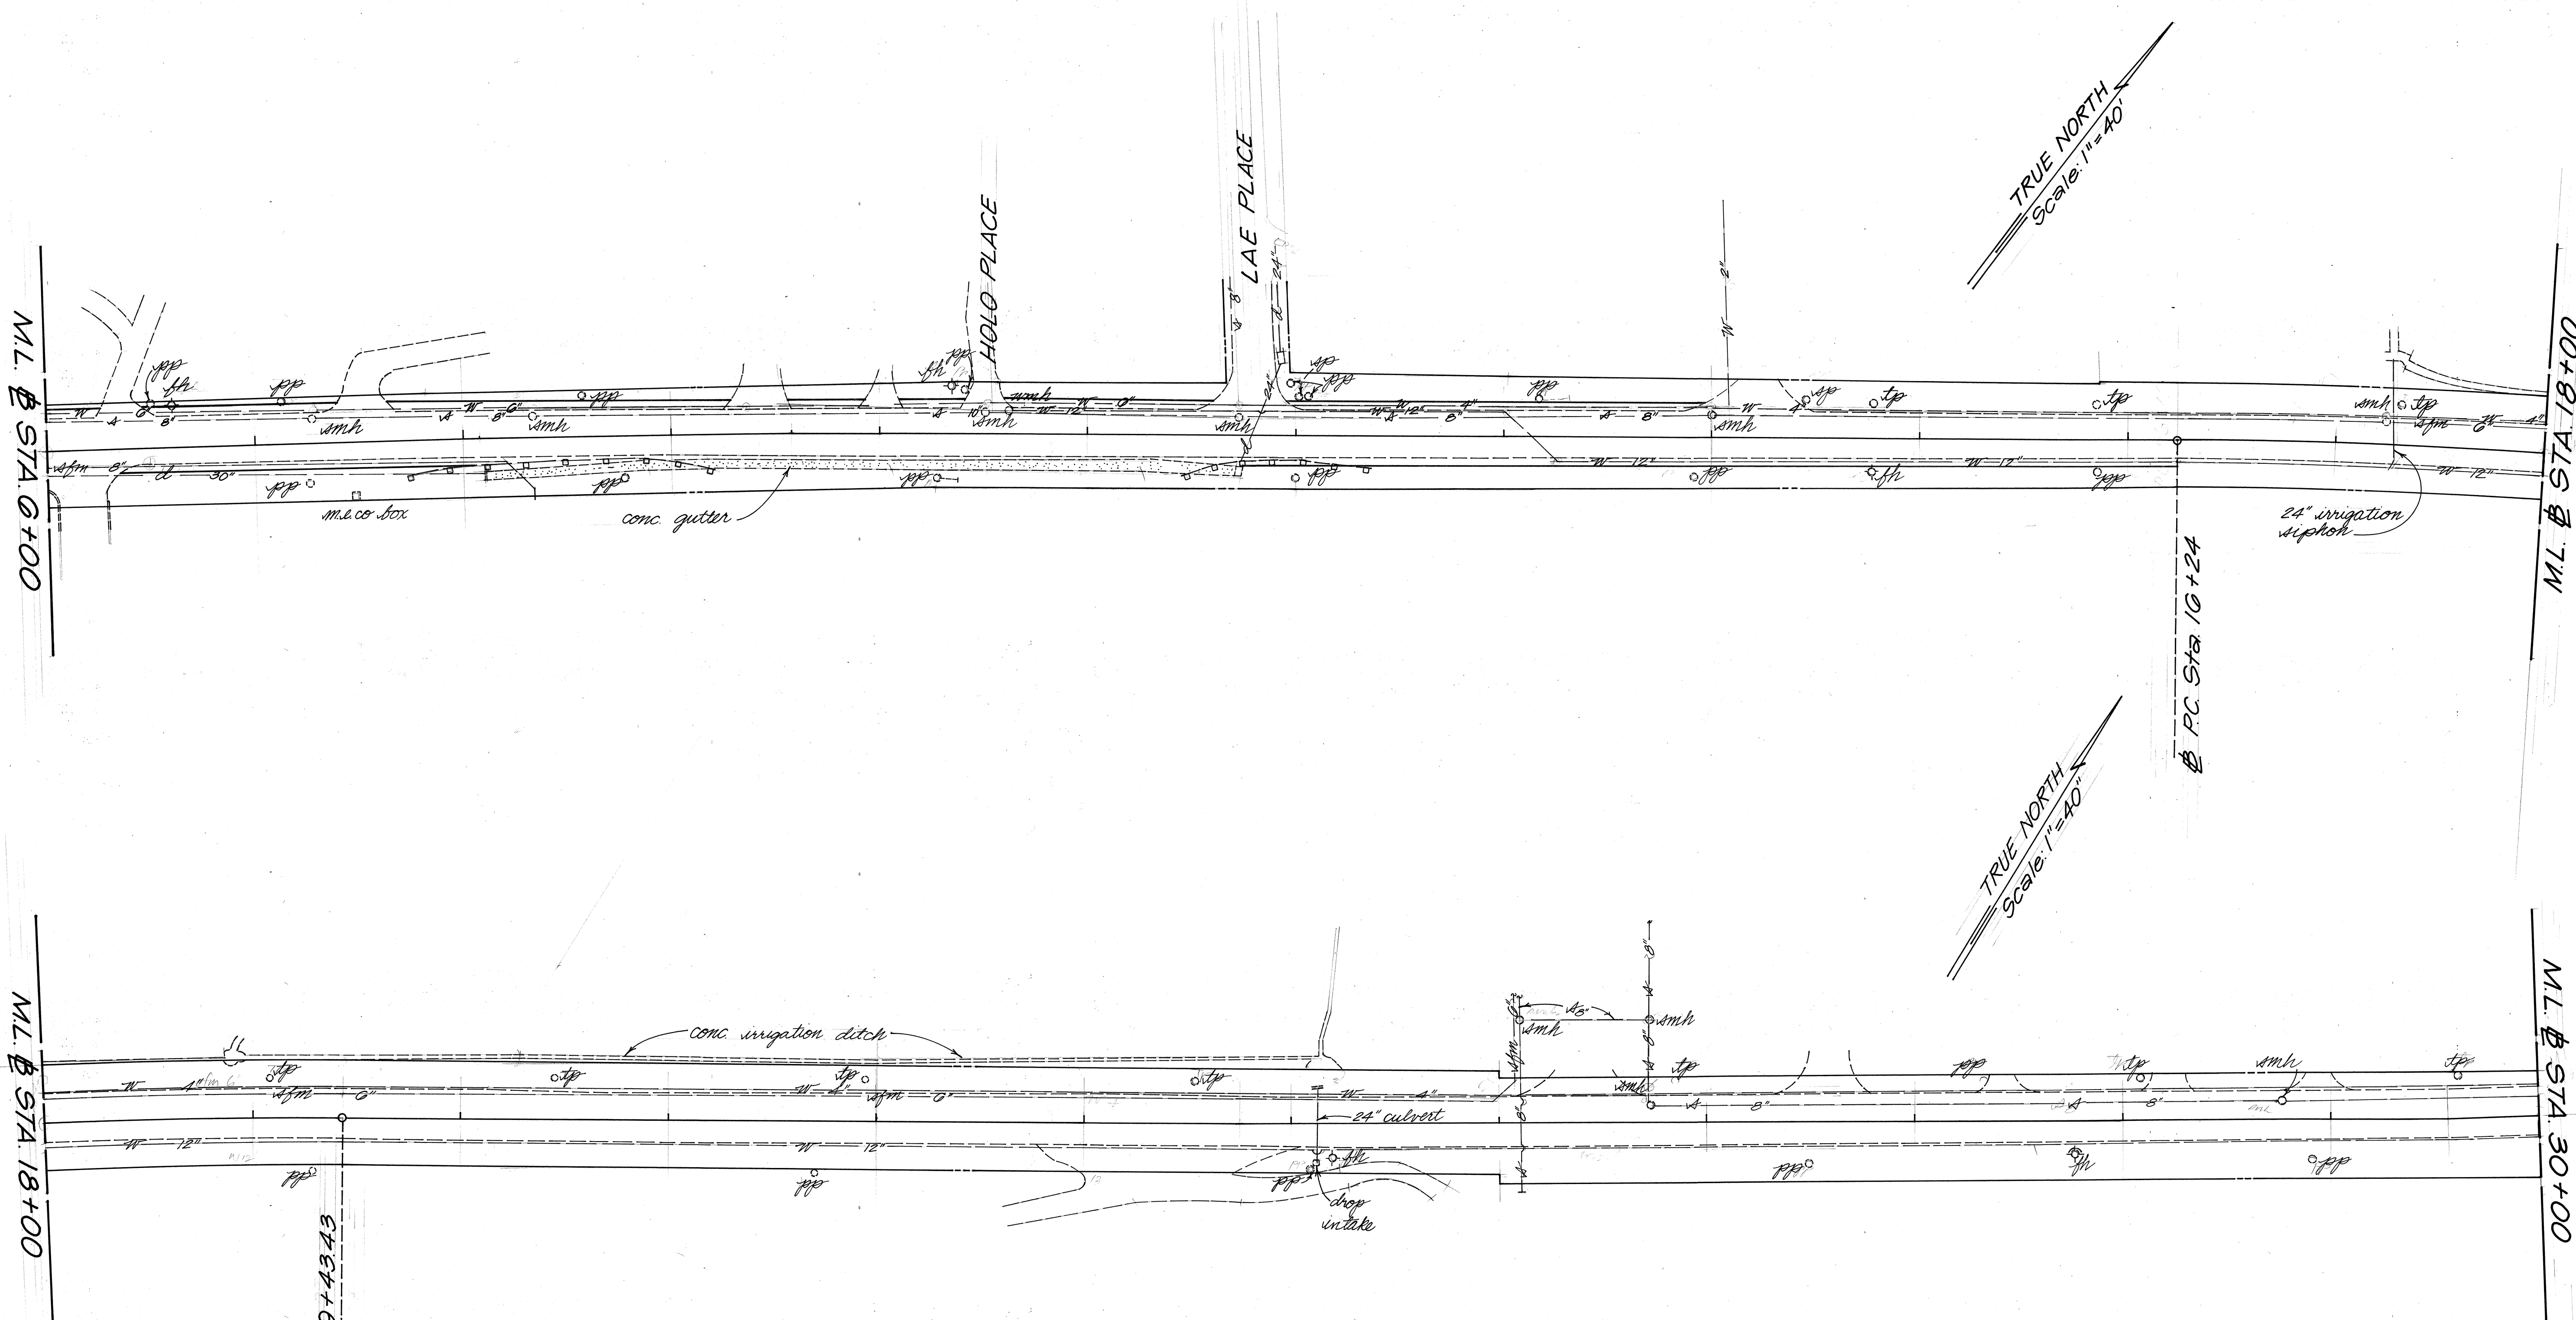

ORIGINAL PLAN	SURVEY PLOTTED BY	DATE
NOTE BOOK	DRAWN BY	
No.	DESIGNED BY	
	QUANTITIES BY	
	CHECKED BY	

STATE OF HAWAII
DEPARTMENT OF TRANSPORTATION
HIGHWAYS DIVISION


ROADWAY PLAN

HANA HIGHWAY RESURFACING
Haleakala Hwy to Hookipa Park
Proj. No. 3GAB-01-90M
Scale: 1" = 40' Date: April, 1990

SHEET NO. 8 OF 12 SHEETS

107888

FED. ROAD DIST. NO.	STATE	FED. PROJ. NO.	FISCAL YEAR	SHEET NO.	TOTAL SHEETS
HAWAII	HAW.	36AB-01-90M	1990	12	16

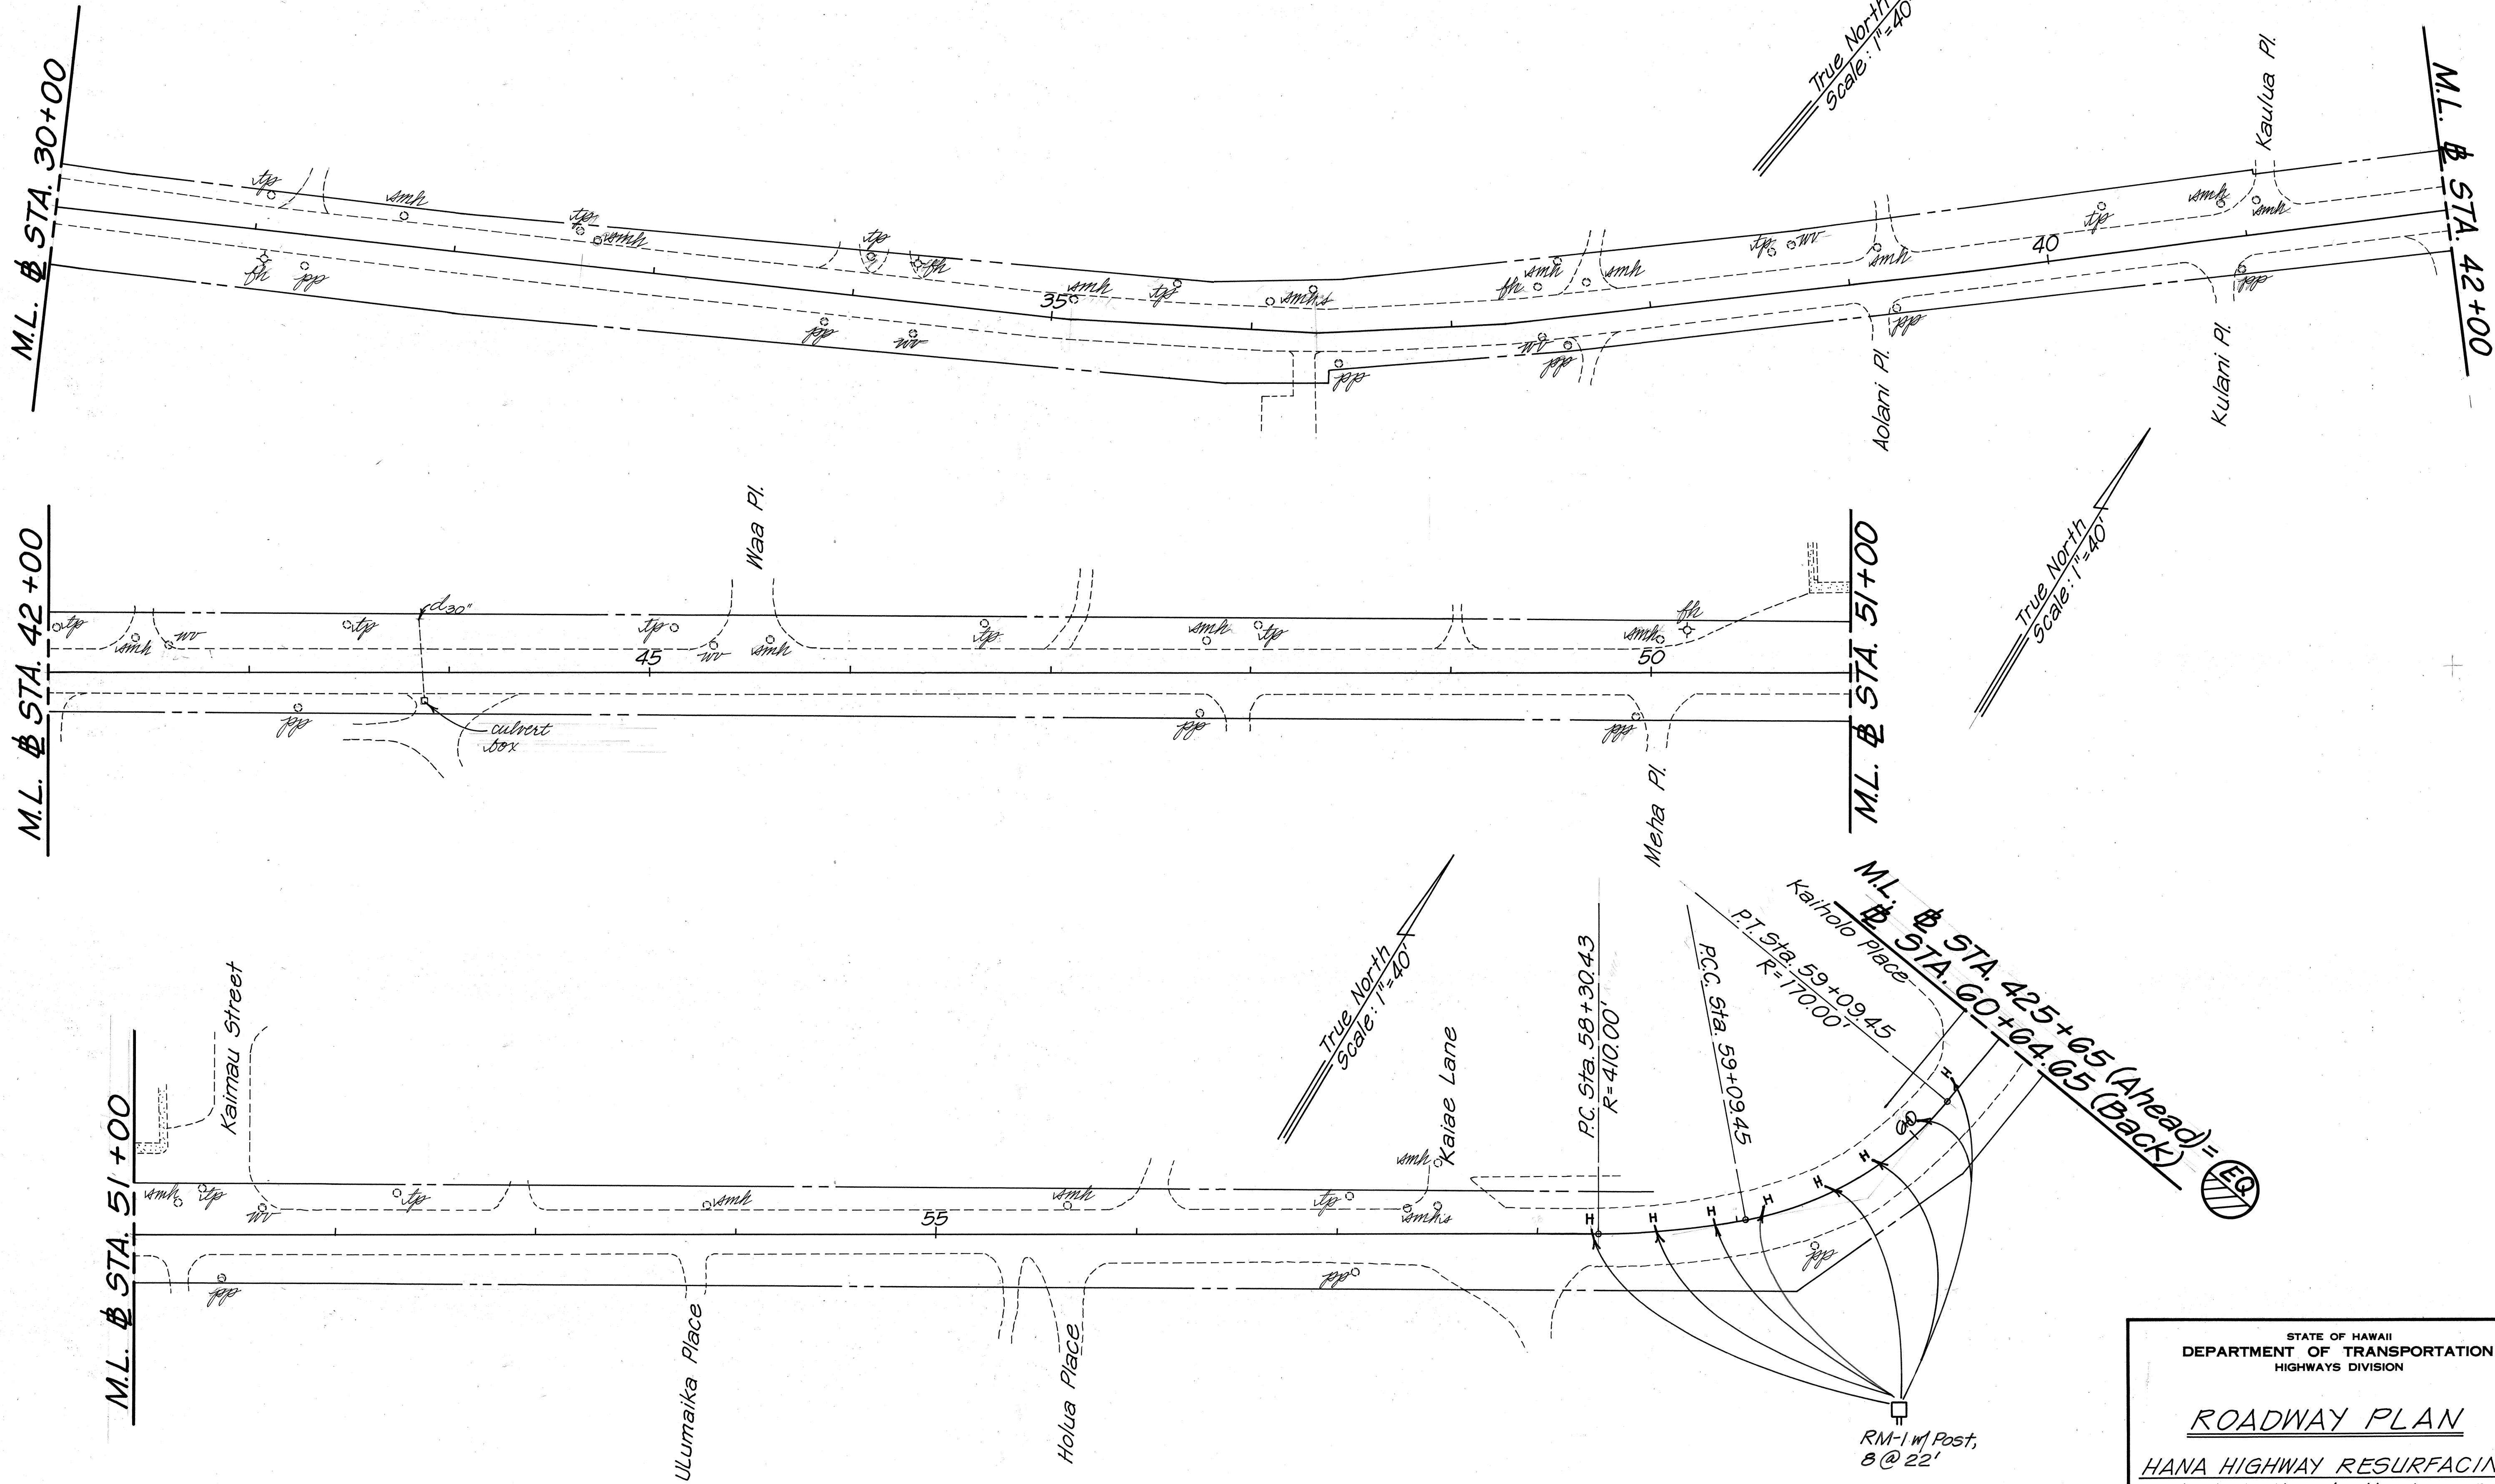

ORIGINAL PLAN	SURVEY PLOTTED BY	DATE
NOTE BOOK	DRAWN BY	
No.	DESIGNED BY	
	QUANTITIES BY	
	CHECKED BY	

STATE OF HAWAII
DEPARTMENT OF TRANSPORTATION
HIGHWAYS DIVISION

ROADWAY PLAN

HANA HIGHWAY RESURFACING
Haleakala Hwy. to Hookipa Park
Proj. No. 36AB-01-90M


Scale: 1" = 40' Date: April, 1990

SHEET No. 9 OF 12 SHEETS

107688

FED. ROAD DIST. NO.	STATE	FED. RD. PROJ. NO.	FISCAL YEAR	SHEET NO.	TOTAL SHEETS
HAWAII	HAW.	36AB-01-90M	1990	13	16

ORIGINAL PLAN	SURVEY PLOTTED BY	DATE
NOTE BOOK	DRAWN BY	
No.	DESIGNED BY	
	QUANTITIES BY	
	CHECKED BY	

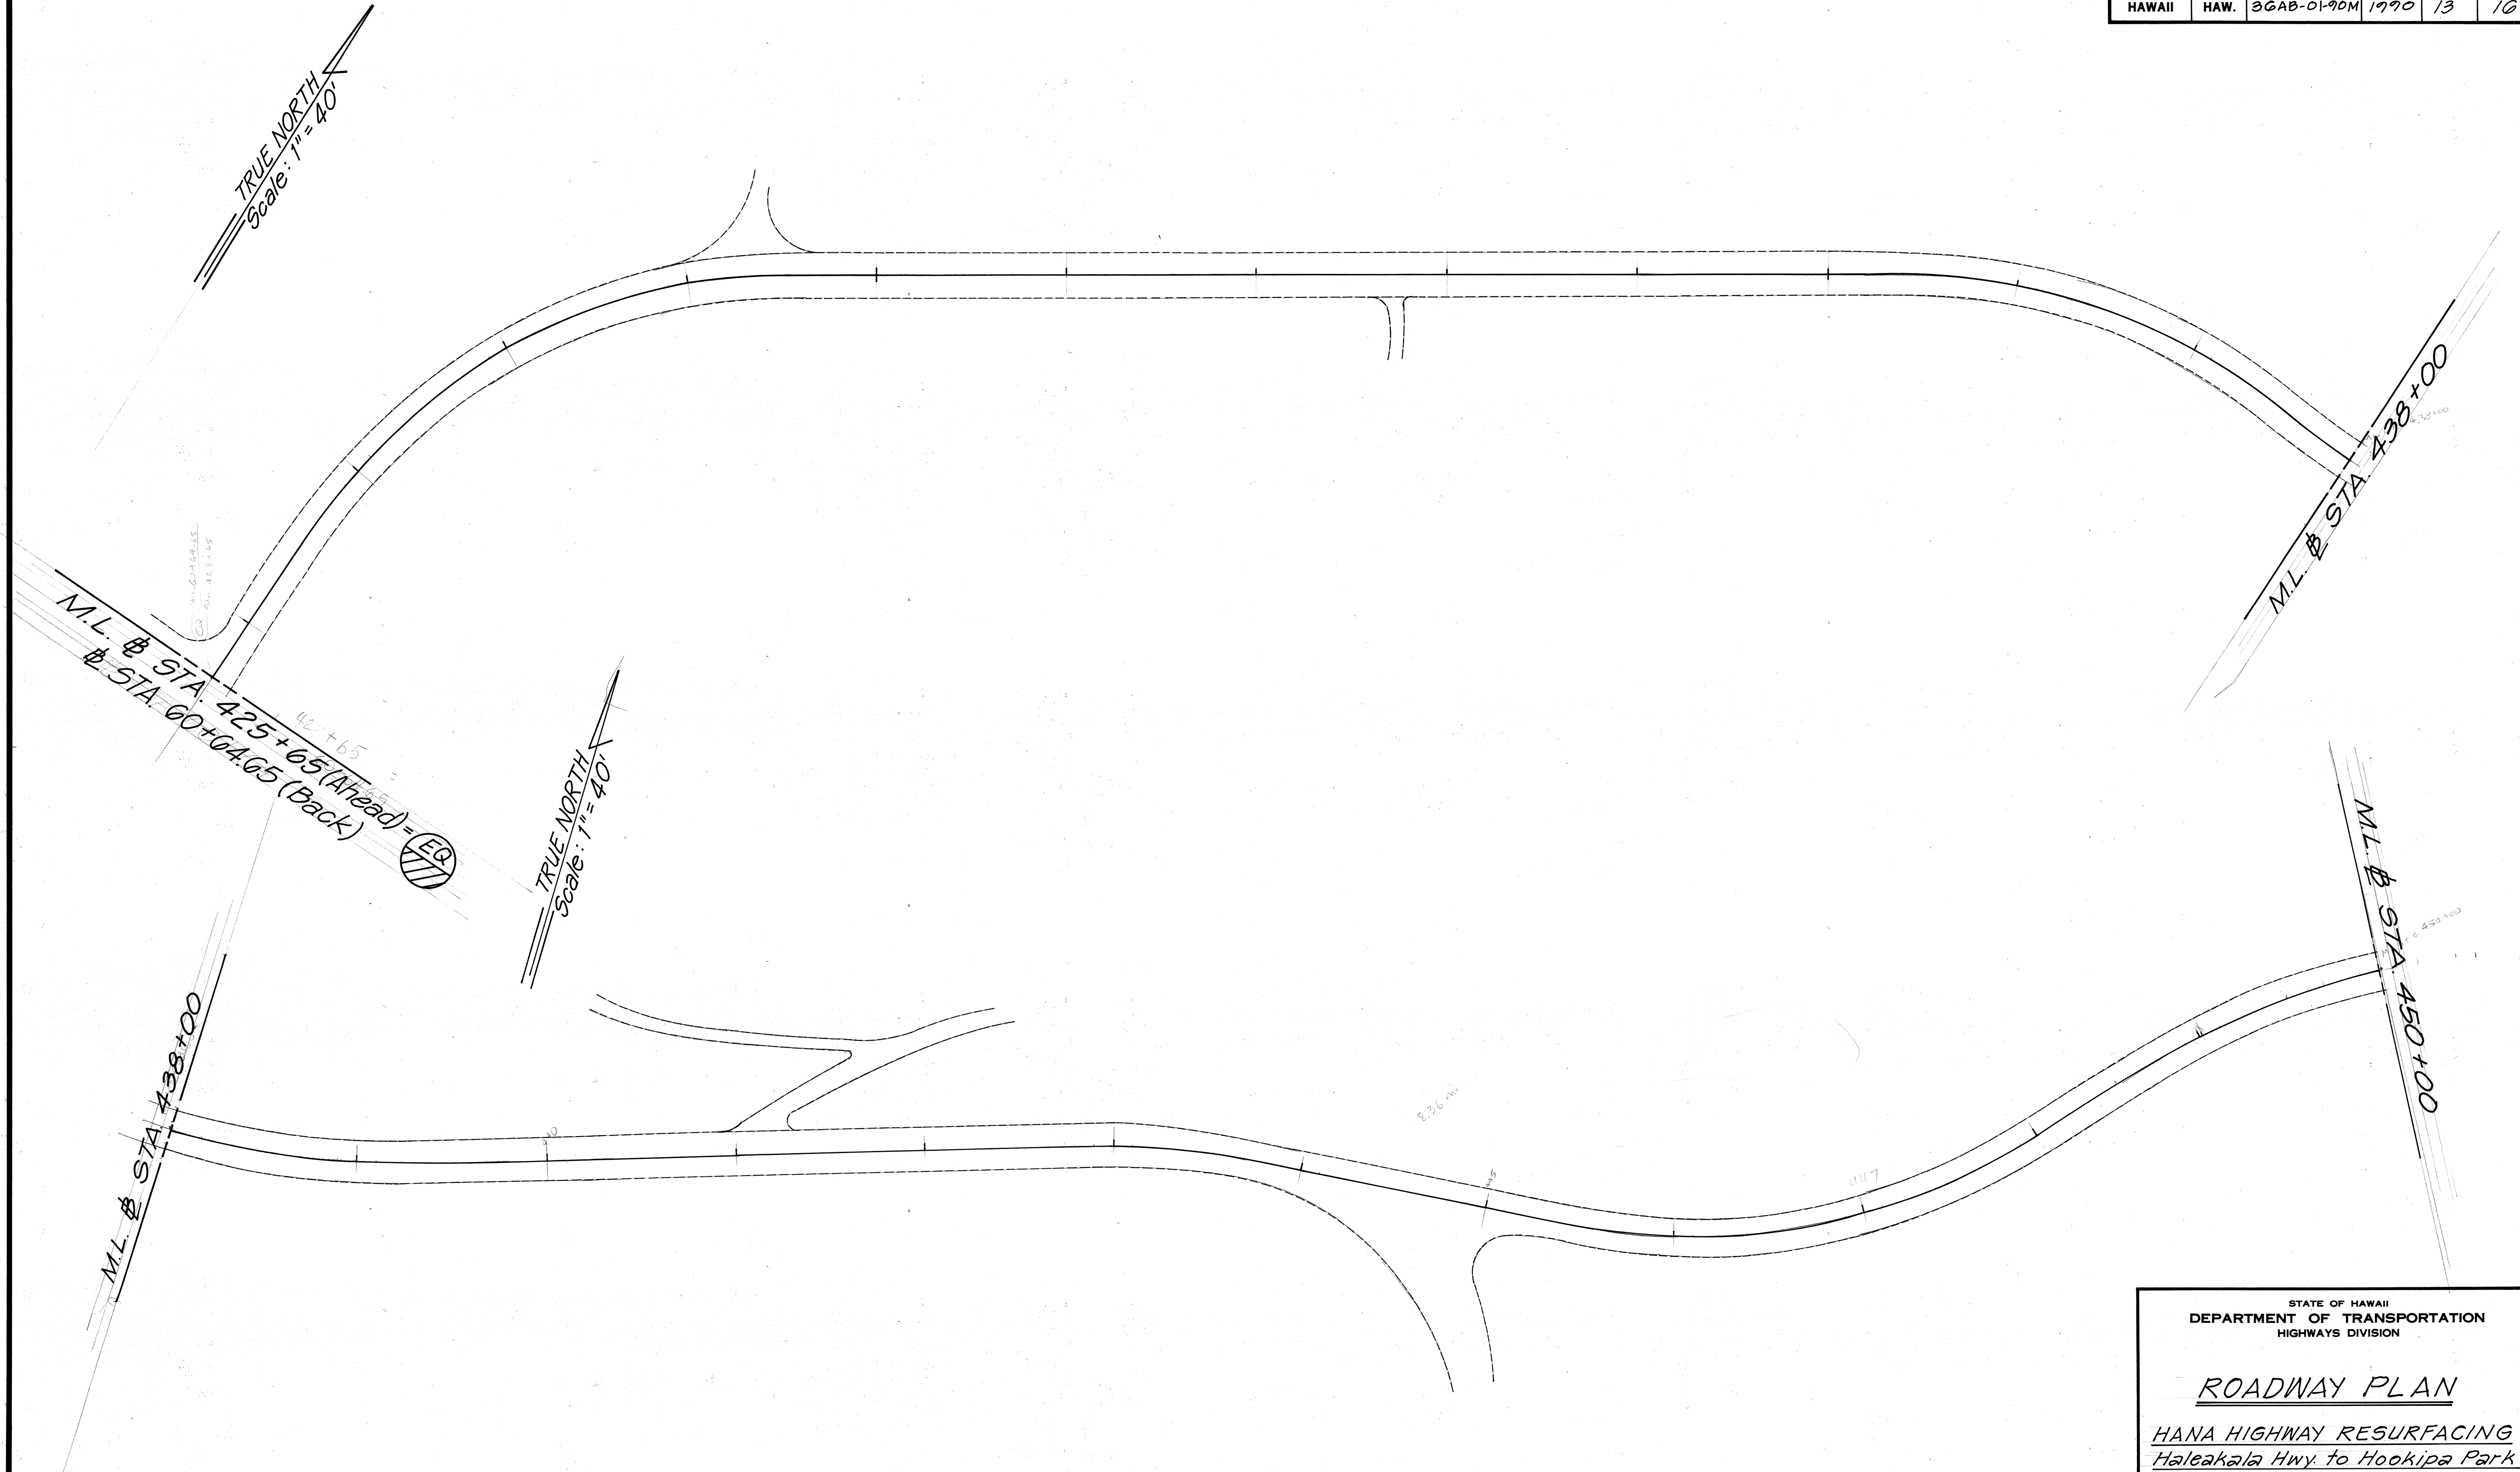

STATE OF HAWAII
DEPARTMENT OF TRANSPORTATION
HIGHWAYS DIVISION

ROADWAY PLAN

HANA HIGHWAY RESURFACING
Haleakala Hwy to Hookipa Park
Proj. No. 36AB-01-90M
Scale: 1"=40' Date: April, 1990

SHEET No. 10 OF 12 SHEETS

FED. ROAD DIST. NO.	STATE	FED. AID PROJ. NO.	FISCAL YEAR	SHEET NO.	TOTAL SHEETS
HAWAII	HAW.	36AB-01-90M	1990	14	16

TRUE NORTH

West Entrance
to Hookipa
Park

TRUE NORTH
Scale: 1" = 40'

EQ. Φ Sta. 407+75 Back = Φ Sta. 112+00 Ahead

PC Sta 114+50
R=1238.83'

Ø P.T. Sta. 115+50

STATE OF HAWAII
DEPARTMENT OF TRANSPORTATION
HIGHWAYS DIVISION

ROADWAY PLAN

HANA HIGHWAY RESURFACING
Haleakala Hwy. to Hookipa Park
Proj. No. 36AB-01-90M


Scale: 1" = 40' Date: April, 1990

SHEET NO. 11 OF 12 SHEETS

144

107688

FED. ROAD DIST. NO.	STATE	FED. AID PROJ. NO.	FISCAL YEAR	SHEET NO.	TOTAL SHEETS
HAWAII	HAW.	36AB-01-90M	1990	15	10

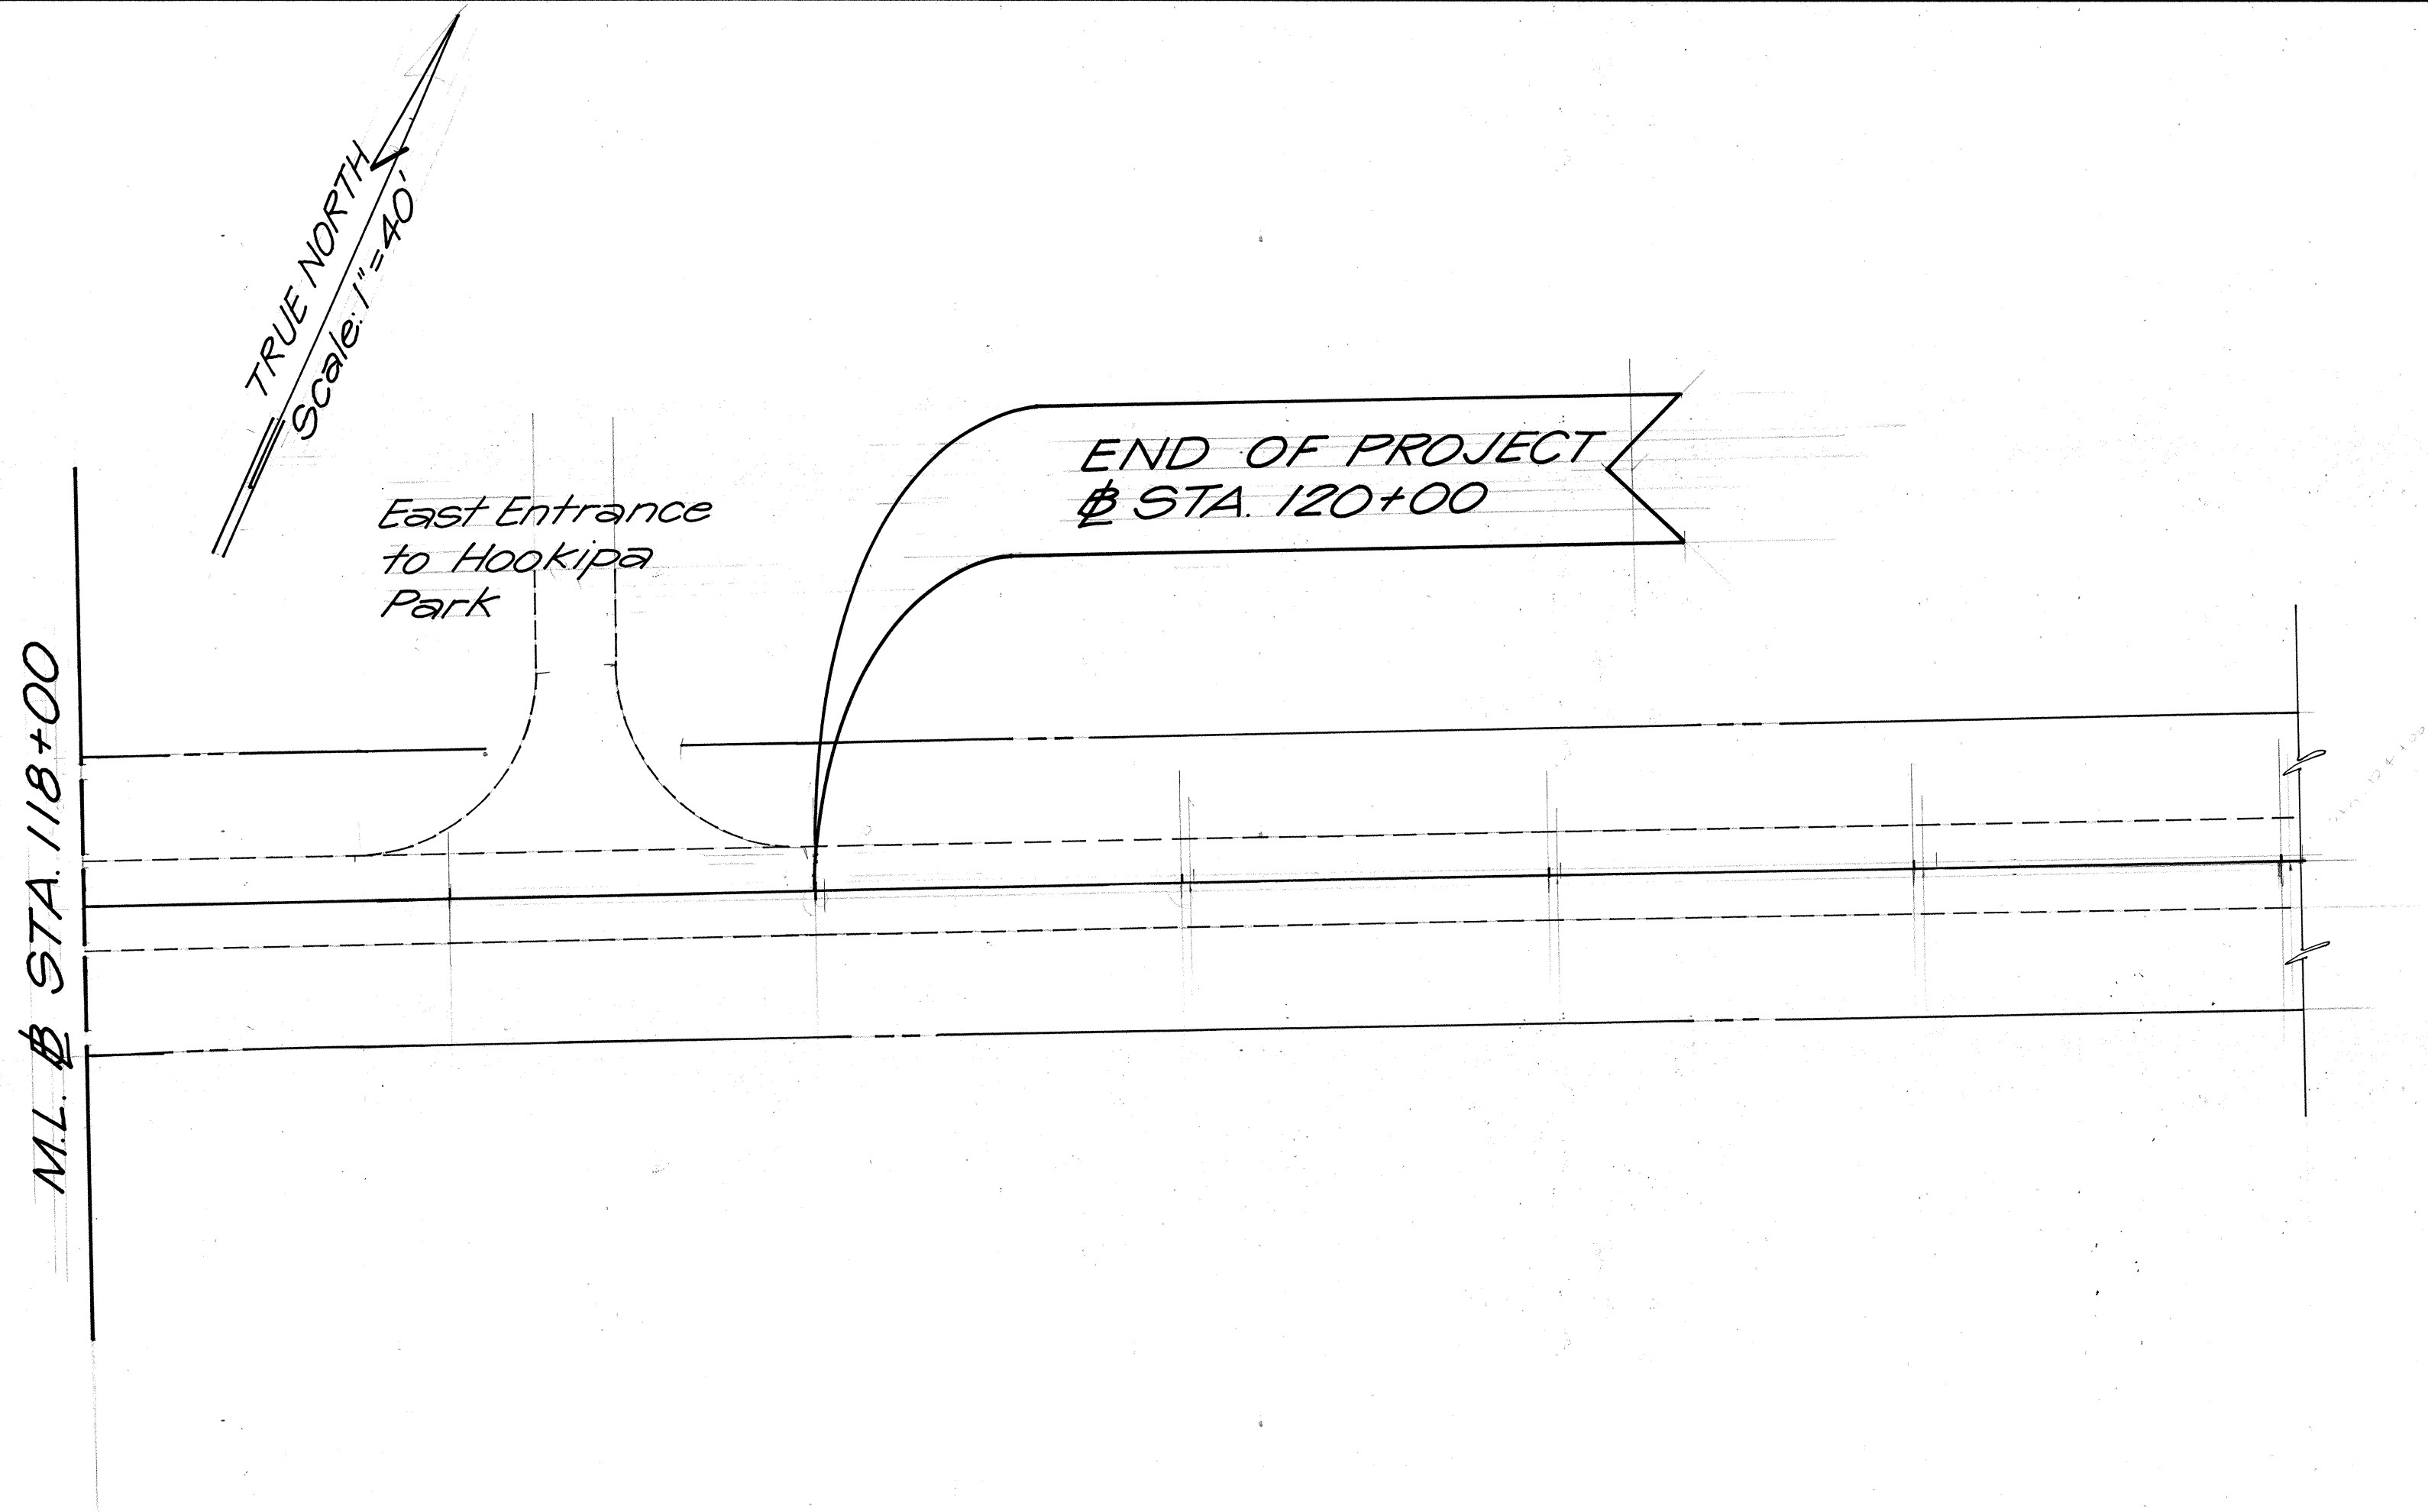

ORIGINAL PLAN	SURVEY PLOTTED BY	DATE
NOTE BOOK	DRAWN BY	
No.	DESIGNED BY	
	QUANTITIES BY	
	CHECKED BY	

STATE OF HAWAII
DEPARTMENT OF TRANSPORTATION
HIGHWAYS DIVISION

ROADWAY PLAN

HANA HIGHWAY RESURFACING
Haleakala Hwy to Hookipa Park
Proj. No. 36AB-01-90M
Scale: 1"=40' Date: April, 1990

SHEET No. 12 OF 12 SHEETS