		INDEX TO DRAWINGS
	SHEET NO.	DESCRIPTION
	l	TITLE SHEET
	2	STANDARD PLANS SUMMARY
,	3	GENERAL NOTES AND TYPICAL
		SECTIONS
(A)	4-15	ROADWAY PLANS
	16	PAVEMENT MARKING, SIGN
		SCHEDULES, AND NOTES
\$ P.		
	·	
		• .
¥		
. 7	(A) 7A IS A SUPPLEMENT SHEET TO THE CONTRACT PLANS. NEW TOTAL = 17 SHEETS	


STATE OF HAWAII

DEPARTMENT OF TRANSPORTATION
HIGHWAYS DIVISION
HONOLULU, HAWAII

"AS-BUILT"
PLANS FOR

HANA HIGHWAY RESURFACING
HALEAKALA HIGHWAY TO HOOKIPA PARK
PROJECT NO. 36AB-OI-90M

DISTRICTS OF WAILUKU AND MAKAWAO
ISLAND OF MAUI

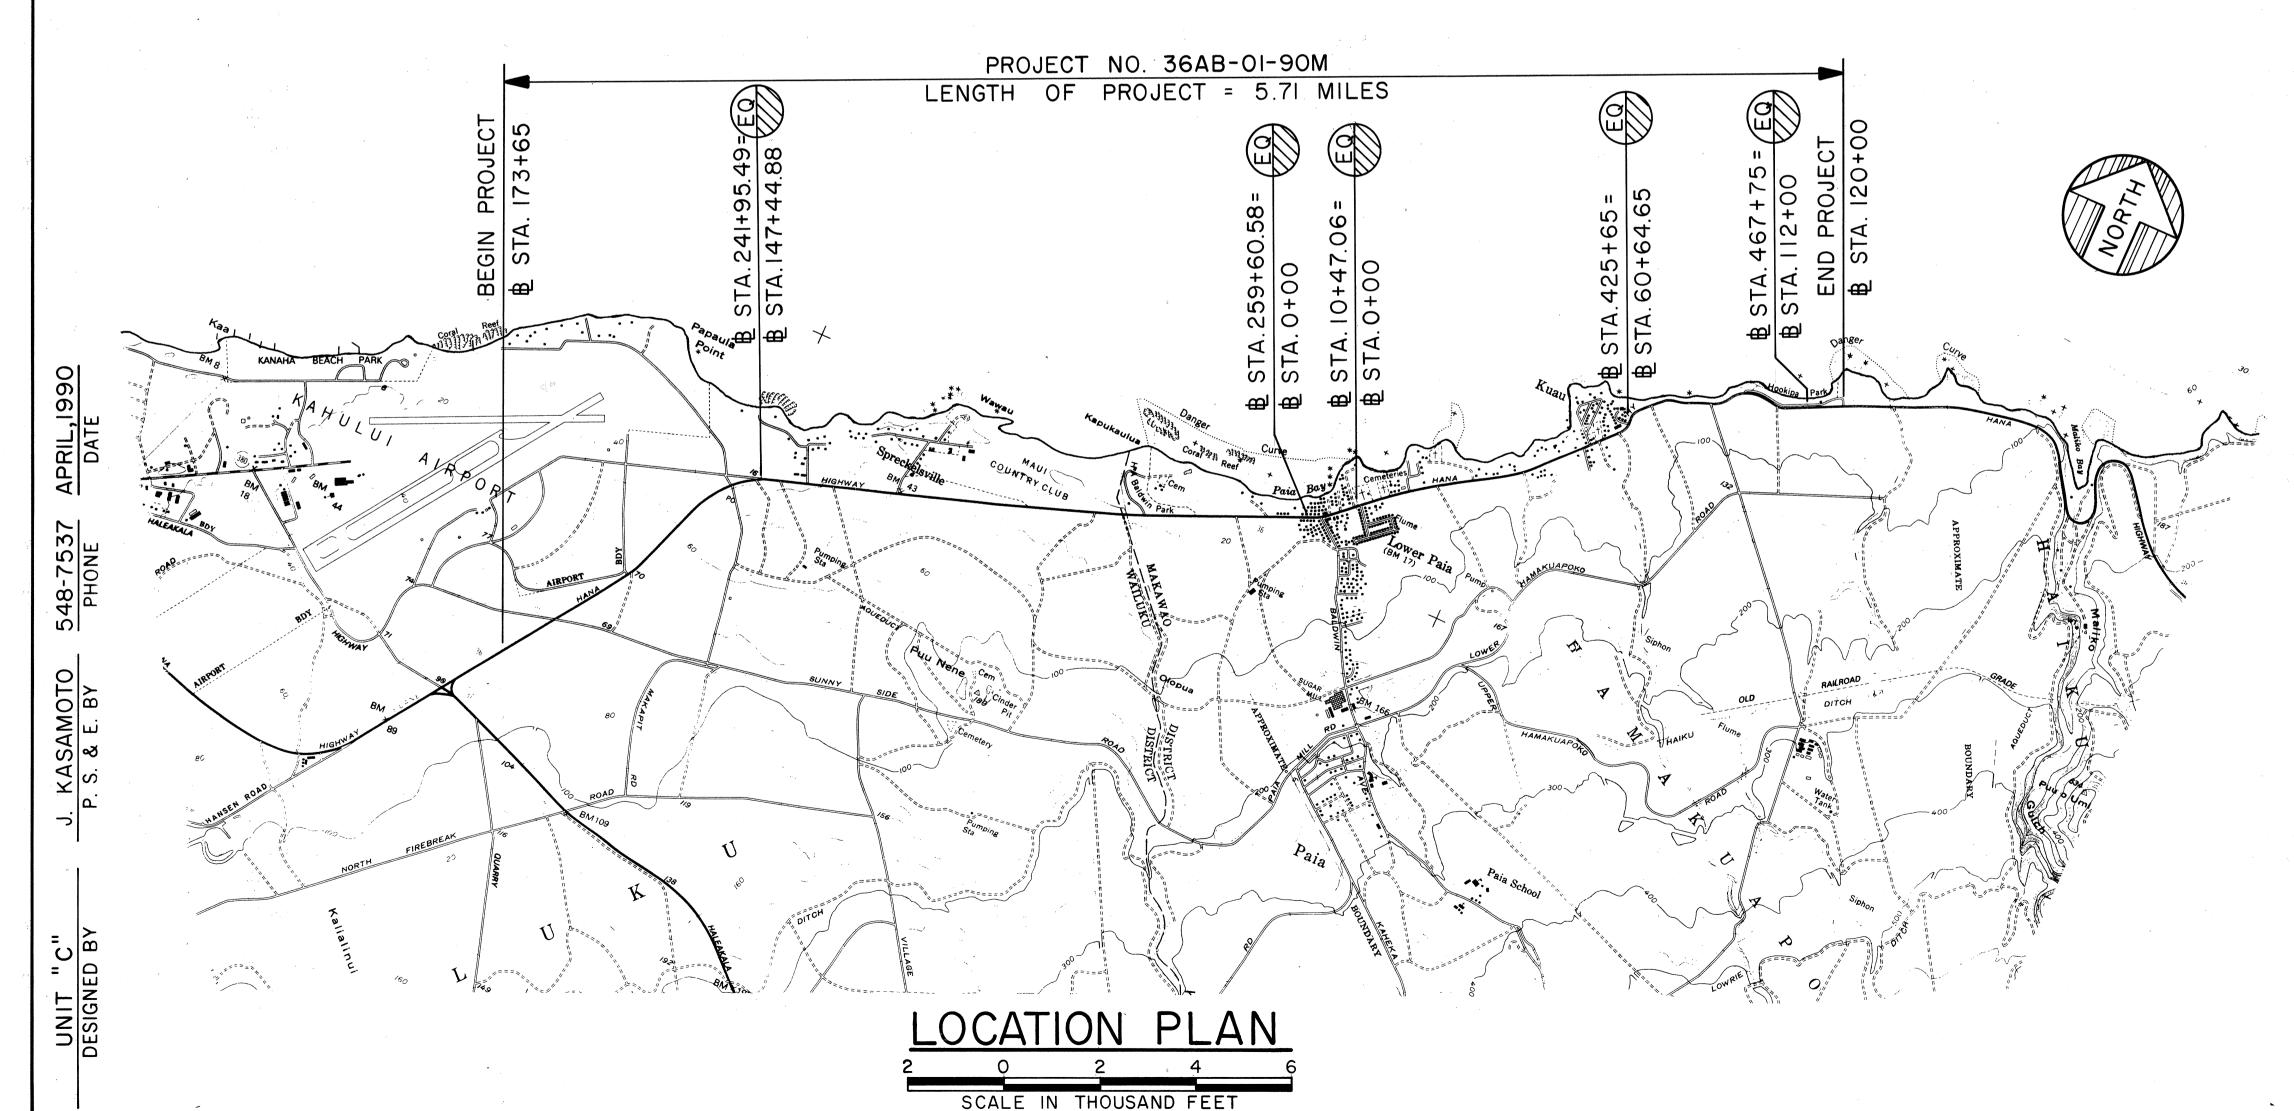

PROJECT
LOCATION

HONOROHAU

KAHAKULOA

KAHA

FED. ROAD DIST. NO.

FEDERAL AID PROJECTS PREVIOUSLY CONSTRUCTED OR UNDER CONSTRUCTION

MILE POST 3.22 TO MILE POST 8.93

CHANGES MADE DURING CONSTRUCTION HAVE BEEN INCORPORATED ON THESE PLANS EXCEPT CHANGES IN THE ORIGINAL THEORETICAL QUANTITIES. FOR ACTUAL QUANTITIES, REFER TO PROJECT LEDGER AND/OR COMPUTATION BOOK.

Michael Mownen RESIDENT ENGINEER

7-17-95 DATE

FISCAL SHEET TOTAL YEAR NO. SHEETS

PROJ. NO.

36AB-01-90M

DEPARTMENT OF TRANSPORTATION STATE OF HAWAII

APPROVED:

DIR. OF TRANSPORTATION

DATE