


FED. ROAD DIST. NO.	STATE	PROJ. NO.	FISCAL YEAR	SHEET NO.	TOTAL SHEETS
HAWAII	HAW.	36B-01-91M	1991	3	6


Remove landslide materials and turn back residual soil to slope indicated prior to construction of CRM facing

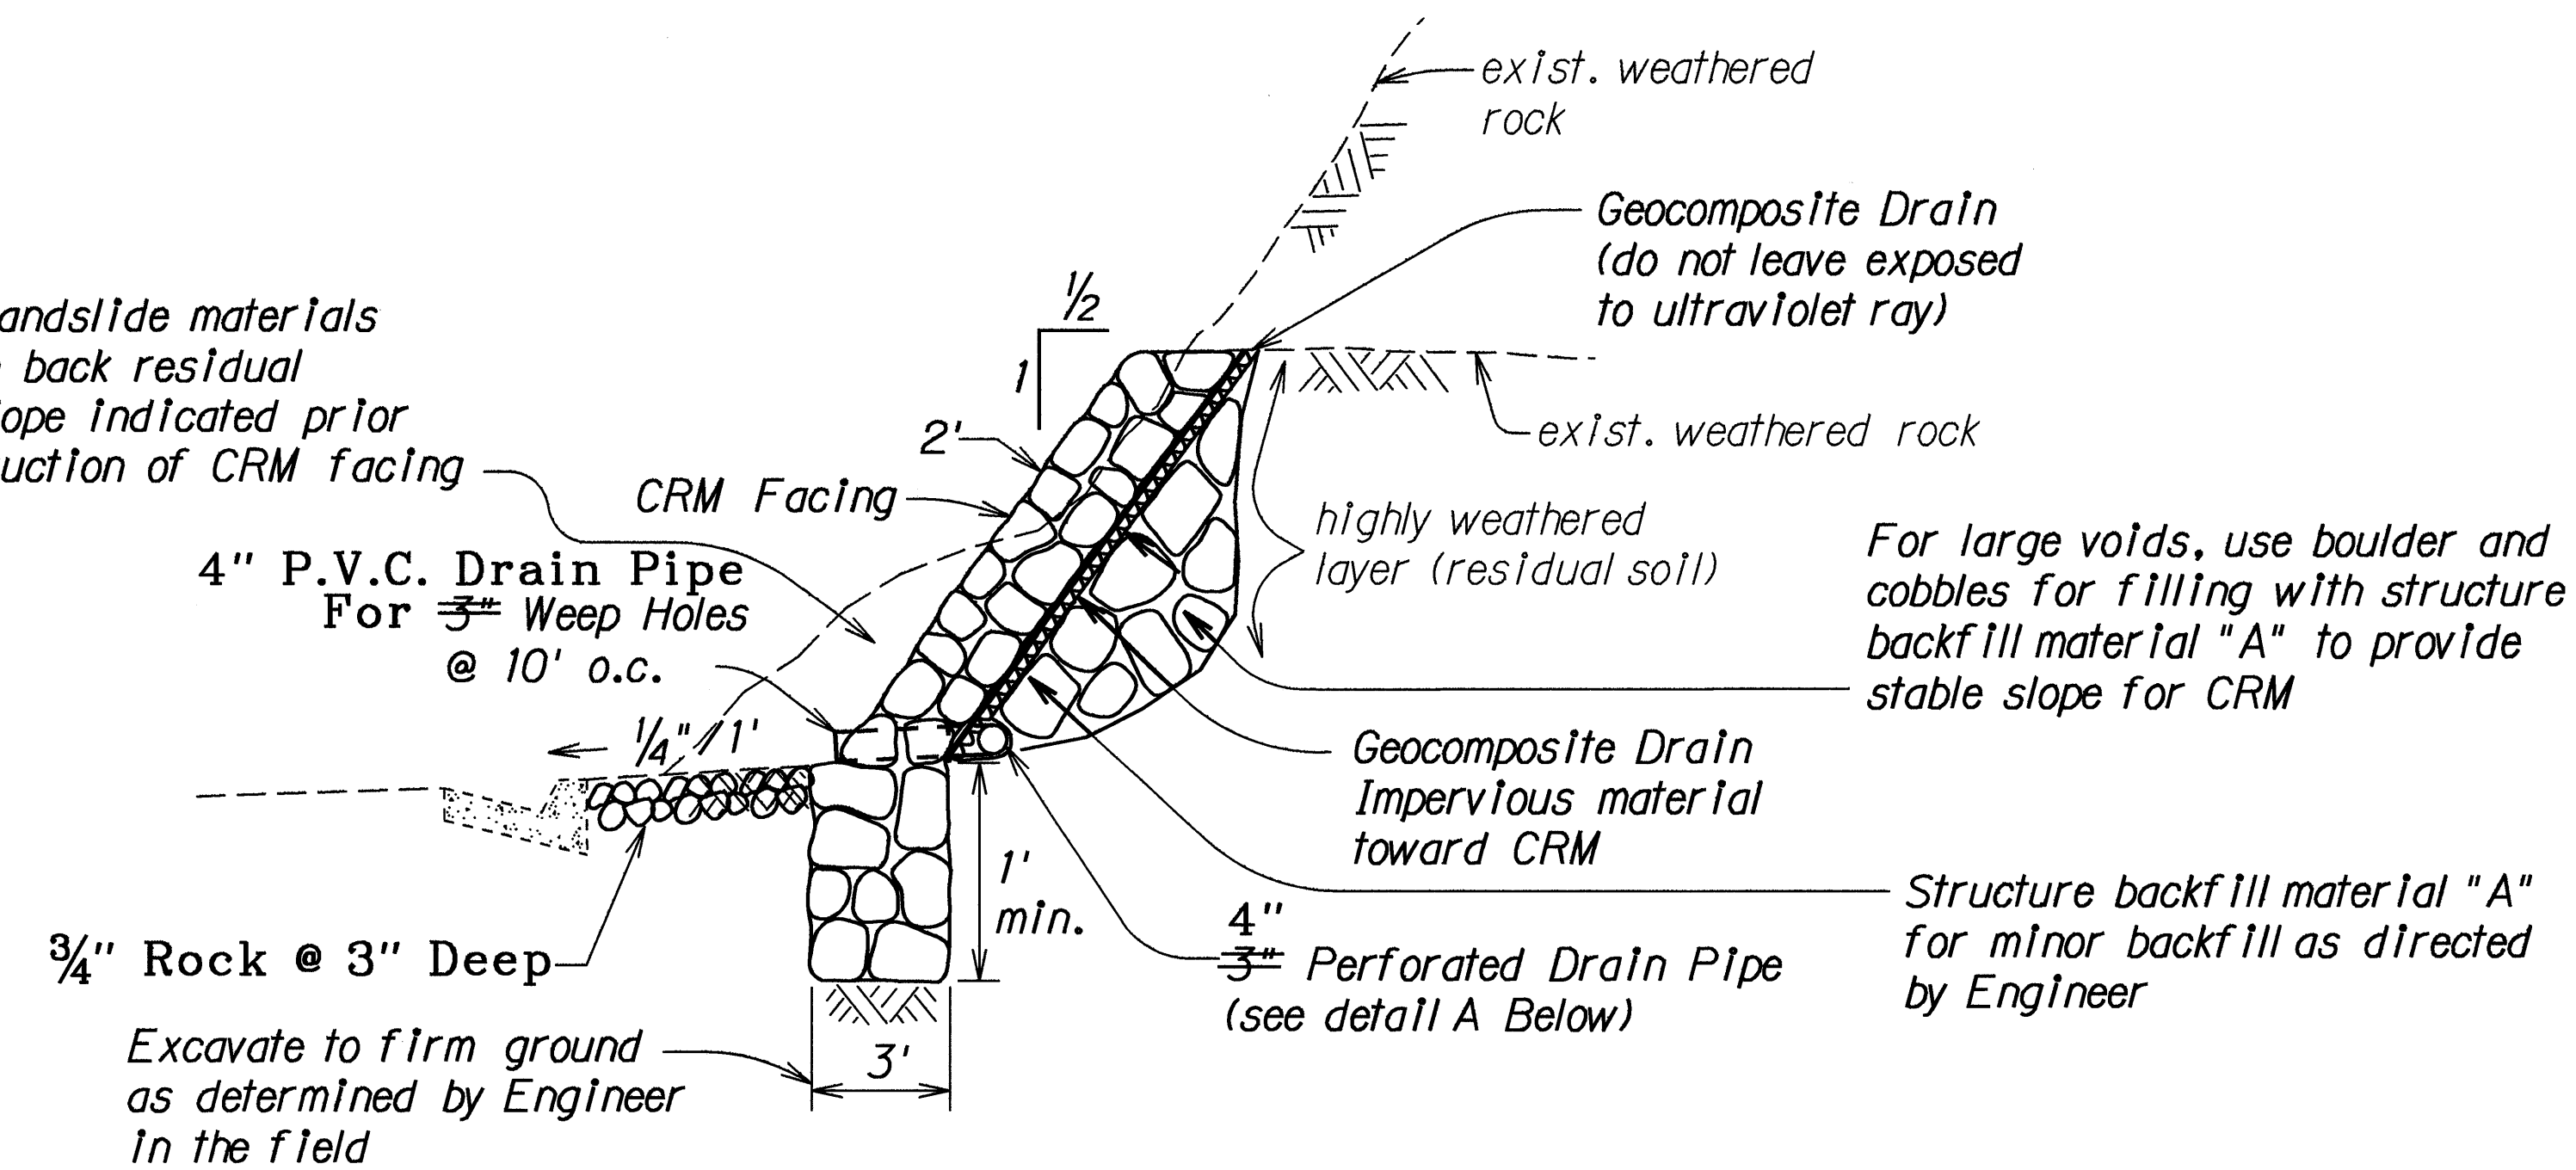

CRM FACING SECTION
Not To Scale

GENERAL NOTE

The project consists of constructing concrete rubble masonry, installing geocomposite drain and perforated pipe, excavating and removing landslide debris, and clearing and disposing of vegetation including removing large trees.

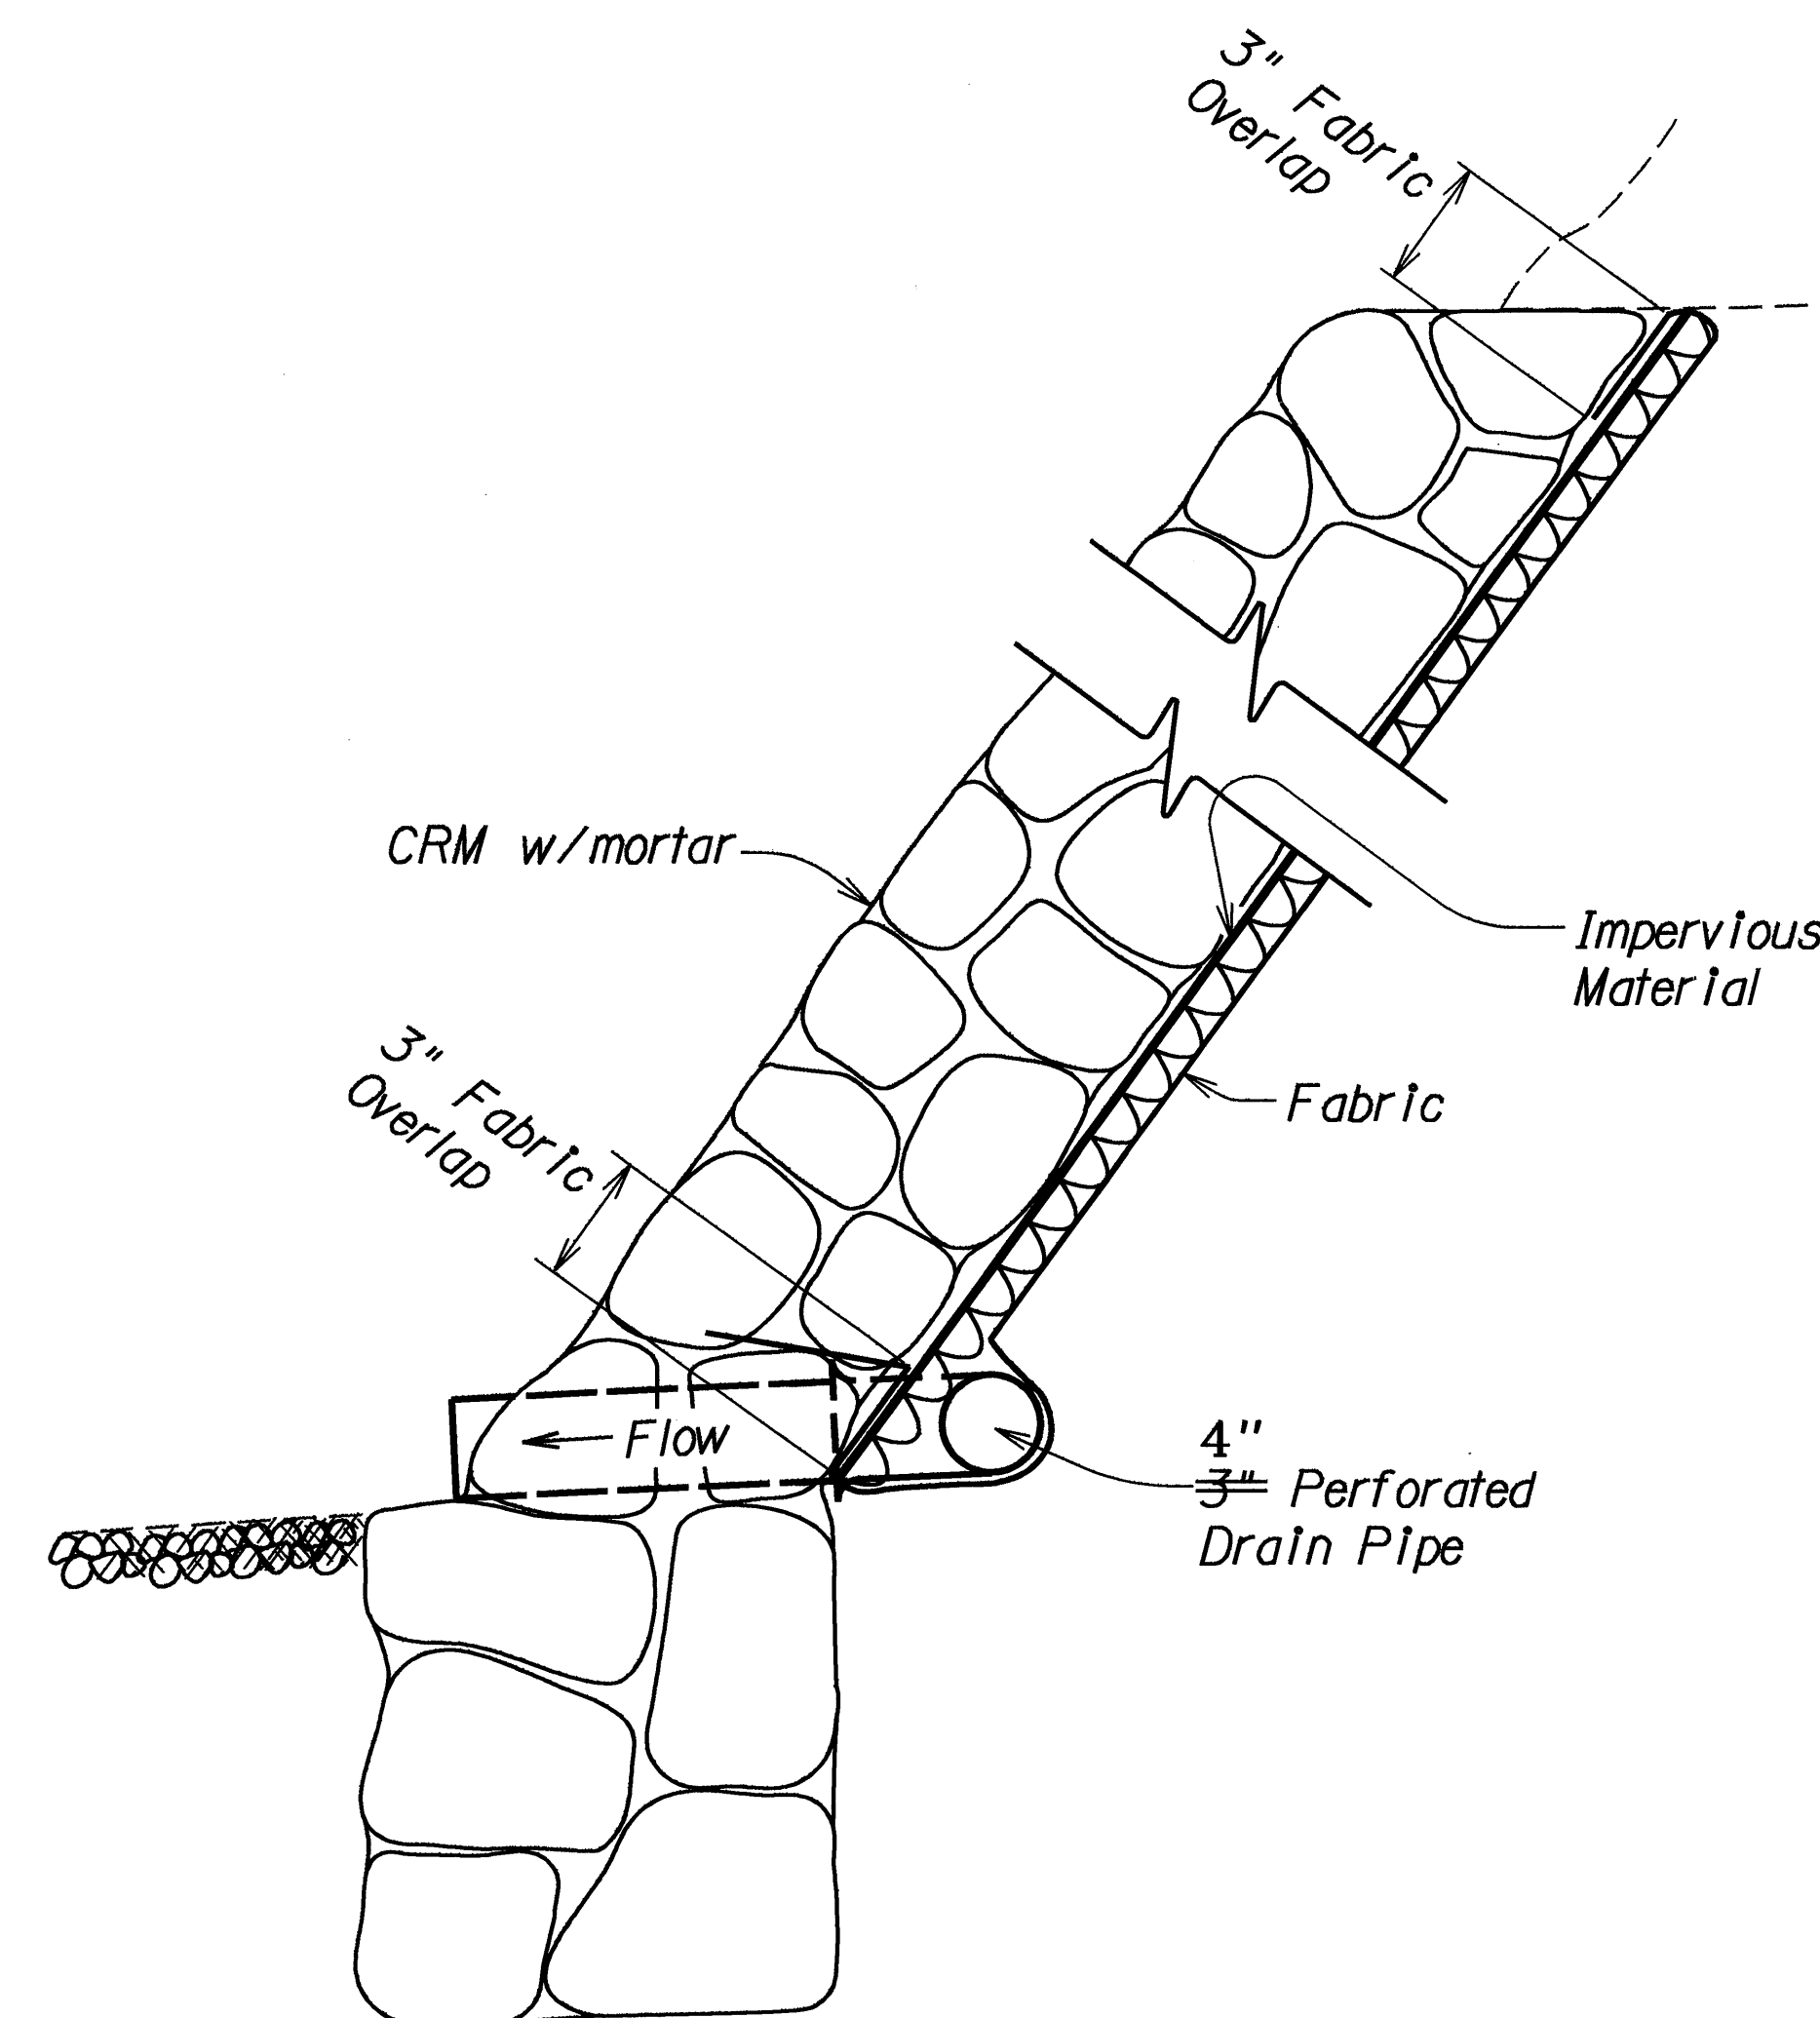


DETAIL A
Not To Scale

All trees shall be cut at groundline with tree stump killer applied to tree stumps

Limits of clearing

Remove all loose boulders and cobbles within limits of clearing

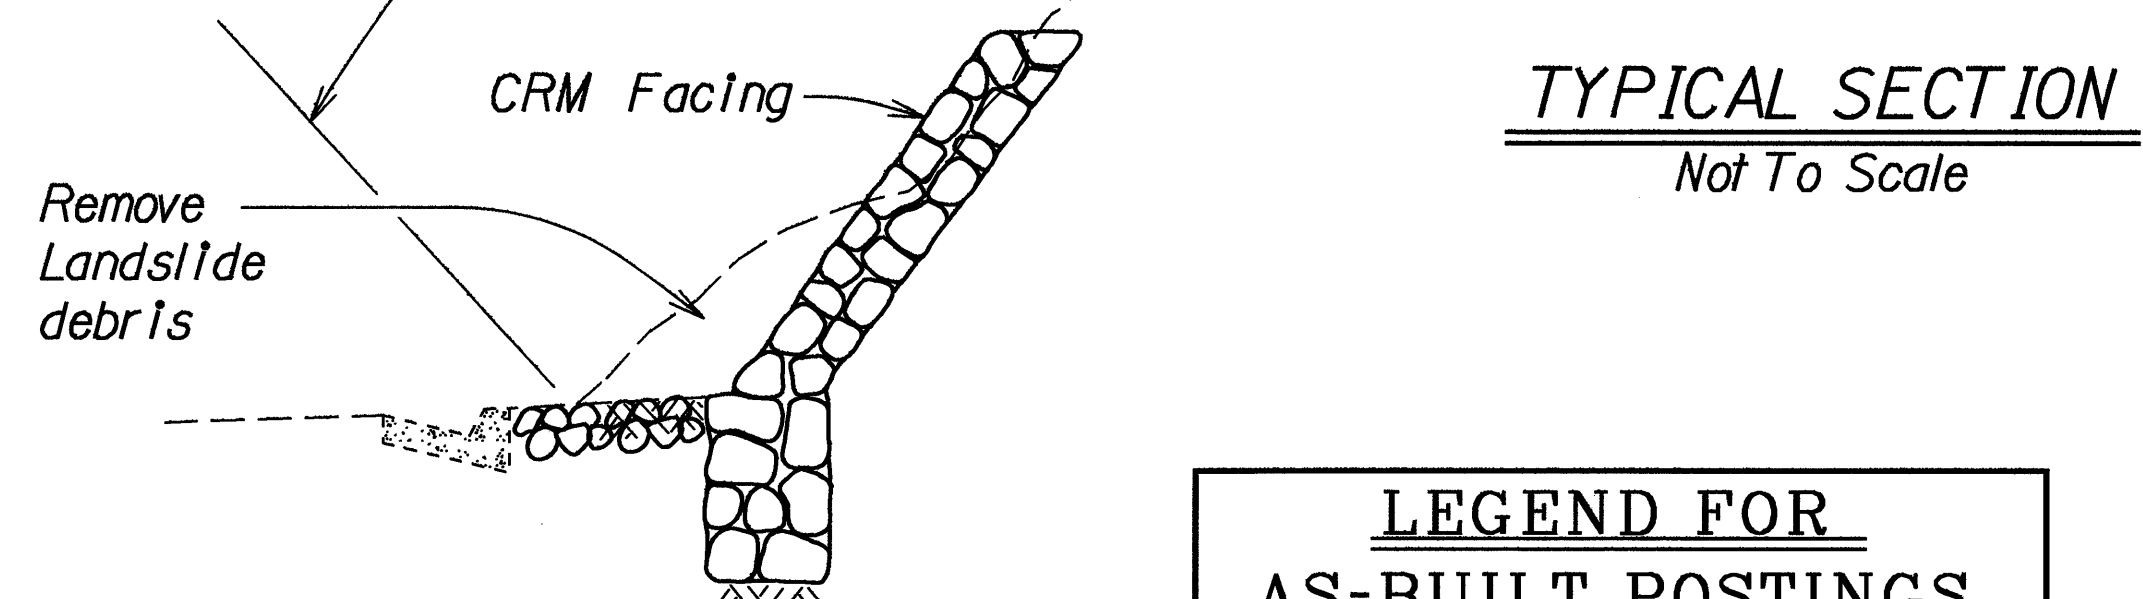

TYPICAL SECTION
Not To Scale

LEGEND FOR AS-BUILT POSTINGS	
	squiggly line for as-built deletion
	double line for as-built deletion
Roadway	text for as-built posting

STATE OF HAWAII
DEPARTMENT OF TRANSPORTATION
HIGHWAYS DIVISION

GENERAL NOTE AND DETAILS

HANA HIGHWAY
Repair Slides at Maliko Gulch
Project No. 36B-01-91M

Scale: As Shown Date: April 1991
SHEET No. 1 OF 1 SHEETS

AS-BUILT

DATE	
SURVEY PLOTTED BY	
DRAWN BY	
DESIGNED BY	
CHECKED BY	
ORIGINAL PLAN	
NOTE BOOK	
NO.	