

FED. ROAD DIST. NO.	STATE	PROJ. NO.	FISCAL YEAR	SHEET NO.	TOTAL SHEETS
HAWAII	HAW.	36B-01-91M	1991	4	6

⌘ CURVE DATA

$\Delta = 2^\circ 10' 00''$
 $R = 8,601.27'$
 $T = 162.65'$
 $C = 325.24'$
 $L = 325.26'$

⌘ CURVE DATA

$\Delta = 106^\circ 23' 40''$
 $R = 301.56'$
 $Lc = 559.98'$
 $Ls = 250.00'$
 $L.T. = 168.18'$
 $S.T. = 84.72'$
 $\theta_s = 23^\circ 44' 59''$
 $L.C. = 248.10'$

TRUE NORTH
SCALE: 1" = 20'

BEGIN PROJECT
⌘ STA. 177+58±

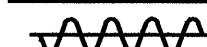
P.T. Sta. 178+62.65
 T.S. Sta. 178+62.65

⌘ Sta. 180+79.87
 Begin Maliko Bridge

S.C. Sta. 181+12.65

⌘ Sta. 182+86.00
 End Maliko Bridge

END PROJECT
⌘ STA. 181+00±

**LEGEND FOR
AS-BUILT POSTINGS**
 squiggly line for as-built deletion
 double line for as-built deletion
 Roadway text for as-built posting

STATE OF HAWAII
 DEPARTMENT OF TRANSPORTATION
 HIGHWAYS DIVISION
ROADWAY PLAN
 HANA HIGHWAY
 Repair Slides at Maliko Gulch
 Project No. 36B-01-91M
 Scale: 1" = 20' Date: Apr 11 1991
 SHEET No. 1 OF 1 SHEETS

AS-BUILT

DATE	
SURVEY PLOTTED BY	
DRAWN BY	
DESIGNED BY	
CHECKED BY	
NOTE BOOK	
No.	

Remove trees, vegetation, and landslide debris to here

Approximate location of existing swale

R/W

bench

swale

325°59'20"

180+00

181

182

MALIKO BRIDGE

178

179

177

R/W