


FED. ROAD DIST. NO.	STATE	PROJ. NO.	FISCAL YEAR	SHEET NO.	TOTAL SHEETS
HAWAII	HAW.	36AB-01-95M	1995	6	11

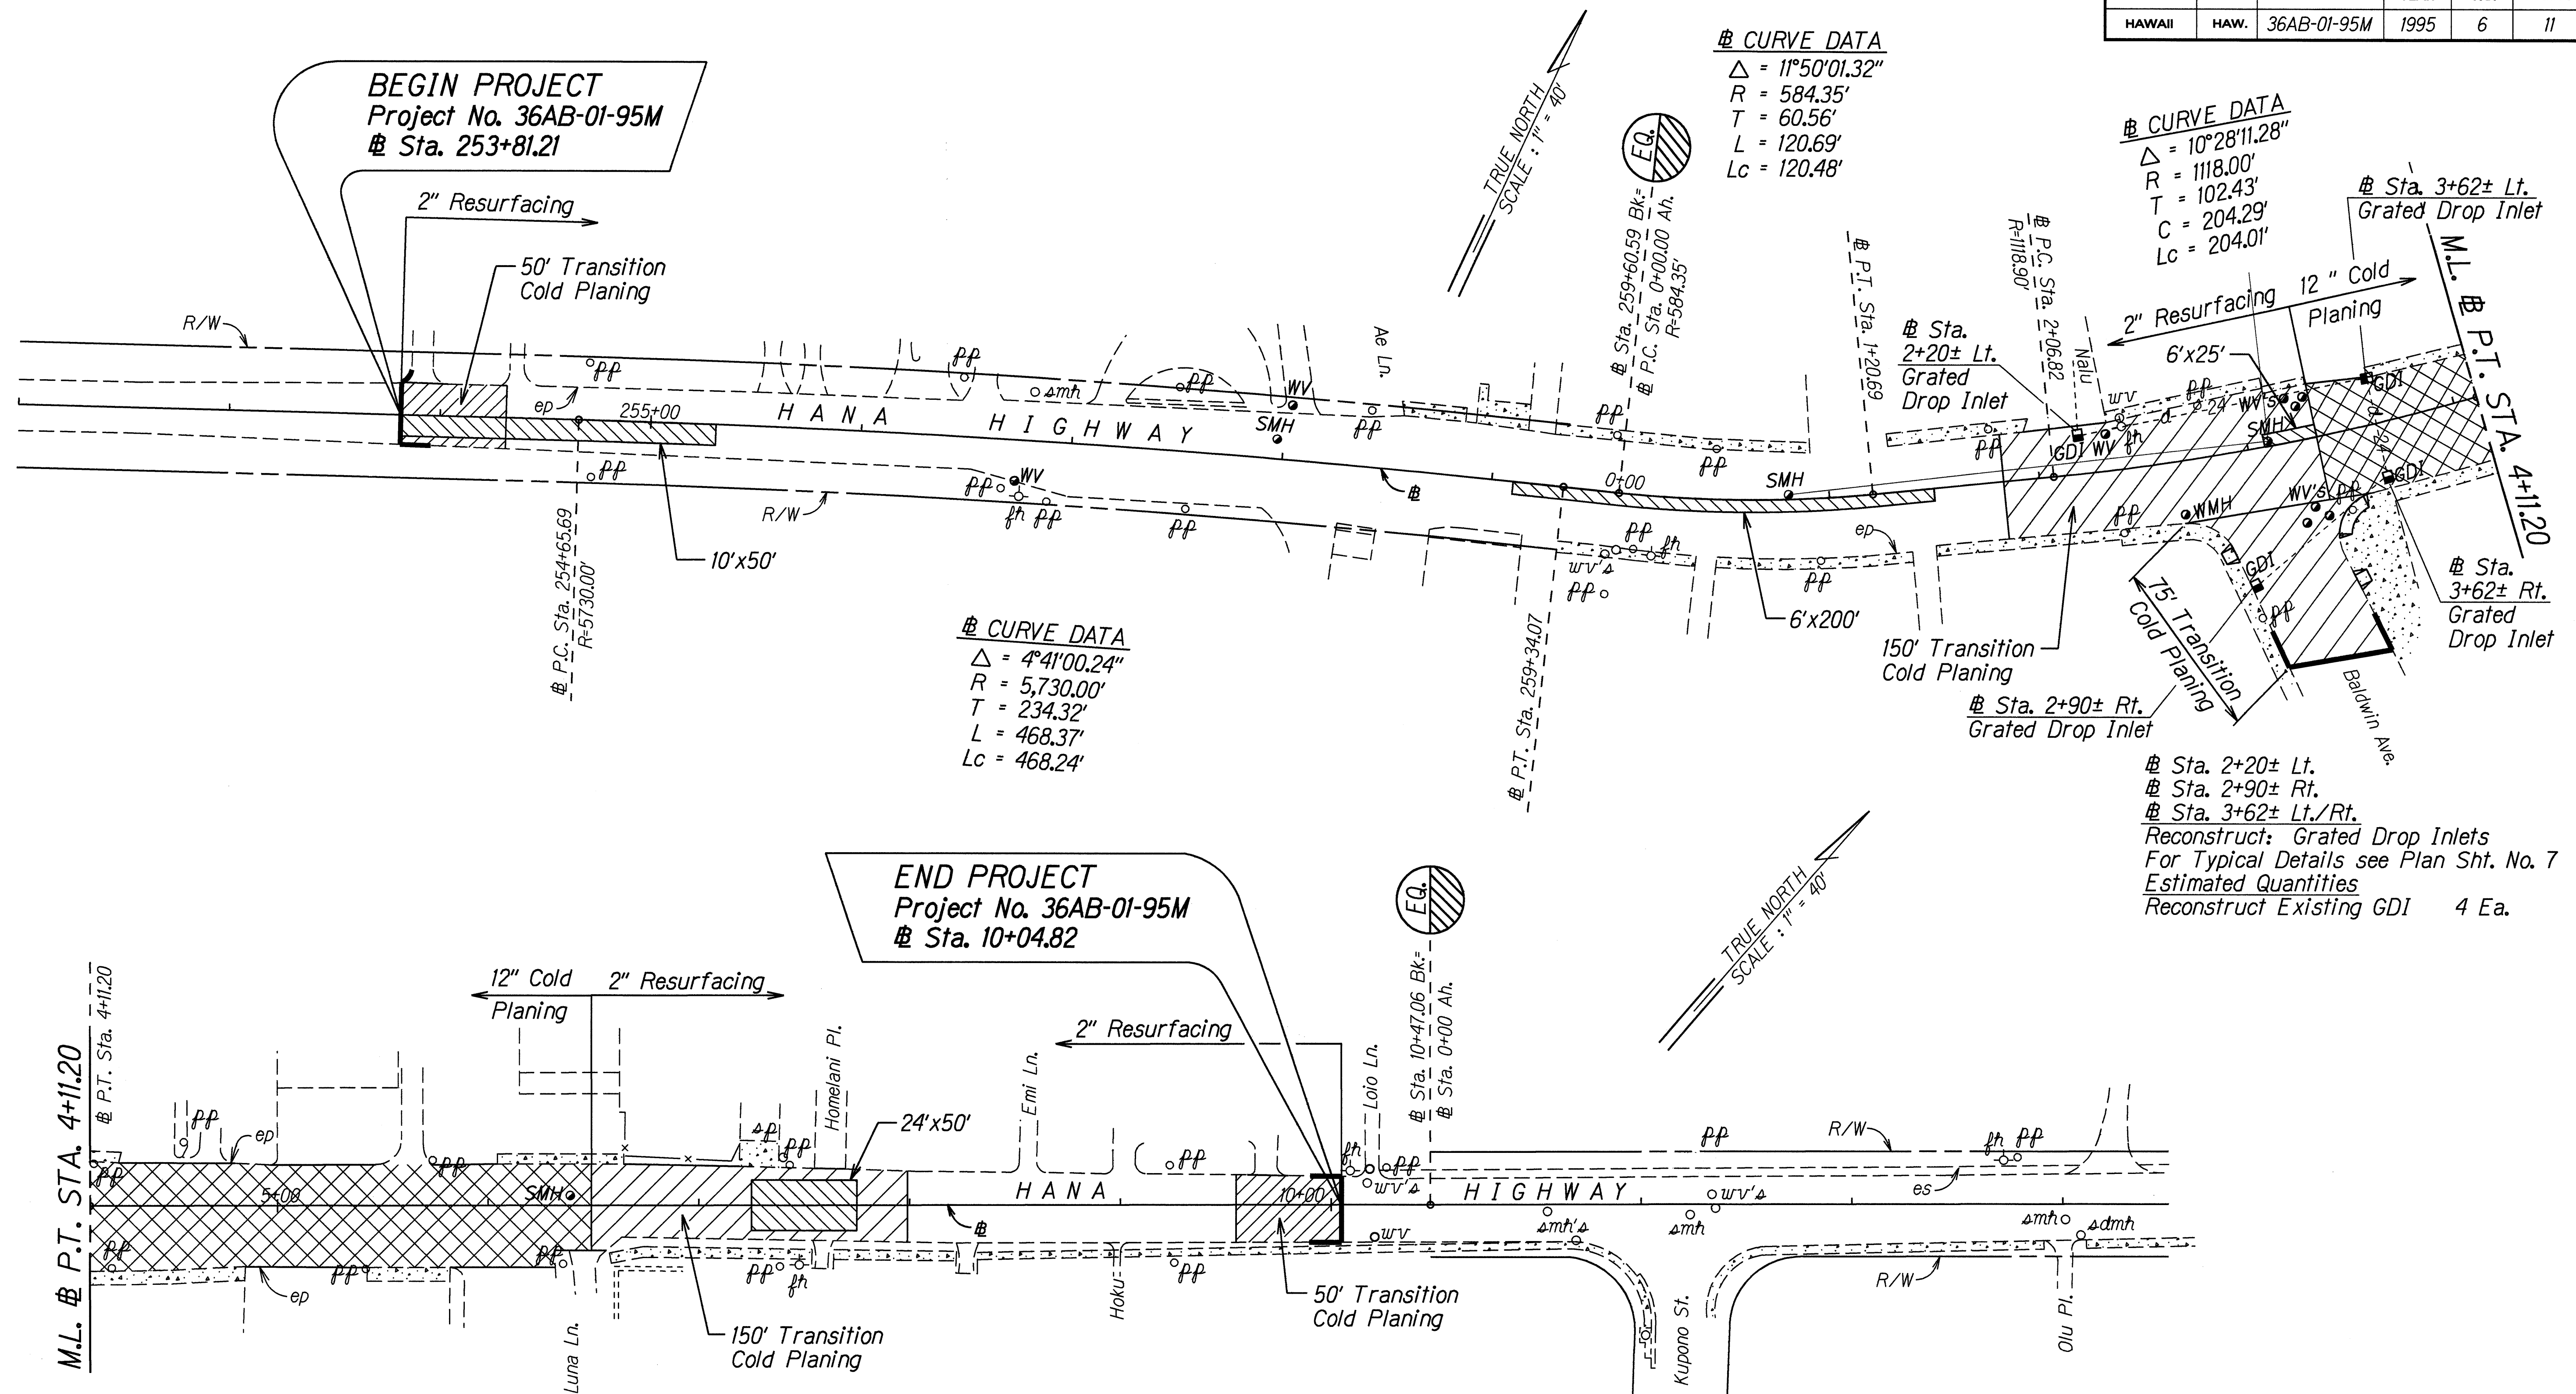

ORIGINAL PLAN	SURVEY PLOTTED BY	DATE
	DRAWN BY <i>M. Howells</i>	<i>15-31-55</i>
NOTE BOOK	TRACED BY	
<i>dellmh</i>	DESIGNED BY <i>M. Quodala</i>	
	QUANTITIES BY	
<i>N. bhandal</i>	CHECKED BY	

STATE OF HAWAII
DEPARTMENT OF TRANSPORTATION
HIGHWAYS DIVISION

PLAN

HANA HIGHWAY RESURFACING
Paia Town Section
Project No. 36AB-01-95M

Scale: 1"=40' Date: May, 1995

SHEET No. 1 OF 1 SHEETS