




FED. ROAD DIST. NO.	STATE	FED. AID PROJ. NO.	FISCAL YEAR	SHEET NO.	TOTAL SHEETS
HAWAII	HAW.	STP-0900(39)	1995	5	51

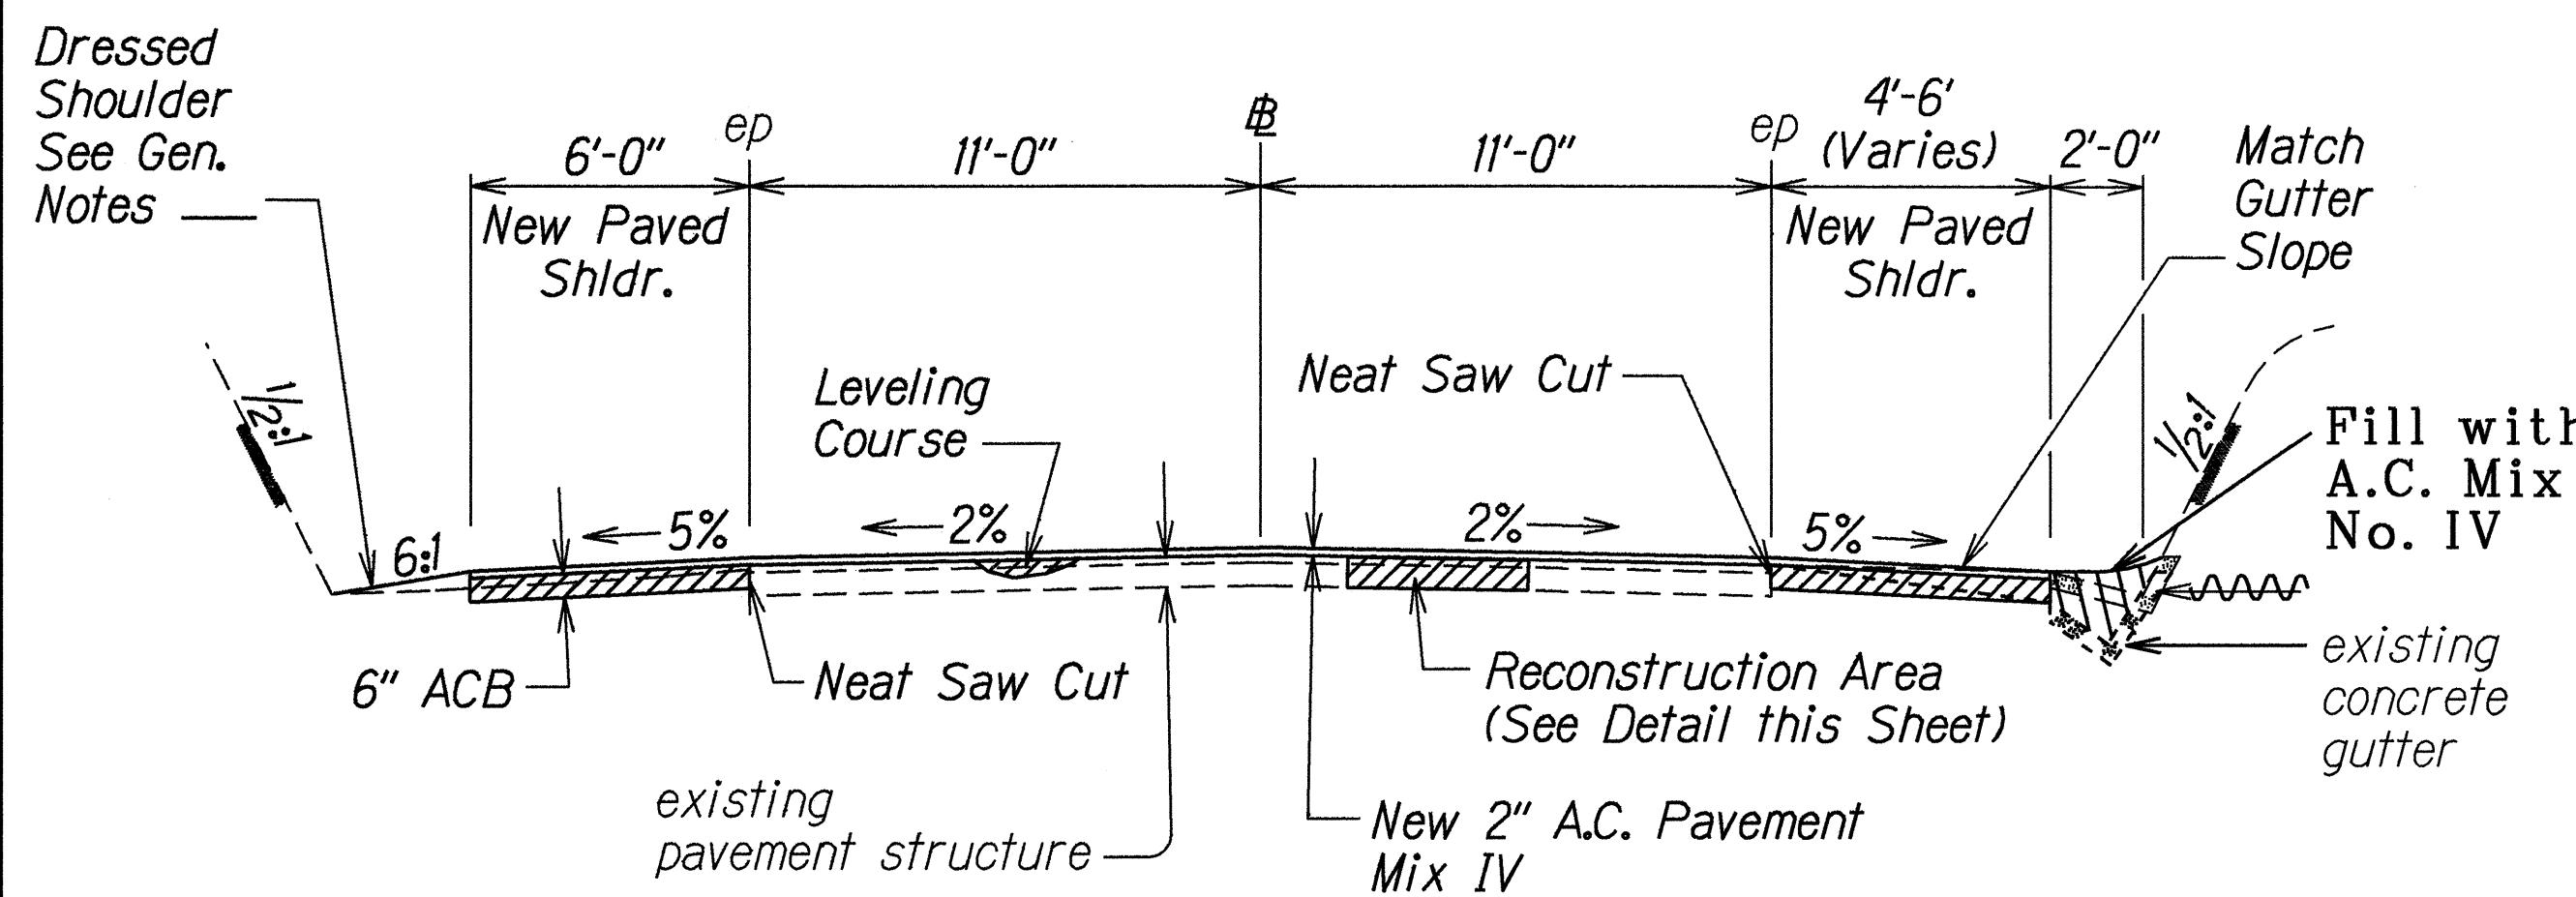


TYPICAL ROAD SECTION TANGENTS
Scale: 1/4" = 1'-0"

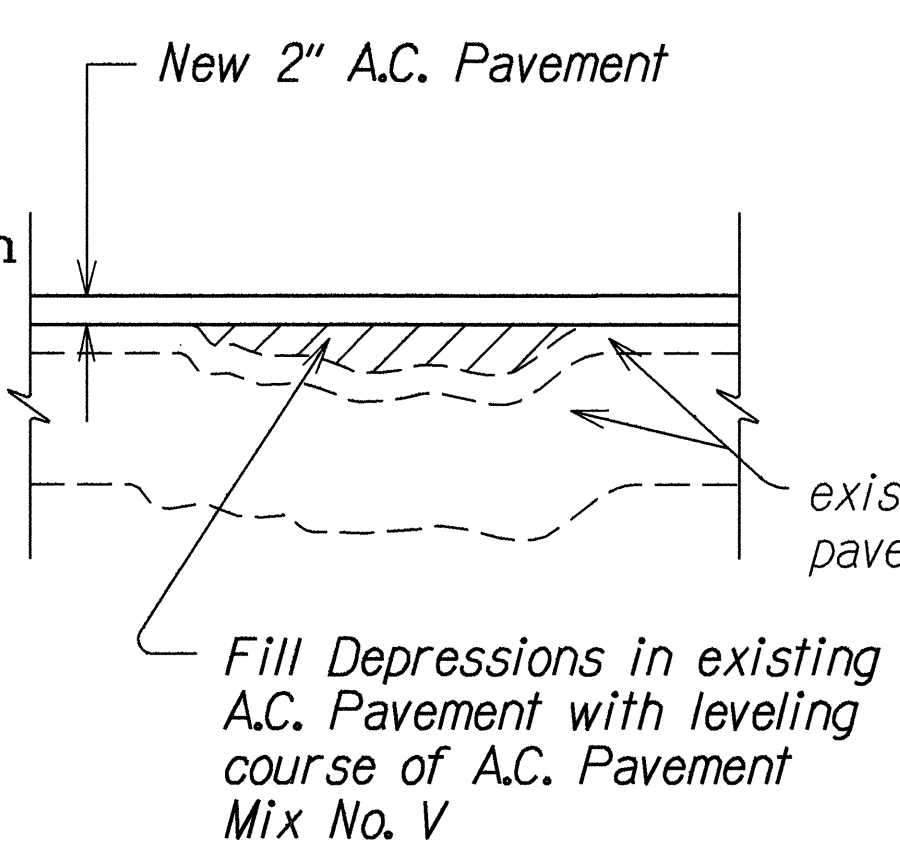


LEVELING COURSE DETAIL
Not To Scale

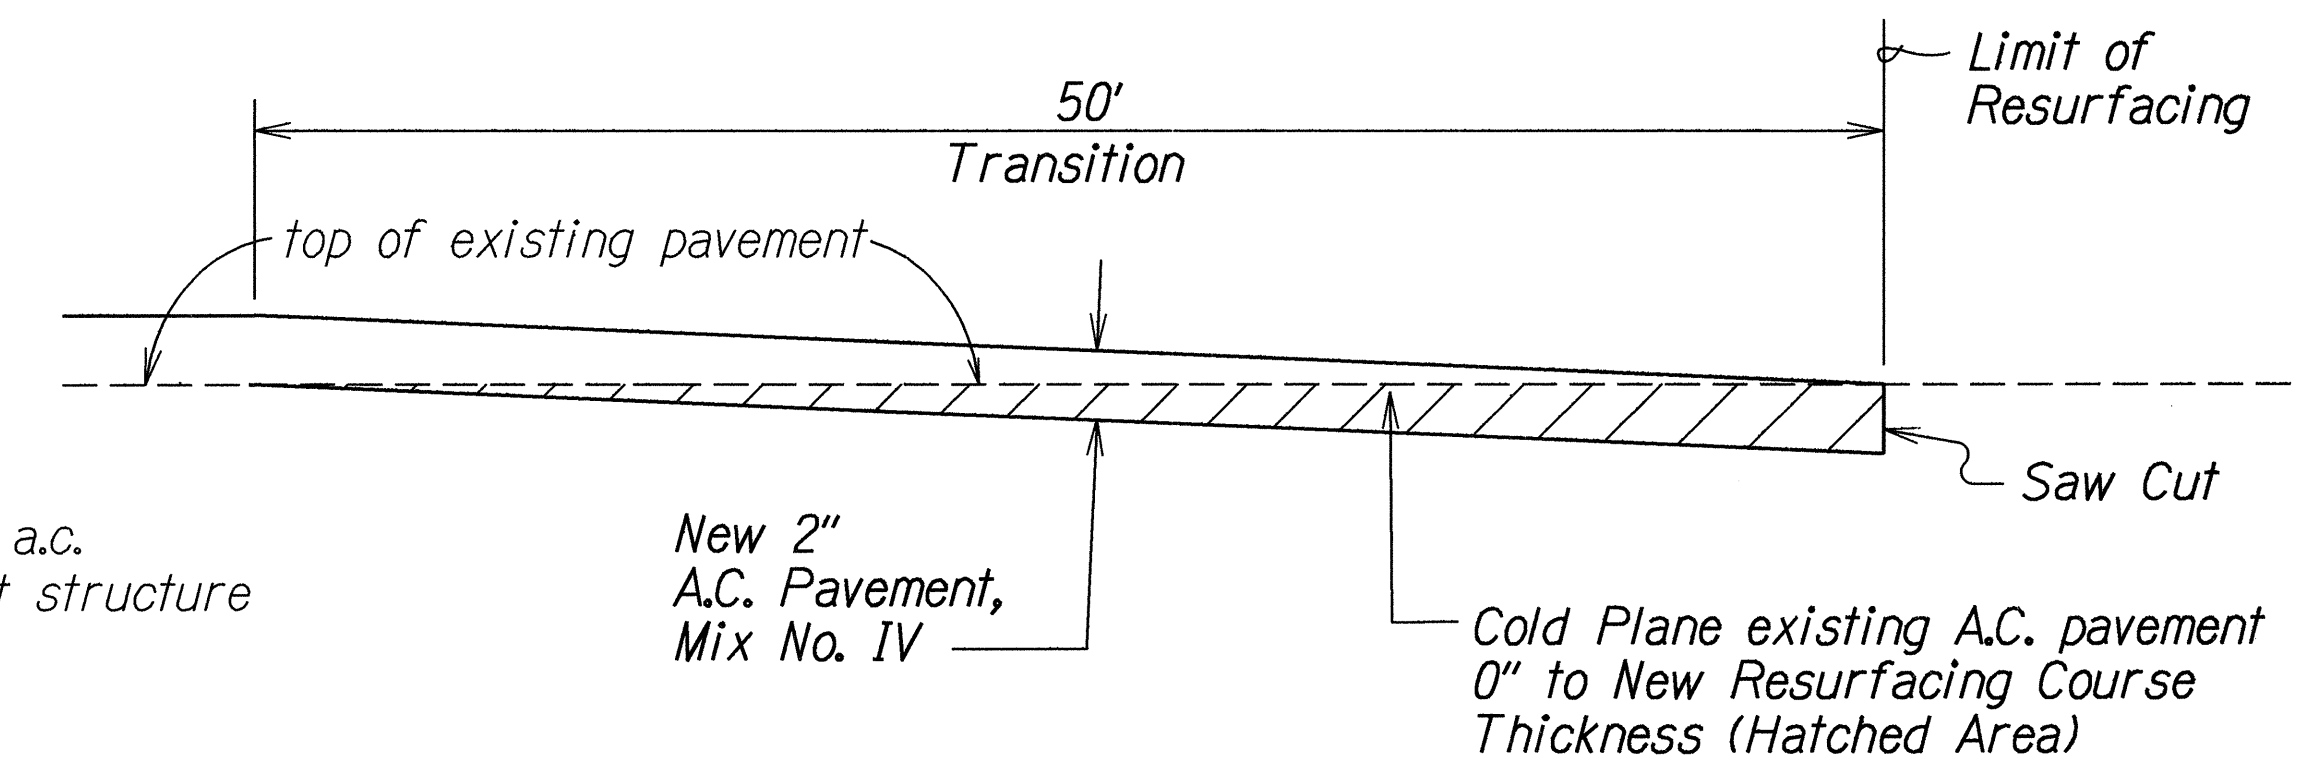


COLD PLANED TRANSITION TO EXISTING A.C. PAVEMENT
Not To Scale

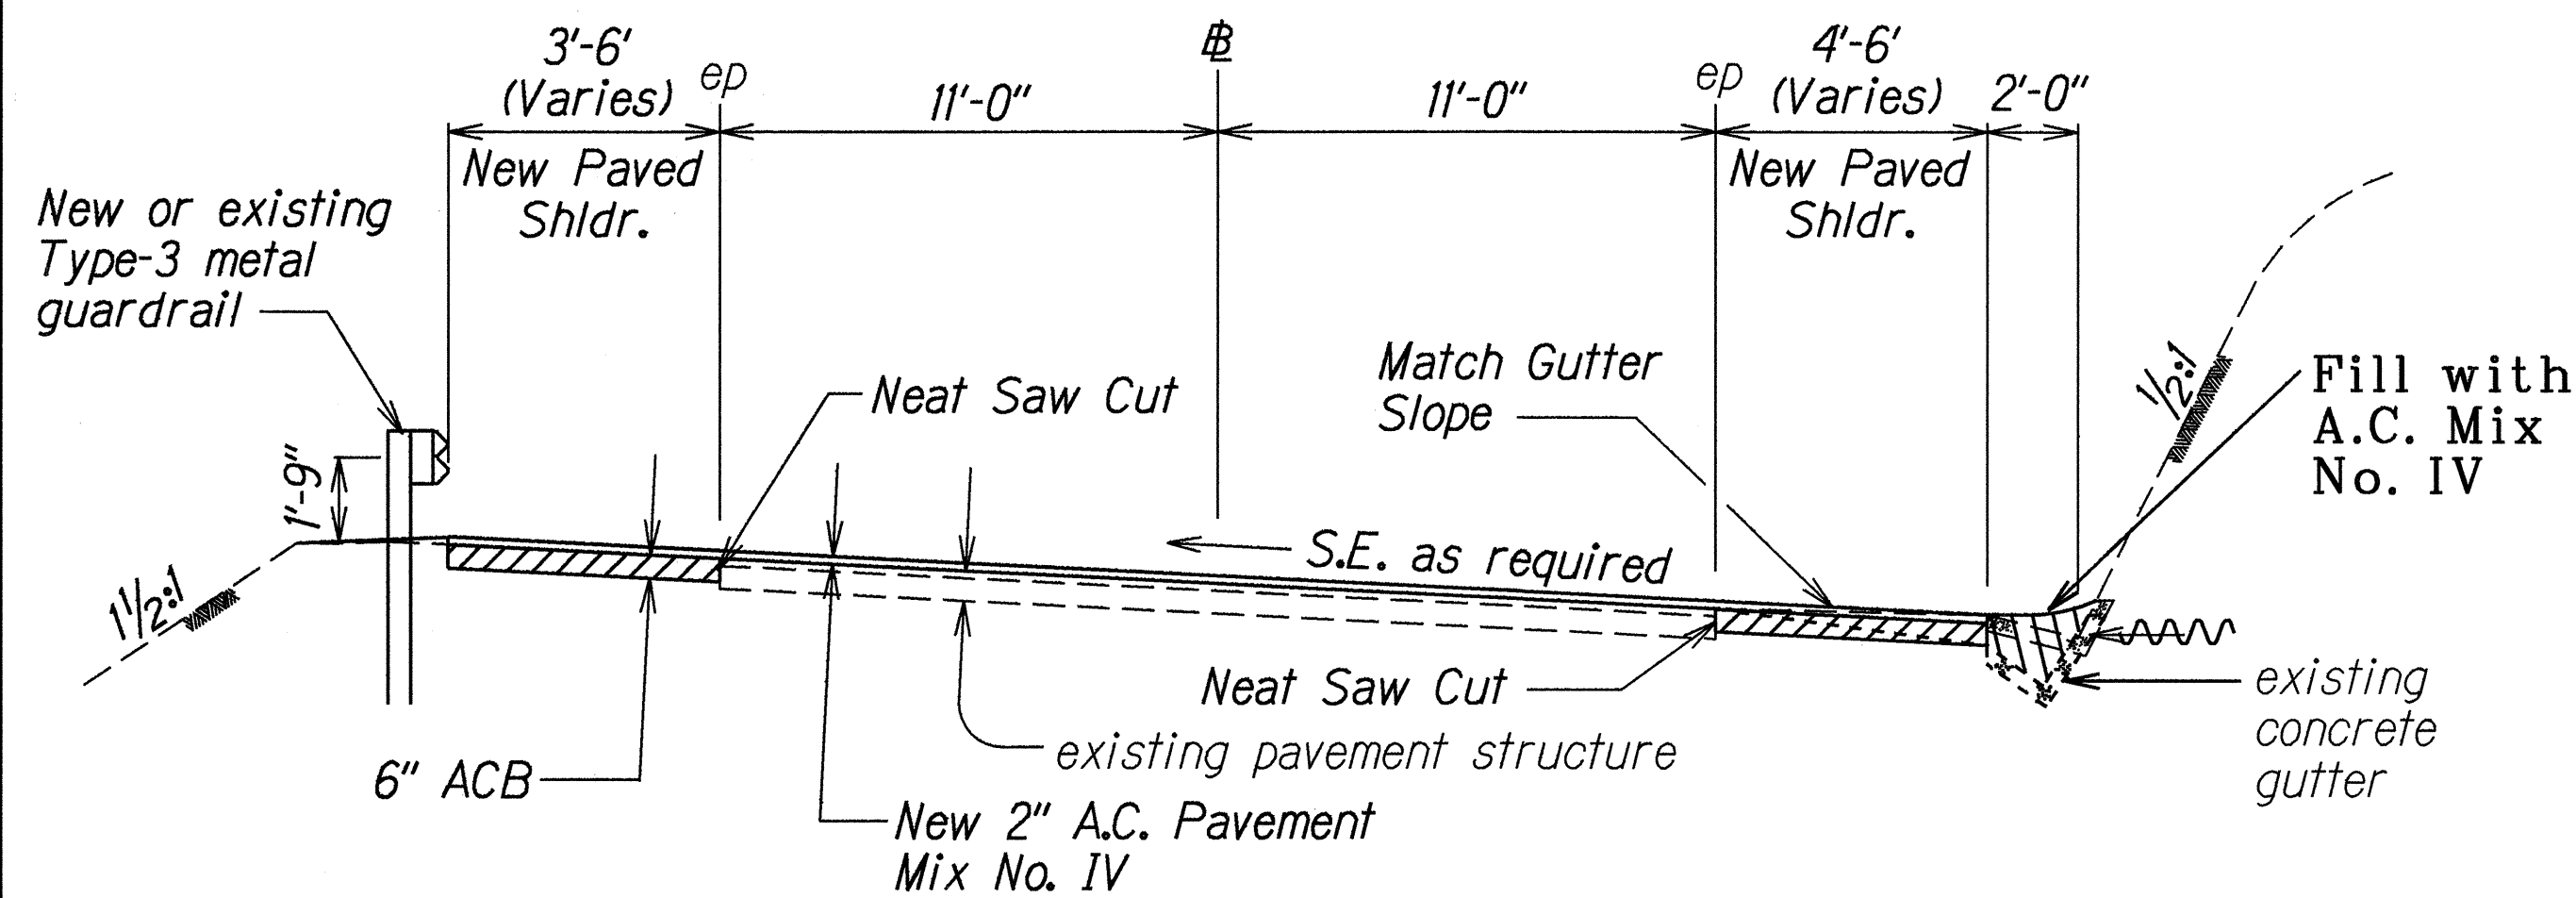


TYPICAL ROAD SECTION ON CURVES
Scale: 1/4" = 1'-0"

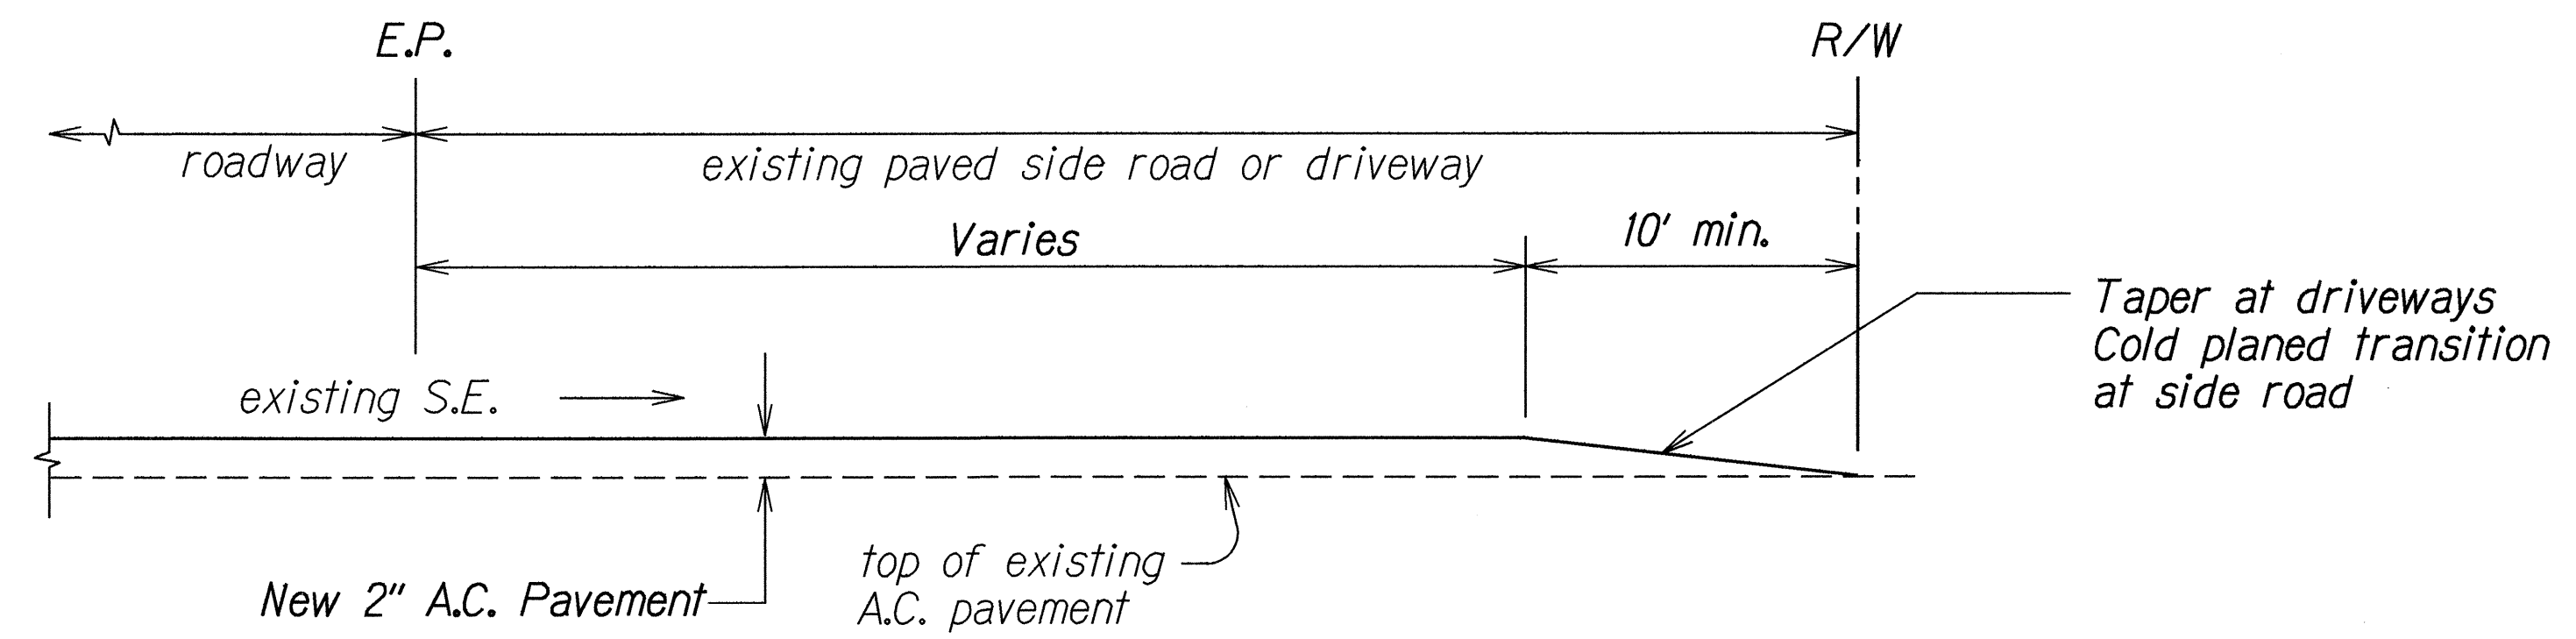


A. C. RESURFACING AT PAVED SIDEROAD OR PAVED DRIVEWAY DETAIL
Not To Scale

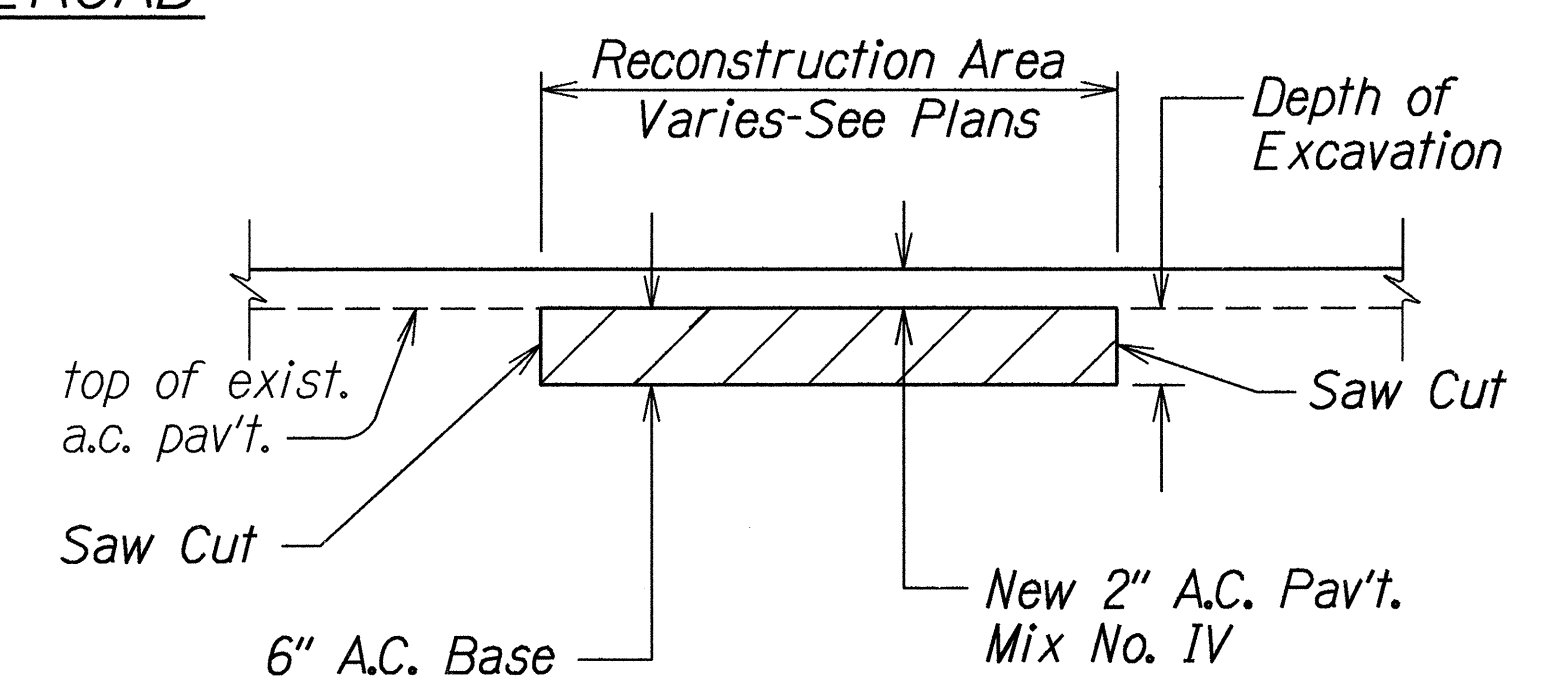

A.C. PAVEMENT RECONSTRUCTION DETAIL
Not To Scale

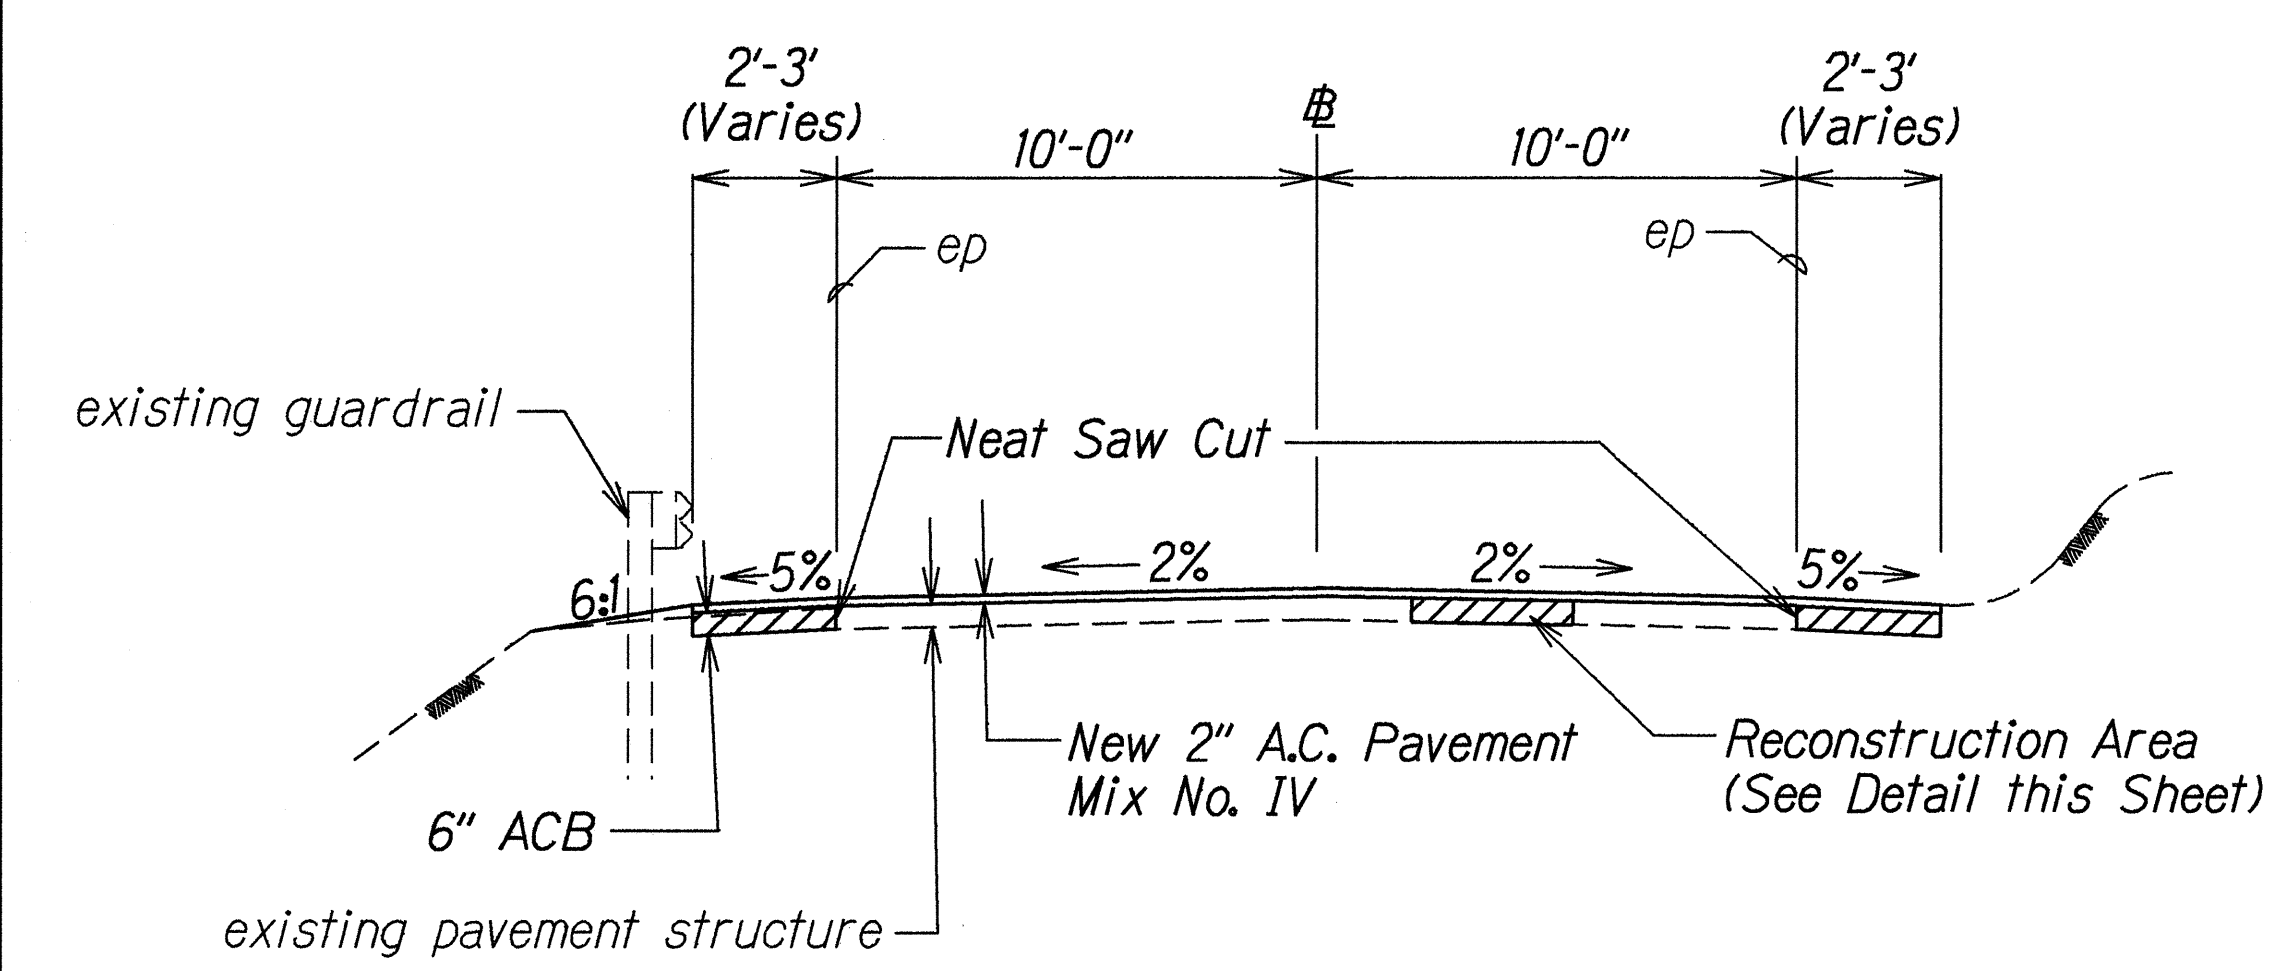

TYPICAL TANGENT SECTION
STA. 0+00 - STA. 26+50
Scale: 1/4" = 1'-0"

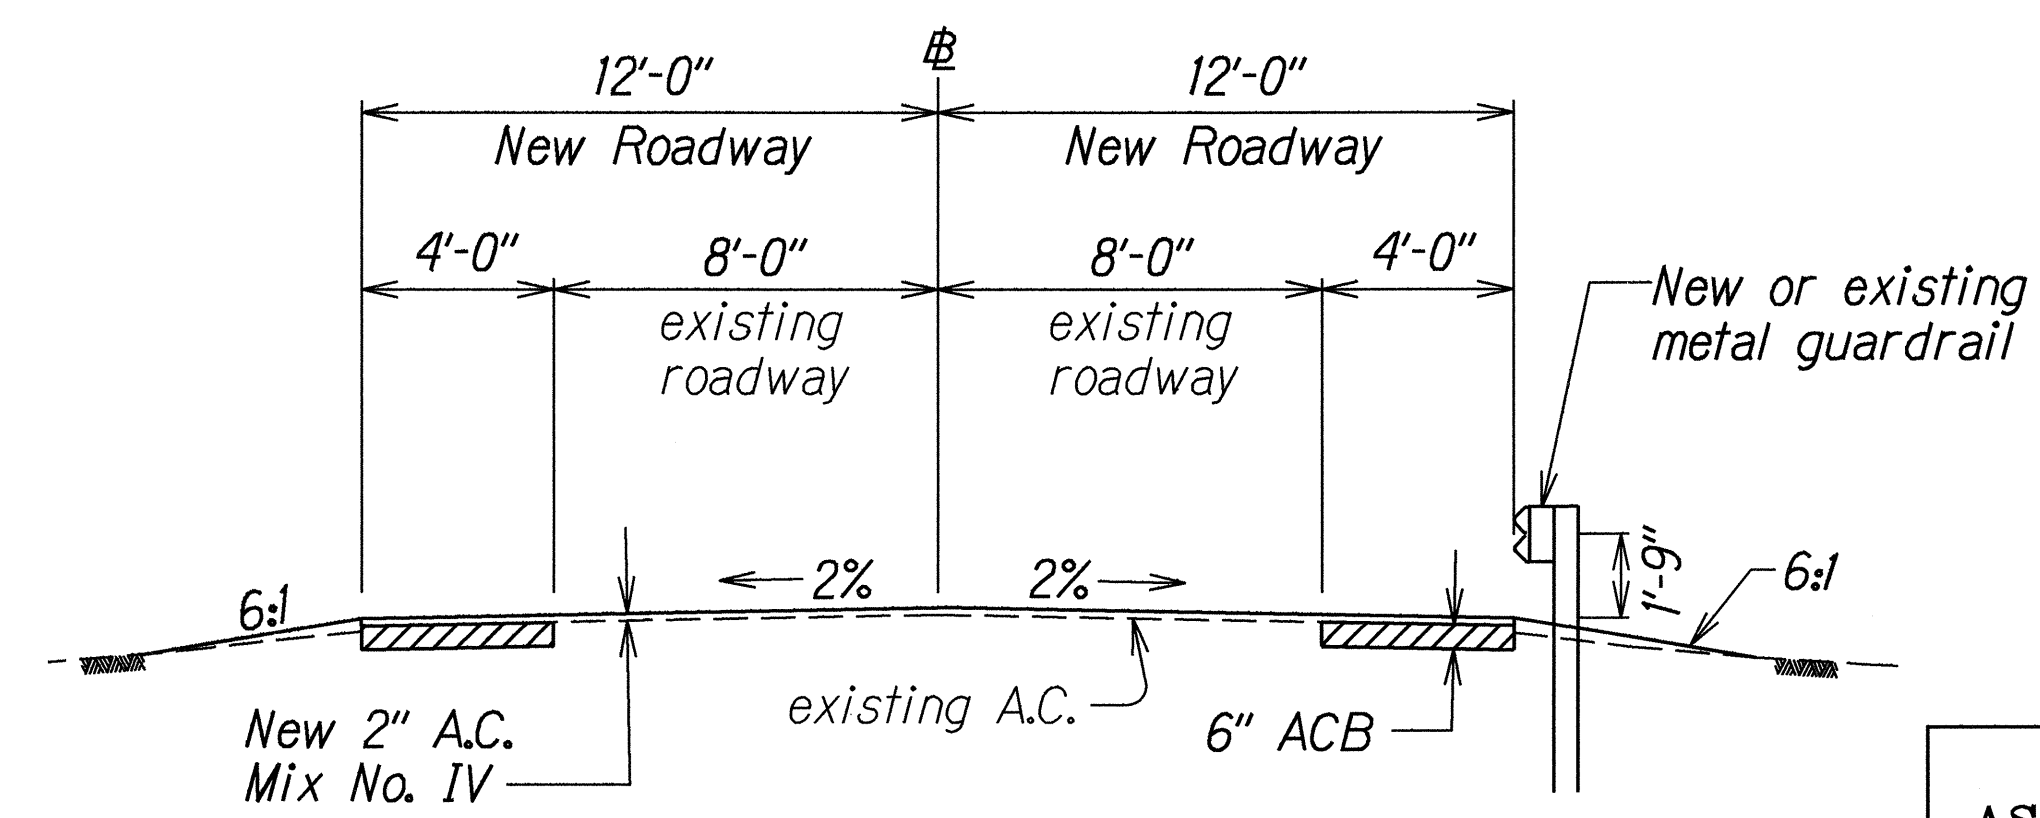

TYPICAL SECTION @ SIDEROADS
Scale: 1/4" = 1'-0"

LEGEND FOR AS-BUILT POSTINGS	
~~~~~	Squiggly line for as-built deletion
=====	Double line for as-built deletion
Roadway	Text for as-built posting

STATE OF HAWAII  
DEPARTMENT OF TRANSPORTATION  
HIGHWAYS DIVISION

**TYPICAL SECTIONS & DETAILS**  
  
HANA HIGHWAY RESURFACING  
Valley Isle Memorial Cemetery to Huelo  
Fed. Aid Project No. STP-0900(39)

Scale: As Shown
Date: May, 1995

SHEET No. 1 OF 1 SHEETS

ORIGINAL PLAN	DATE
DESIGNED BY	May, 1995
DRAWN BY	
CHECKED BY	
APPROVED BY	