


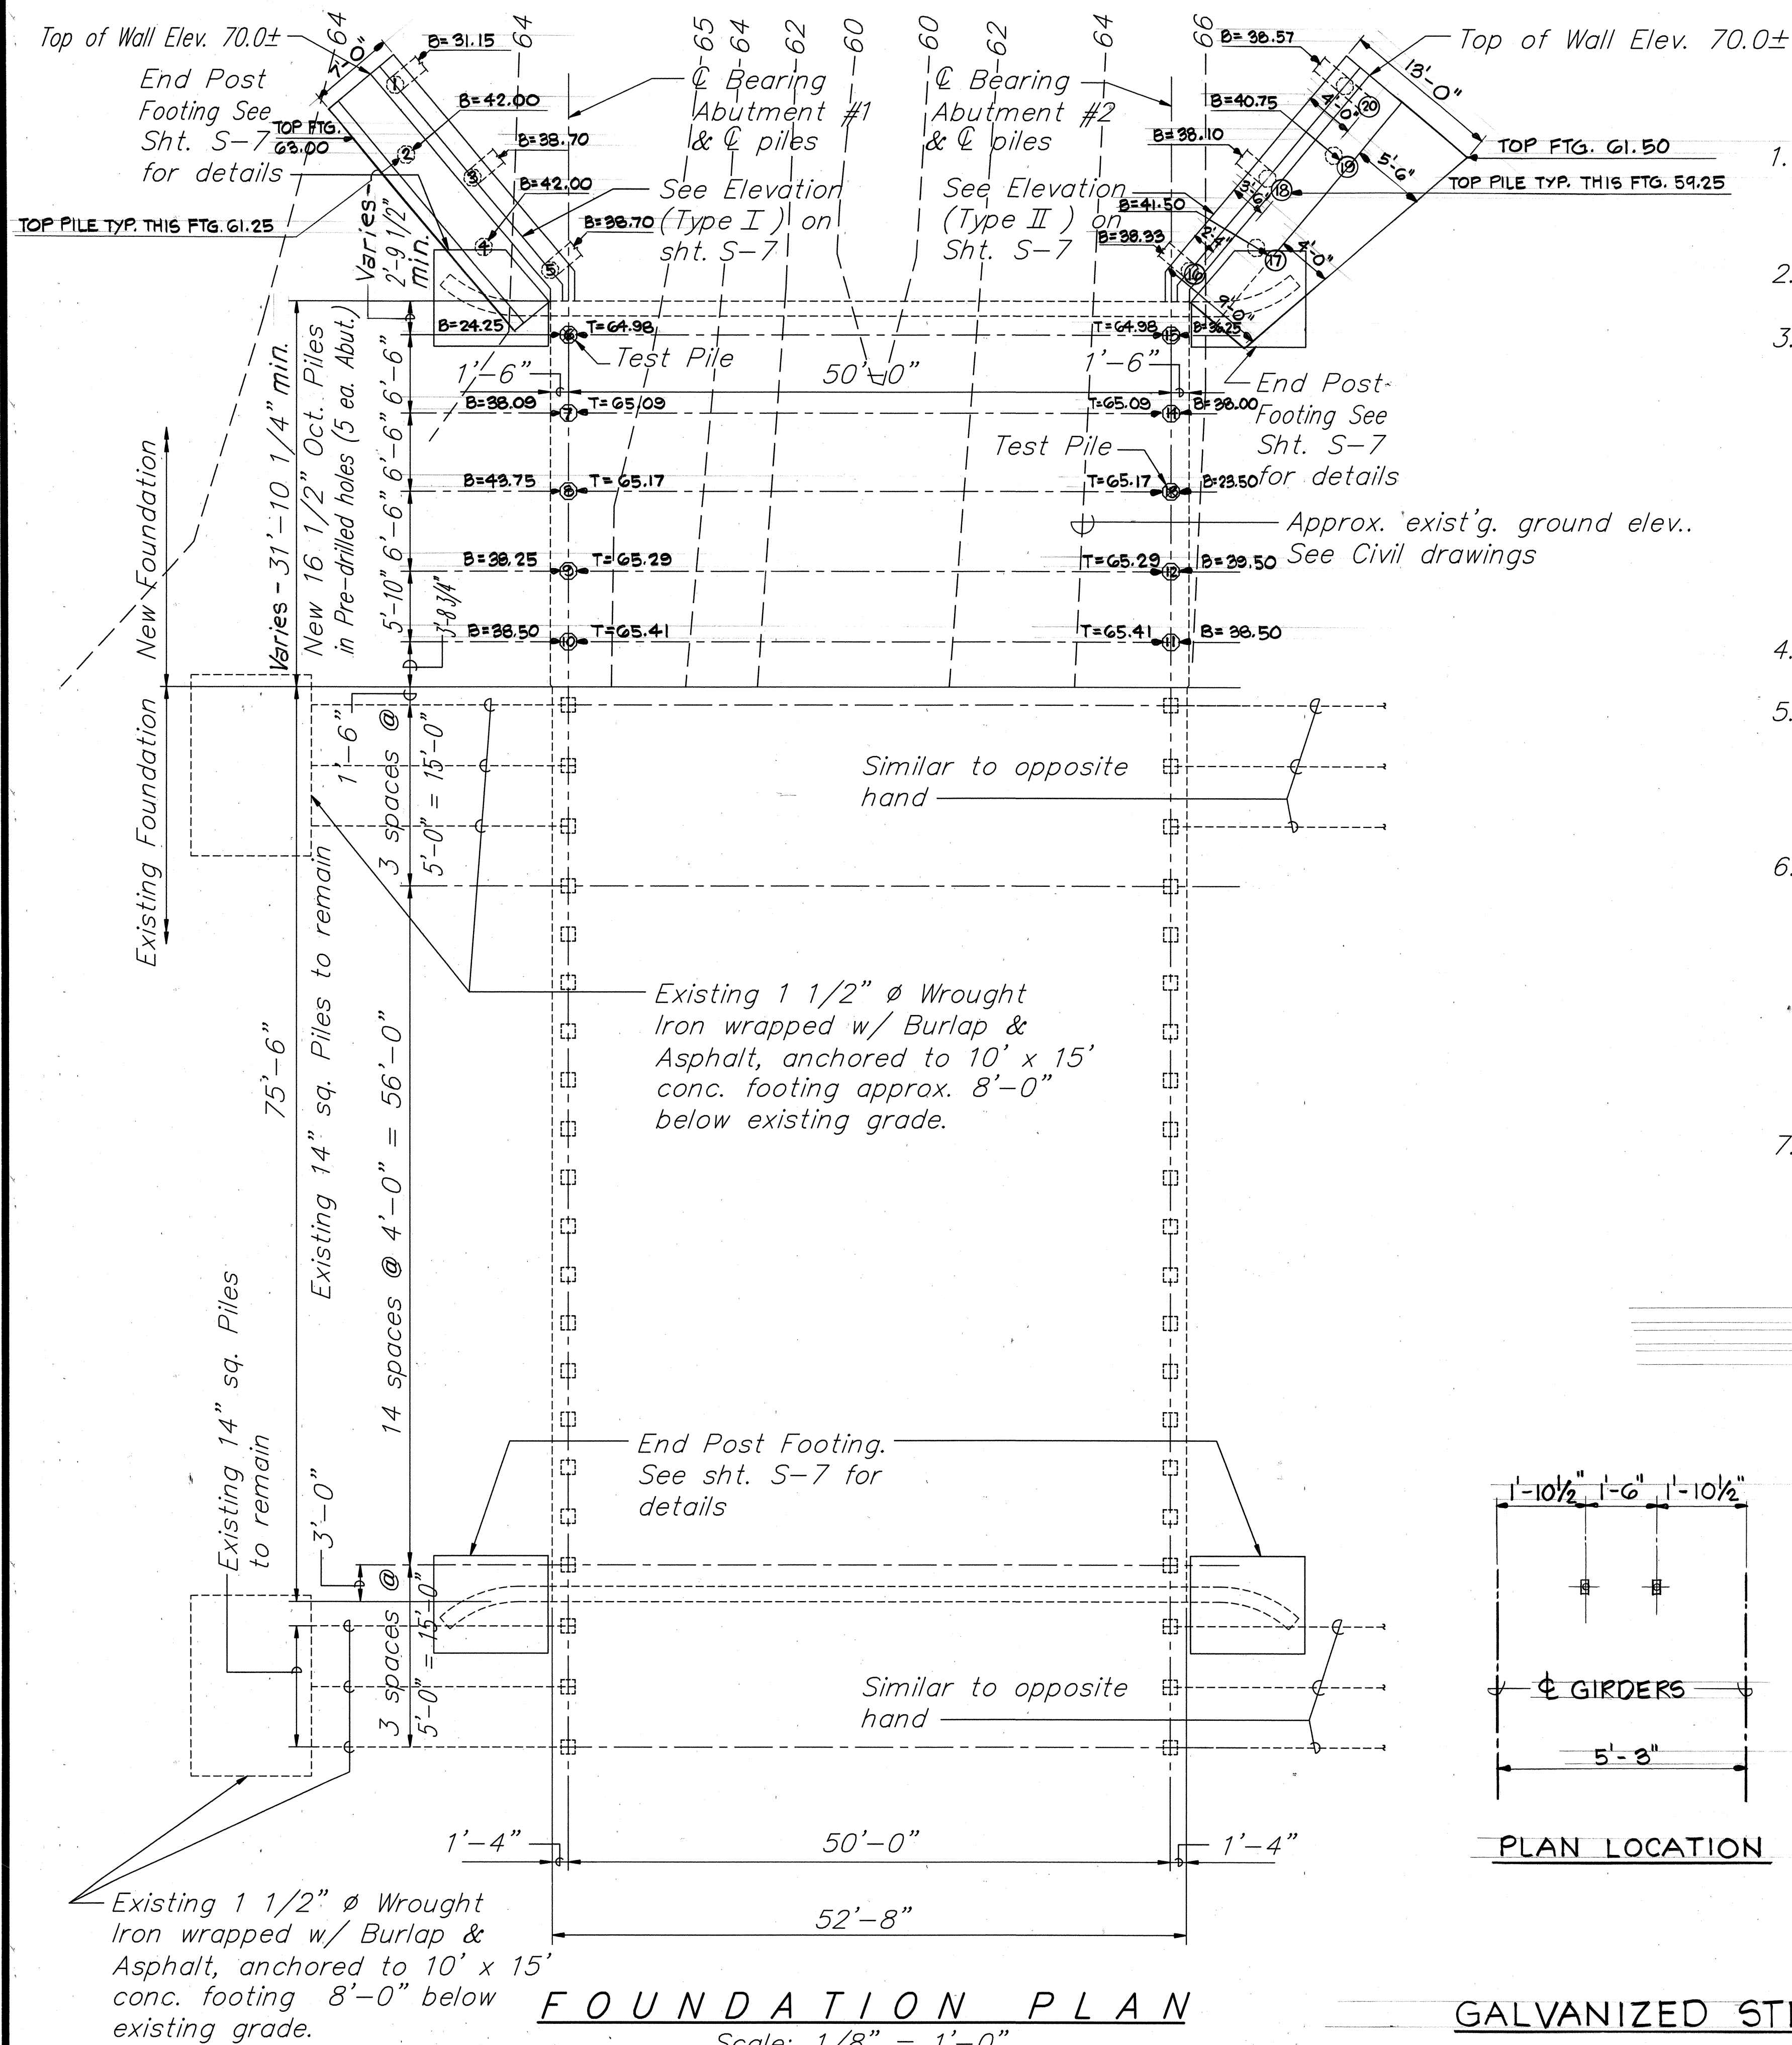

STRUCTURAL NOTES

- Design Specifications: Standard Specifications for Highway Bridges, 13th Edition 1983 and subsequent Interim Specifications, adopted by AASHTO.
- Traffic Design Live Load: HS-20-44
- Design Specifications:
 - Class ~~A~~ Concrete: $f_c' = 3,750$ ksi
 $f_c = 1,200$ psi
 $n = 9$
 - Reinforcing Steel: $f_s = 20,000$ psi
 - Design method for Reinforced Concrete: Working Stress design
 - Prestressed Concrete: $f_c' = 6,000$ ksi
 - Prestressing Steel: $f_s' = 270,000$ psi
- General Notes: See Standard Plan B-01
- For additional details for Joints, Structure Excavation & Backfill Pay Limits, Prestressed Concrete Piles, Chain Link Fence, and Metal Guardrail, see Standard Plans B-01, B-03, B-12, B-13, D-01, TE-50, TE-51 and TE-55.
- The elevation of the new bridge deck, abutment, footings etc., shall be determined by the Contractor after exposing the existing bridge concrete slab. The top of the new bridge slab extension shall match the top of existing bridge slab elevation and slope. Contractor shall submit new bridge deck, abutment, girder concrete seat, and footing elevations for review by the Engineer prior to starting construction of the project.
- Prestressed girder lengths are horizontal measurements. Actual lengths to be determined by the Contractor. See Civil drawings for horizontal and vertical grade data.



Airports Division
DEPARTMENT OF TRANSPORTATION
STATE OF HAWAII



THIS WORK WAS PREPARED BY
ME OR UNDER MY SUPERVISION

Harold Takashi Mima

DSGN.	DRWN.	CHKD.	APPD.
L.S.	G.K.	V.C.	H.T.M.

KEY PLAN / NOTES :

NO. DATE REVISIONS

RECORD DRAWINGS

This record drawing has been prepared, in part, based upon information furnished by others. The Engineer is thus not responsible for the accuracy of this record drawing or for any errors or omissions which may have been incorporated into it as a result.

Date: July 12, 1991

PROJECT TITLE :

HANA HIGHWAY
IMPROVEMENTS

PROJECT NO. :

STATE PROJ. NO. AM-1061-12
AIP PROJ. NO. 3-15-0006-II

SHEET TITLE :

FOUNDATION PLAN
AND STRUCTURAL
NOTES

DATE :

10-3-89

DWG. NO. :

S-1A

5-5,5-6