

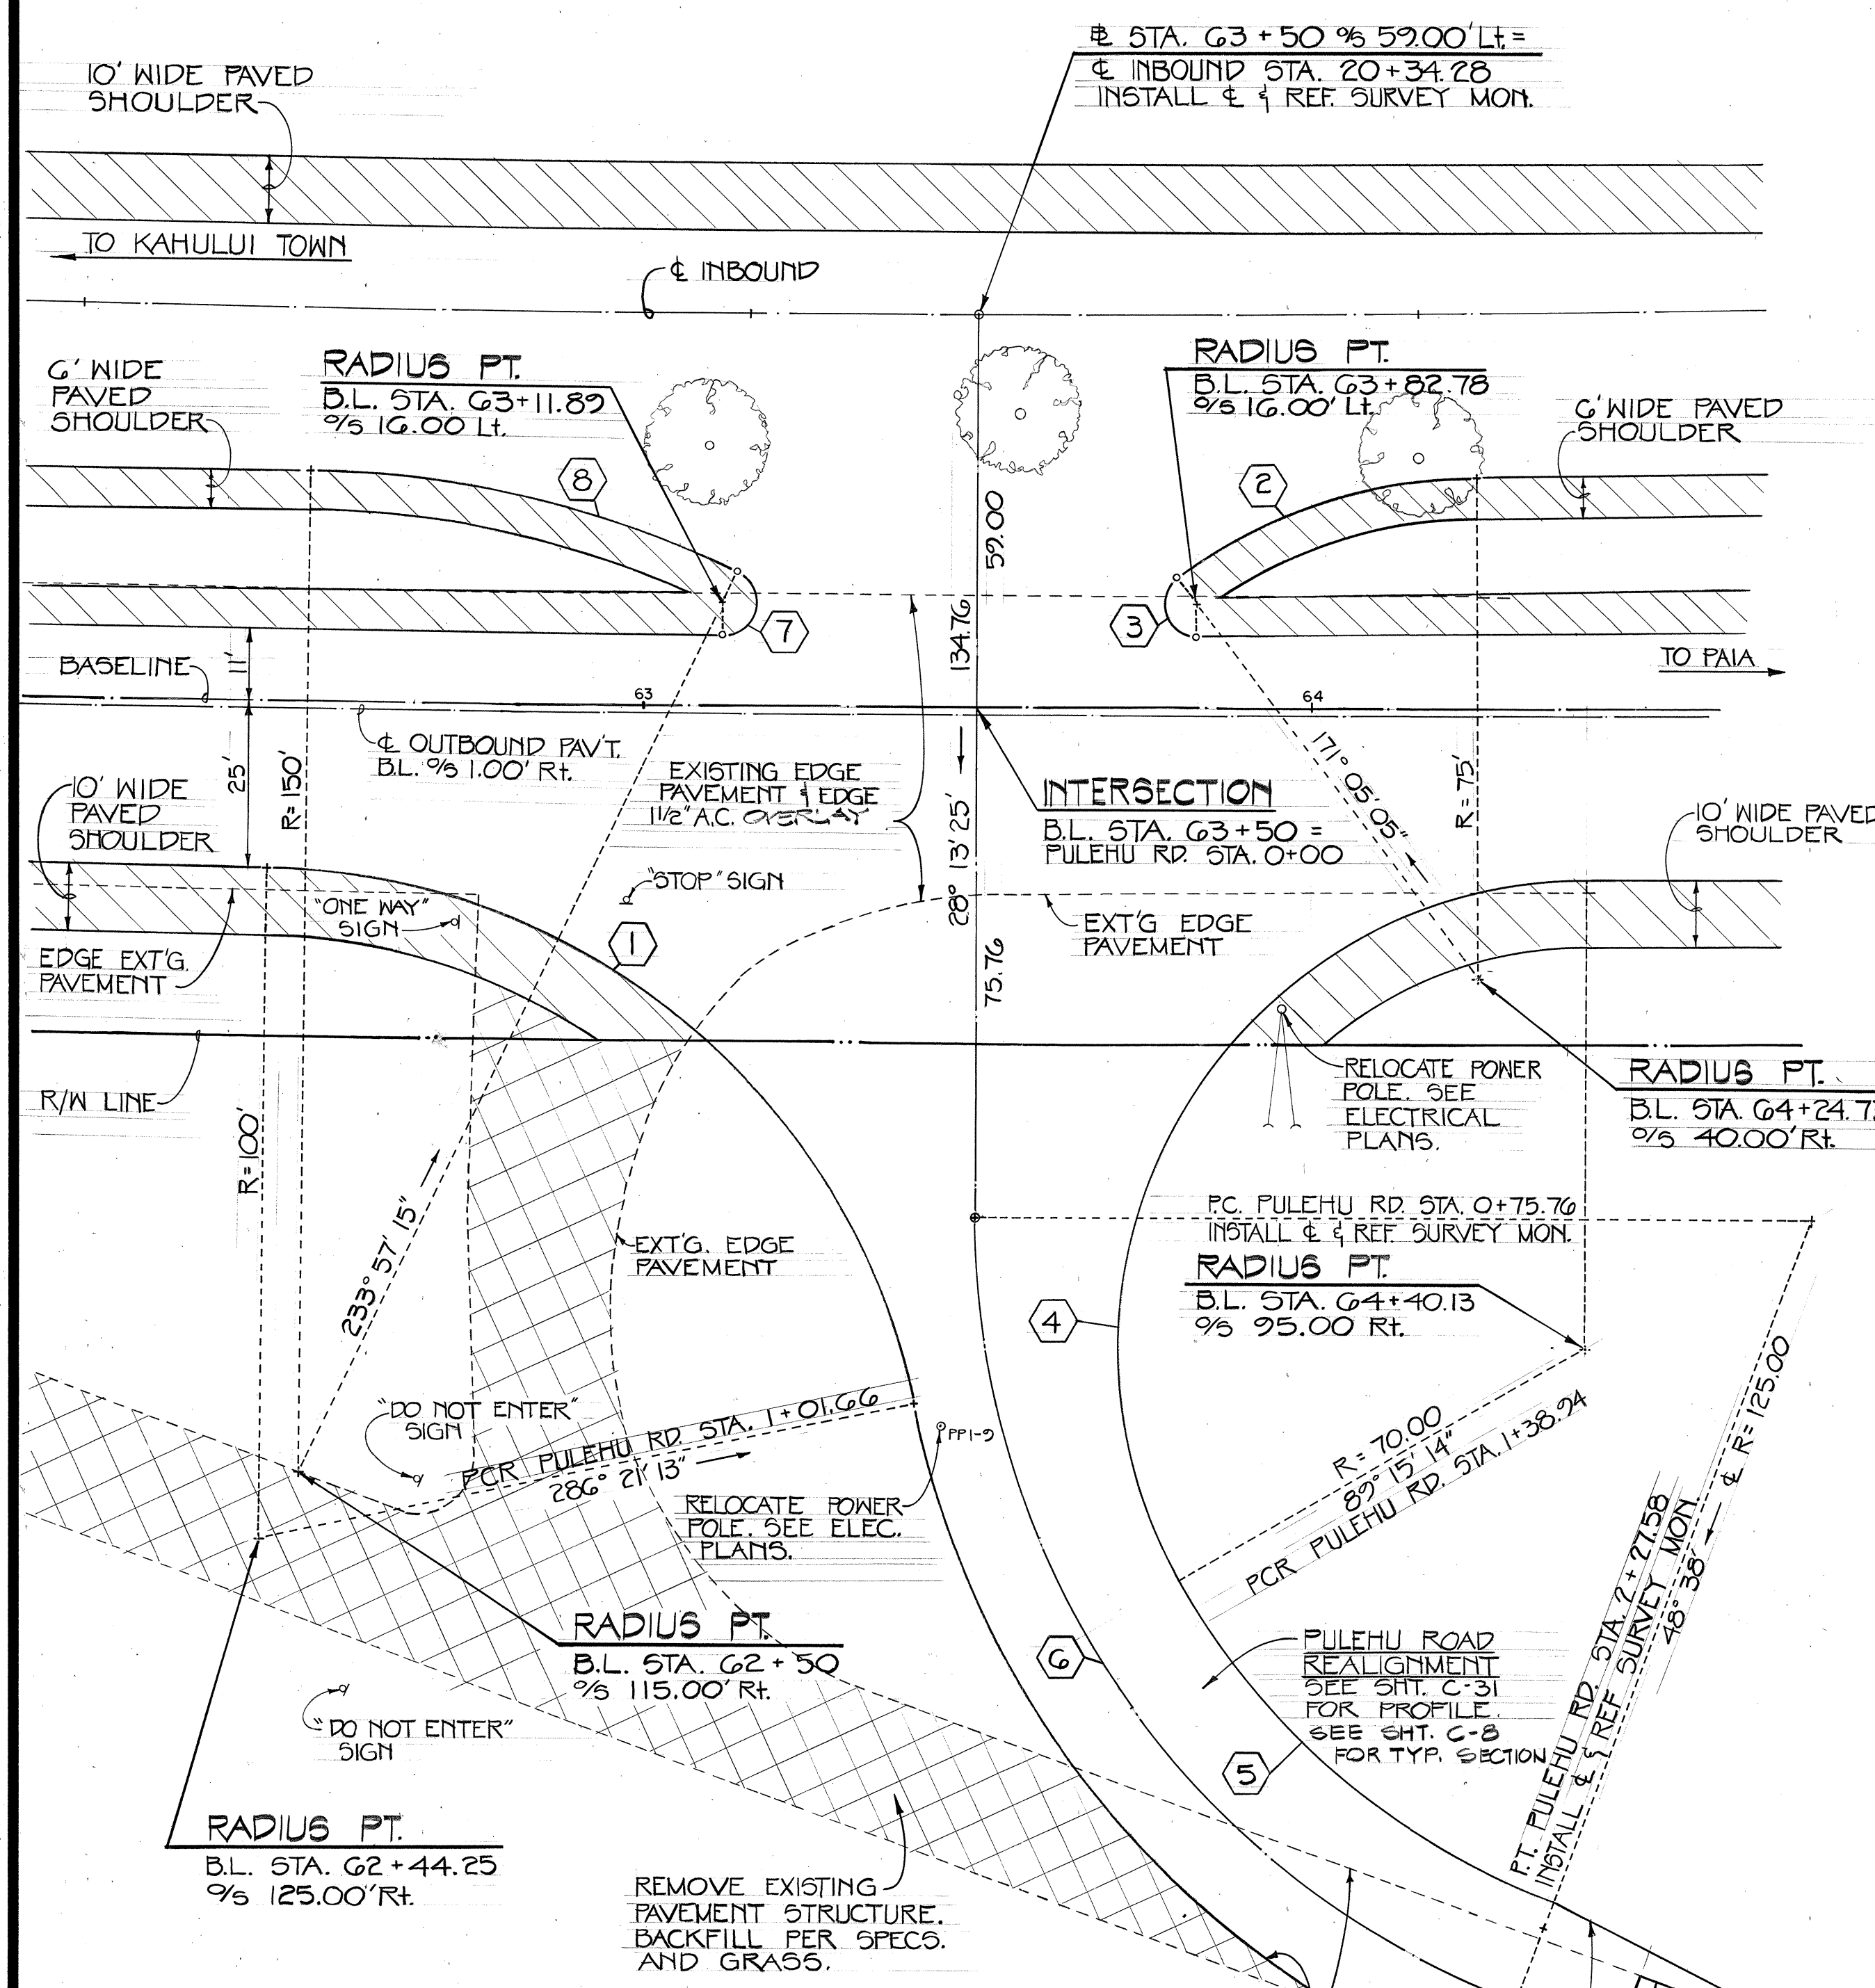


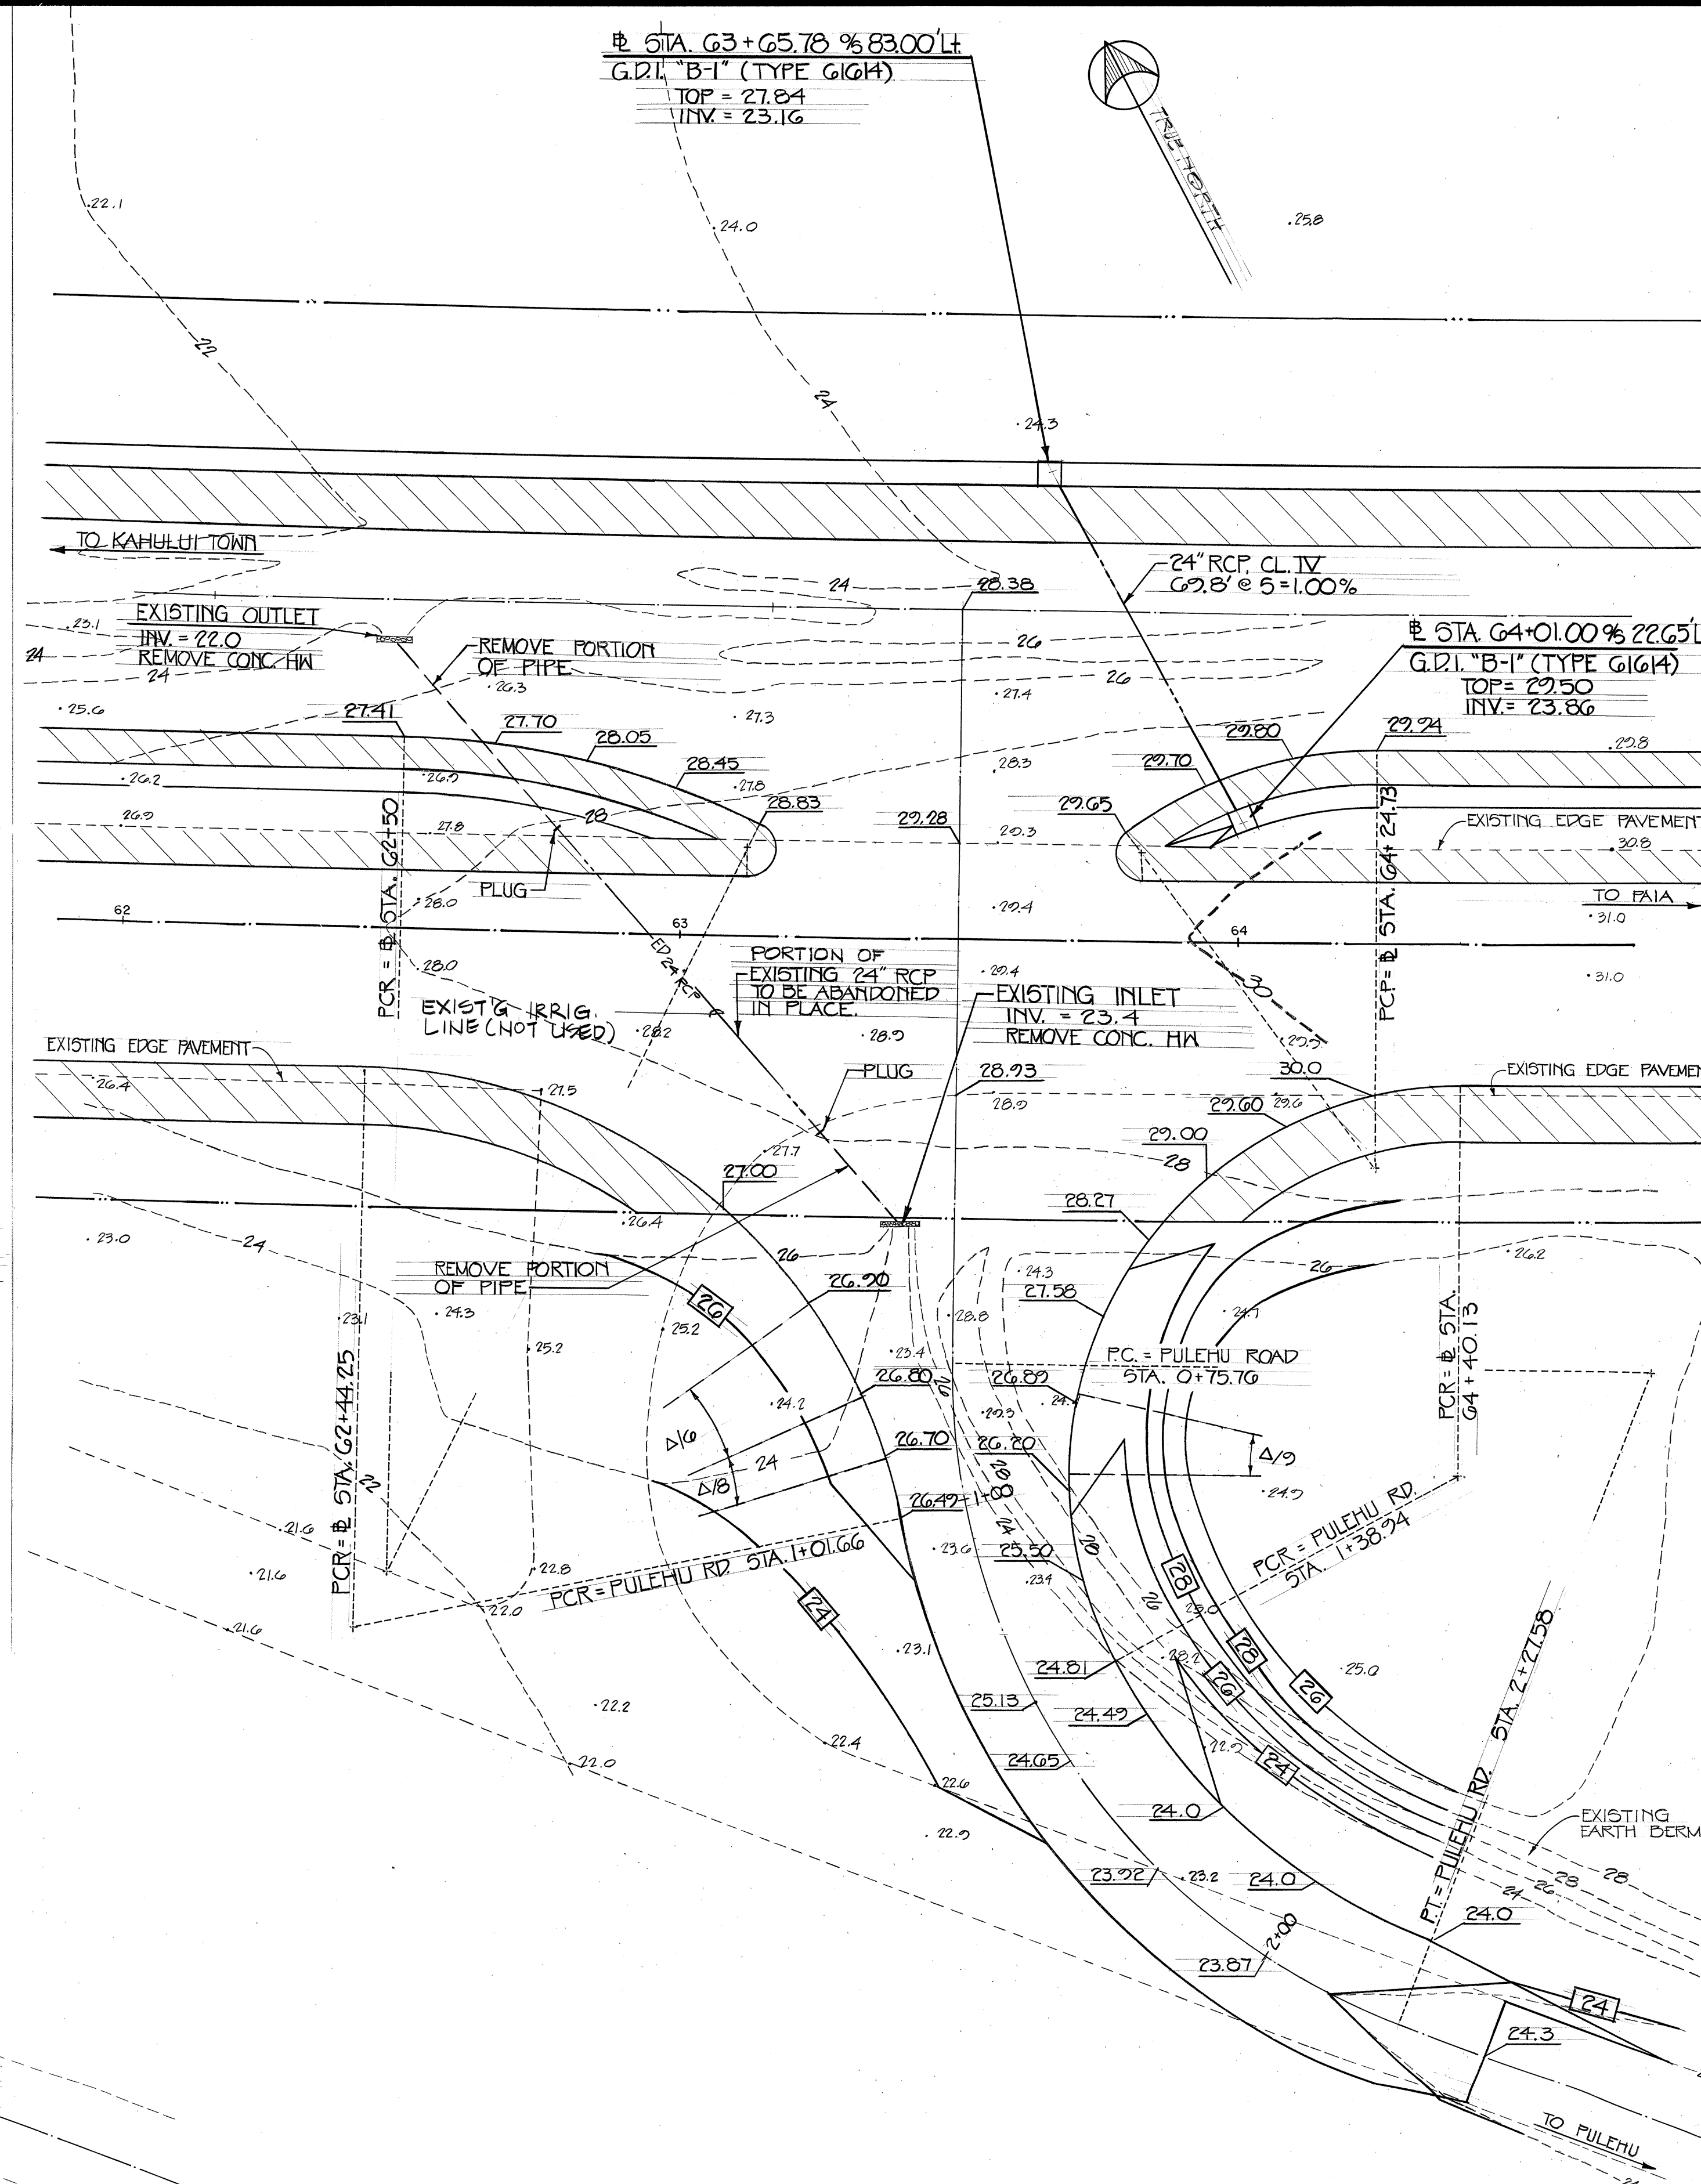

No.	R	Δ	Lc	T	C
1	100.00	77°36'04"	135.44	80.40	125.32
2	75.00	36°45'55"	48.13	24.92	47.30
3	5.00	143°01'30"	12.48	14.95	9.48
4	70.00	118°30'42"	144.79	117.69	120.32
5	109.00	40°37'40"	77.29	40.35	75.68
6	125.00	69°35'25"	151.82	86.86	142.66
7	5.00	154°37'36"	13.48	22.06	9.75
8	150.00	25°13'50"	66.05	33.57	3.71

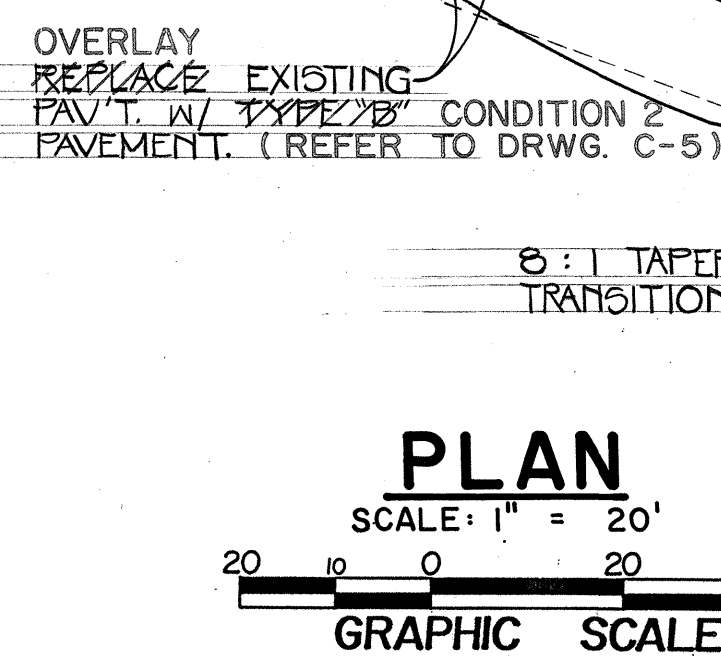


GRADING PLAN

SCALE: 1" = 20'


20 10 0 20 40

GRAPHIC SCALE

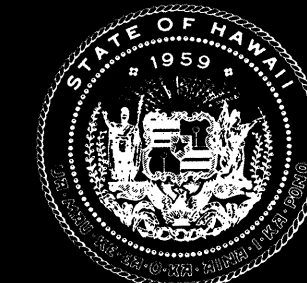

Airports Division
DEPARTMENT OF TRANSPORTATION
STATE OF HAWAII

THIS WORK WAS PREPARED BY ME
OR UNDER MY DIRECT SUPERVISION.

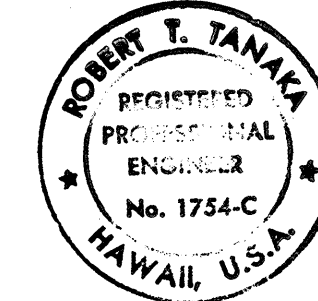

R. T. TANAKA ENGINEERS, INC.
871 KOLU STREET, SUITE 201
WAILUKU, MAUI, HAWAII 96793

DSGN. DRWN. CHKD. APPD.

R.H.	C.N.	R.T.T.
------	------	--------

KEY PLAN / NOTES :

NO.	DATE	REVISIONS
-----	------	-----------

AS-BUILT

DATE 7/12/91

This Drawing has been prepared, in part, based upon information furnished by . While this information is believed to be reliable, the Design Period, and cannot assure its accuracy of this As-Built drawing or future errors or omission which may have been incorporated into it as a result.

PROJECT TITLE :

HANA HIGHWAY IMPROVEMENTS

PROJECT NO. :

STATE NO. AM - 1061 - 12
AIP NO. 3 - 15 - 0006 - 11



SHEET TITLE :

PULEHU ROAD INTERSECTION PLANS

DATE : 11-15-82

DWG. NO. :


C-24

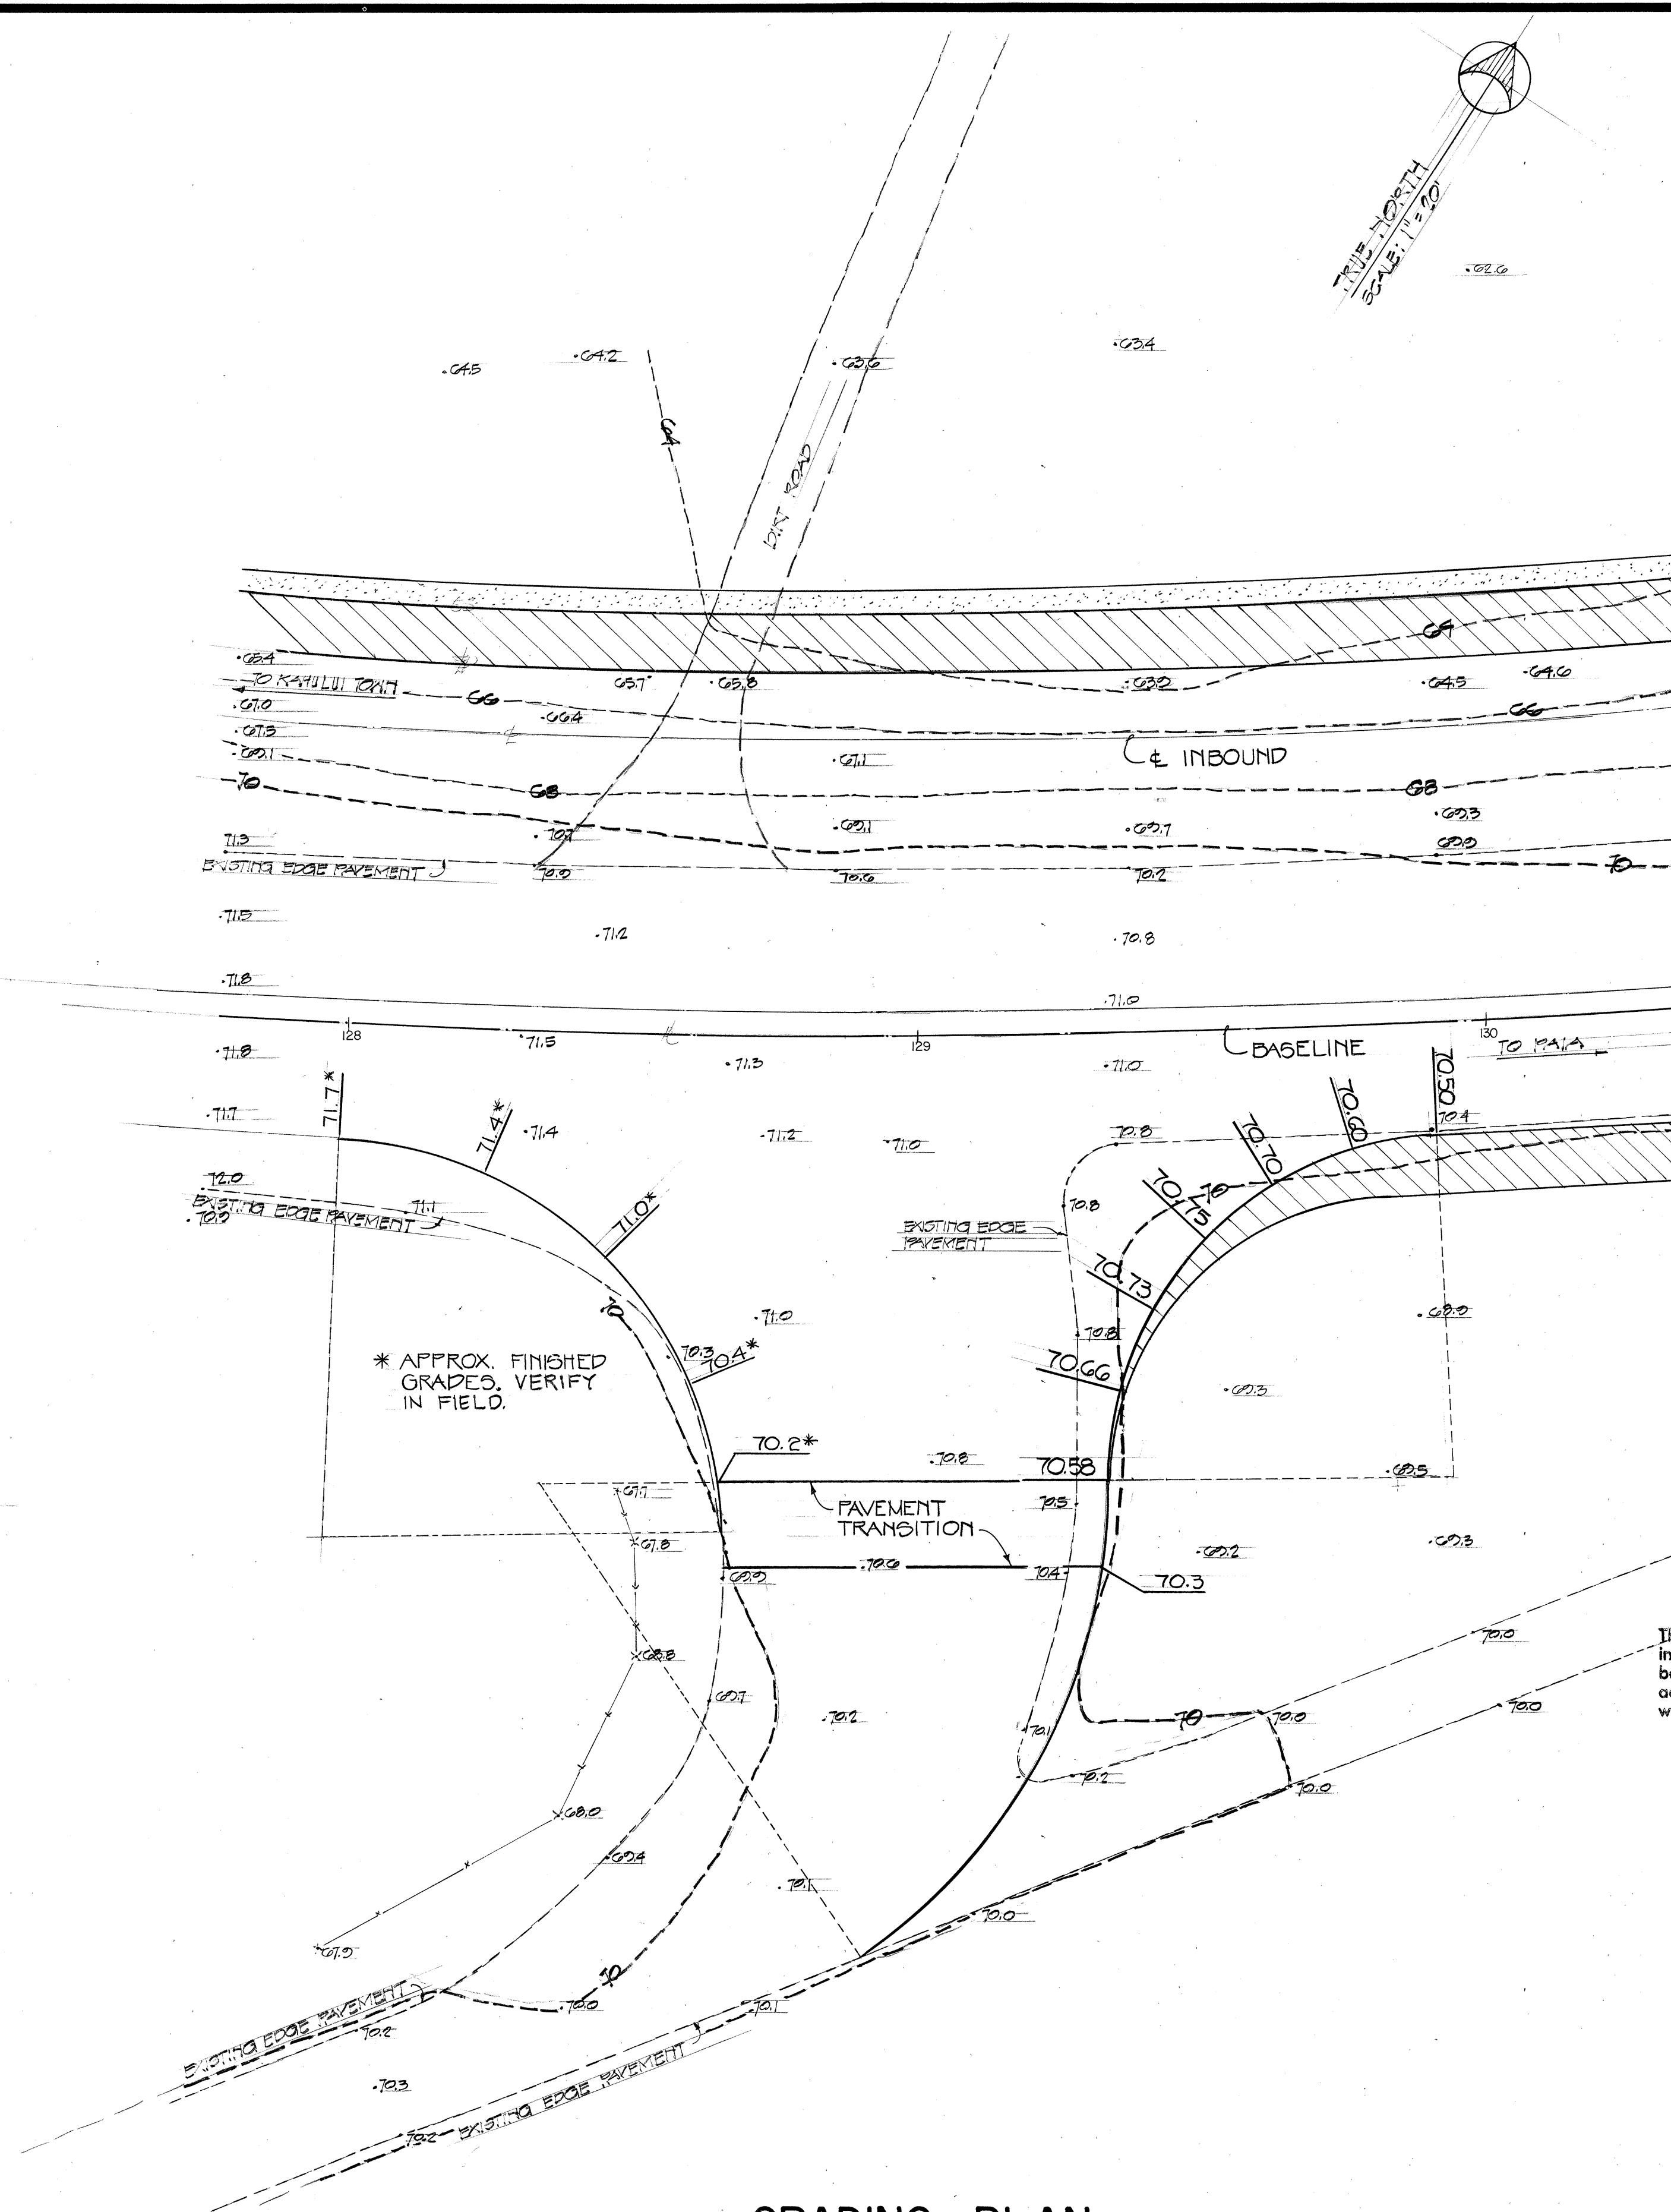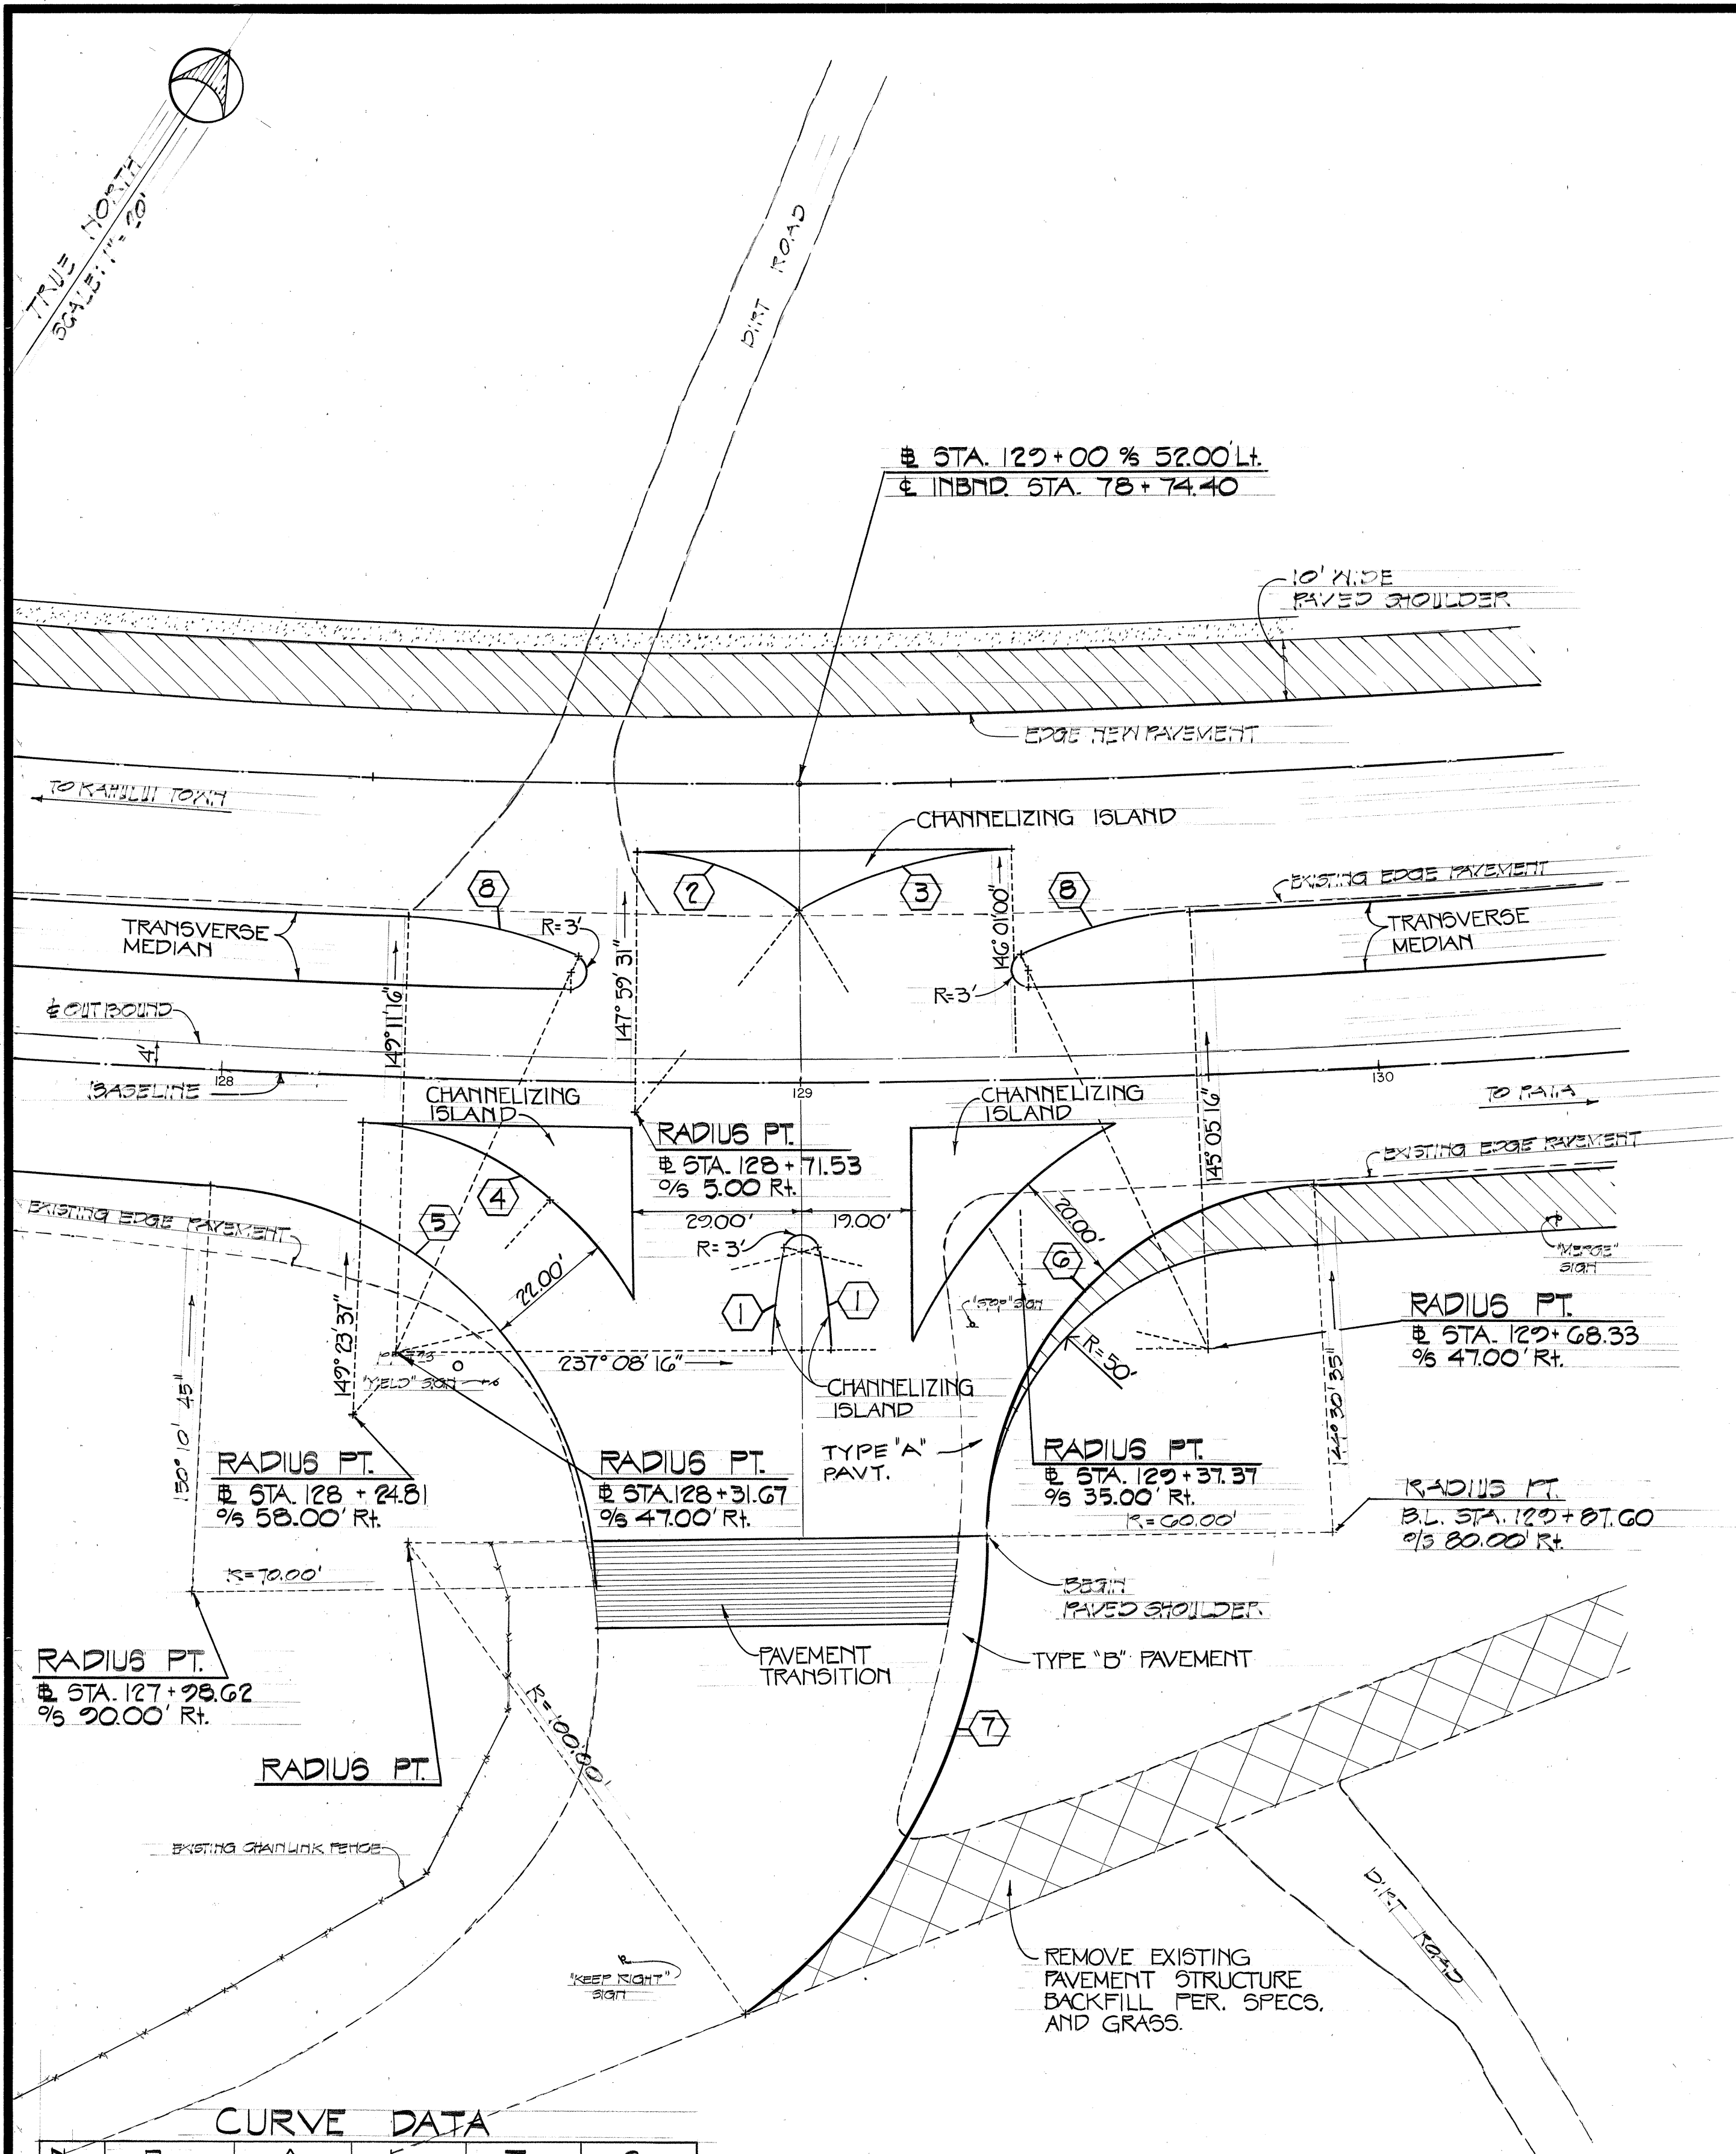

Airports Division
DEPARTMENT OF TRANSPORTATION
STATE OF HAWAII

THIS WORK WAS PREPARED BY
ME OR UNDER MY SUPERVISION.

Robert T. Tanaka
10/13/89

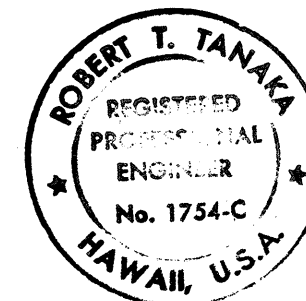

R. T. TANAKA ENGINEERS, INC.
871 KOLU STREET, SUITE 201
WAILUKU, MAUI, HAWAII 96793

DSGN. DRWN. CHKD. APPD.

R.H. M.K./C.N. R.T.T.

KEY PLAN / NOTES :

NO. DATE REVISIONS

AS-BUILT
DATE: 7/12/91

(Record Drawing)

This drawing has been prepared, in part, based upon information furnished by others. While this information is believed to be reliable, the Design Professional cannot assure its accuracy of this As-Built drawing or for any errors or omissions which may have been incorporated into it as a result.

PROJECT TITLE :

HANA HIGHWAY
IMPROVEMENTS

PROJECT NO. :

STATE NO. AM-1061-12
AIP NO. 3-15-0006-11

SHEET TITLE :


HANSEN ROAD
INTERSECTION PLANS

DATE :

11-15-89

DWG. NO. :


C-25

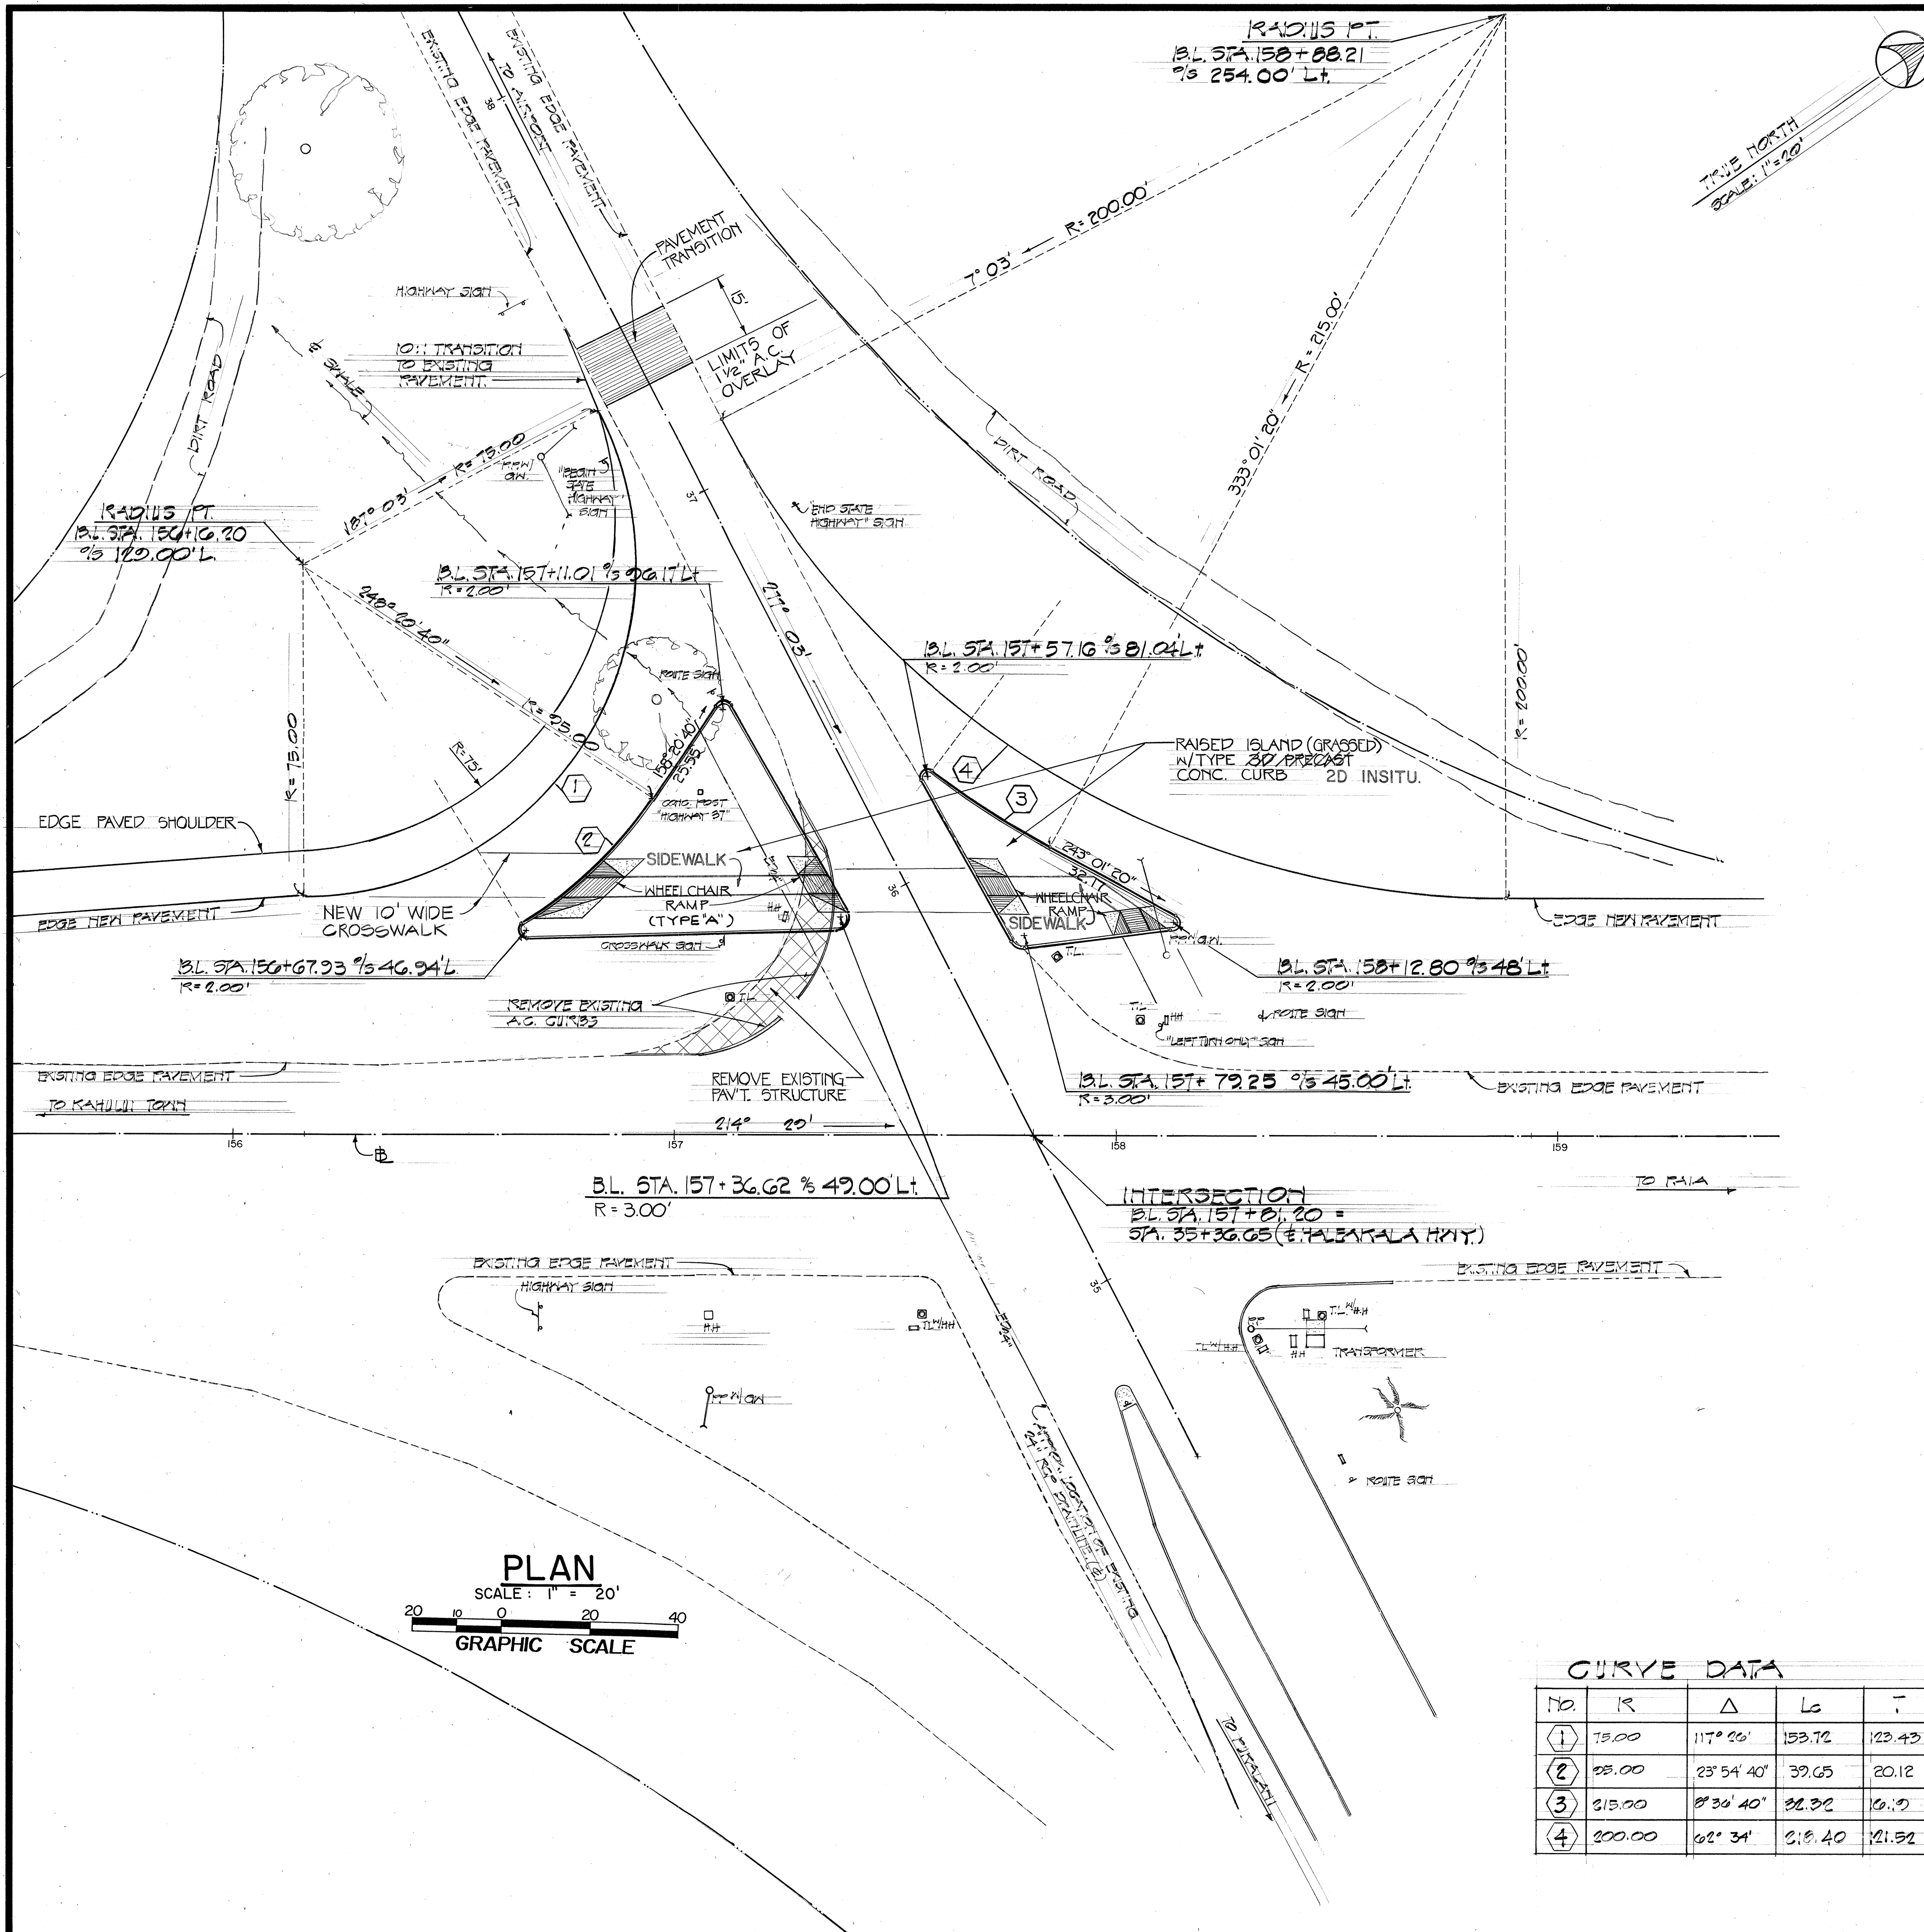

Airports Division
DEPARTMENT OF TRANSPORTATION
STATE OF HAWAII

THIS WORK WAS PREPARED BY
ME OR UNDER MY SUPERVISION.

Robert T. Tanaka
10/13/91

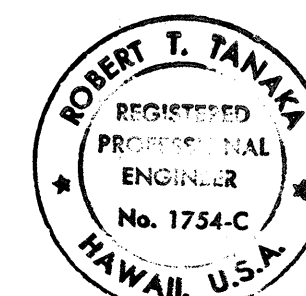

R. T. TANAKA ENGINEERS, INC.
871 KOLU STREET, SUITE 201
WAILUKU, MAUI, HAWAII 96793

DSGN. DRWN. CHKD. APPD.

R.H. M.K./C.N. R.T.T.

KEY PLAN / NOTES :

NO. DATE REVISIONS

AS-BUILT (Record Drawing)

DATE 7/12/91

This Drawing has been prepared, in part, based upon information furnished by others. While this information is believed to be reliable, the Design Professional cannot assure its accuracy of this As-Built drawing or for any errors or omissions which may have been incorporated into it as a result.

PROJECT TITLE :

HANA HIGHWAY
IMPROVEMENTS

PROJECT NO. :

STATE NO. AM-1061-12
AIP NO. 3-15-0006-11

SHEET TITLE :



HALEAKALA HIGHWAY
INTERSECTION PLANS

DATE :

11-15-89

DWG. NO. :


C-26

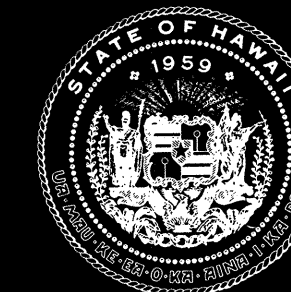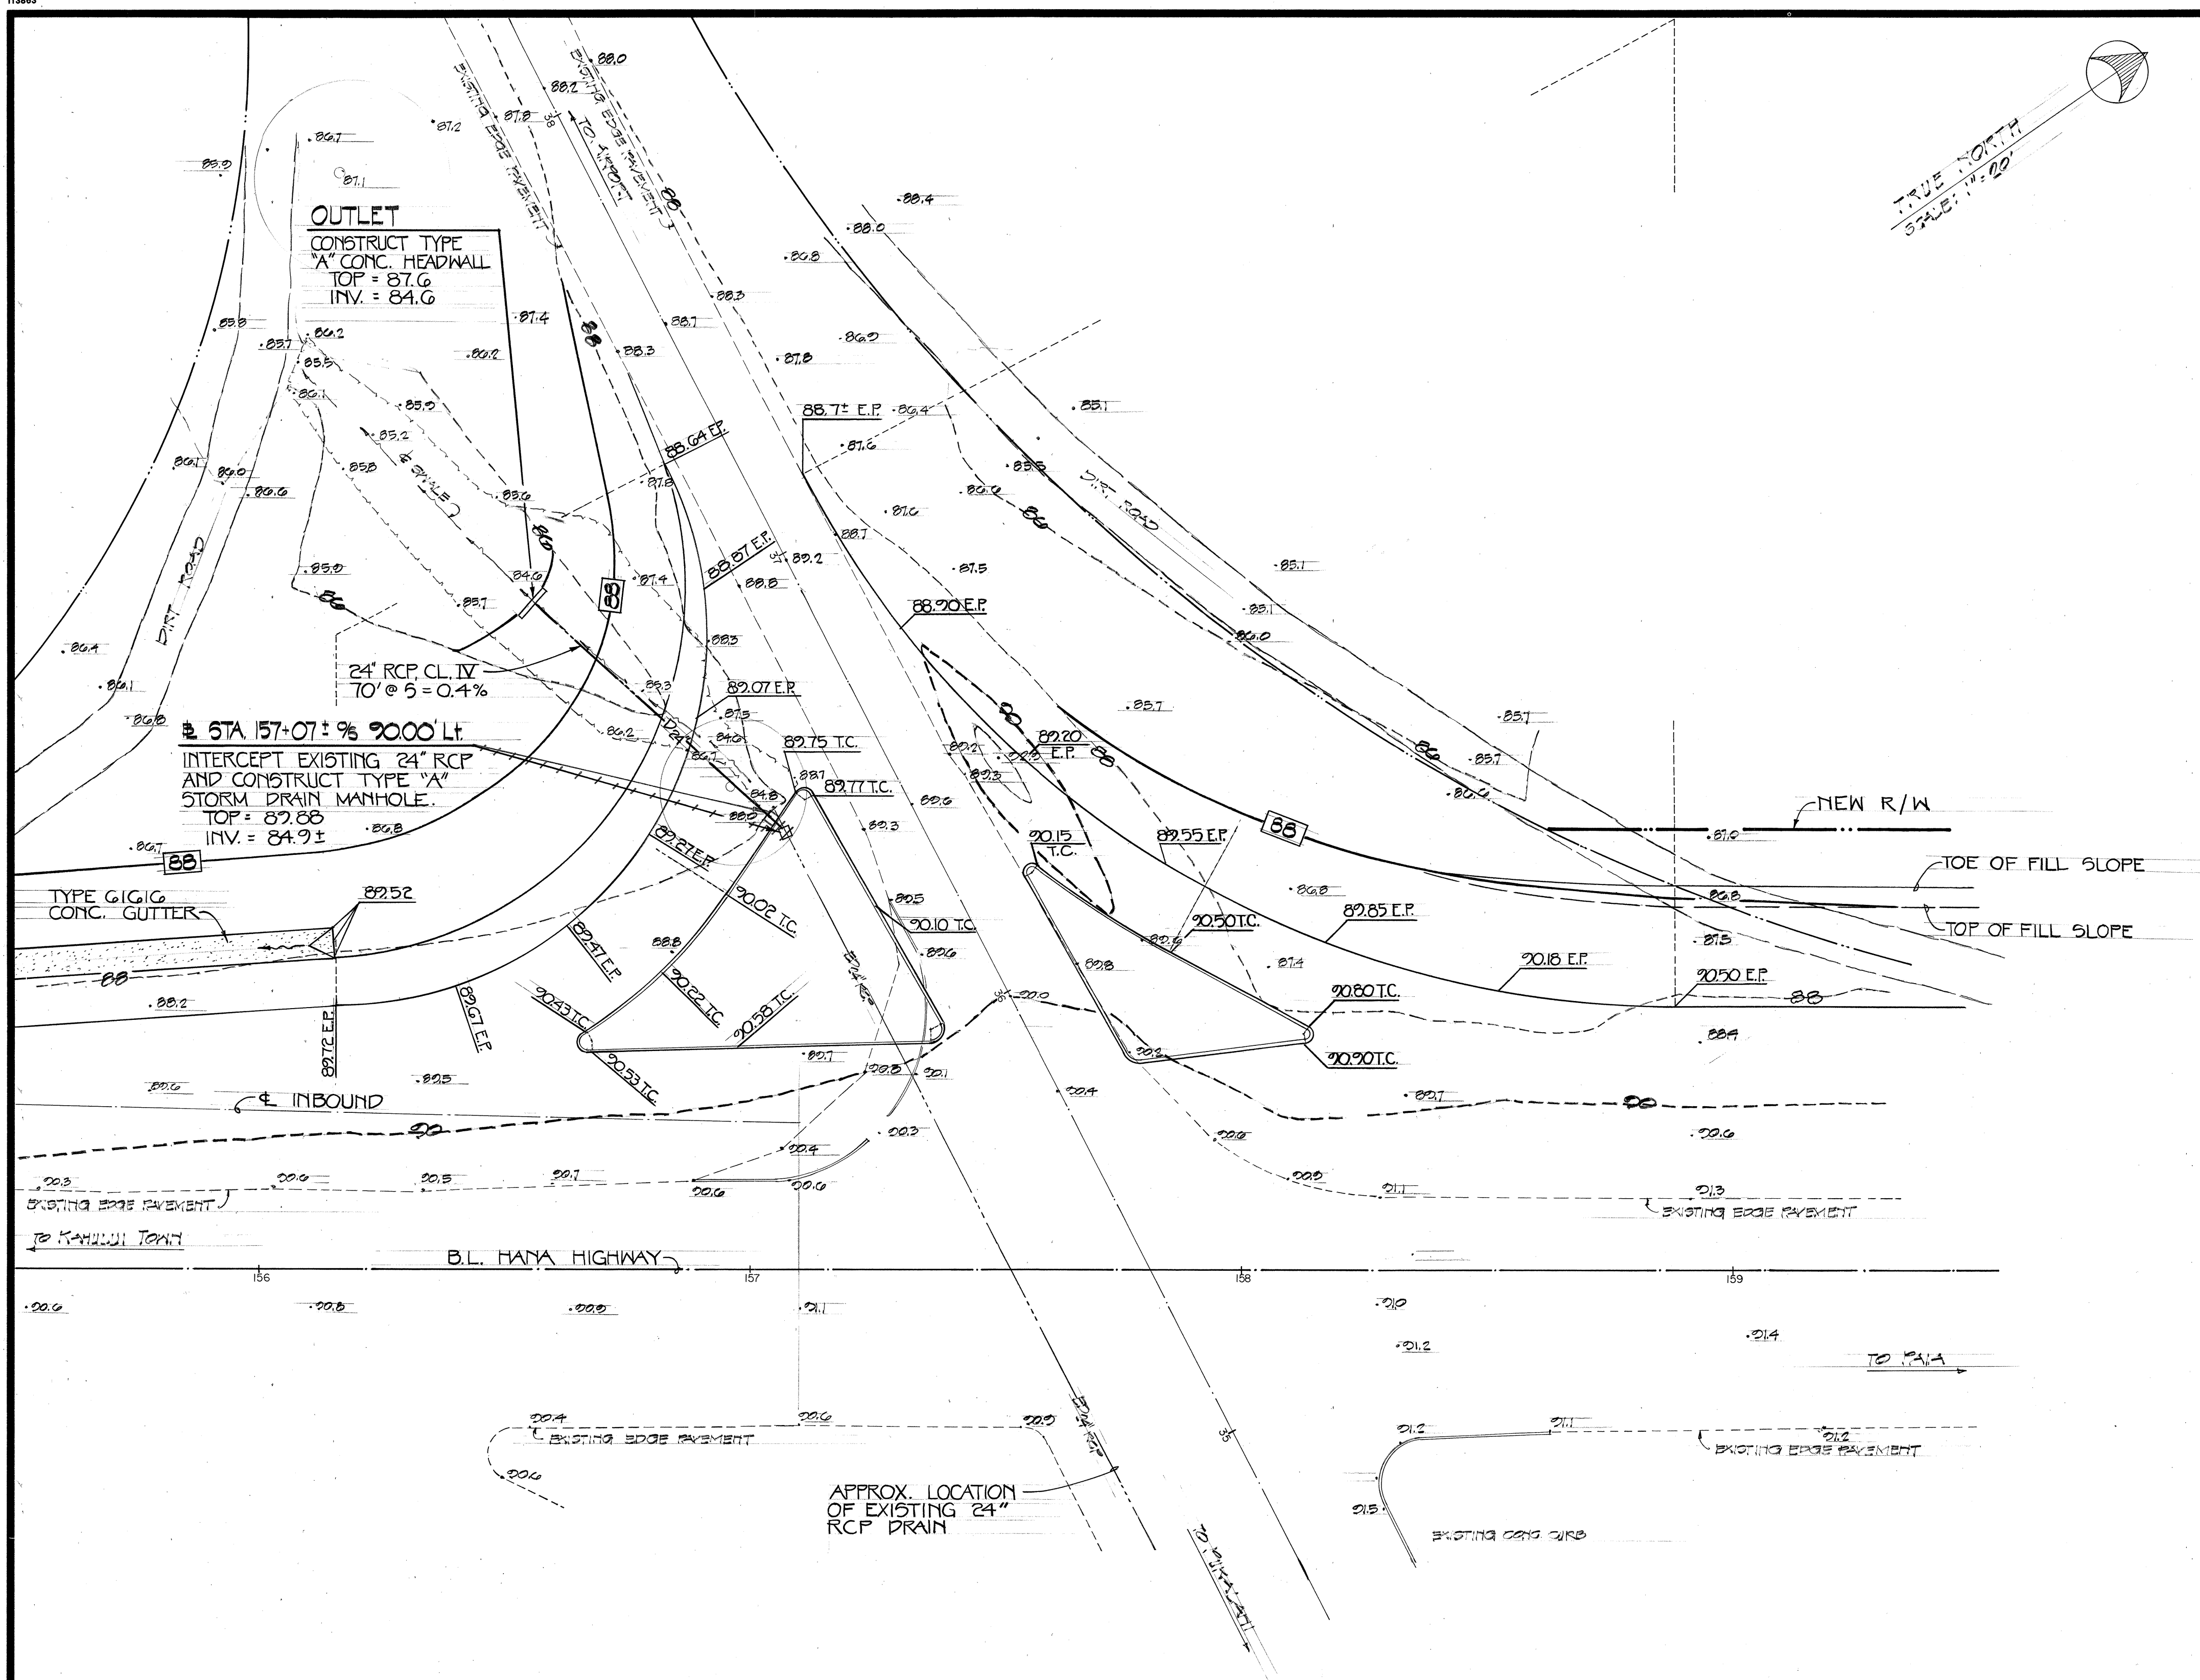

Airports Division
DEPARTMENT OF TRANSPORTATION
STATE OF HAWAII

HIS WORK WAS PREPARED BY
ME OR UNDER MY SUPERVISION.

[Signature]
10/3/91

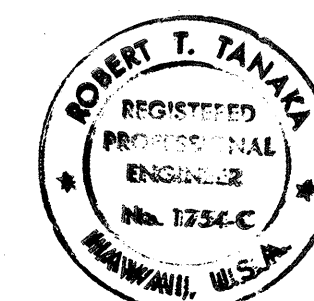

R. T. TANAKA ENGINEERS, INC.
871 KOLU STREET, SUITE 201
WAILUKU, MAUI, HAWAII 96793

DSGN. DRWN. CHKD. APPD.

R.H. C.N. R.T.T.

KEY PLAN / NOTES :

NO. DATE REVISIONS

AS-BUILT
(Record Drawing)

DATE 7/12/91

This Drawing has been prepared, in part, based upon information furnished by others. While this information is believed to be reliable, the Design Professional cannot assume its accuracy of this As-Built drawing or for any errors or omissions which may have been incorporated into it as a result.

PROJECT TITLE :

**HANA HIGHWAY
IMPROVEMENTS**

PROJECT NO. :

STATE NO. AM-1061-12
AIP NO. 3-15-0006-11

SHEET TITLE :

**HALEAKALA HIGHWAY
INTERSECTION PLANS**

DATE :

10-3-89

DWG. NO. :

C-27