


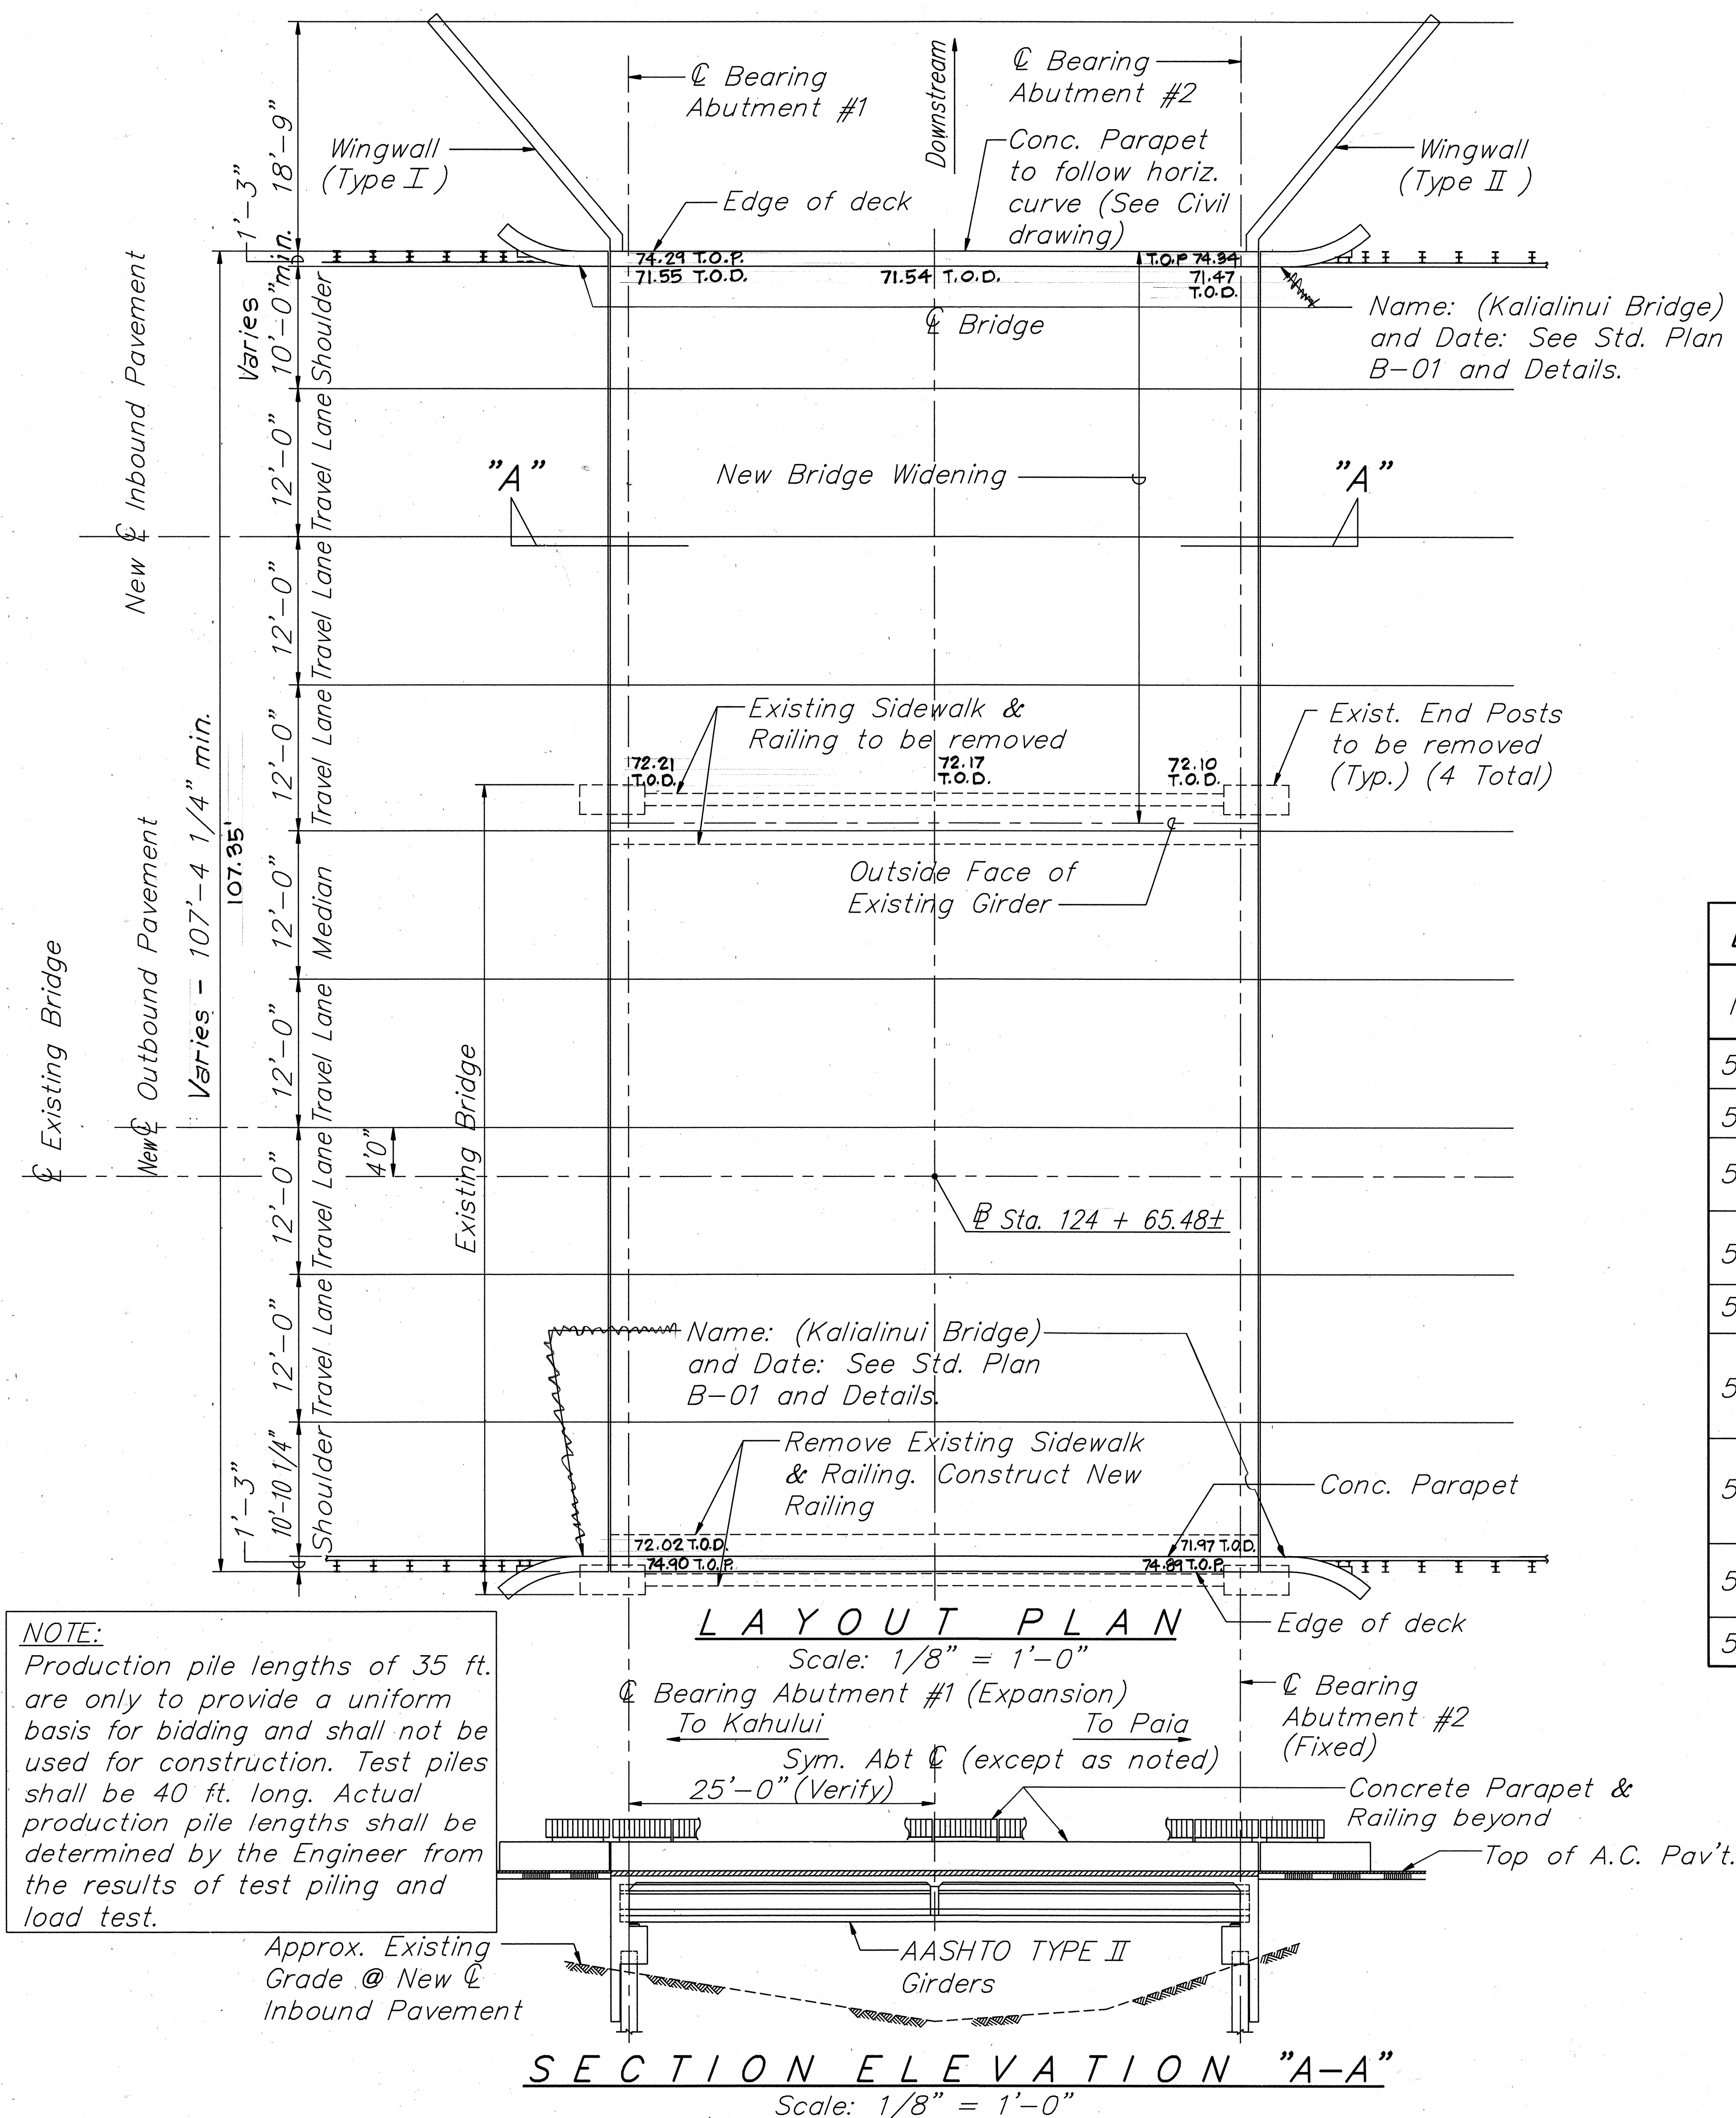

INDEX TO DRAWINGS	
SHEET NO.	DESCRIPTION
S-1	INDEX TO DRAWINGS, LAYOUT PLAN AND LONGITUDINAL ELEVATION
S-1A	FOUNDATION PLAN AND STRUCTURAL NOTES
S-2	TYPICAL AND NORMAL DECK SECTION
S-3	BRIDGE DECK, CONCRETE PARAPET AND DIAPHRAGM DETAILS
S-4	PRESTRESSED BEAM DETAILS
S-5	ABUTMENT ELEVATION AND DETAILS
S-6	ABUTMENT PLAN AND SEAT DETAILS
S-7	WINGWALL ELEVATION AND DETAILS
S-8	METAL GUARD RAIL CONNECTION AND END POST
S-9	METAL RAILING
S-10	METAL RAILING, METAL GUARDRAIL CONNECTION & END POST
S-11	TYPICAL ARRANGEMENT OF TOP REINF. PILE PLACEMENT AT ABUTMENTS

NOTE: A COMPLETE SET HAS 12 SHEETS.

ESTIMATED QUANTITIES			
Item No.	Item	Approx. Quant.	Unit
505.0010	Pile Load Test	1	Each
505.0020	Test Piles, Driven	34	Lin. Ft.
505.0410	Precast, Prestressed Concrete Piles, Furnished	710	Lin. Ft.
505.4100	Precast, Prestressed Concrete Piles, Driven	216	Lin. Ft.
505.6000	Drilled Holes	460	Lin. Ft.
505.9000	Extensions or Build-ups to Precast, Prestressed Concrete Piles	--	F.A.
505.9500	Pile Driving Equipment Expense (Not to Exceed \$8,000)	--	Lump Sum
504.2100	Type II Precast Prestressed Concrete Girder	--	Lump Sum
550.0001	Kalialinui Bridge Widening	--	Lump Sum



Airports Division
DEPARTMENT OF TRANSPORTATION
STATE OF HAWAII



THIS WORK WAS PREPARED BY
ME OR UNDER MY SUPERVISION

Harold Takashi Minamoto

DSGN.	DRWN.	CHKD.	APPD.
L.S.	F.G.	V.C.	H.T.M.

KEY PLAN / NOTES :

NO. DATE REVISIONS

RECORD DRAWINGS

This record drawing has been prepared, in part, based upon information furnished by others. The Engineer is thus not responsible for the accuracy of this record drawing or for any errors or omissions which may have been incorporated into it as a result.

Date: July 12, 1991

PROJECT TITLE :

HANA HIGHWAY
IMPROVEMENTS

PROJECT NO. :

STATE PROJ. NO. AM-1061-12
AIP PROJ. NO. 3-15-0006-11

SHEET TITLE :

INDEX TO DRAWINGS,
LAYOUT PLAN AND
LONGITUDINAL ELEV.

DATE :

10-3-87

DWG. NO. :

S-1