



NOTE: 1. CONTRACTOR TO NOTIFY FAA SECTOR FIELD OFFICE PRIOR TO ANY GRADING OR WORK IN THE VICINITY OF FAA NDB BUILDING. SITE TO ASCERTAIN THAT THE BEACON OPERATIONS WILL NOT BE DISRUPTED OR TO ENSURE AN ORDERLY RELOCATION OF CABLES, SIGNAL WIRES, ETC. TO MINIMIZE DISRUPTION OF BEACON'S OPERATIONS. RELOCATION OF NDB COMPONENTS (POLES, ANTENNA, ETC.) AS REQUIRED SHALL BE TO THE REQUIREMENTS OF THE FAA.



2. NO WORK SHALL BE DONE ON FAA LEASED PROPERTY UNTIL APPROVAL TO PROCEED HAS BEEN OBTAINED FROM FAA.

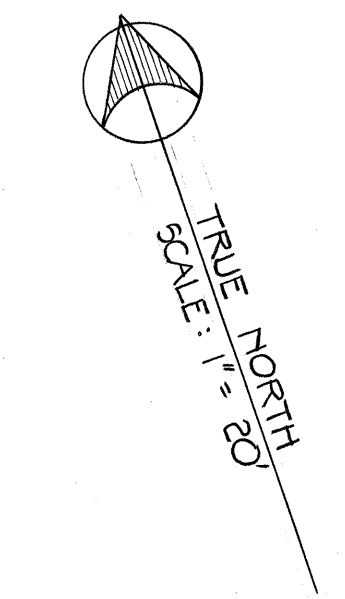


| CURVE DATA |       |        |       |       |       |
|------------|-------|--------|-------|-------|-------|
|            | R     | Δ      | Lc    | T     | C     |
| (1)        | 30.00 | 90°00' | 47.12 | 30.00 | 42.43 |
| (2)        | 20.00 | 73°04' | 25.51 | 14.82 | 23.81 |

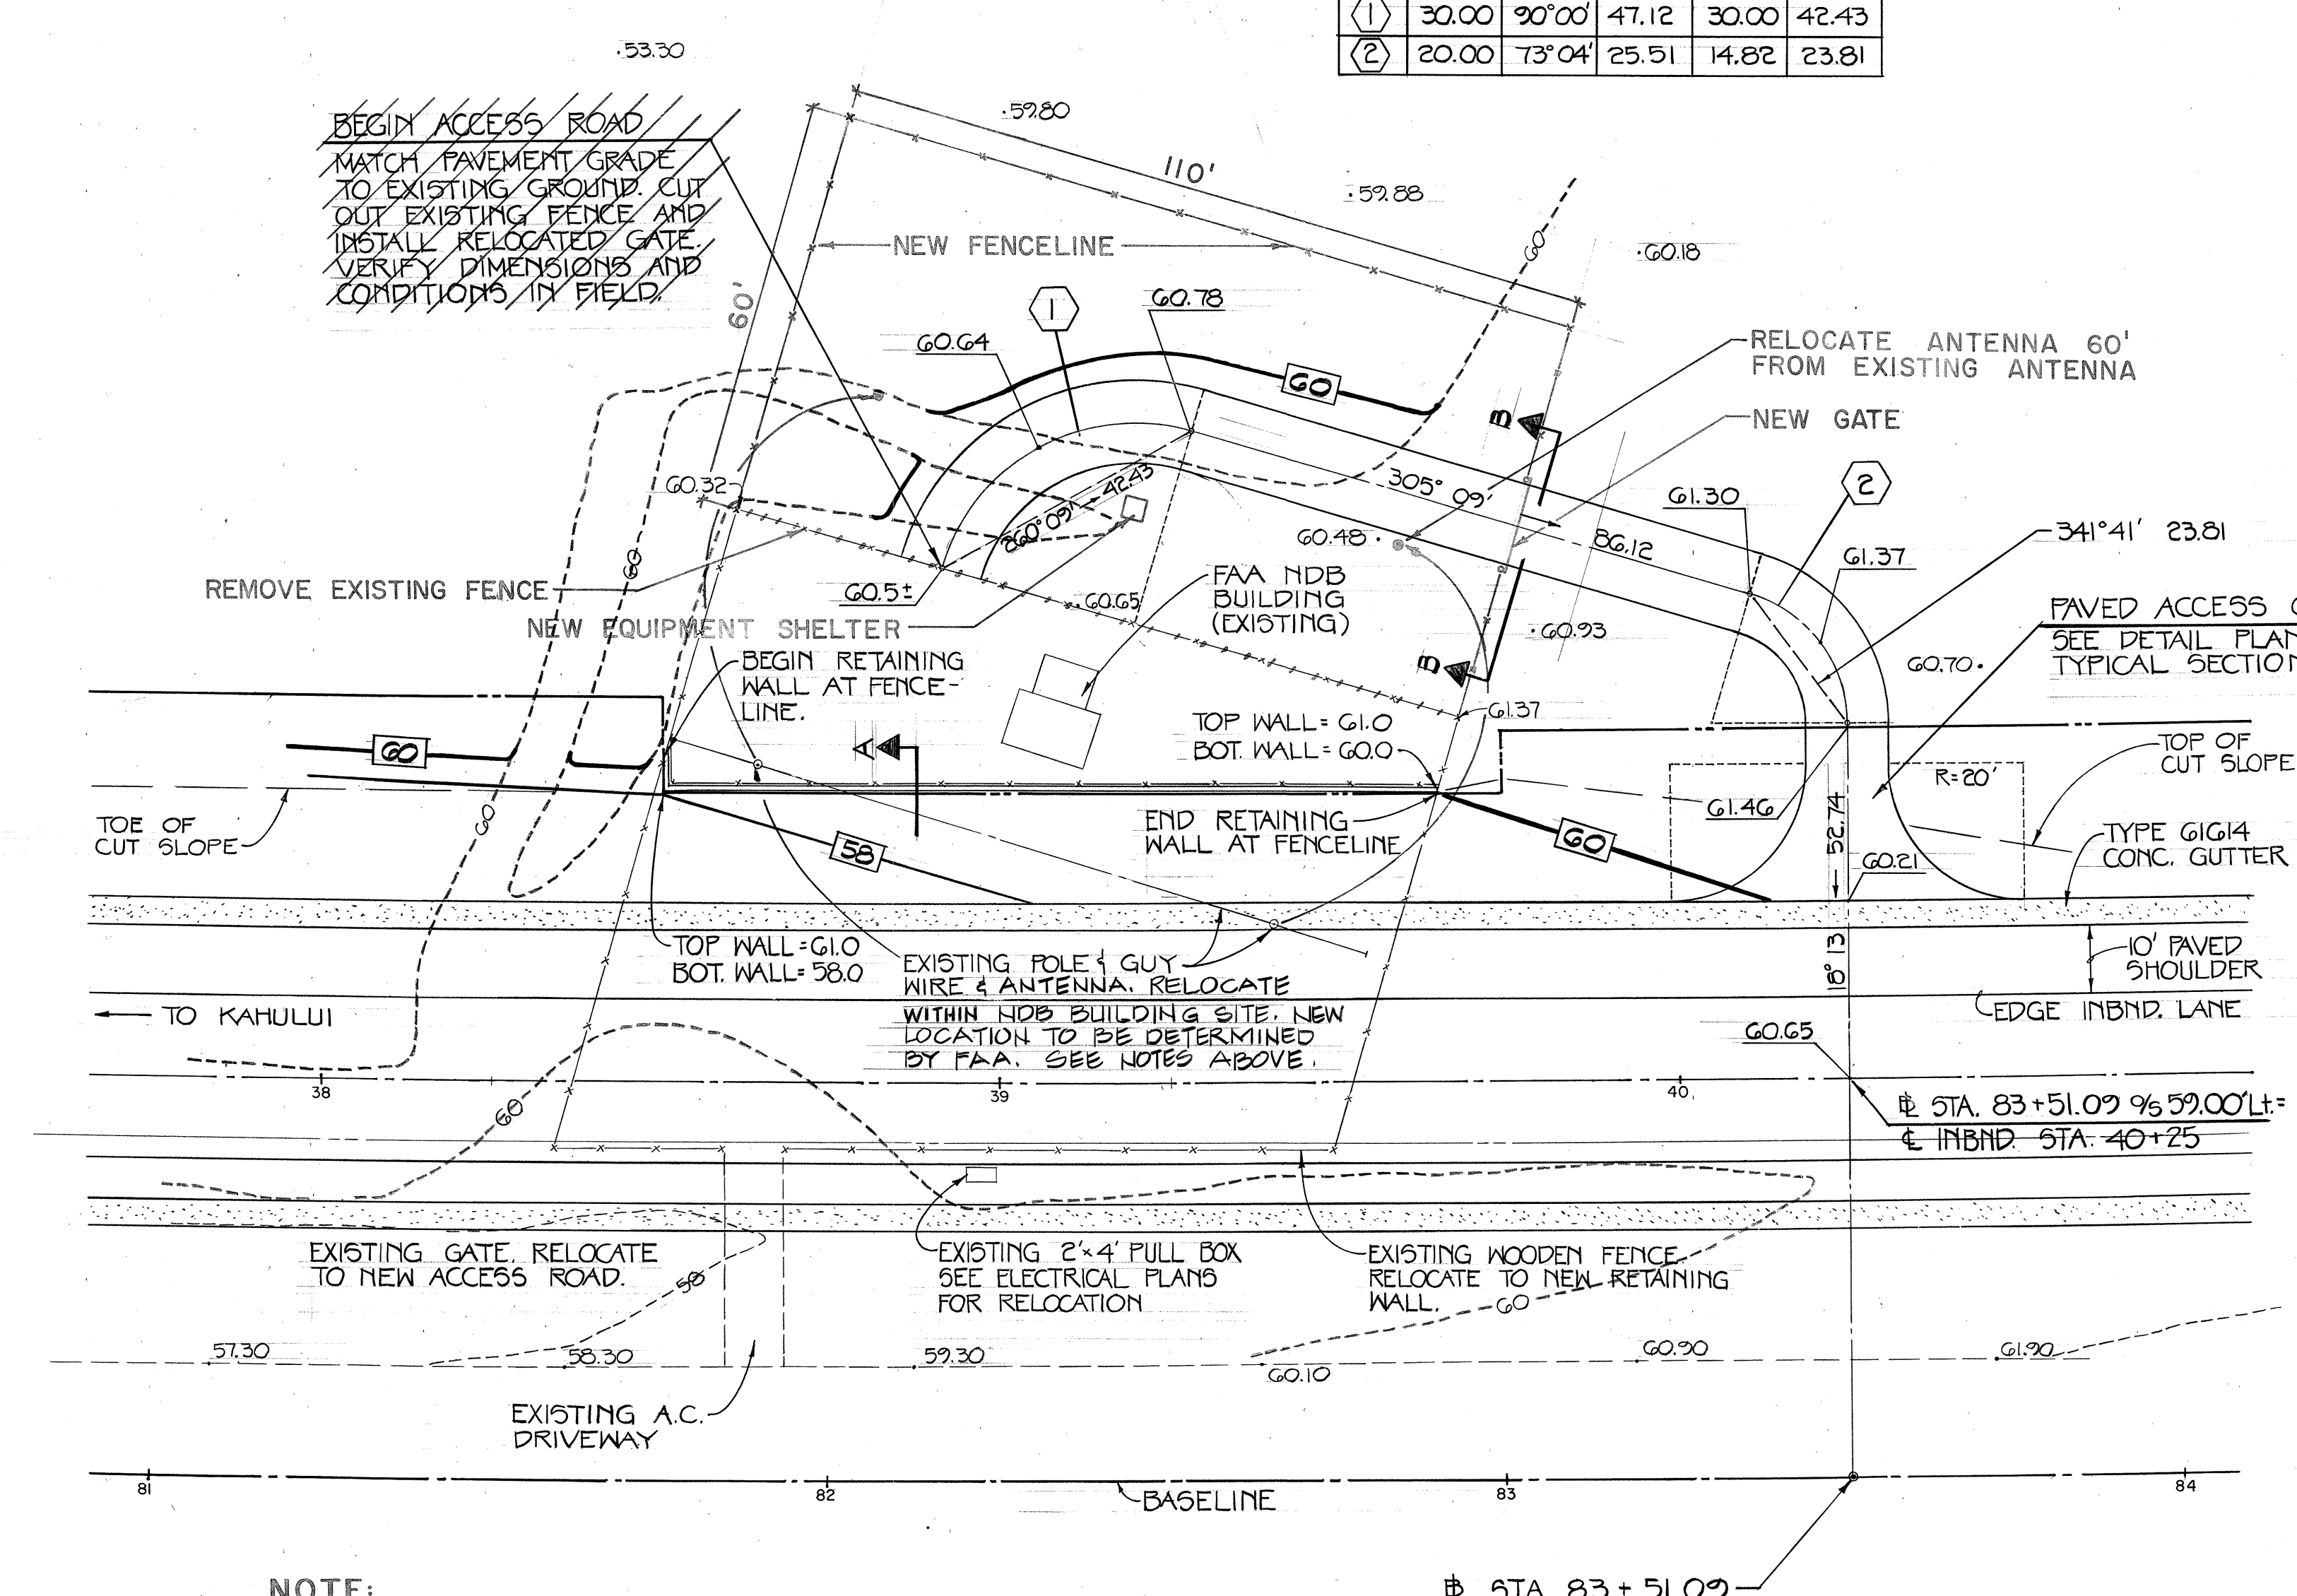


NOTE: SEE SHEET C-61 FOR MISCELLANEOUS MIDDLE MARKER DETAILS.

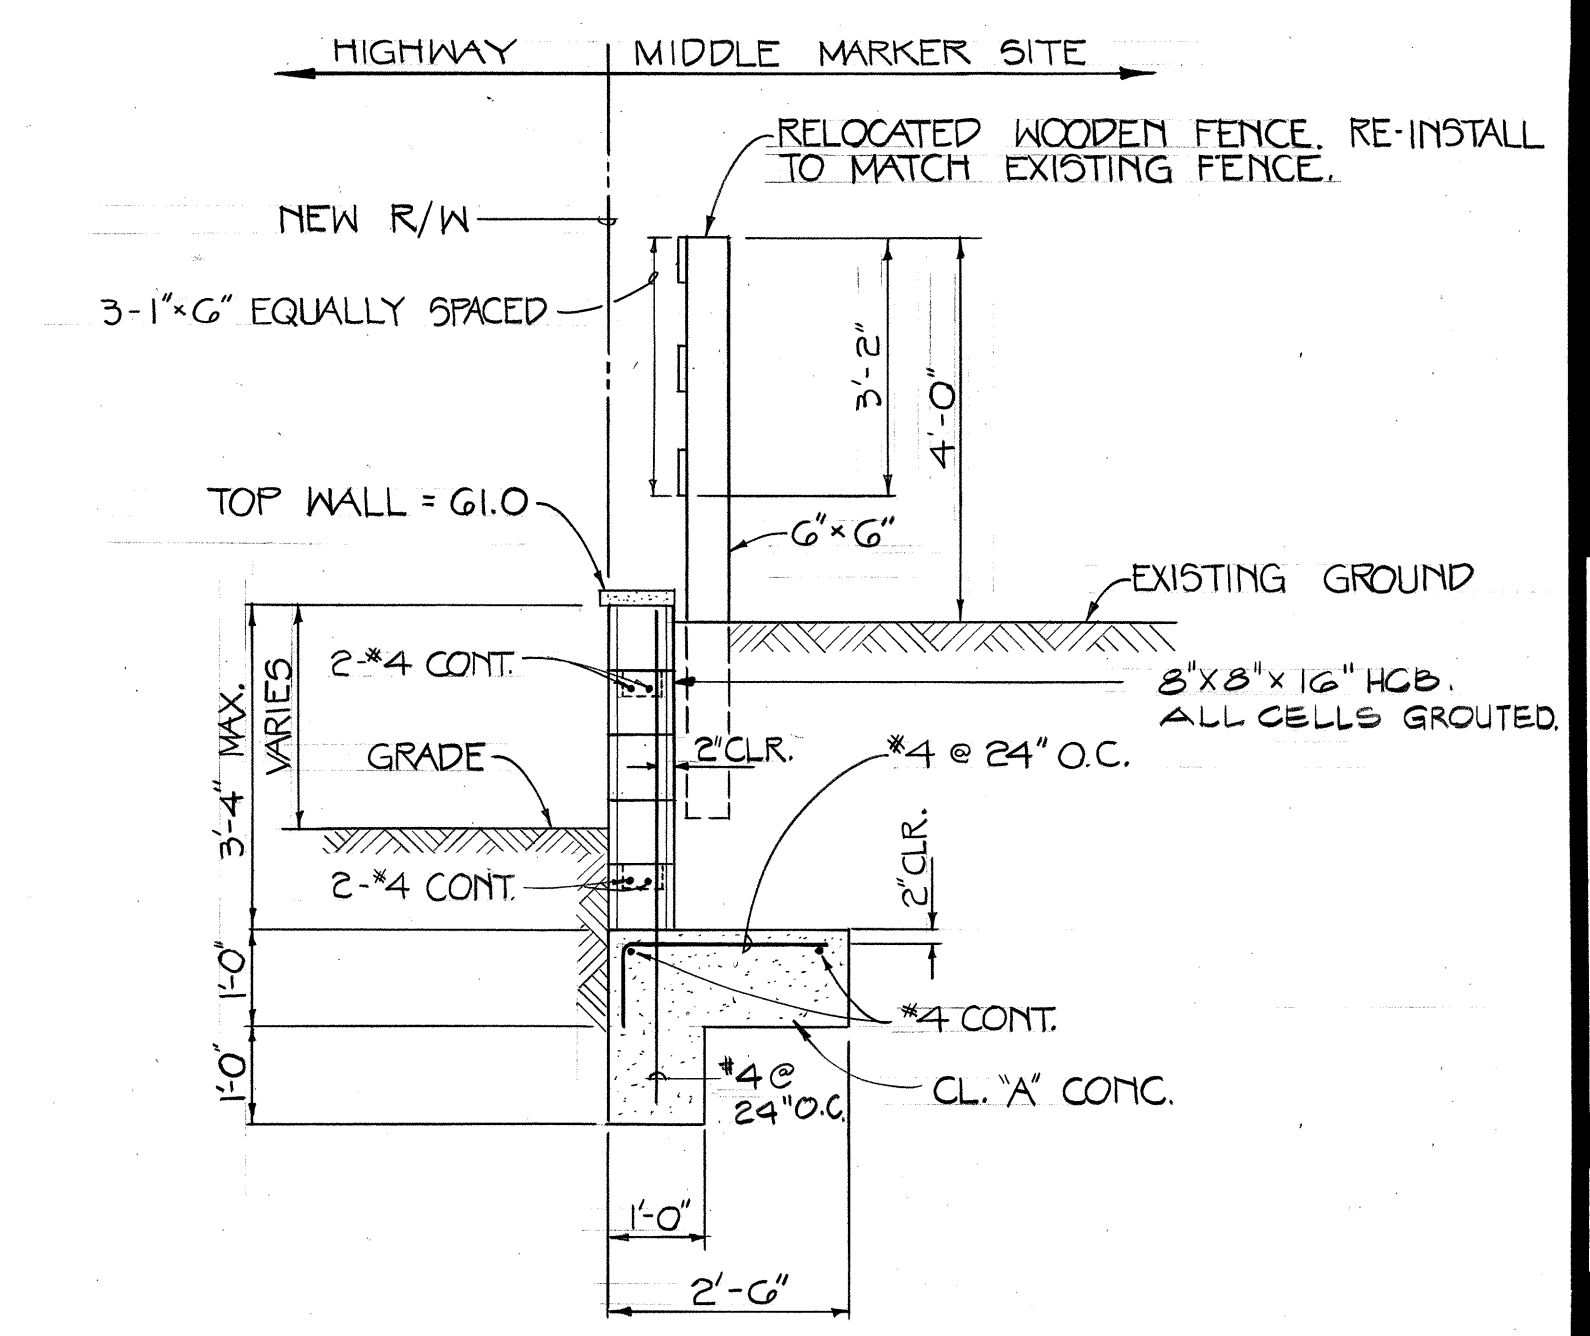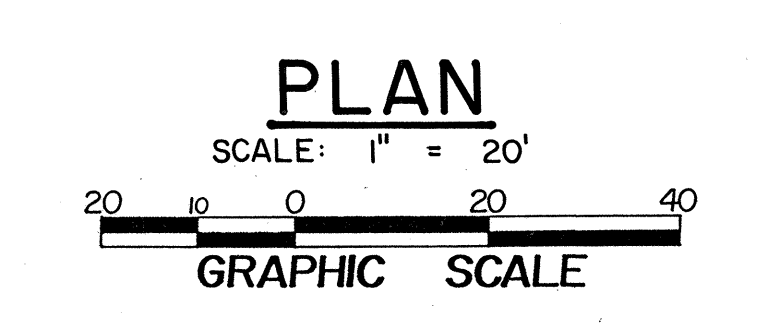


SECTION 'A'  
TYPICAL RETAINING WALL  
NOT TO SCALE

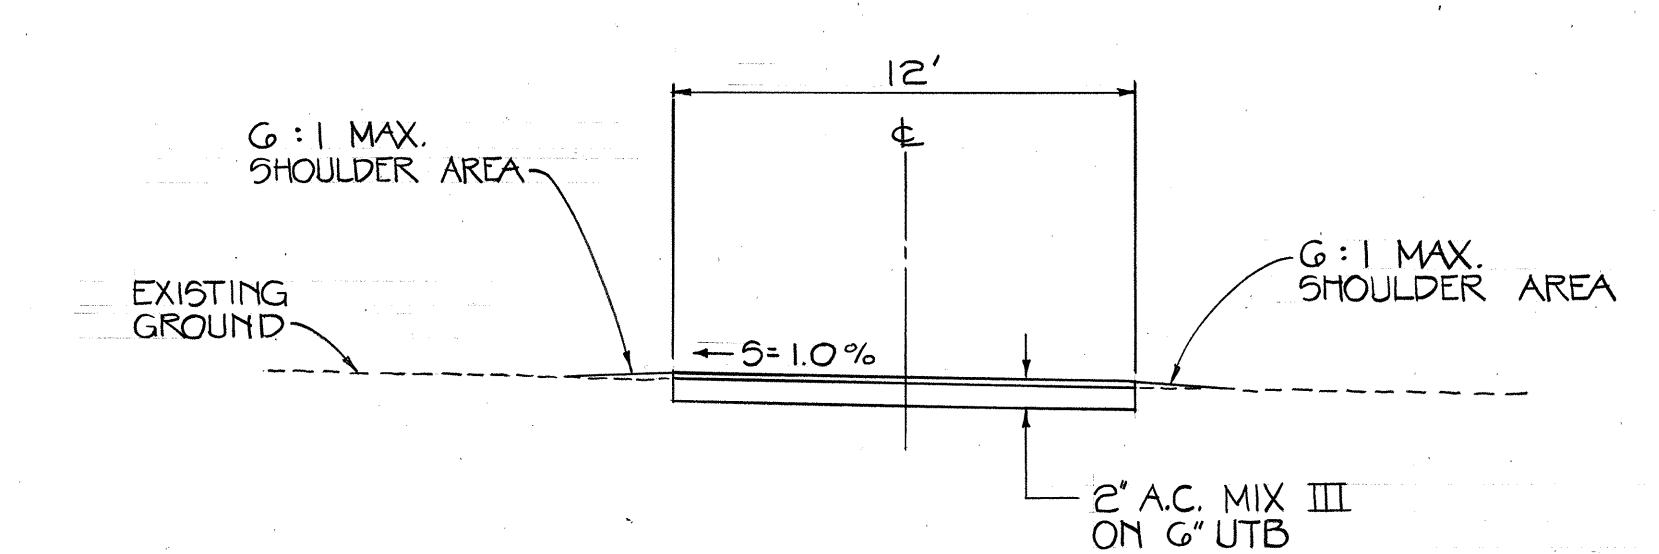

SECTION 'B-B' - TYPICAL  
FAA MARKER SITE ACCESS ROAD  
NOT TO SCALE

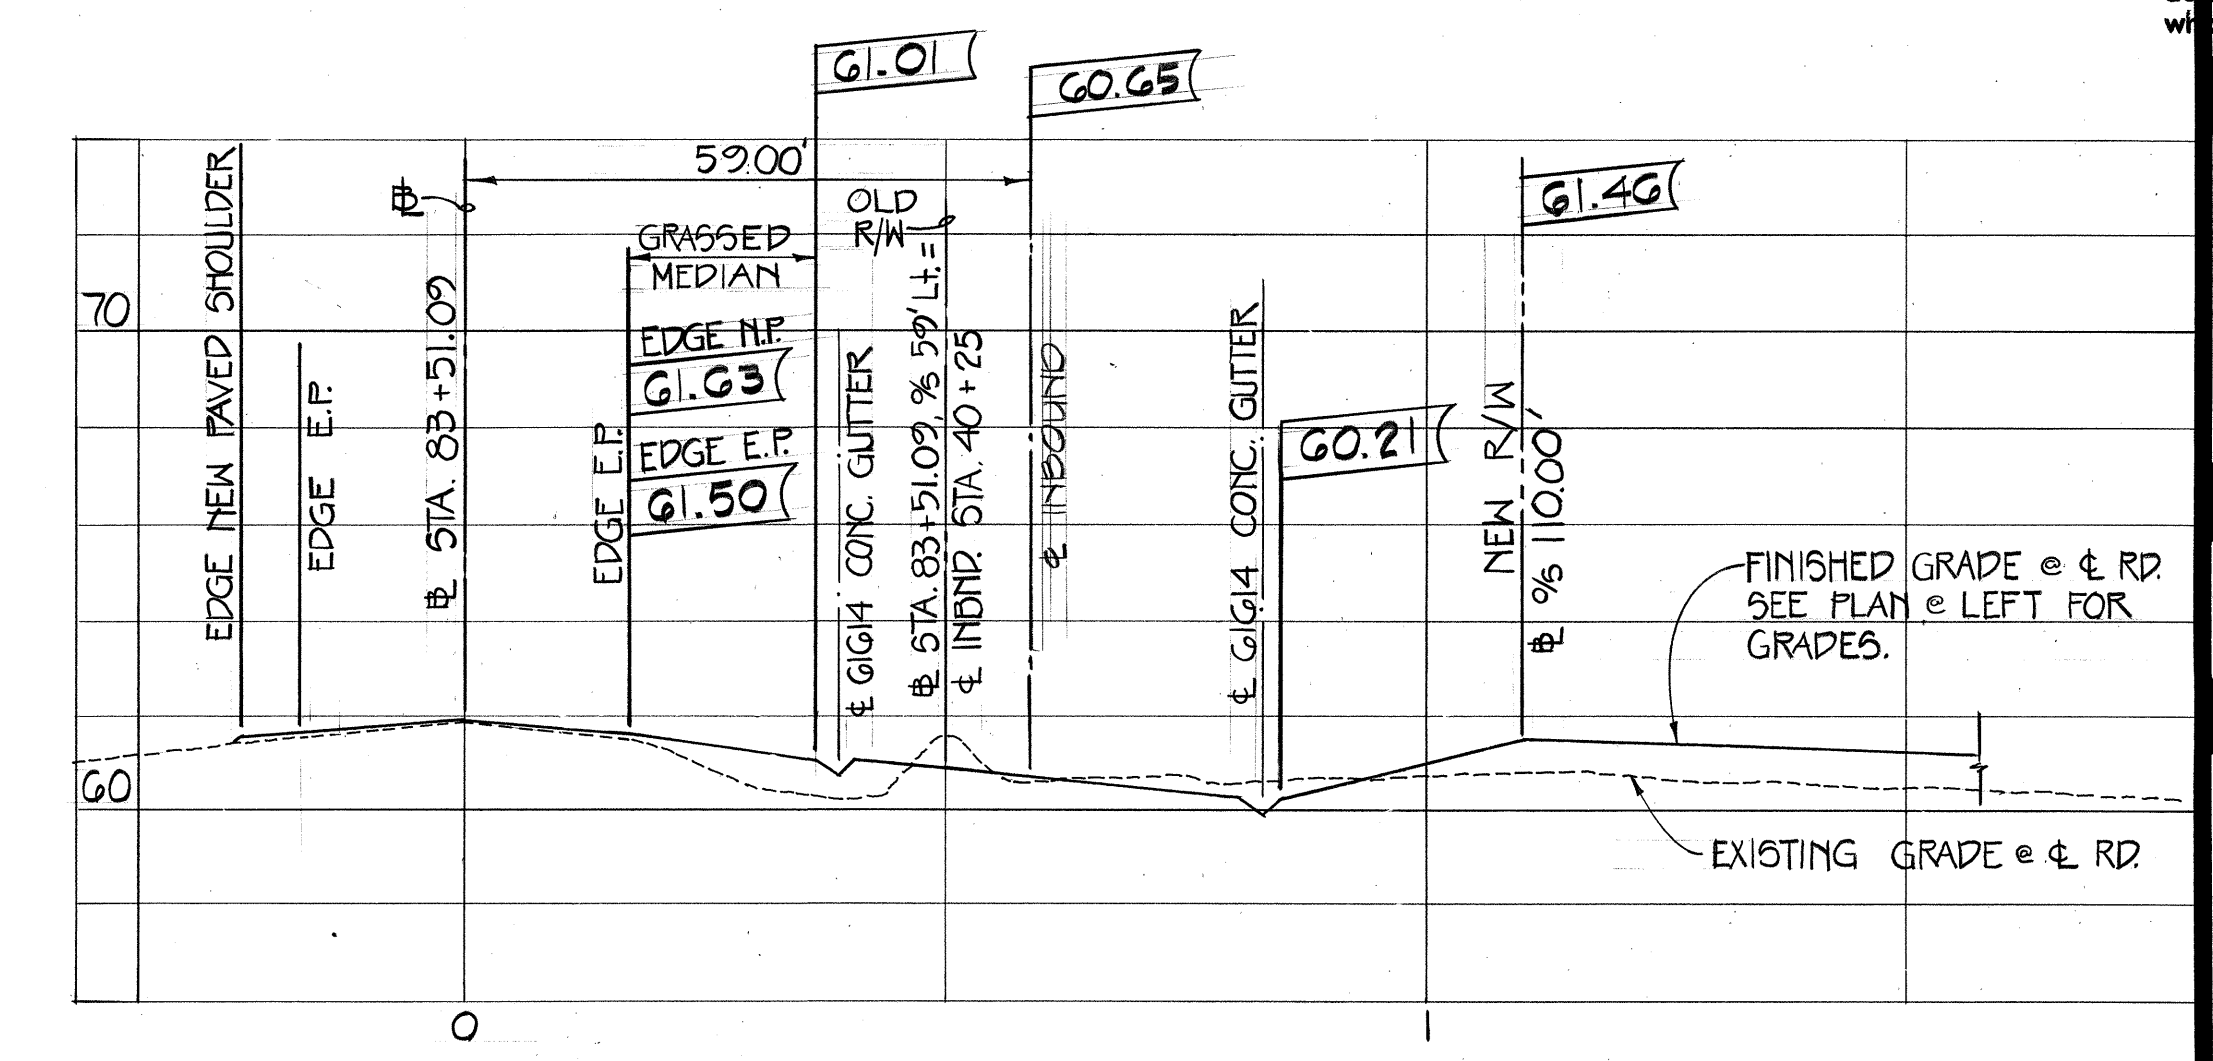


PROFILE - MIDDLE MARKER ROAD CONNECTION

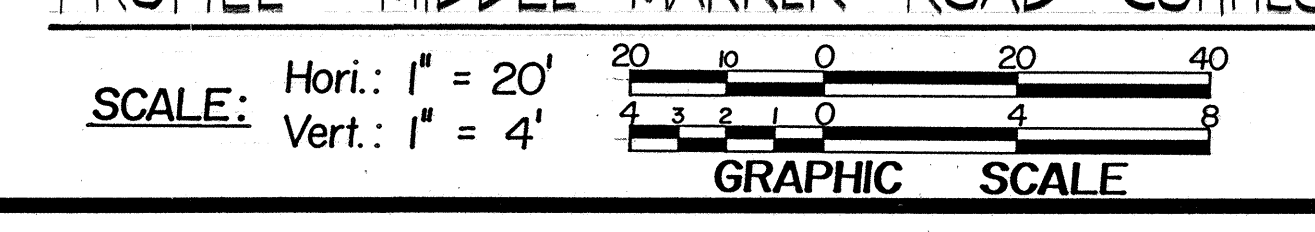

Airports Division  
DEPARTMENT OF TRANSPORTATION  
STATE OF HAWAII

THIS WORK WAS PREPARED BY ME OR UNDER MY SUPERVISION.

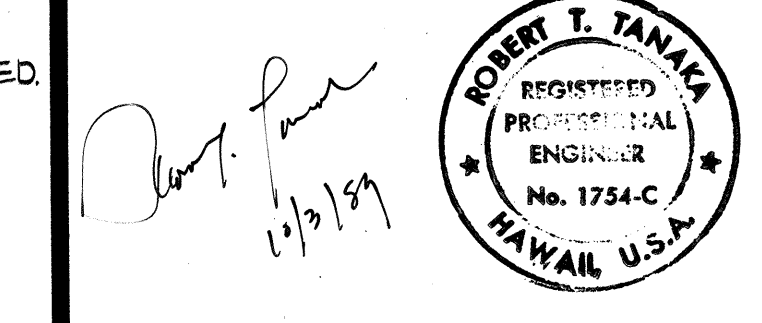

R. T. TANAKA ENGINEERS, INC.  
871 KOLU STREET, SUITE 201  
WAILUKU, MAUI, HAWAII 96793

| DSGN. | DRWN. | CHKD.  | APPD. |
|-------|-------|--------|-------|
| R.H.  | C.N.  | R.T.T. |       |

KEY PLAN / NOTES :

NO. DATE REVISIONS

**AS-BUILT** (Record Drawing)

DATE 7/12/91

The Drawing has been prepared, in part, based upon information furnished by others. While this information is believed to be reliable, the Design Professional cannot assume its accuracy of this As-Built drawing or for any errors or omissions which may have been incorporated into it as a result.

PROJECT TITLE :

HANA HIGHWAY IMPROVEMENTS

PROJECT NO. :

STATE NO. AM-1061-12  
AIP NO. 3-15-0006-11

SHEET TITLE :

MIDDLE MARKER SITE PLAN & SECTIONS

DATE : 11-15-89

DWG. NO. :

C-28