




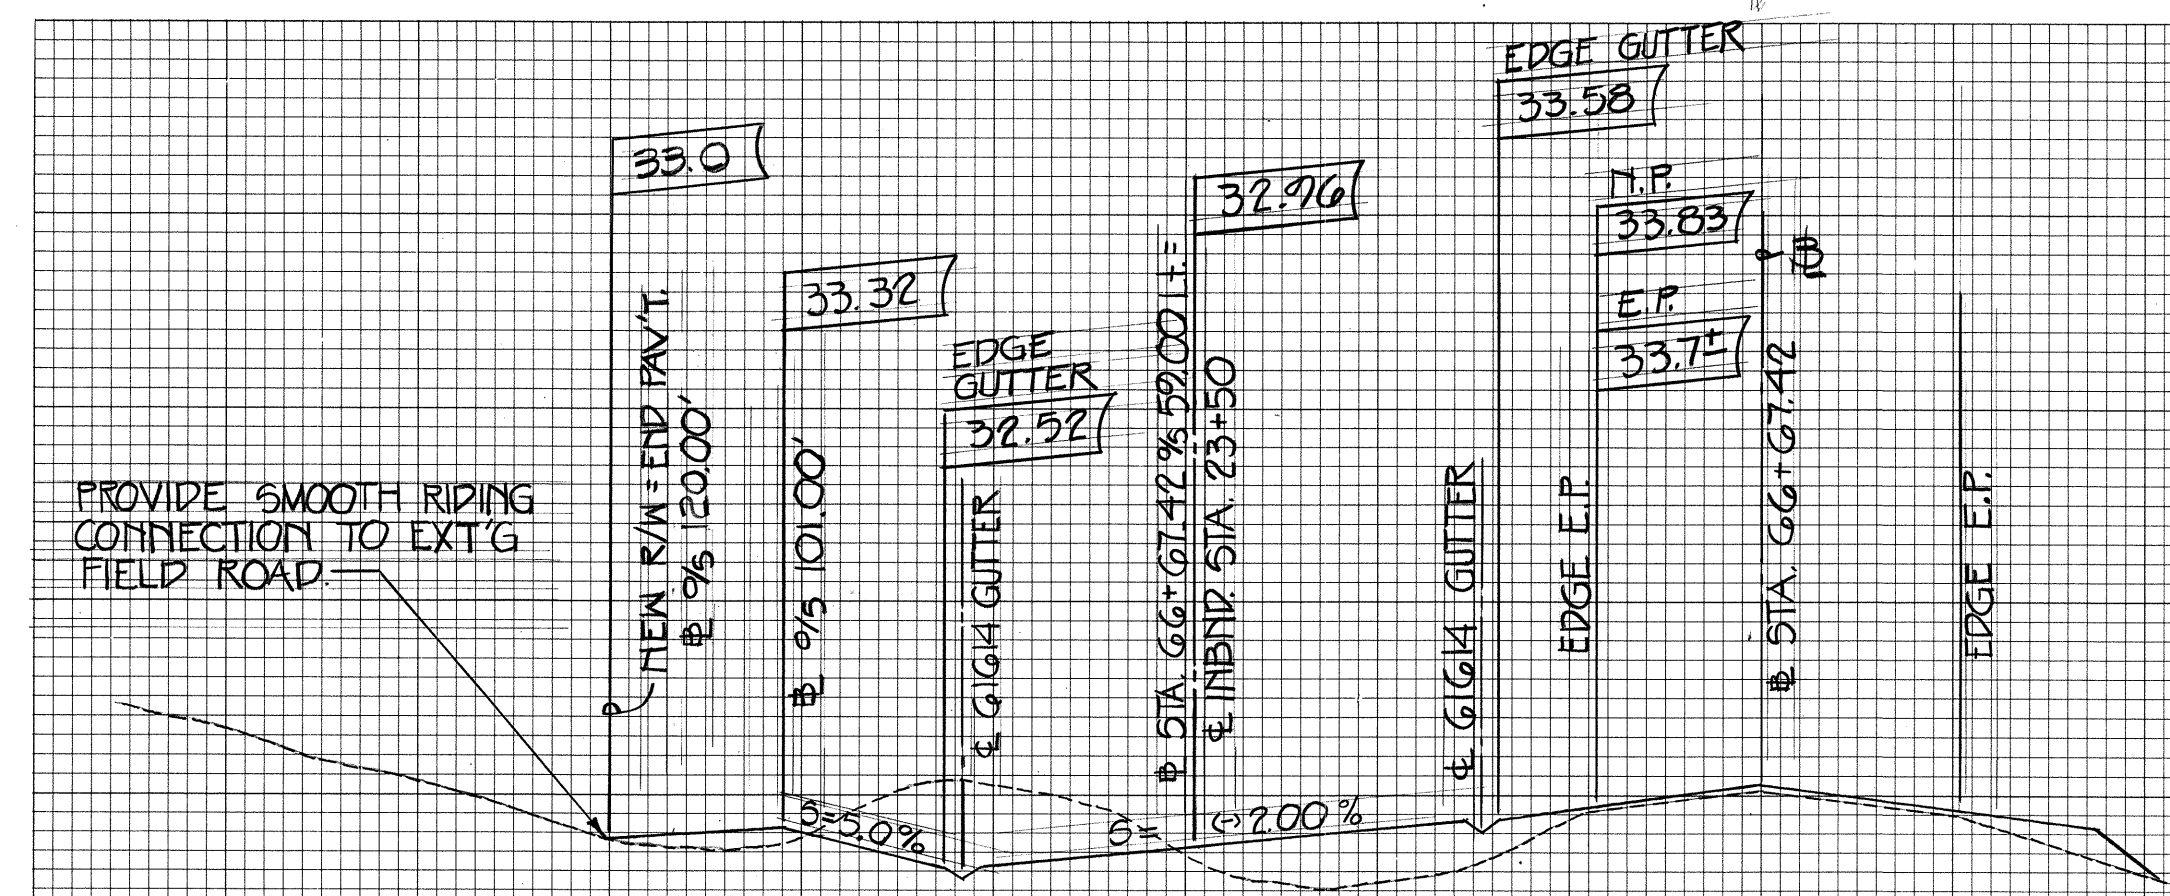


PROFILE - FIELD ROAD CONNECTION
@ STA 66+67.42
SCALE: HORIZ. 1" = 20'
VERT. 1" = 4'

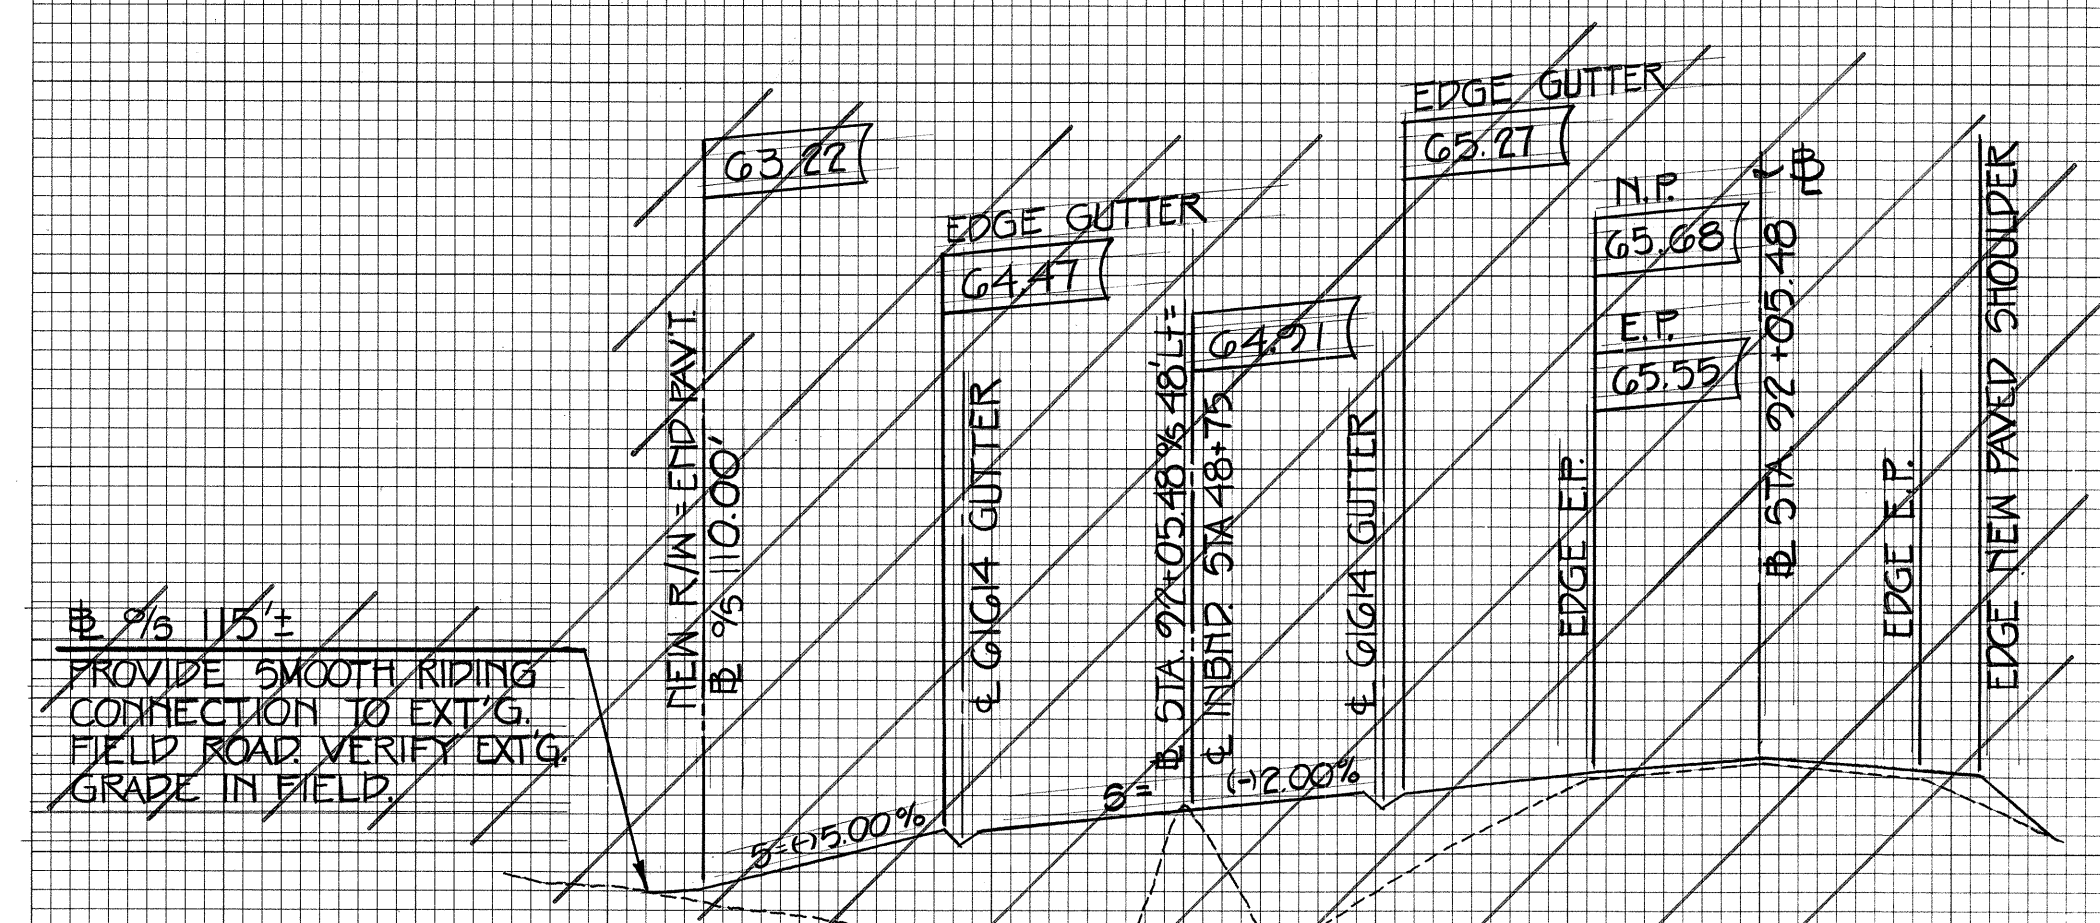


PROFILE - FIELD ROAD CONNECTION
@ STA 72+05.48
SCALE: HORIZ. 1" = 20'
VERT. 1" = 4'

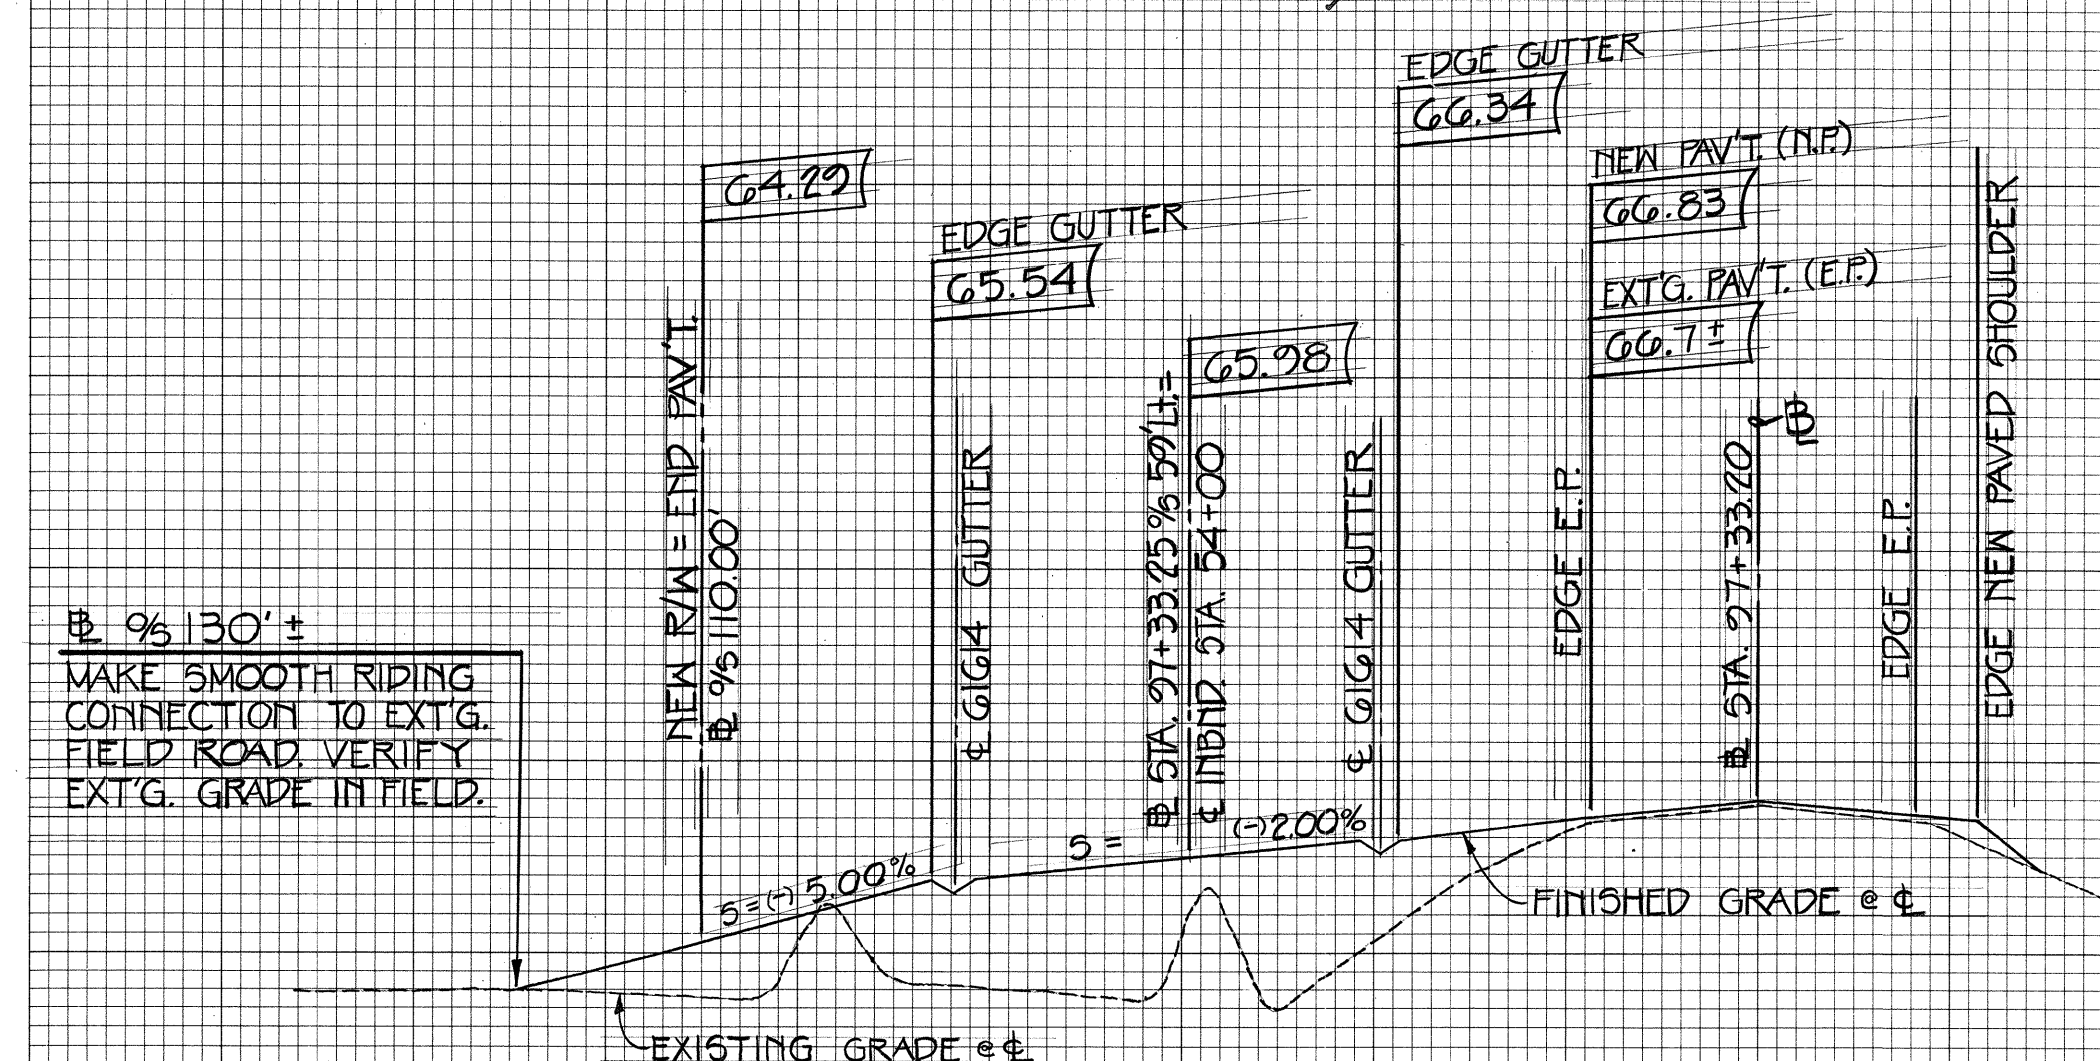


PROFILE - FIELD ROAD CONNECTION
@ STA 97+33.20
SCALE: HORIZ. 1" = 20'
VERT. 1" = 4'

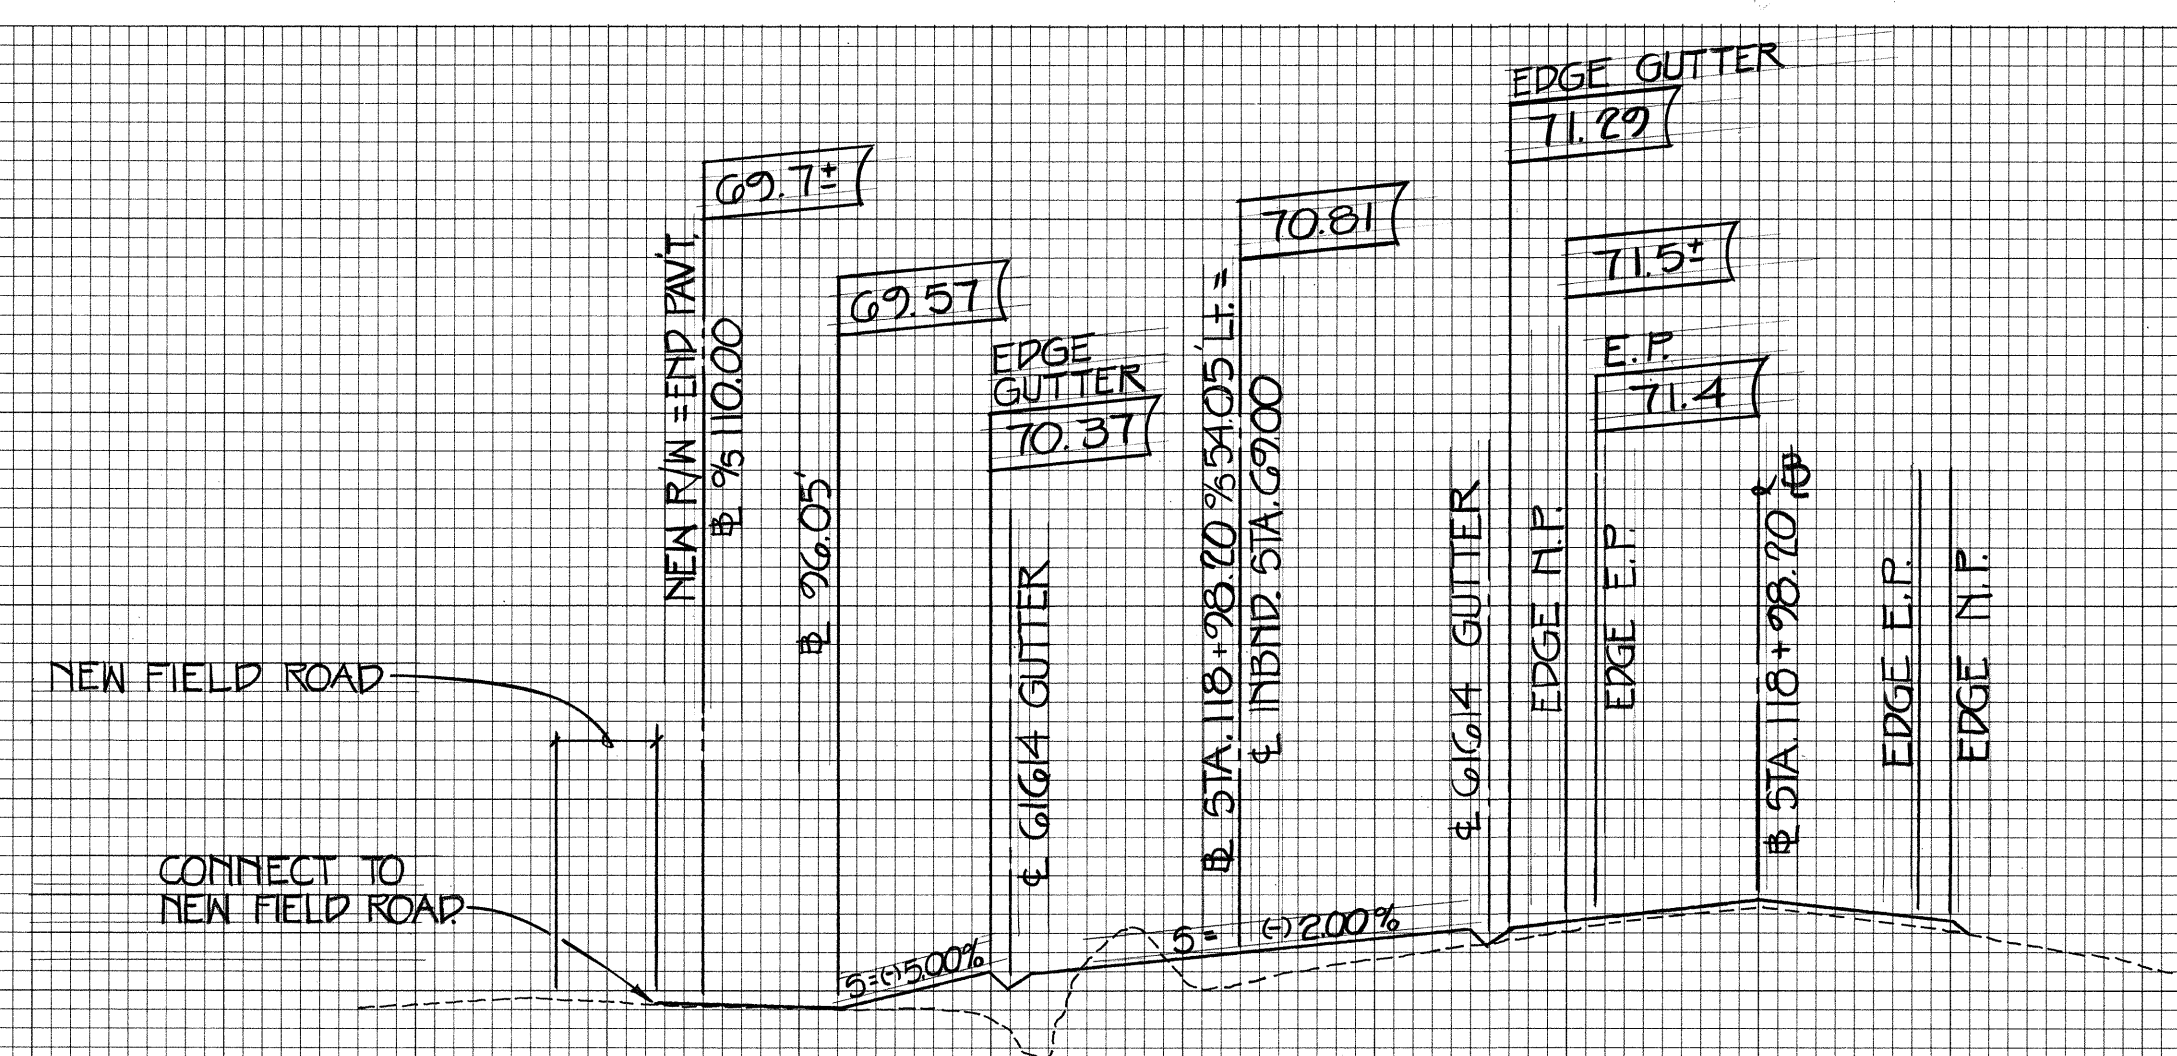



PROFILE - FIELD ROAD CONNECTION
@ STA 118+28.20
SCALE: HORIZ. 1" = 20'
VERT. 1" = 4'

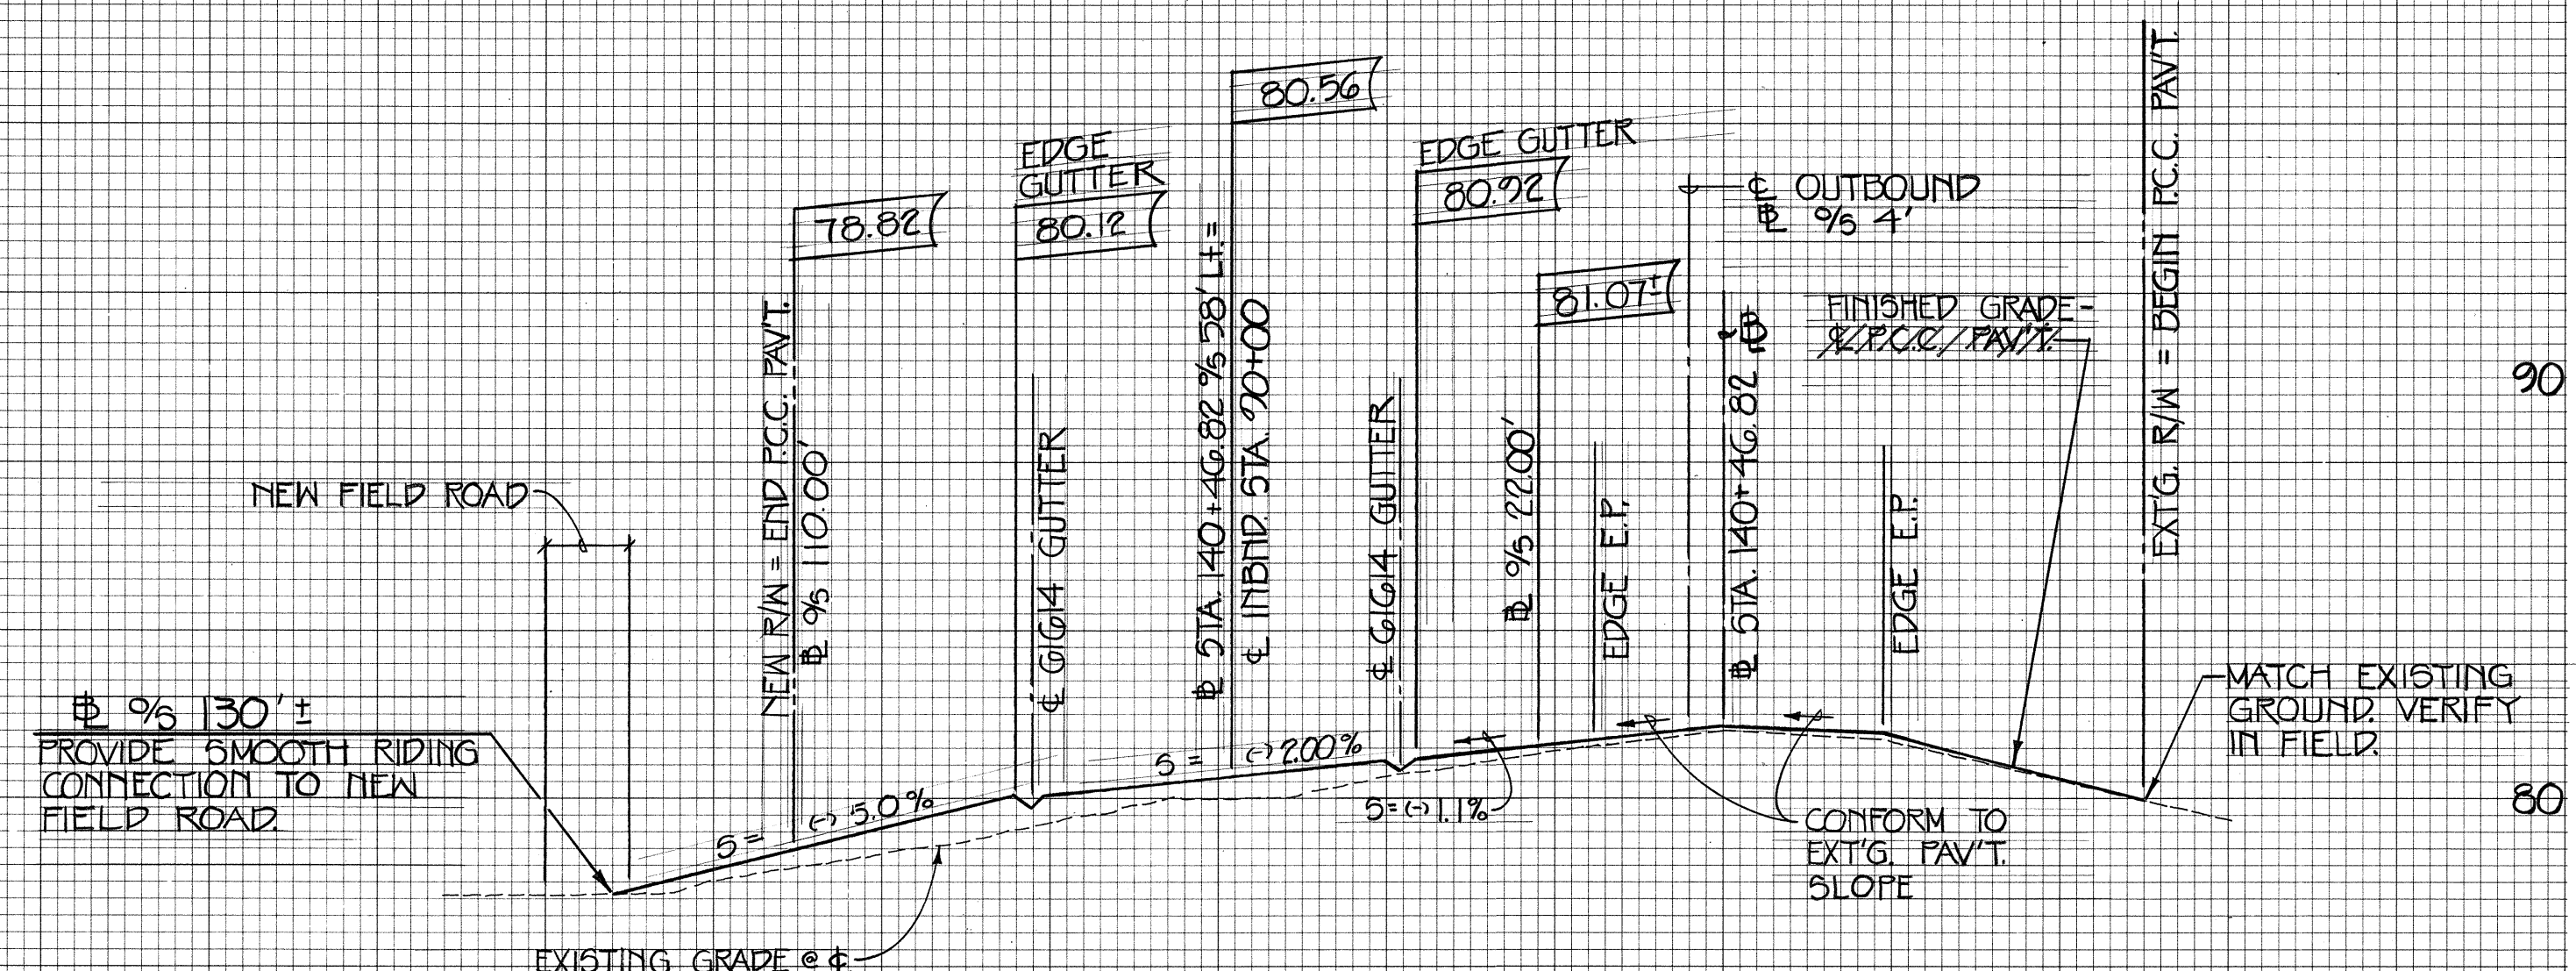

PROFILE - FIELD ROAD CONNECTION
@ STA 140+46.82
SCALE: HORIZ. 1" = 20'
VERT. 1" = 4'

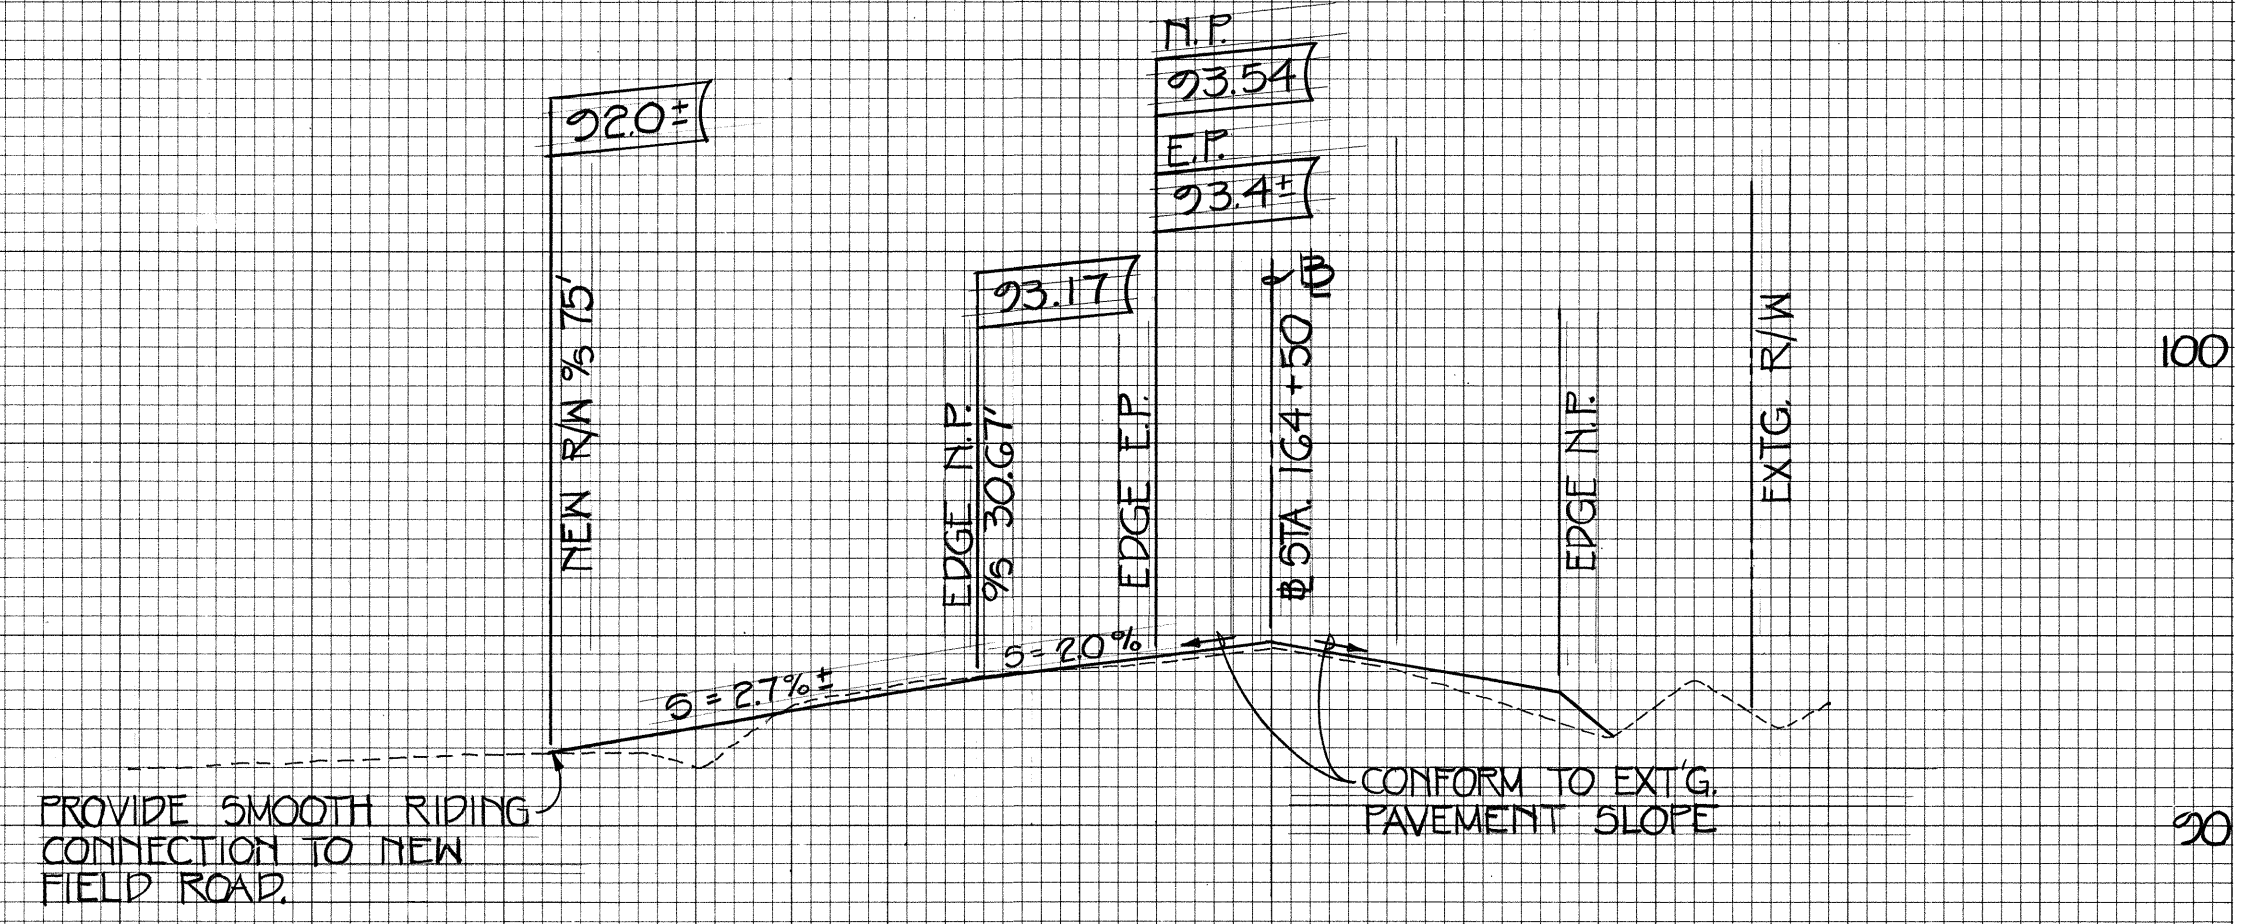

PROFILE - FIELD ROAD CONNECTION
@ STA 164+50
SCALE: HORIZ. 1" = 20'
VERT. 1" = 4'

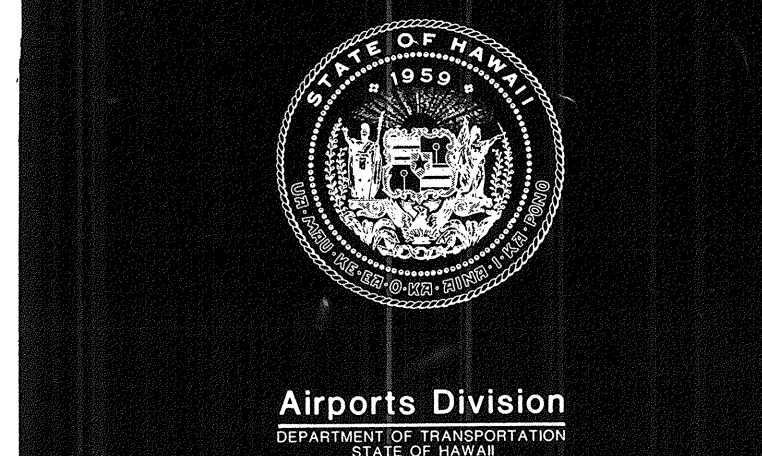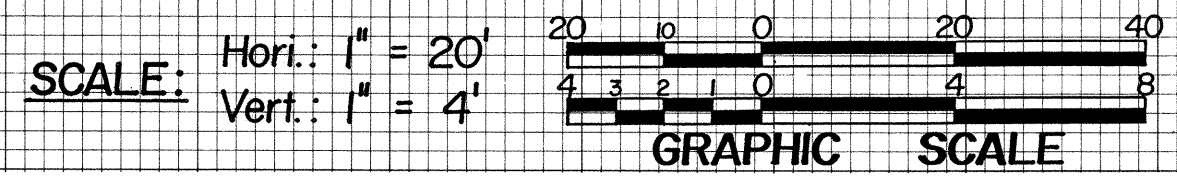

THIS WORK WAS PREPARED BY
ME OR UNDER MY SUPERVISION.

Robert T. Tanaka
10/3/99
REGISTERED PROFESSIONAL ENGINEER
No. 1754-C
HAWAII, U.S.A.

R. T. TANAKA ENGINEERS, INC.
871 KOLU STREET, SUITE 201
WAILUKU, MAUI, HAWAII 96793

DSGN.	DRWN.	CHKD.	APPD.
R.H.	C.N.	R.I.T.	

KEY PLAN / NOTES :

NO. DATE REVISIONS
AS-BUILT (Record Drawing)
DATE 7/12/91
This Drawing has been prepared, in part, based upon information furnished by others. While this information is believed to be reliable, the Design Professional cannot assure its accuracy of this As-Built drawing or for any errors or omissions which may have been incorporated into it as a result.

PROJECT TITLE :
HANA HIGHWAY IMPROVEMENTS


PROJECT NO. :
STATE NO. AM-1061-12
AIP NO. 3-15-0006-11

SHEET TITLE :

MISCELLANEOUS ACCESS
ROAD PROFILES



DATE :
11-15-89
DWG. NO. :

C-30


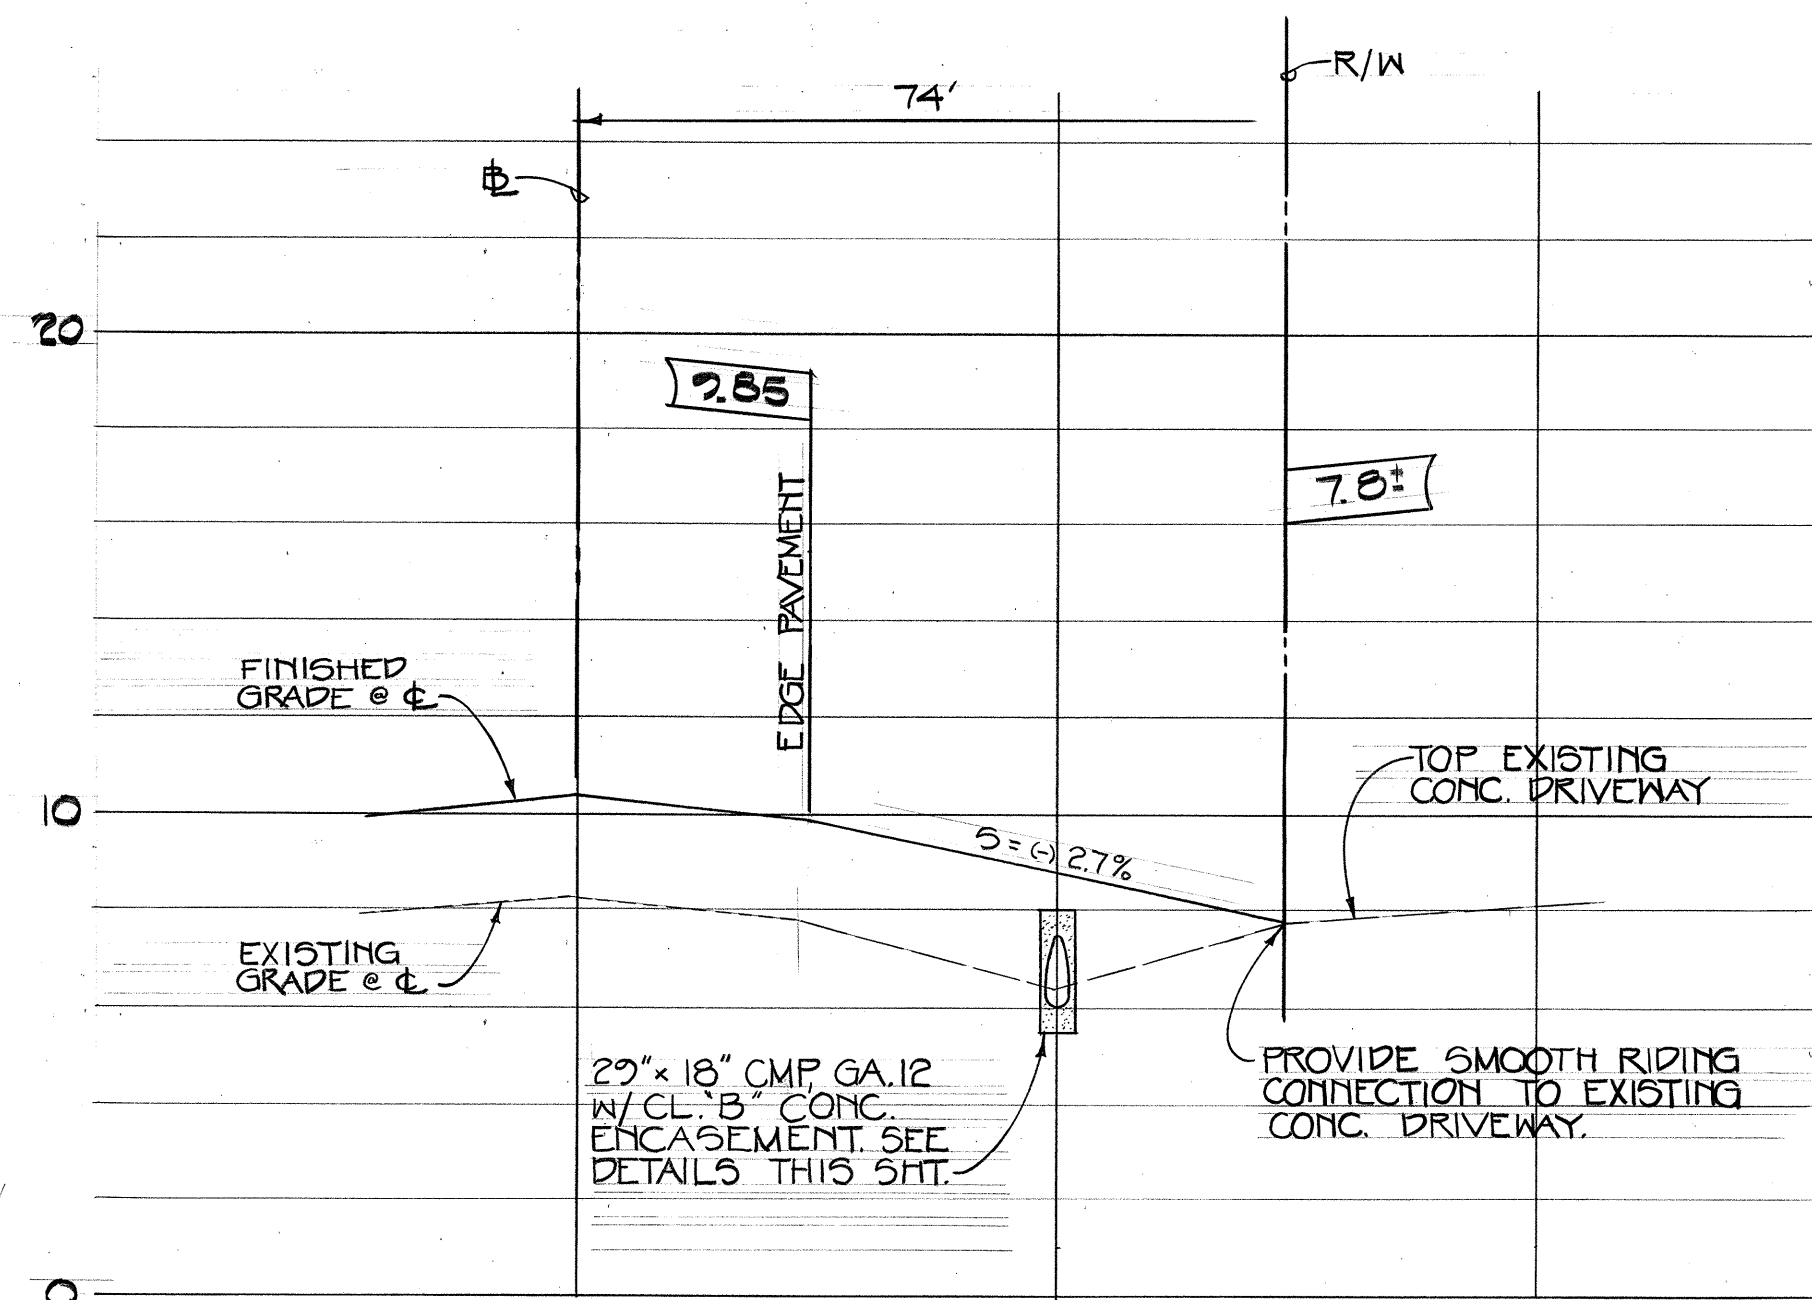


PROFILE CONC. DRIVEWAY


± STA. 48+23±

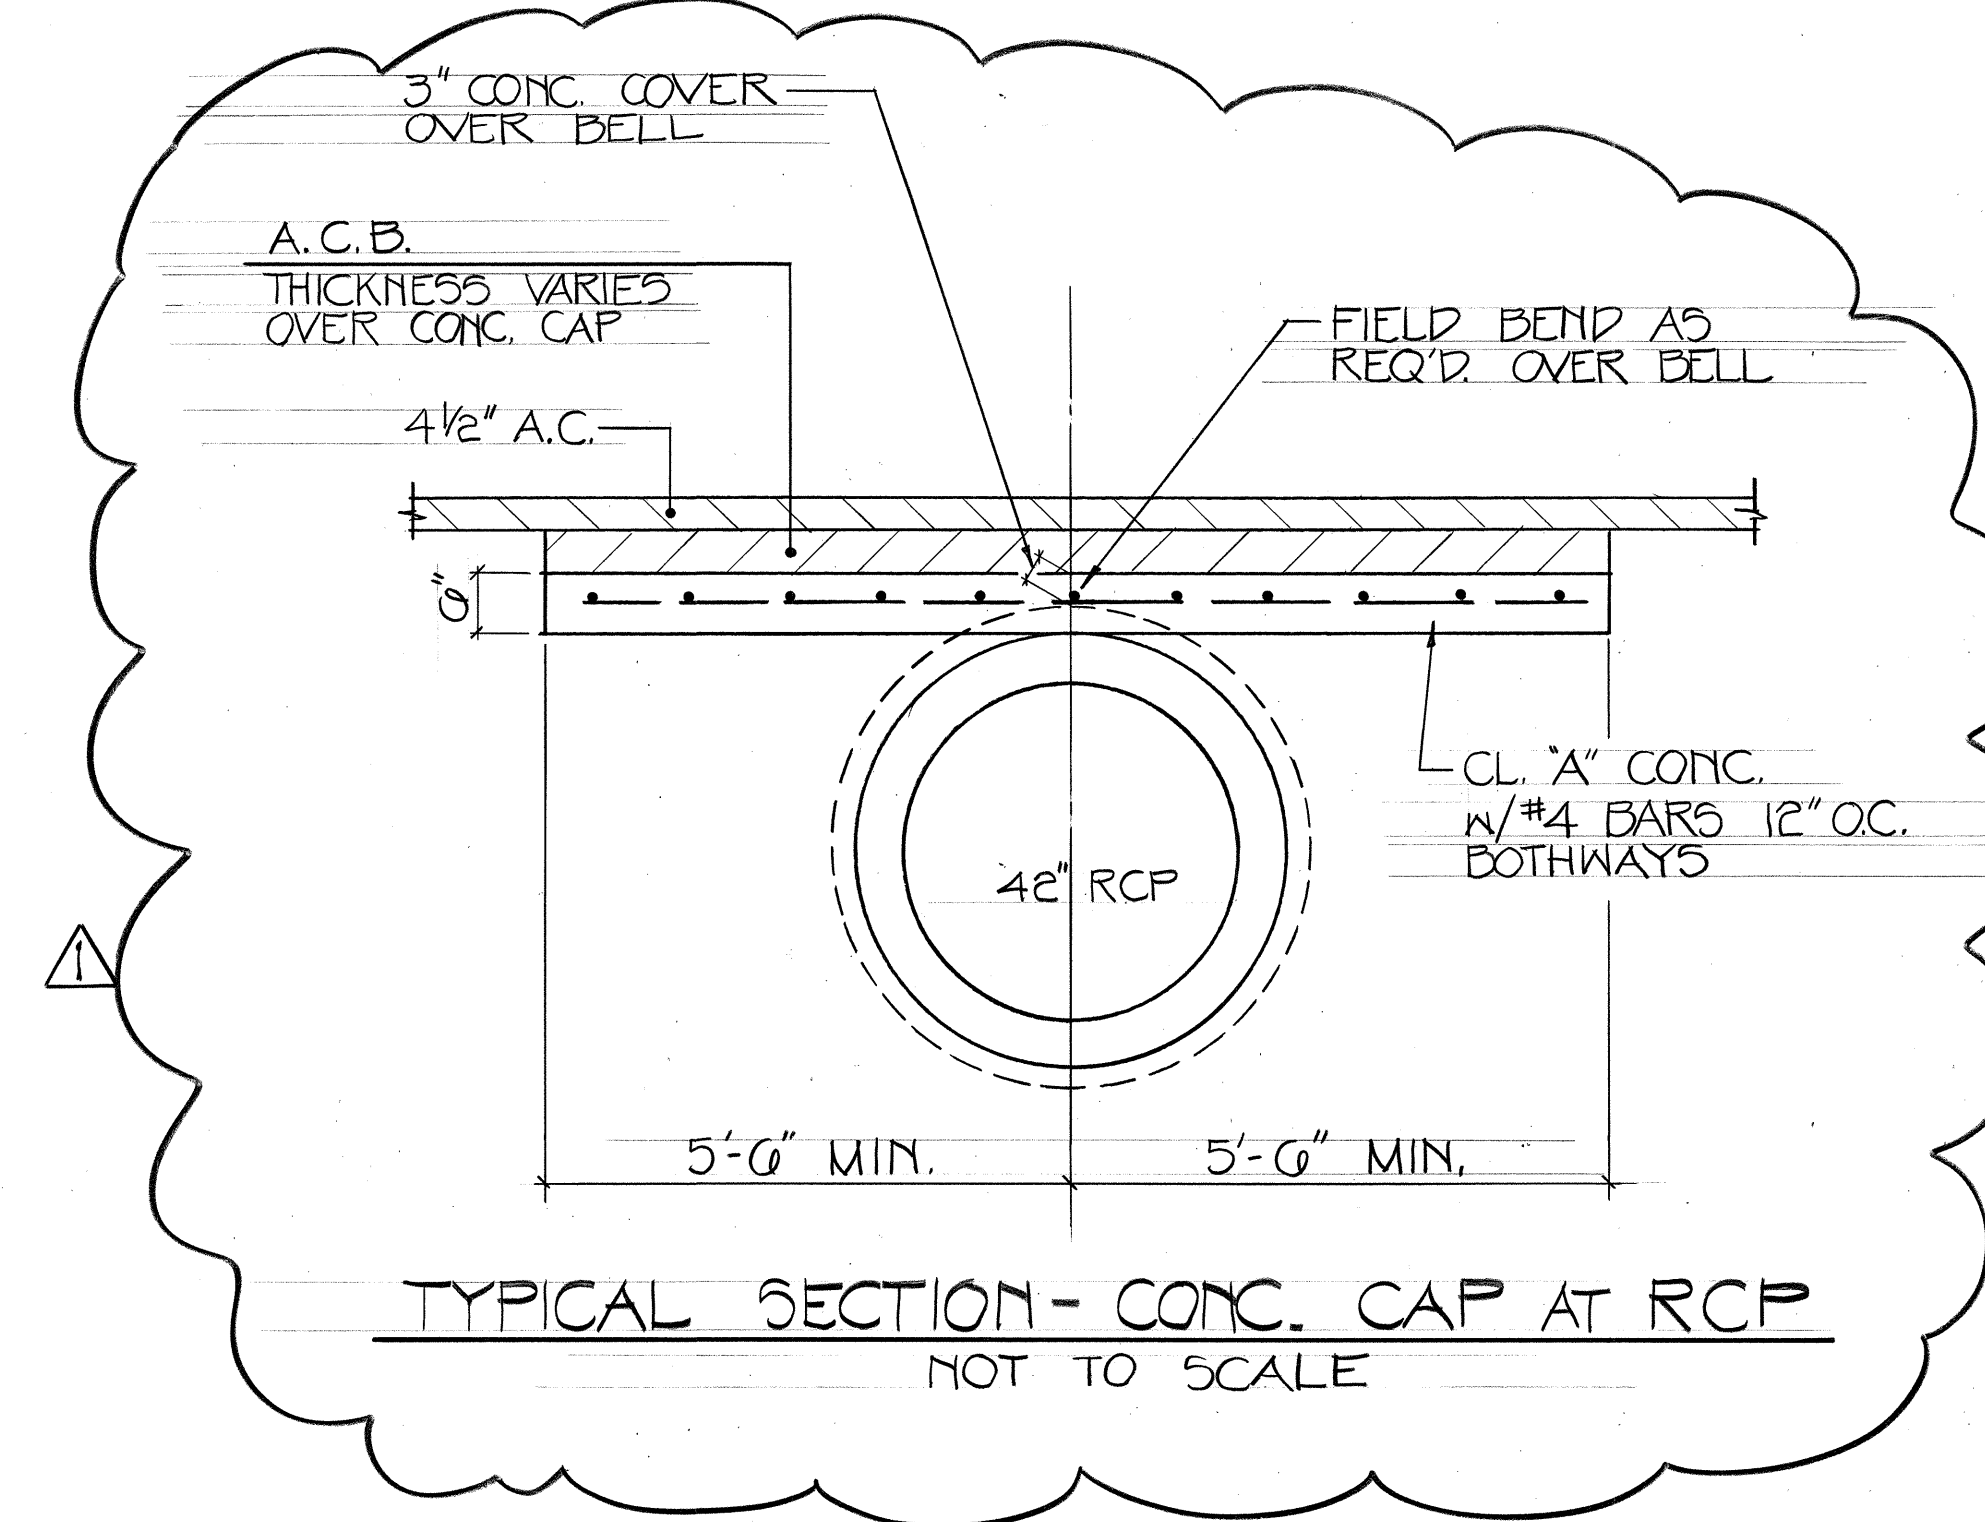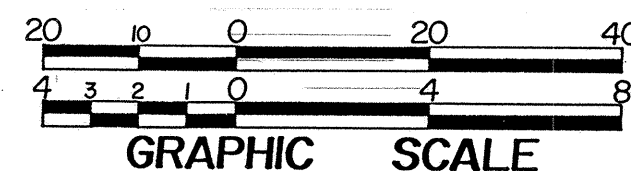SCALE: Hori.: 1" = 20'
Vert.: 1" = 4'

PROFILE - PULEHU ROAD

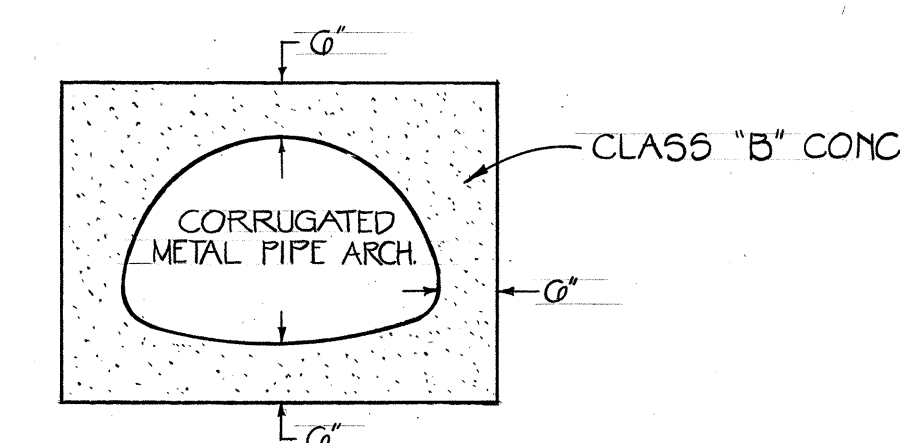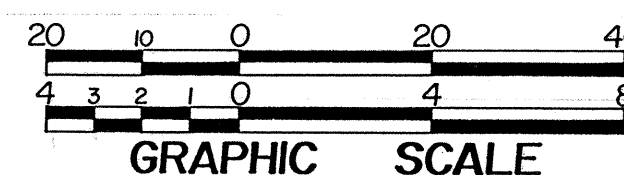SCALE: Hori.: 1" = 20'
Vert.: 1" = 4'Airports Division
DEPARTMENT OF TRANSPORTATION
STATE OF HAWAIITHIS WORK WAS PREPARED BY
ME OR UNDER MY SUPERVISION.

10/2/99

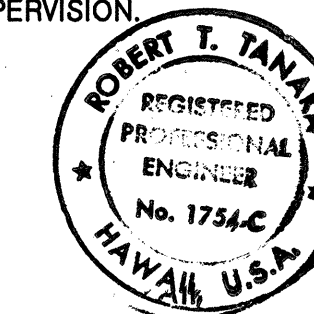R. T. TANAKA ENGINEERS, INC.
871 KOLU STREET, SUITE 201
WAILUKU, MAUI, HAWAII 96793

DSGN. DRWN. CHKD. APPD.

R.H. C.N. R.T.

KEY PLAN / NOTES :

NO. DATE REVISIONS
2-10-92 AS-BUILT

AS-BUILT (Record Drawing)

DATE 7/12/91
This Drawing has been prepared, in part, based upon information furnished by others. While this information is believed to be reliable, the Design Professional cannot assume accuracy of this As-Built drawing or for any errors or omission which may have been incorporated into it as a result.

PROJECT TITLE :

HANA HIGHWAY
IMPROVEMENTSPROJECT NO. :
STATE NO. AM-1061-12
AIP NO. 3-15-0006-11

SHEET TITLE :

MISCELLANEOUS
ACCESS ROAD PROFILES

DATE :

11-15-89

DWG. NO. :

C-31