
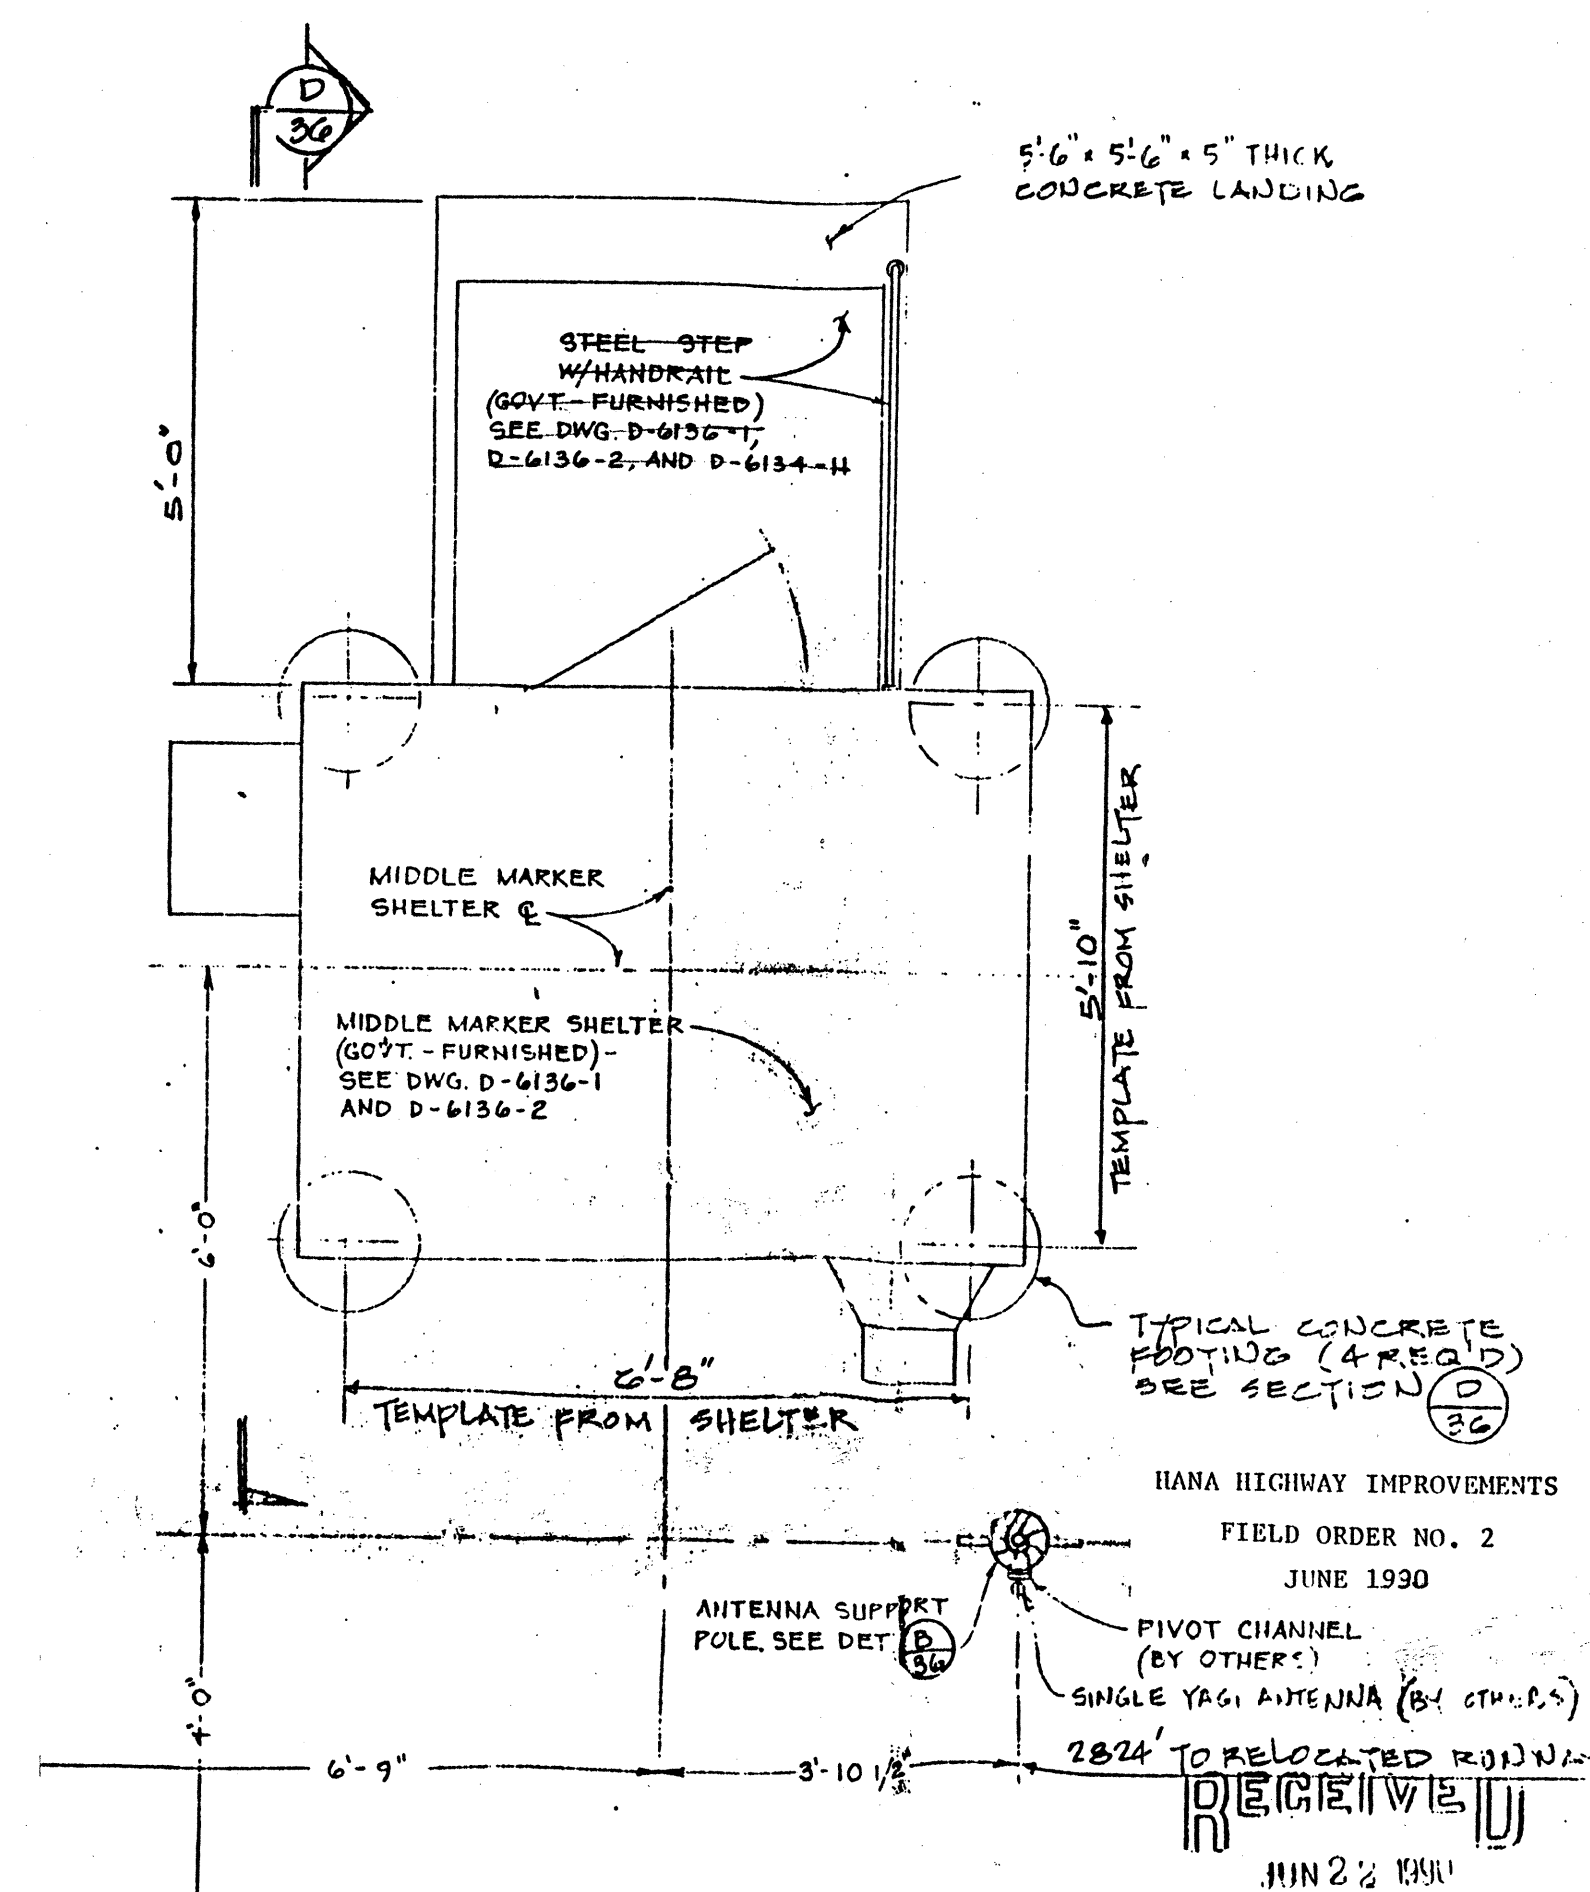
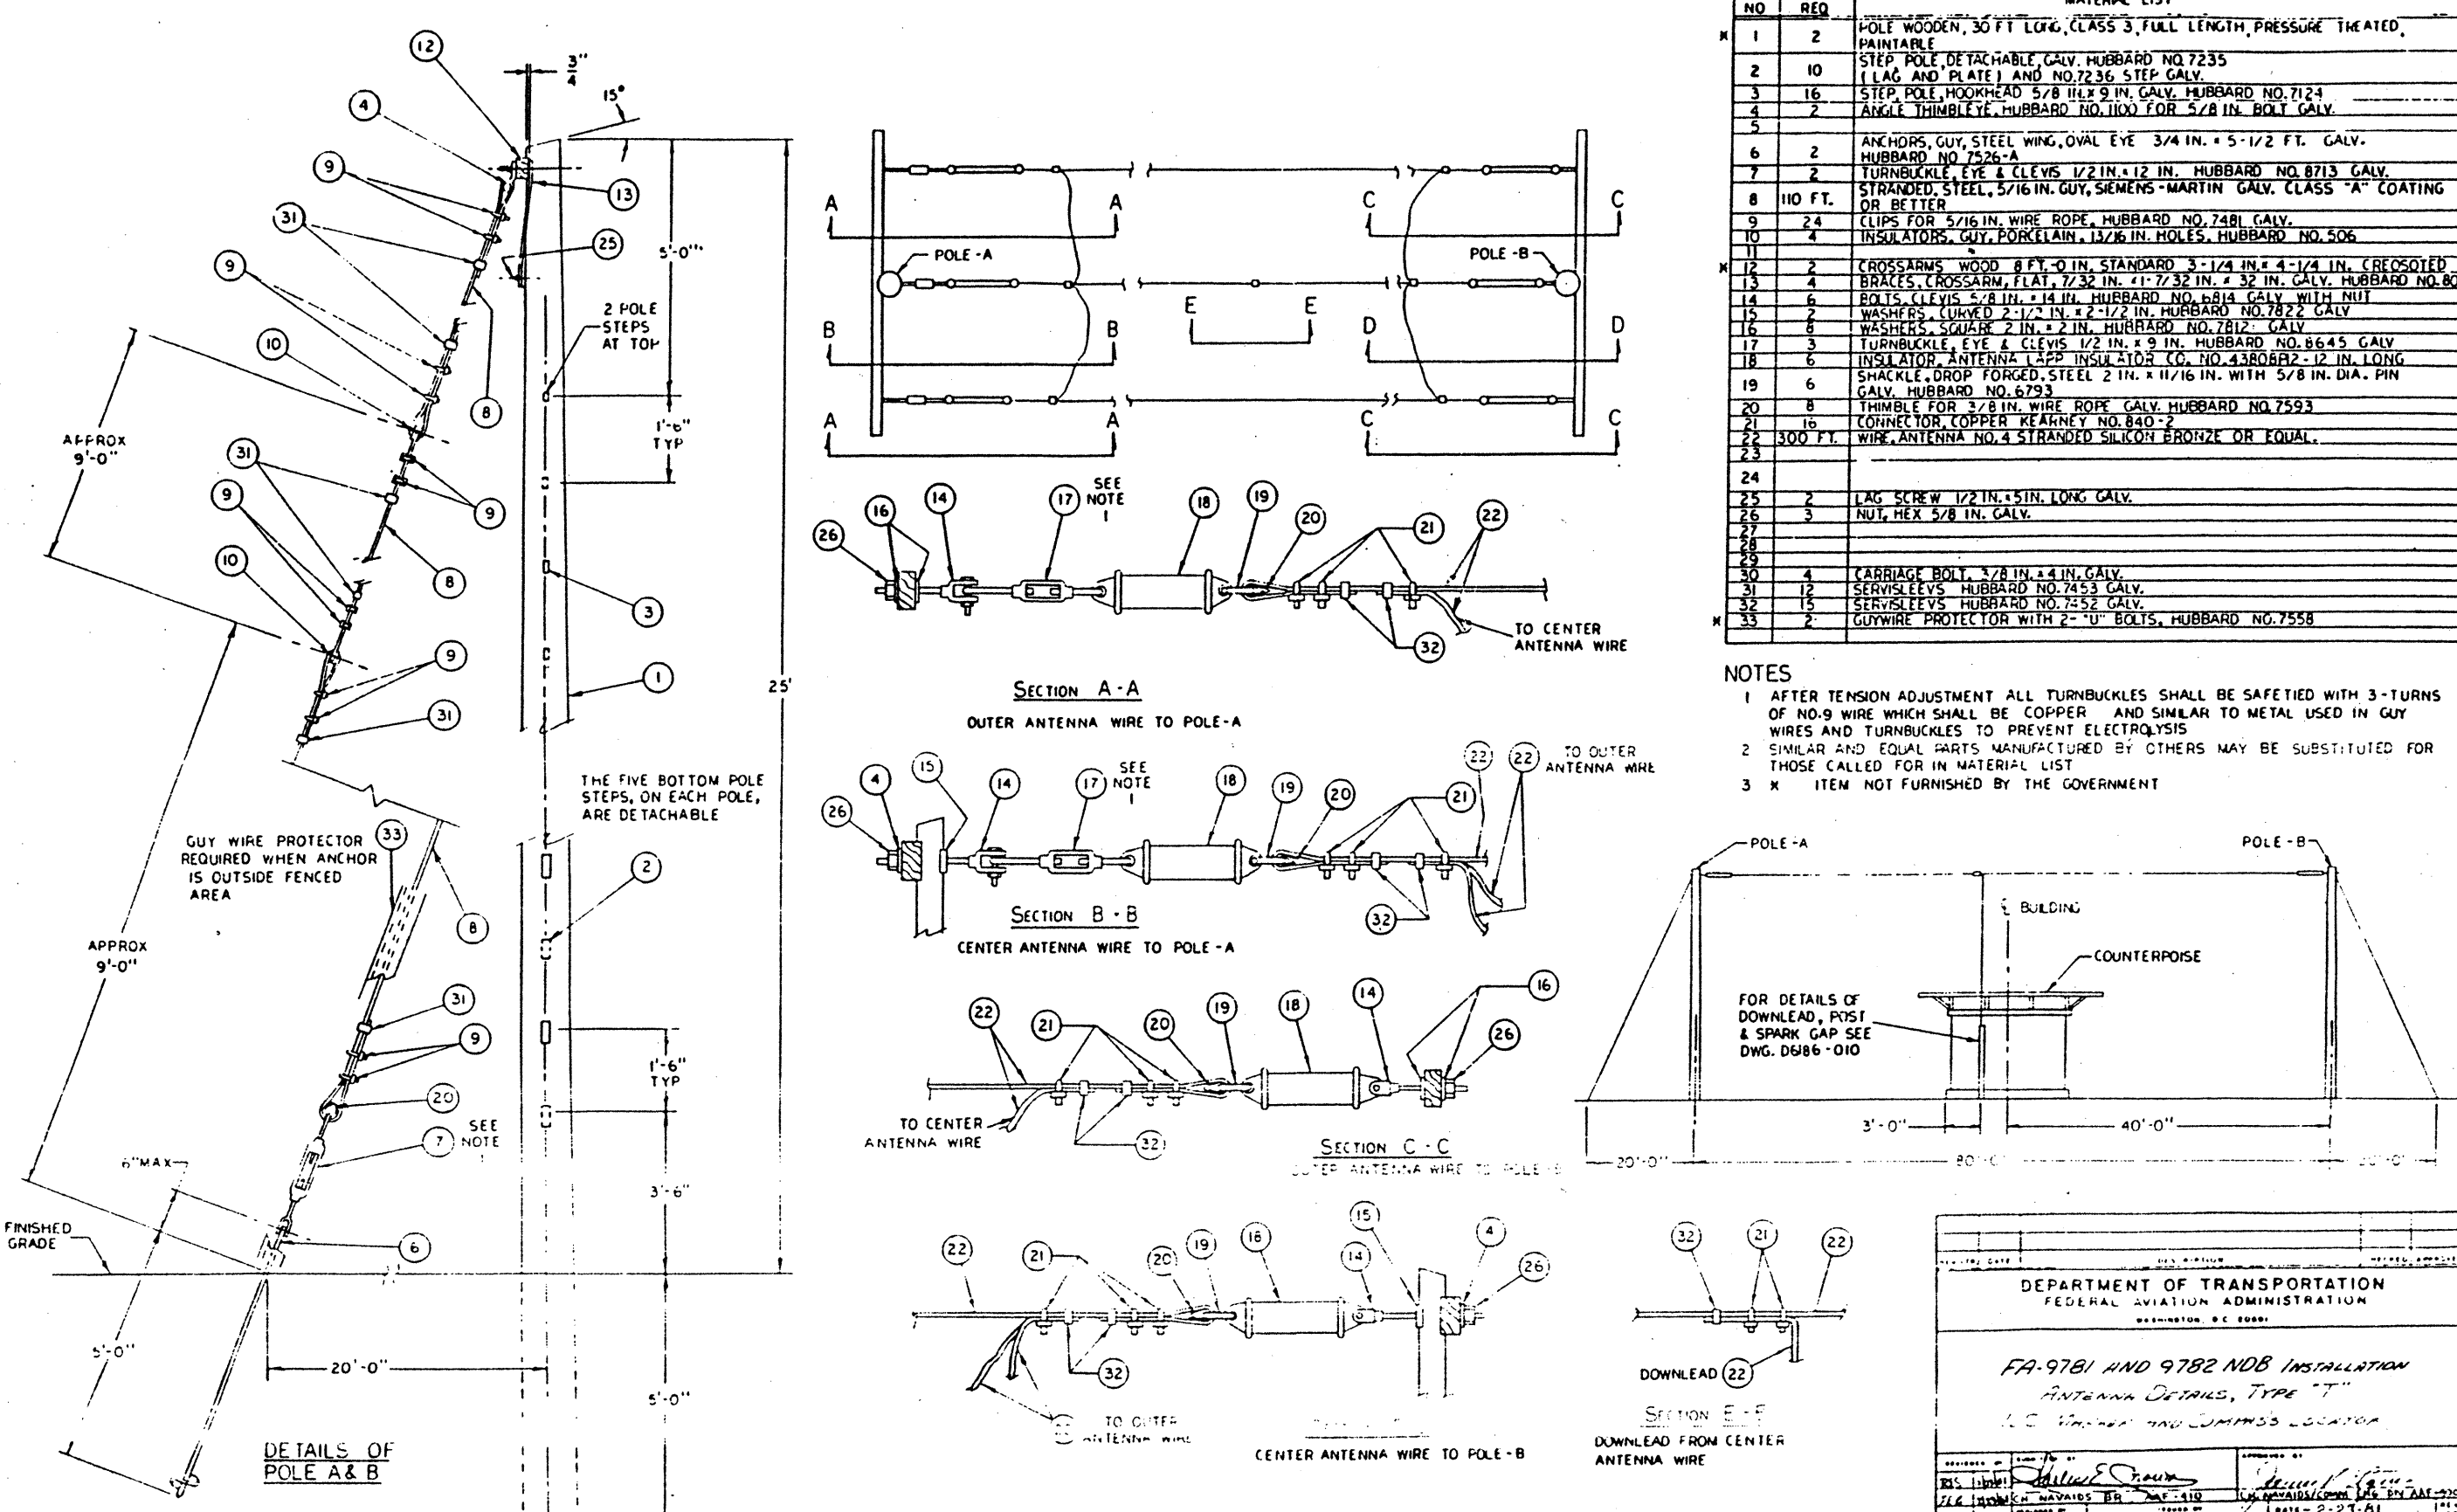



6740.4

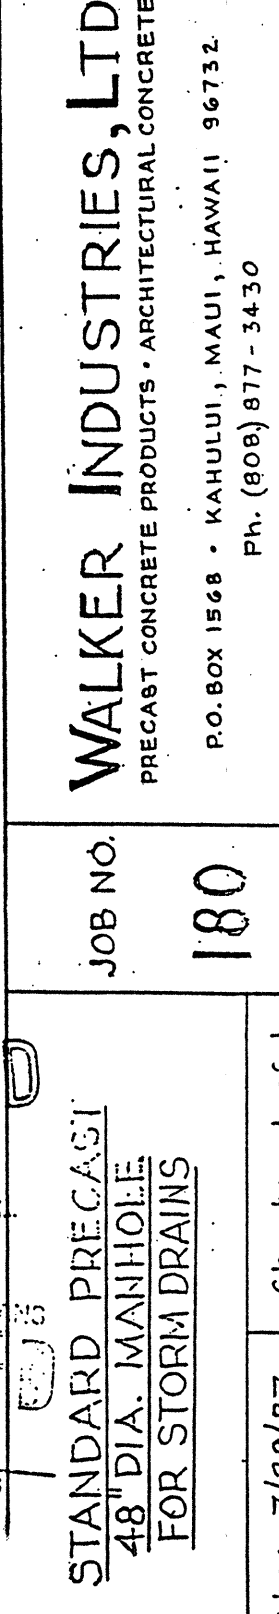

MIDDLE MARKER DETAILS

4 - 10 - 92

C-61

C-61