
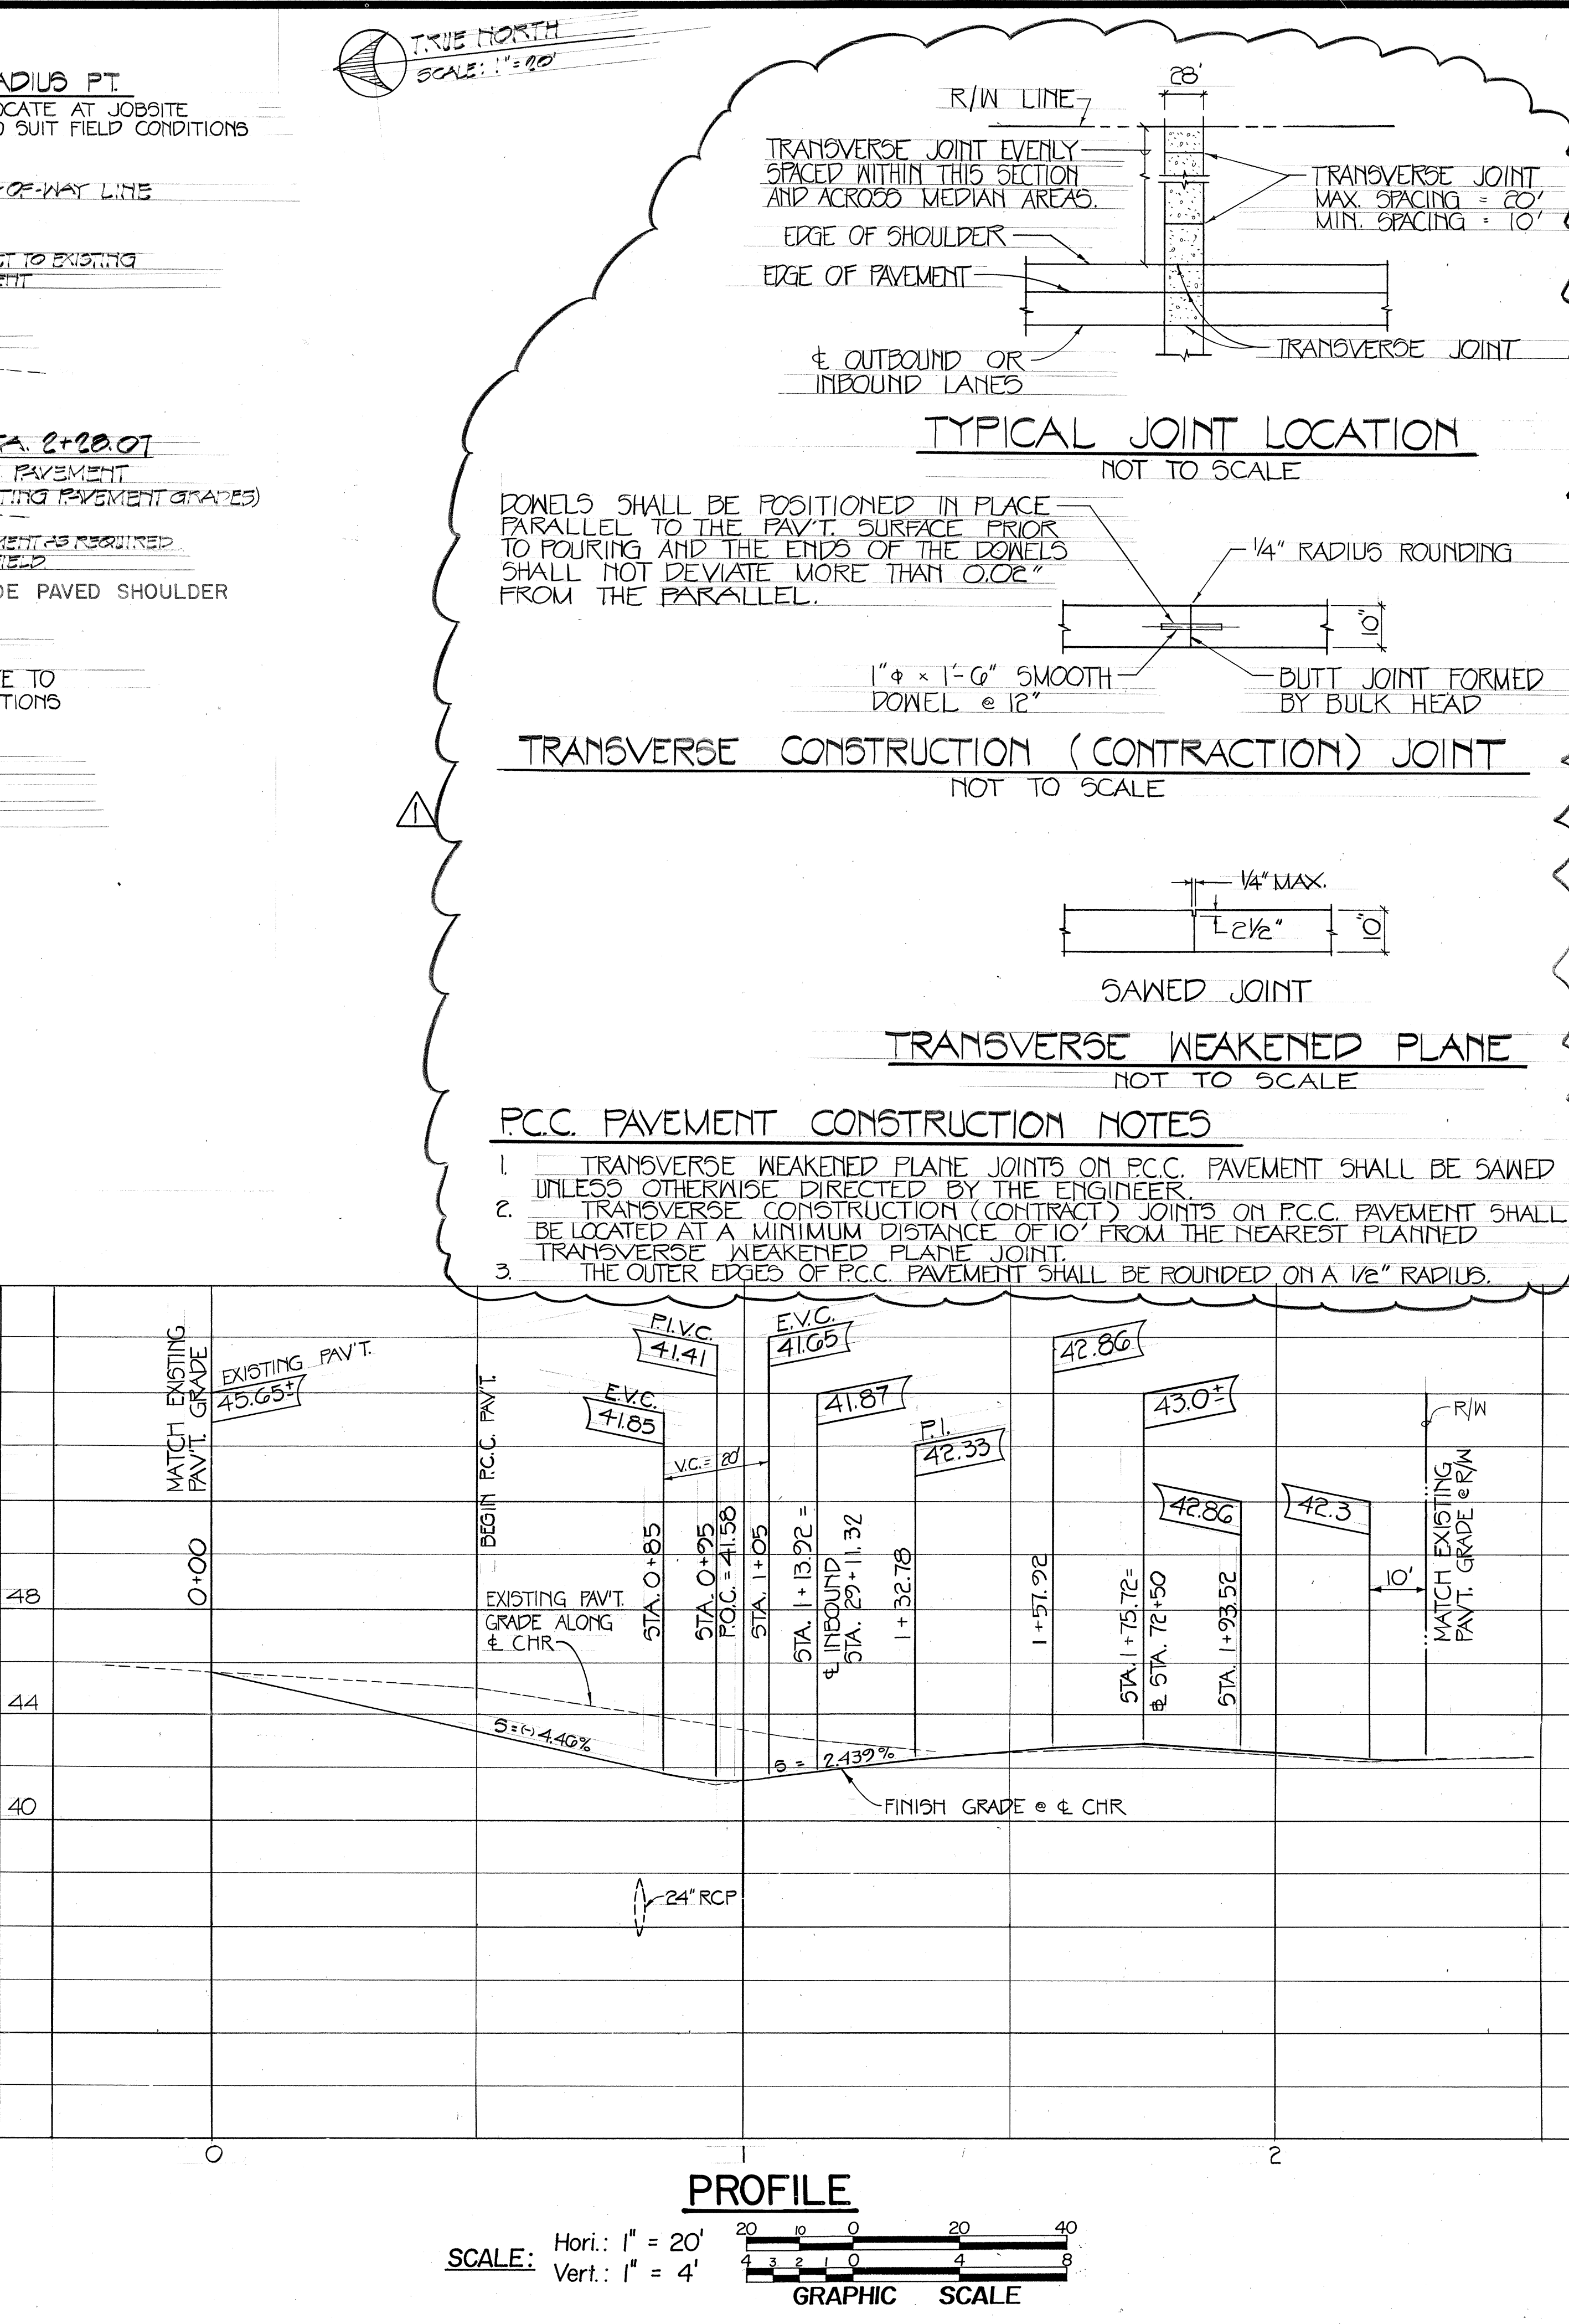
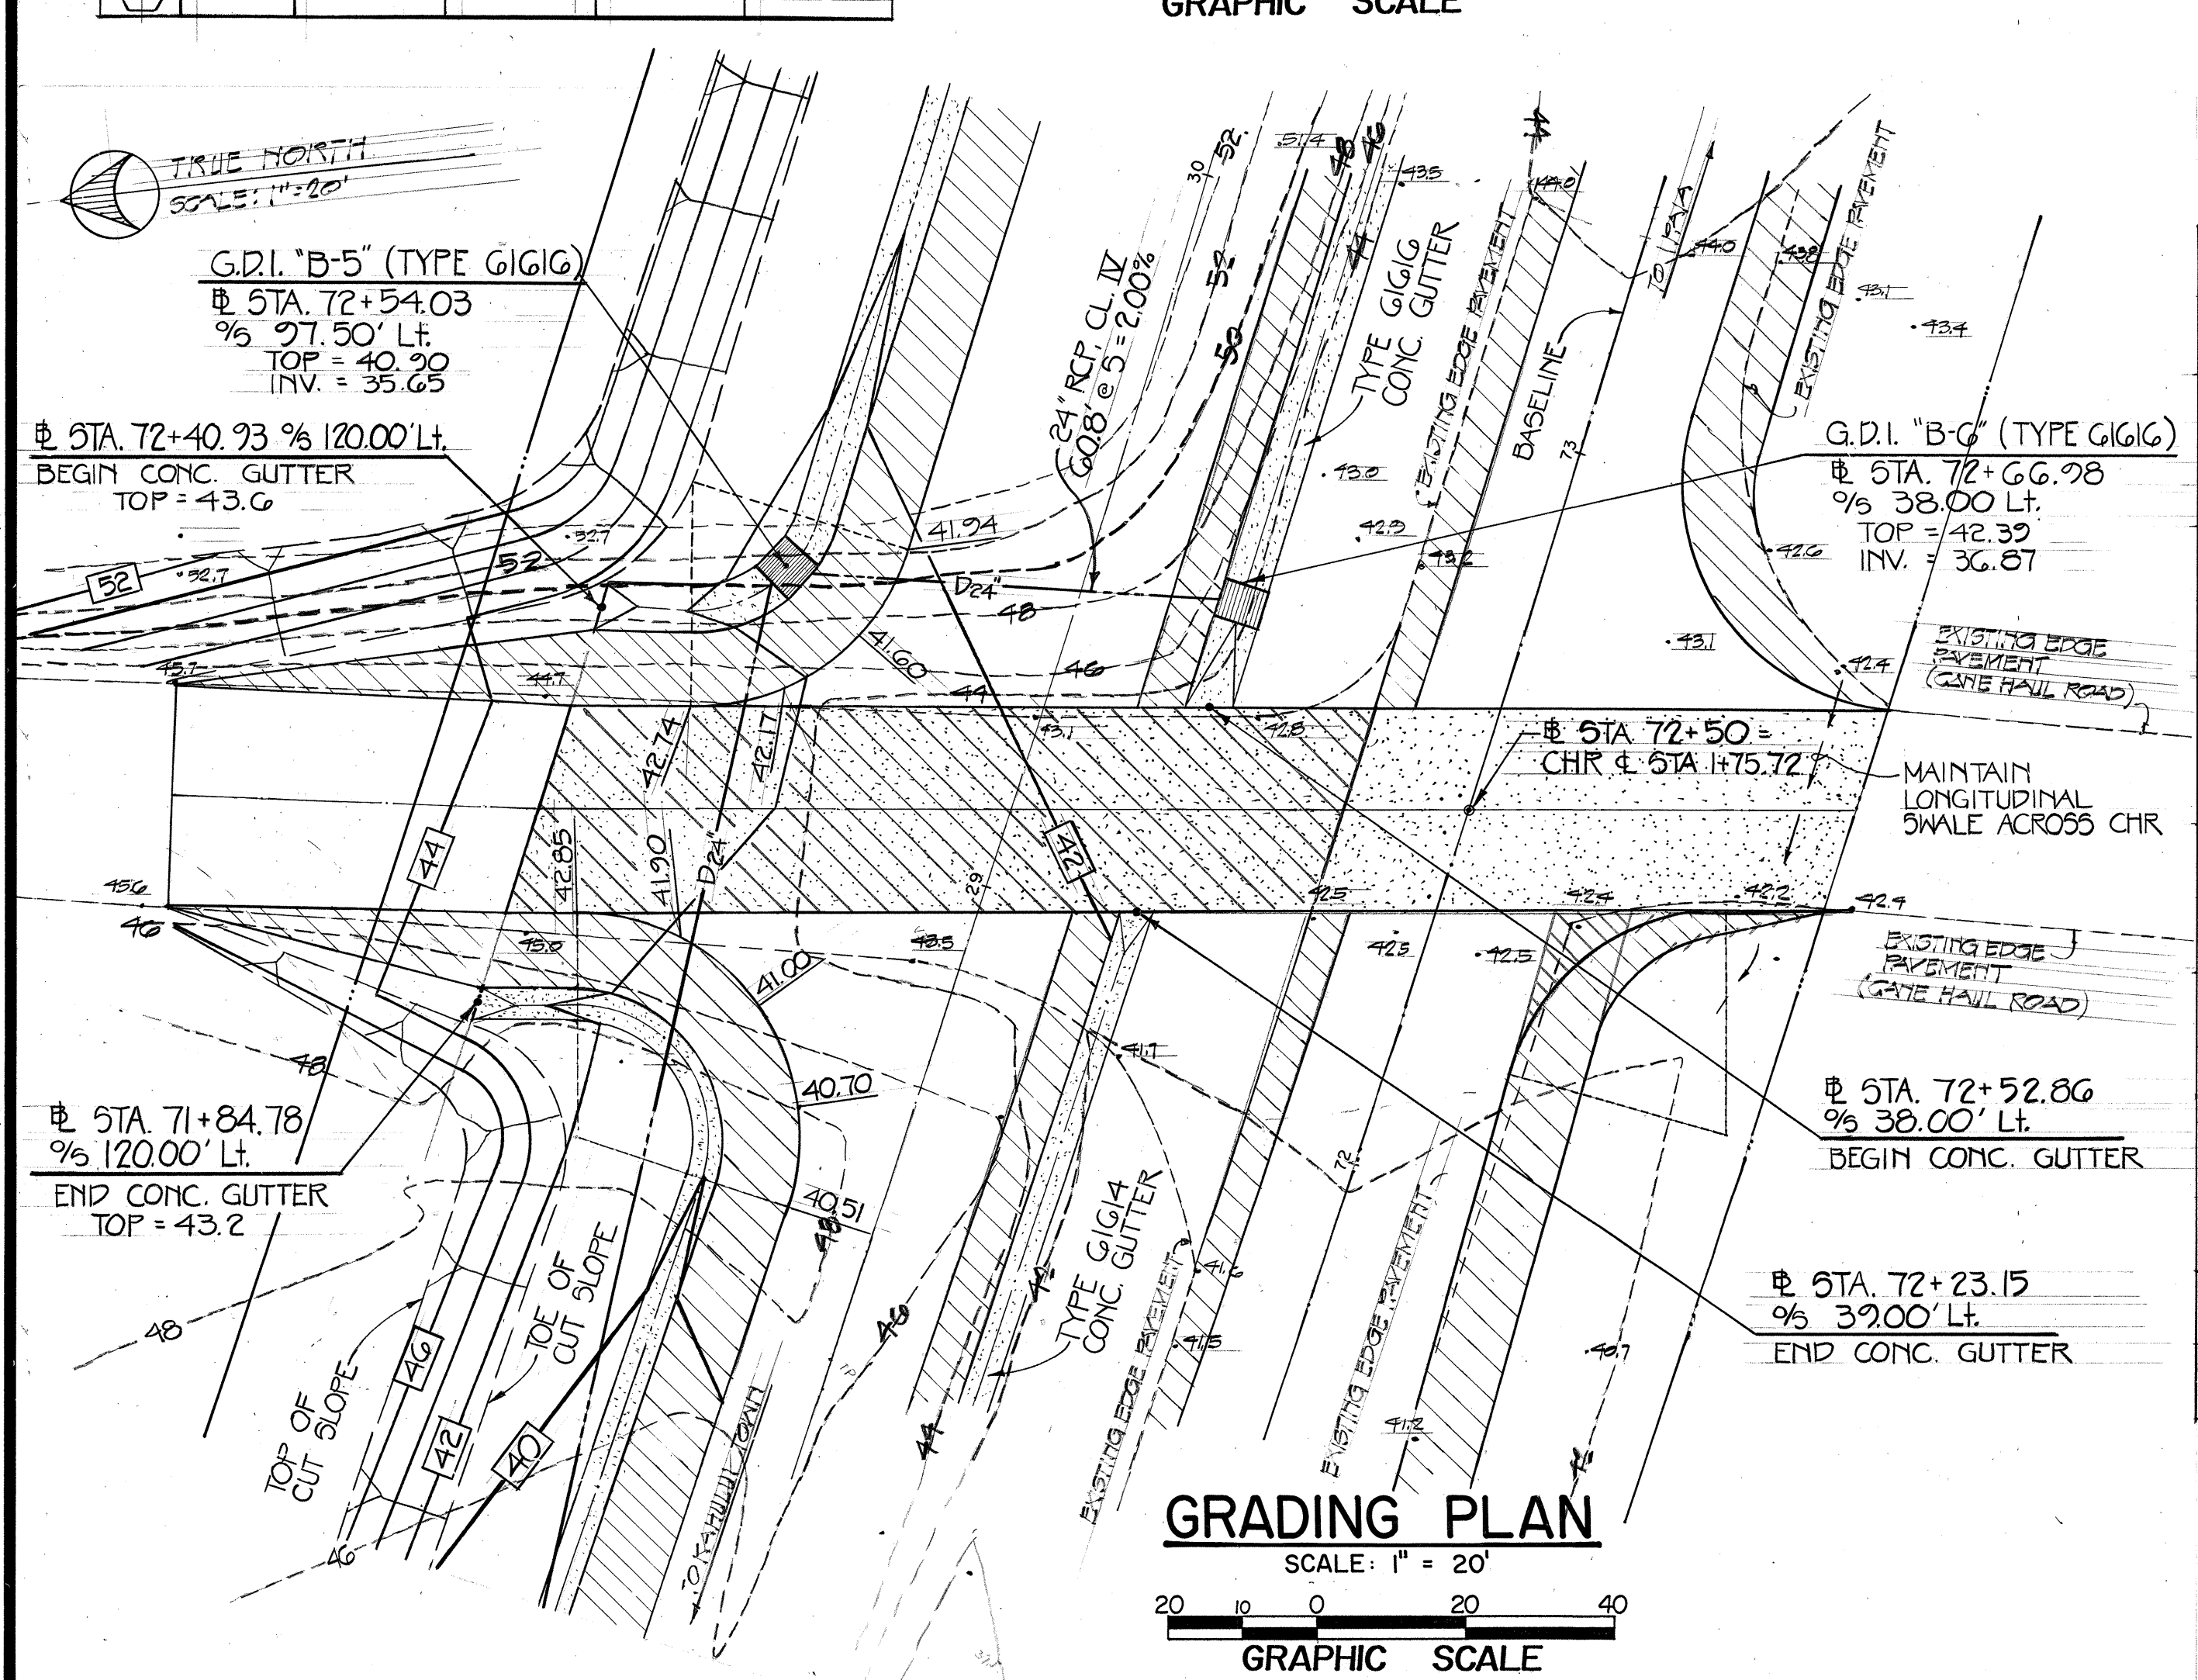


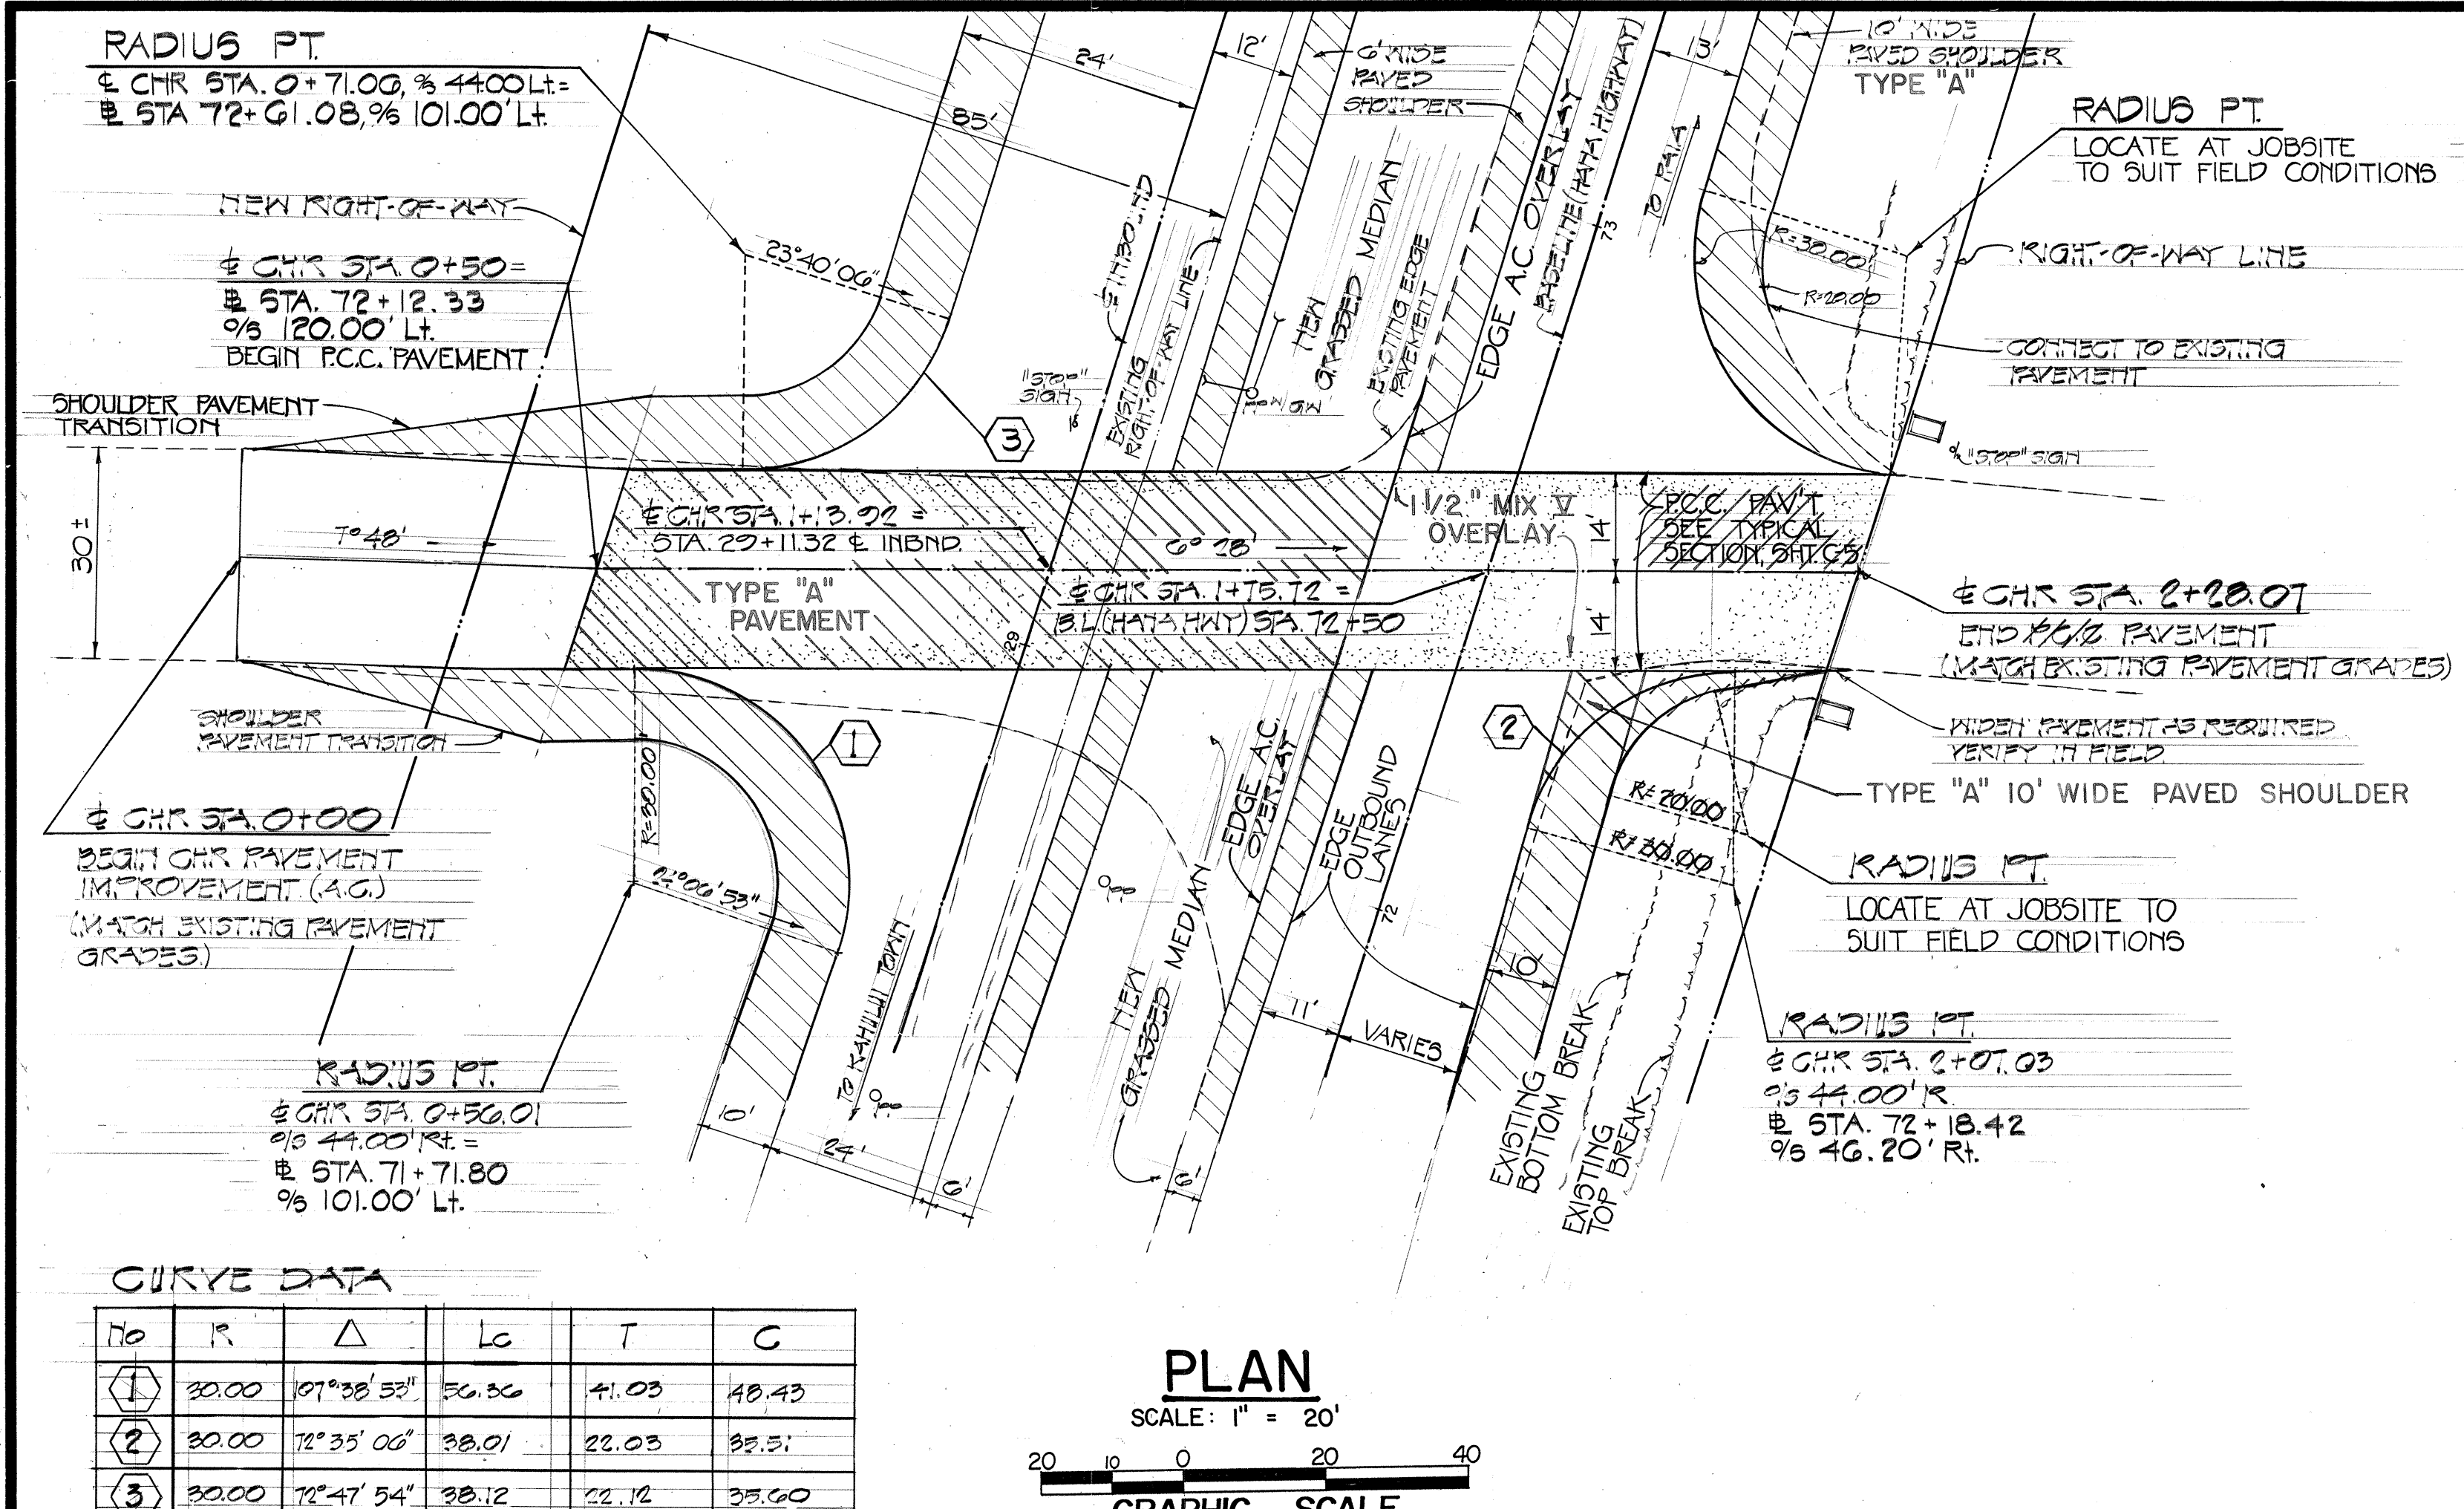

STATE OF HAWAII
1959

Airports Division
DEPARTMENT OF TRANSPORTATION
STATE OF HAWAII

THIS WORK WAS PREPARED BY ME OR UNDER MY SUPERVISION.

ROBERT T. TANAKA
REGISTERED PROFESSIONAL ENGINEER
No. 1754-C
HAWAII, U.S.A.

R. T. TANAKA ENGINEERS, INC.
871 KOLU STREET, SUITE 201
WAILUKU, MAUI, HAWAII 96793

DSGN. DRWN. CHKD. APPD.

R.H. MK./C.N. R.T.T.

KEY PLAN / NOTES :

1-5-90 ADDENDUM #1

NO. DATE REVISIONS

AS-BUILT (Record Drawing)

DATE: 7/12/91

This Drawing has been prepared, in part, based upon information furnished by others. While this information is believed to be reliable, the Design Professional cannot assure the accuracy of this As-Built drawing or for any errors or omission which may have been incorporated into it as a result.

PROJECT TITLE :

HANA HIGHWAY IMPROVEMENTS

PROJECT NO. :

STATE NO. AM-1061-12
AIP NO. 3-15-0006-11

SHEET TITLE :

PLAN & PROFILE
CANE HAUL RD. CROSSING
AT Sta. 72 + 50

DATE: 11-15-89

DWG. NO. :

C-29

