

Airports Division

DEPARTMENT OF TRANSPORTATION
STATE OF HAWAII

PLANS FOR


HANA HIGHWAY IMPROVEMENTS

AT

KAHULUI AIRPORT
KAHULUI, MAUI, HAWAII

STATE PROJECT NO. AM 1061 - 12
AIP PROJECT NO. 3 - 15 - 0006 - 11

DESIGN DESIGNATION DATA
HIGHWAY CLASSIFICATION... MINOR ARTERIAL
CURRENT ADT (1989)..... 29,100
DESIGN ADT (2009)..... 48,400
DHV 4,350
D 80/20
T 4.5

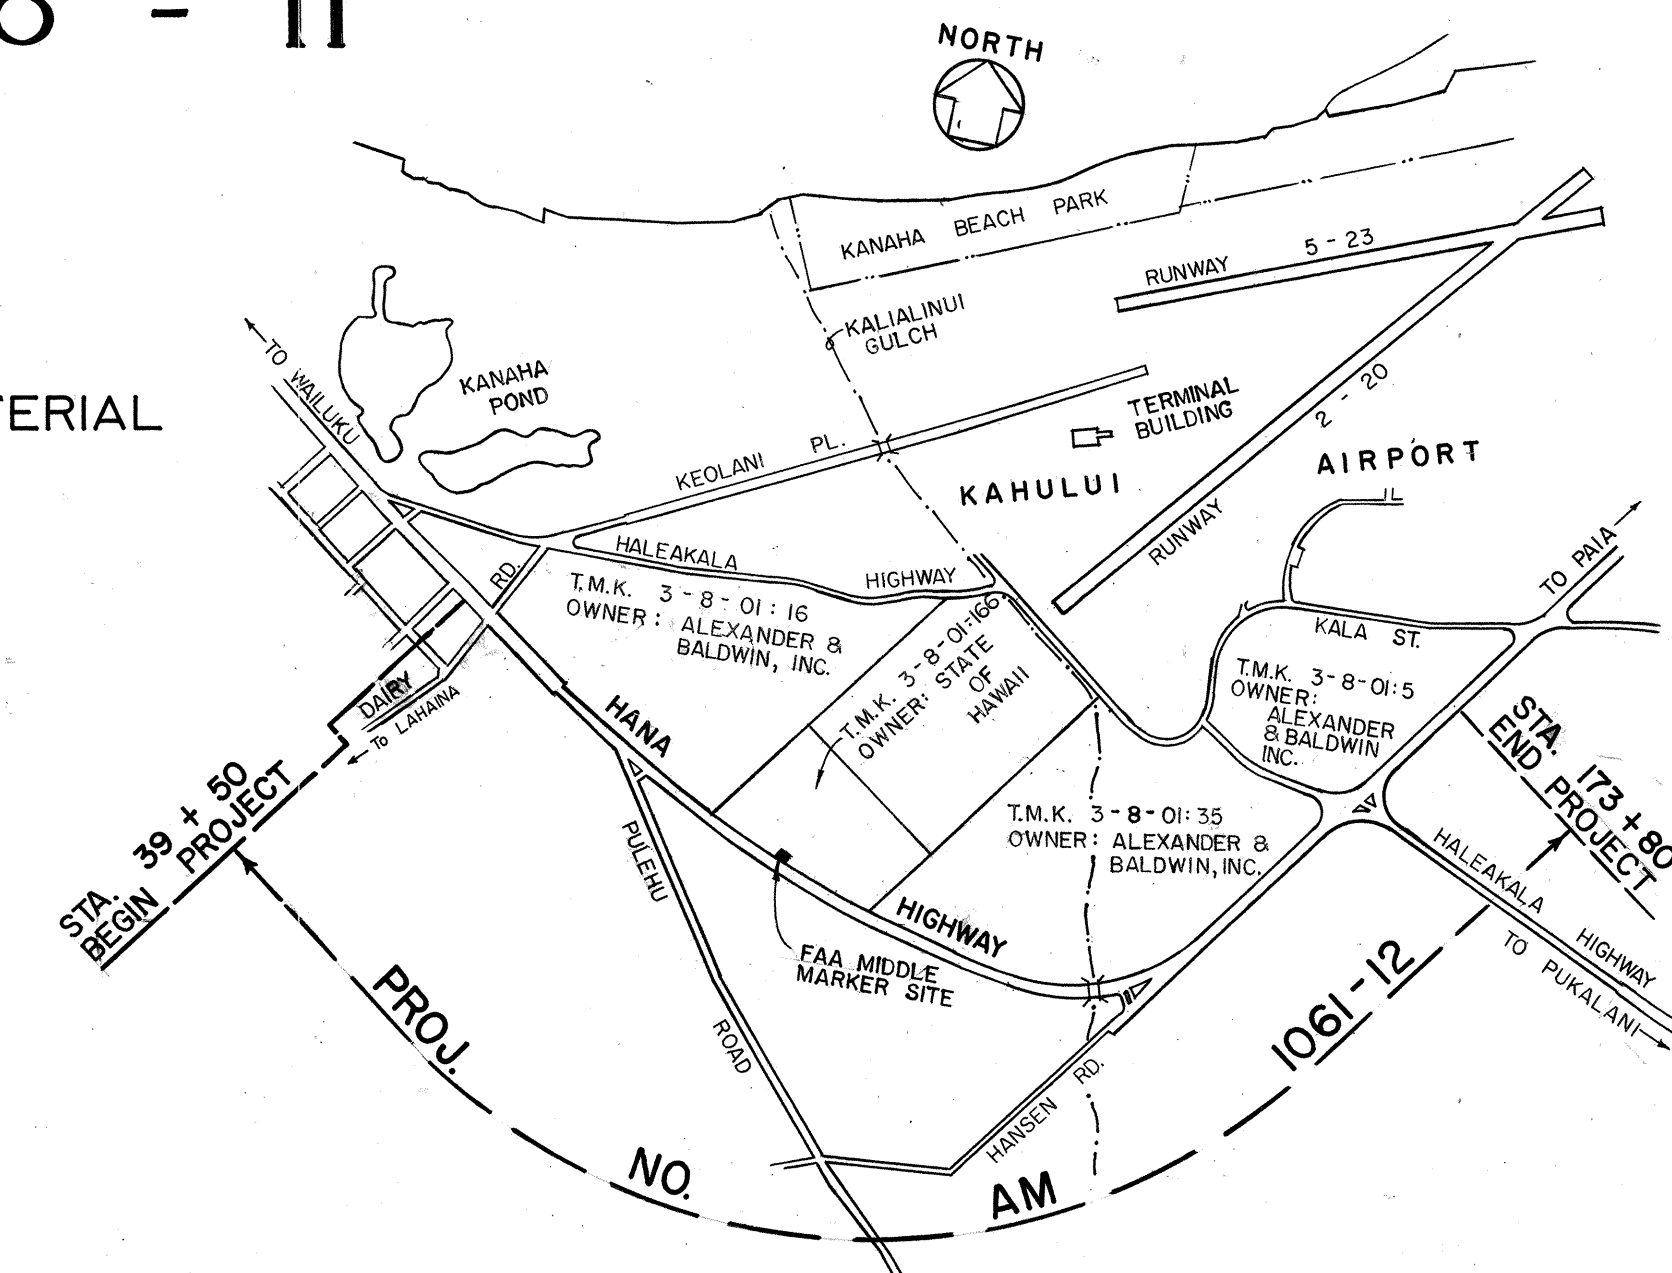


LOCATION MAP
SCALE IN THOUSAND FEET

DEPARTMENT OF TRANSPORTATION
STATE OF HAWAII

APPROVED:

[Signature] 10/6/89
DIR. OF TRANSPORTATION DATE

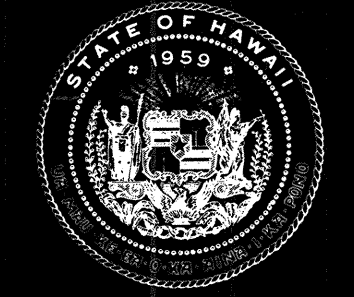

Airports Division
DEPARTMENT OF TRANSPORTATION
STATE OF HAWAII

THIS WORK WAS PREPARED BY
ME OR UNDER MY SUPERVISION.

[Signature] 10/3/89
ROBERT T. TANAKA
PROFESSIONAL ENGINEER
No. 1724-C
HAWAII, U.S.A.

R. T. TANAKA ENGINEERS, INC.
840 ALUA STREET, SUITE 103
WAILUKU, MAUI, HAWAII 96793

DSGN. DRWN. CHKD. APPD.

R.H. M.K.,C.N. R.T.T.

KEY PLAN / NOTES :

NO. DATE REVISIONS

AS-BUILT (Record Drawing)

DATE 7/12/91

This Drawing has been prepared, in part, based upon information furnished by others. While this information is believed to be reliable, the Design Professional cannot assume its accuracy of this As-Built drawing or for any errors or omissions which may have been incorporated into it as a result.

PROJECT TITLE :

HANA HIGHWAY
IMPROVEMENTS

PROJECT NO. :

STATE NO. AM-1061-12
AIP NO. 3-15-0006-11

SHEET TITLE :

TITLE SHEET

DATE :

10-3-89

DWG. NO. :

T-1