



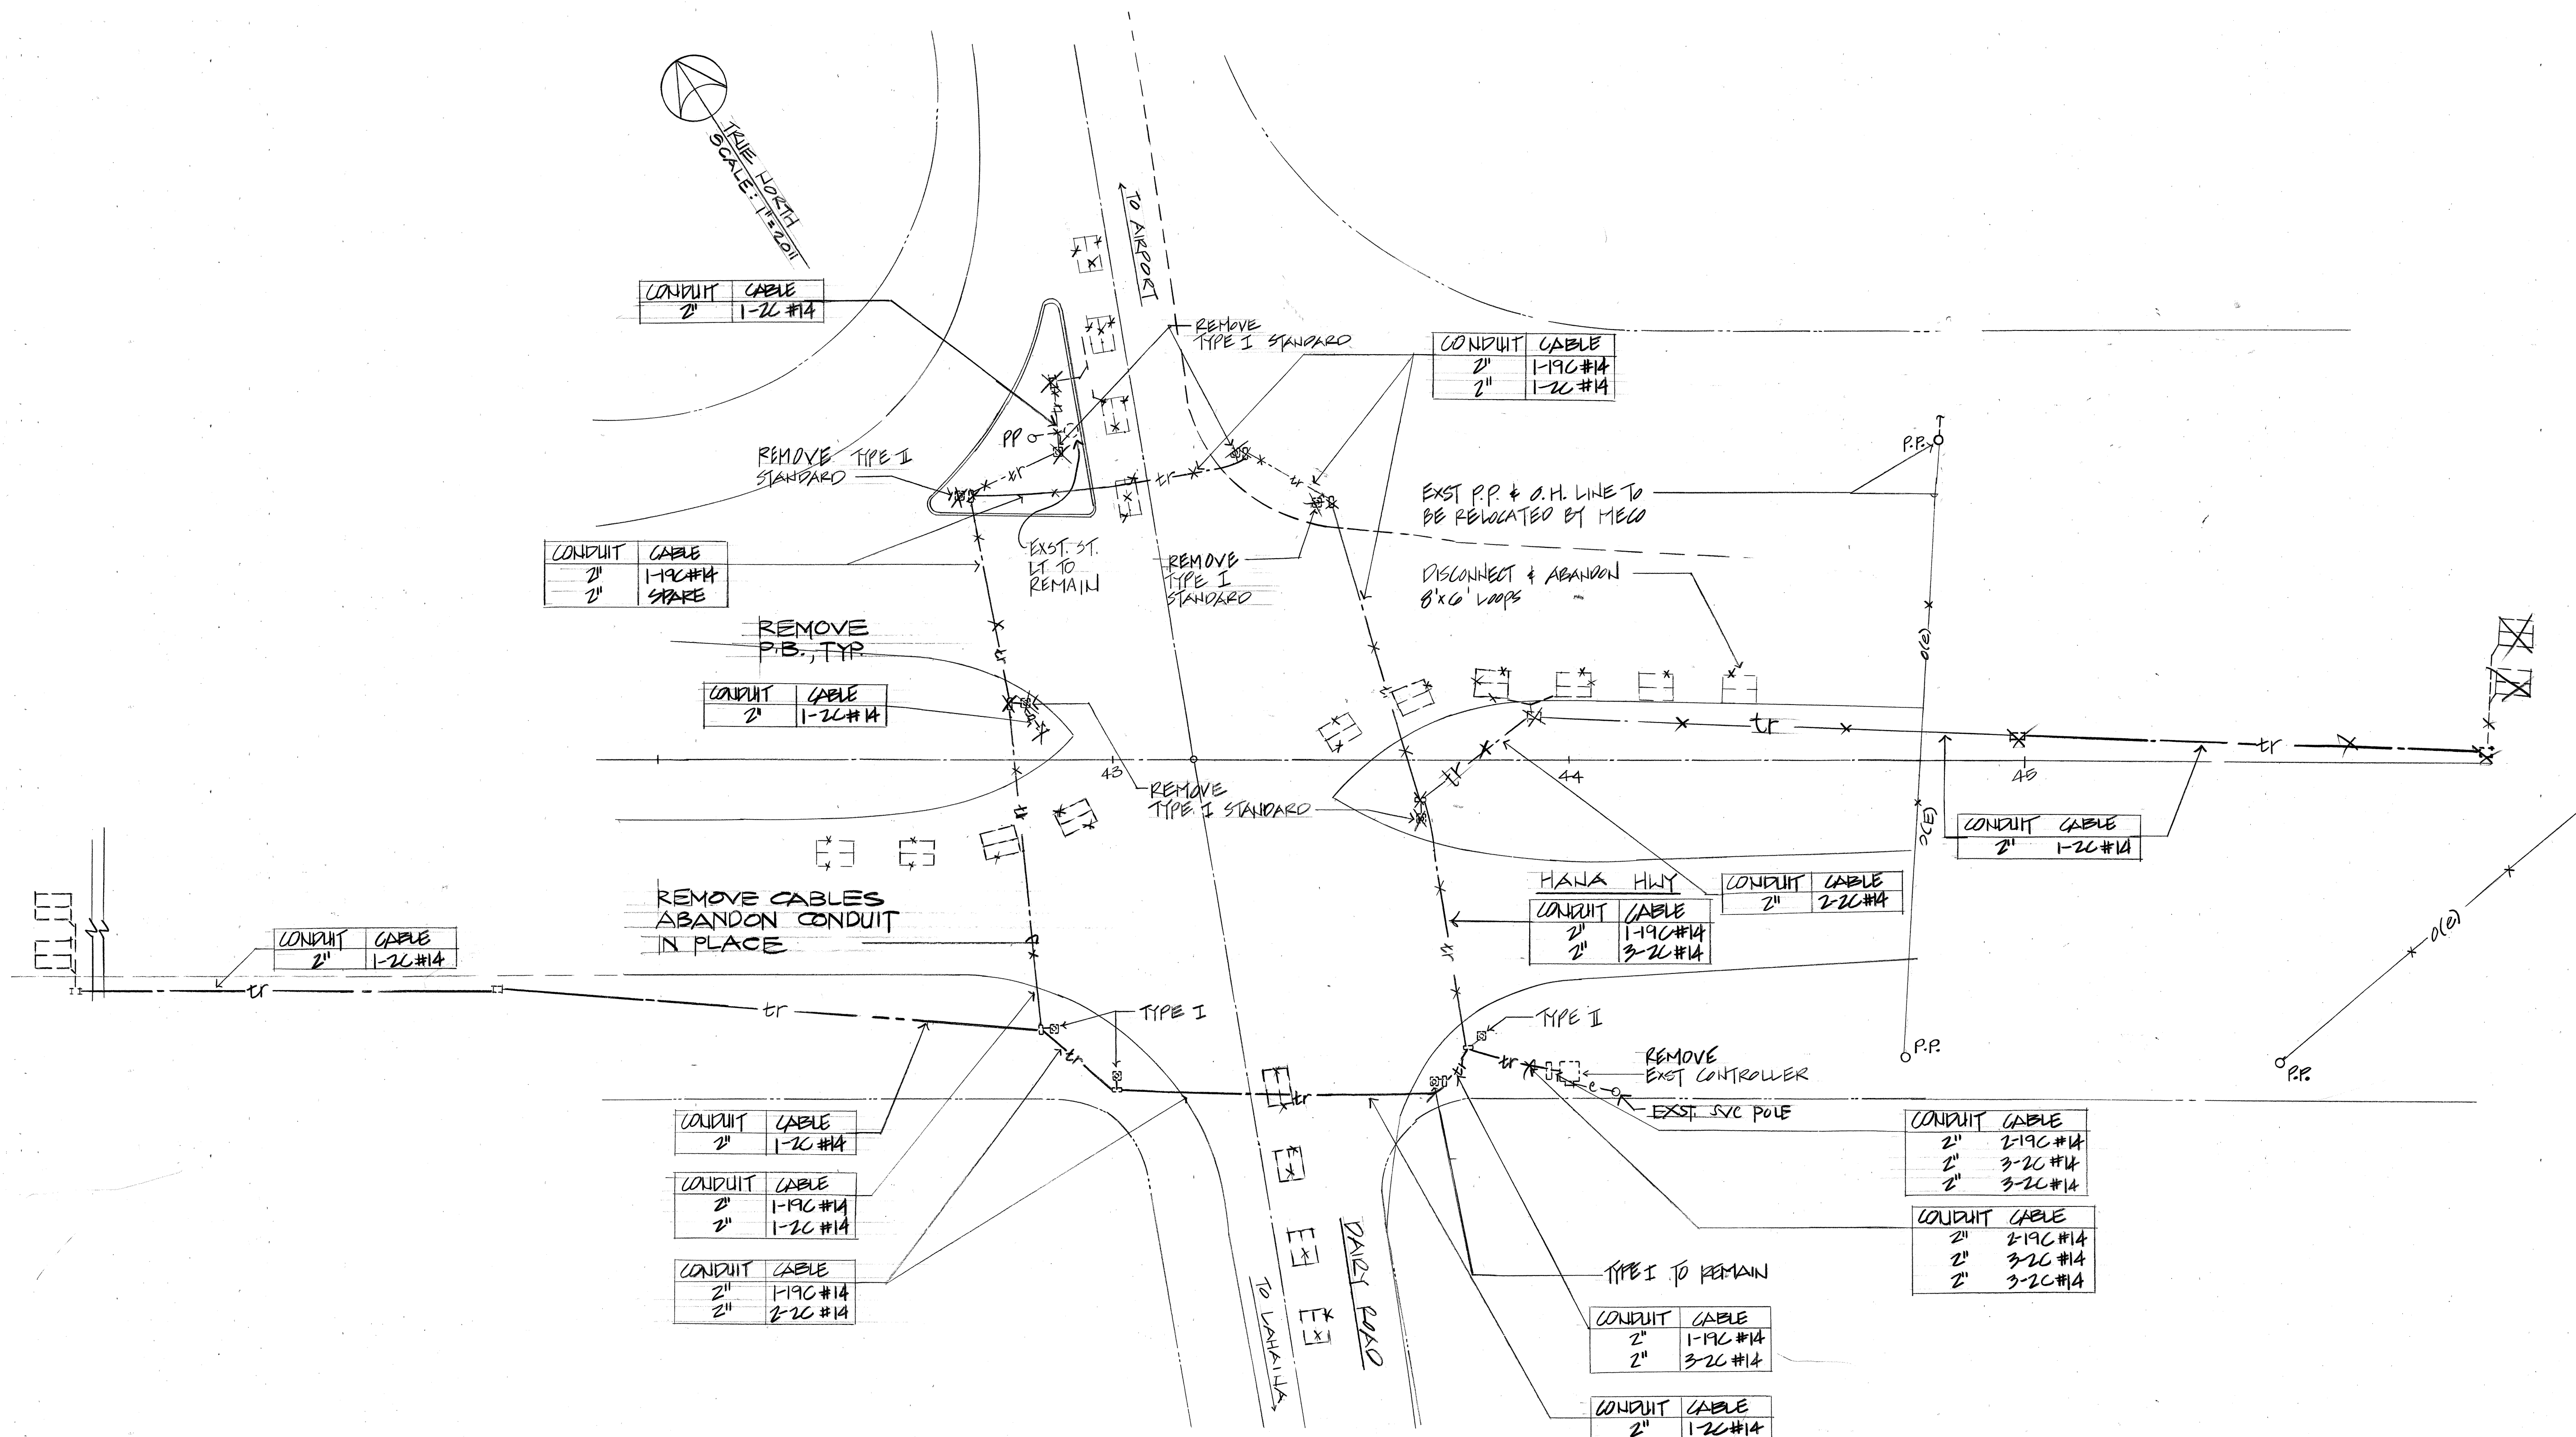


NOTE: STANDARDS & CABLES TO BE REMOVED ONLY AFTER THE NEW SIGNAL SYSTEM IS OPERATIONAL

RECORD DRAWING
DATE 7/12/91

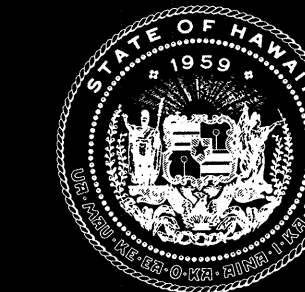

Airports Division
DEPARTMENT OF TRANSPORTATION
STATE OF HAWAII

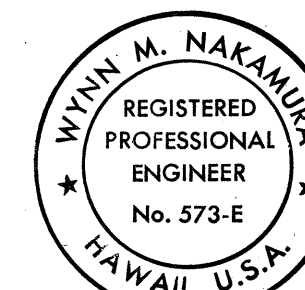

THIS WORK WAS PREPARED BY
ME OR UNDER MY SUPERVISION.
Shunichi Nakamura
NAKAMURA, OYAMA & ASSOC., INC. 2888
CONSULTING ENGINEERS

DSGN.	DRWN.	CHKD.	APPD.
-------	-------	-------	-------

KEY PLAN / NOTES :

NO.	DATE	REVISIONS
-----	------	-----------

PROJECT TITLE :

HANA HIGHWAY IMPROVEMENTS

PROJECT NO. :

STATE NO. AM-1061-12
AIP NO. 3-15-0006-11

SHEET TITLE :

TRAFFIC SIGNAL
DEMOLITION PLAN
DAIRY ROAD INTERSECTION

DATE :

9-28-89

DWG. NO. :