


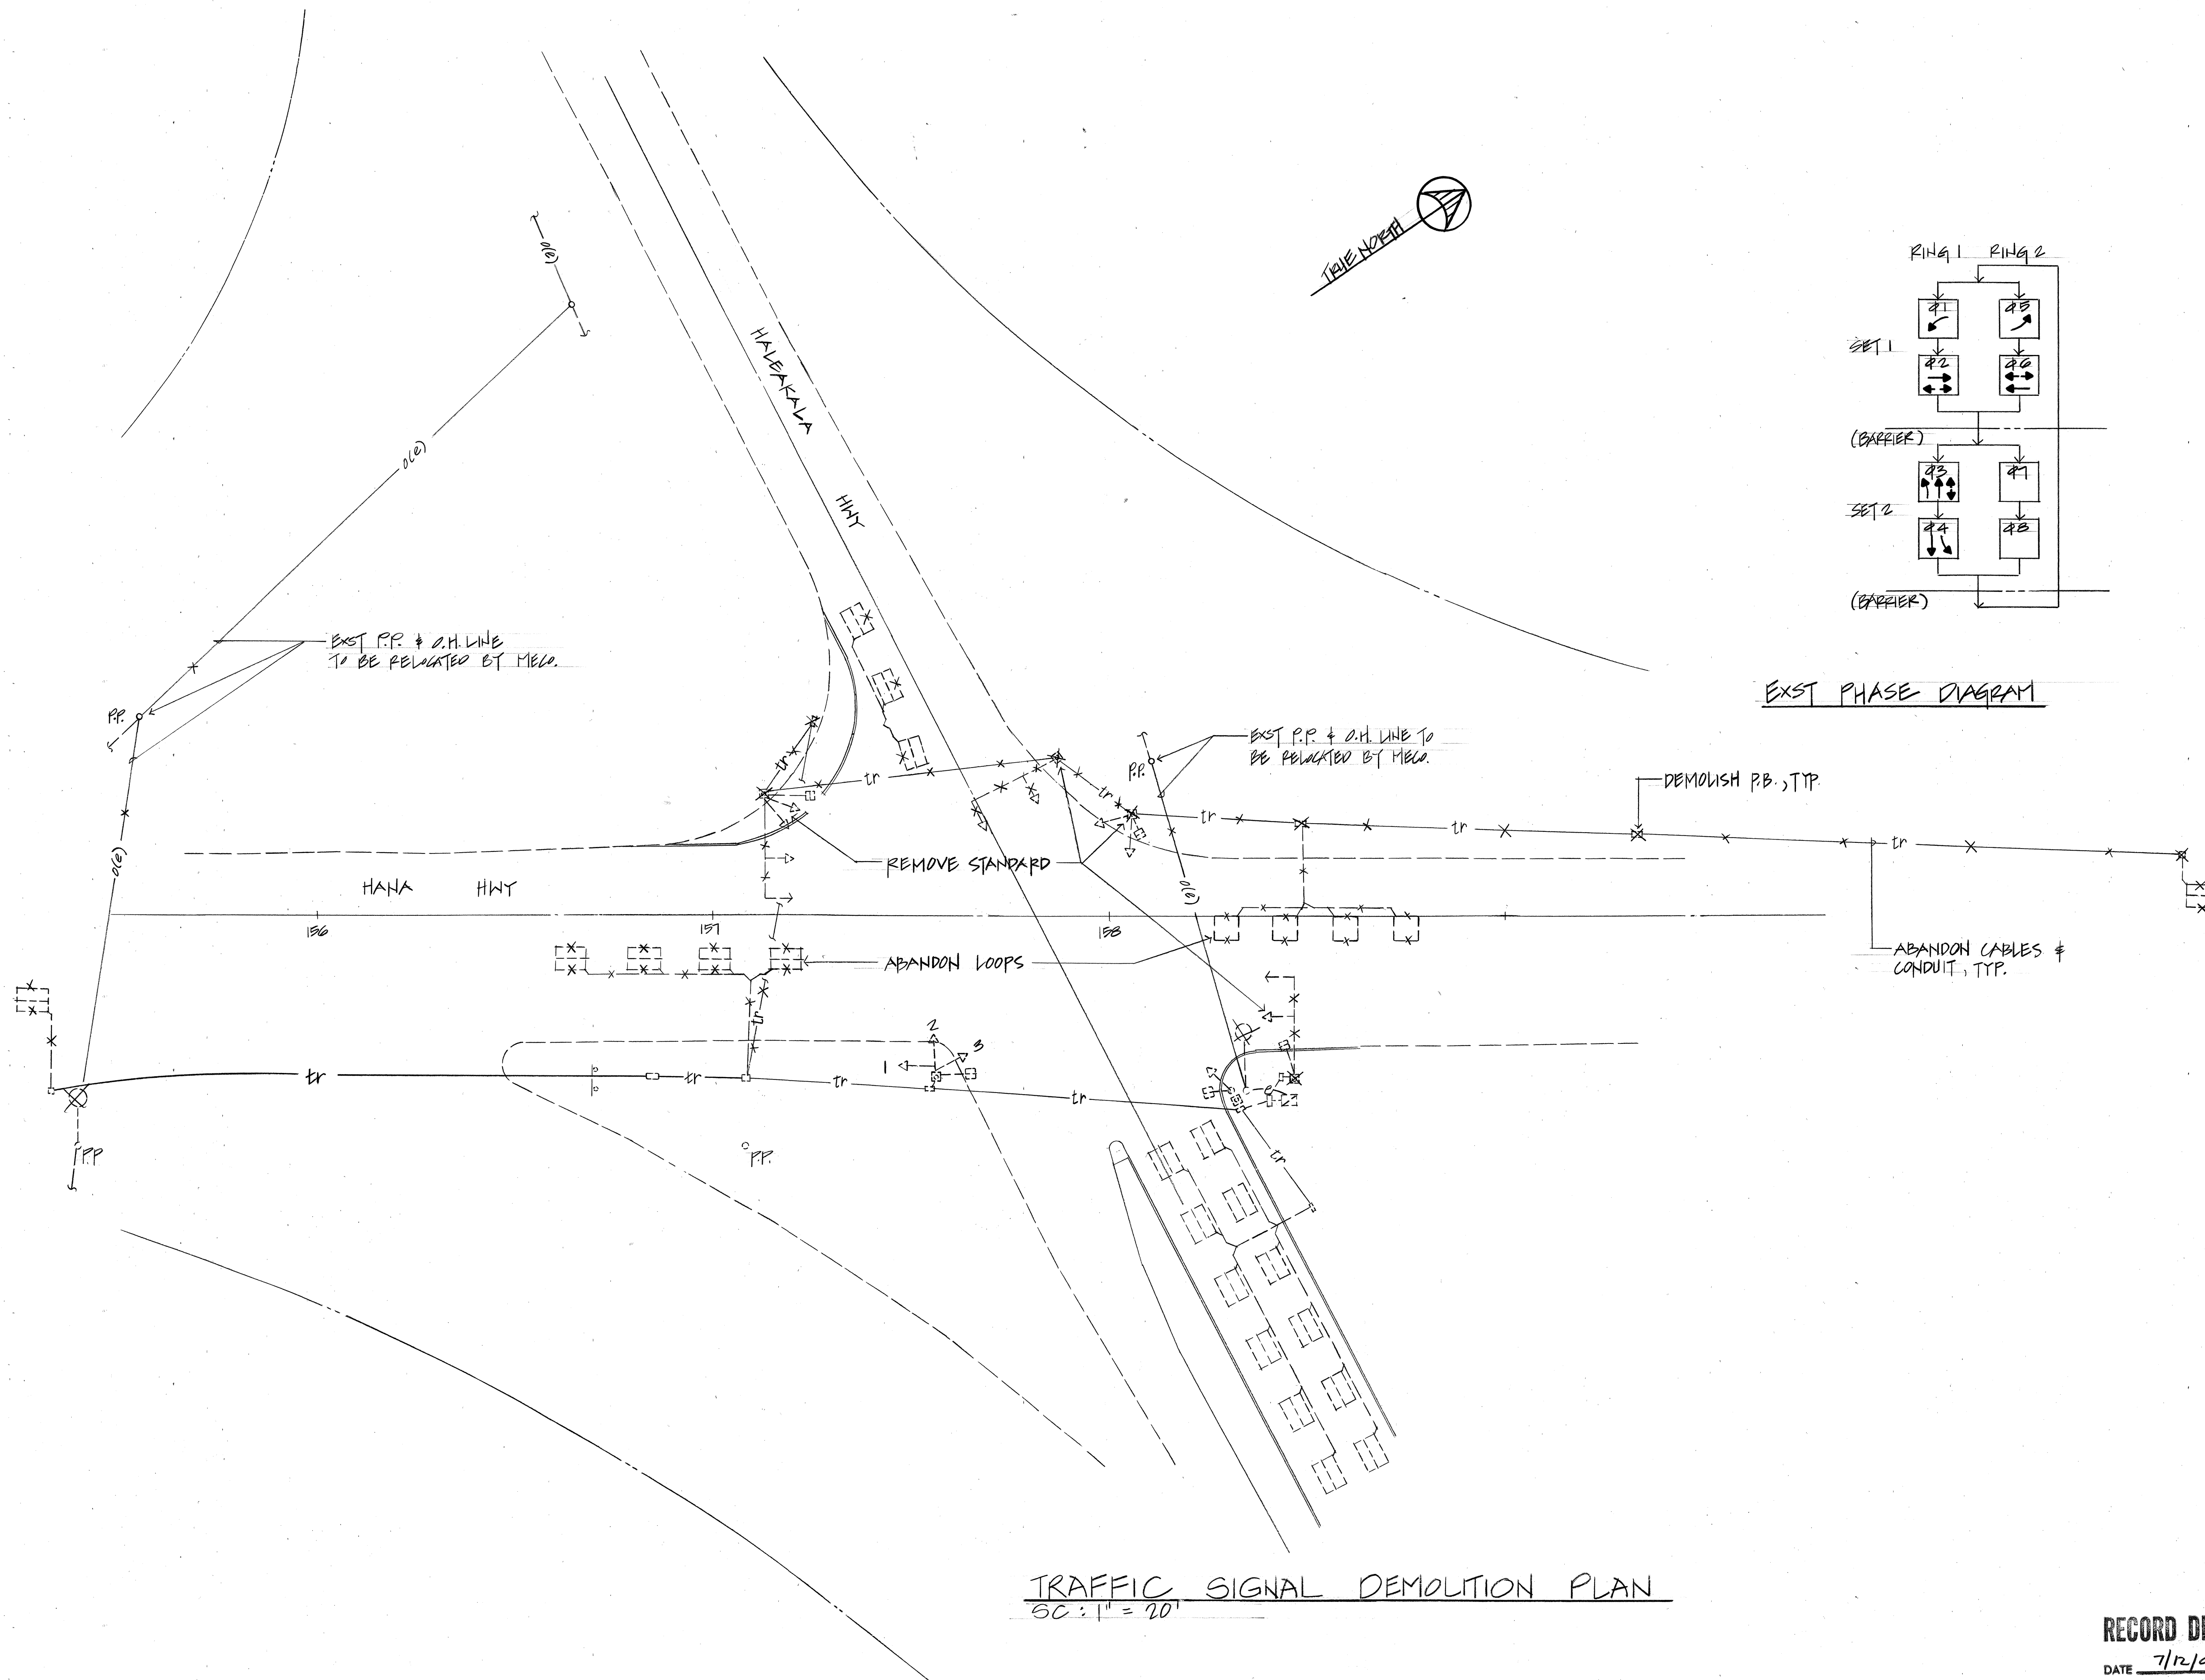


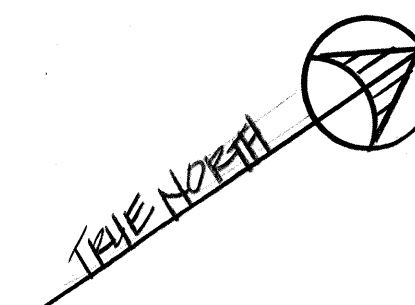


TRAFFIC SIGNAL DEMOLITION PLAN
SC: 1" = 20'

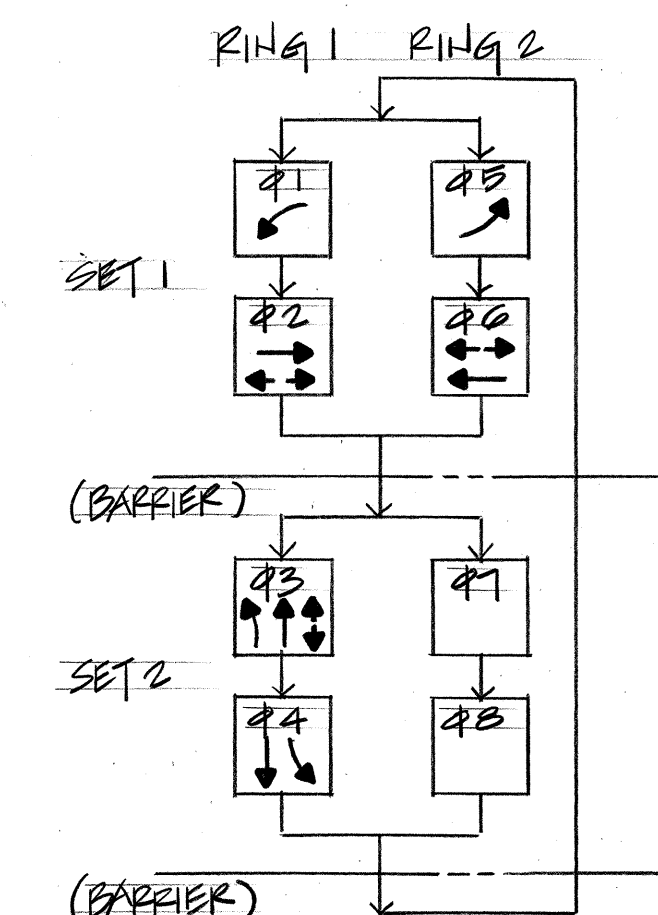

EXIST PHASE DIAGRAM

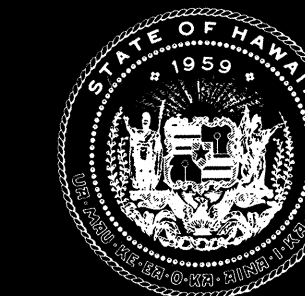

Airports Division
DEPARTMENT OF TRANSPORTATION
STATE OF HAWAII

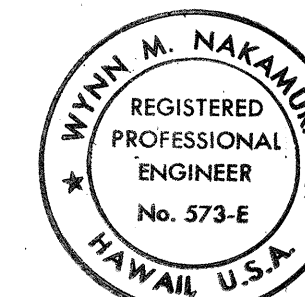

THIS WORK WAS PREPARED BY
ME OR UNDER MY SUPERVISION
Wynn M. Nakamura
NAKAMURA, OYAMA & ASSOC., INC.
CONSULTING ENGINEERS

DSGN. DRWN. CHKD. APPD.

KEY PLAN / NOTES :

NO. DATE REVISIONS

PROJECT TITLE :

HANA HIGHWAY
IMPROVEMENTS

PROJECT NO. :

STATE NO. AM-1001-12
AIP NO. 345-0006

SHEET TITLE :

TRAFFIC SIGNAL
DEMOLITION PLAN
HANA - HALEAKALA HWY
INTERSECTION

DATE :

9-28-89

DWG. NO. :

1E-5

RECORD DRAWING

DATE 7/12/91