



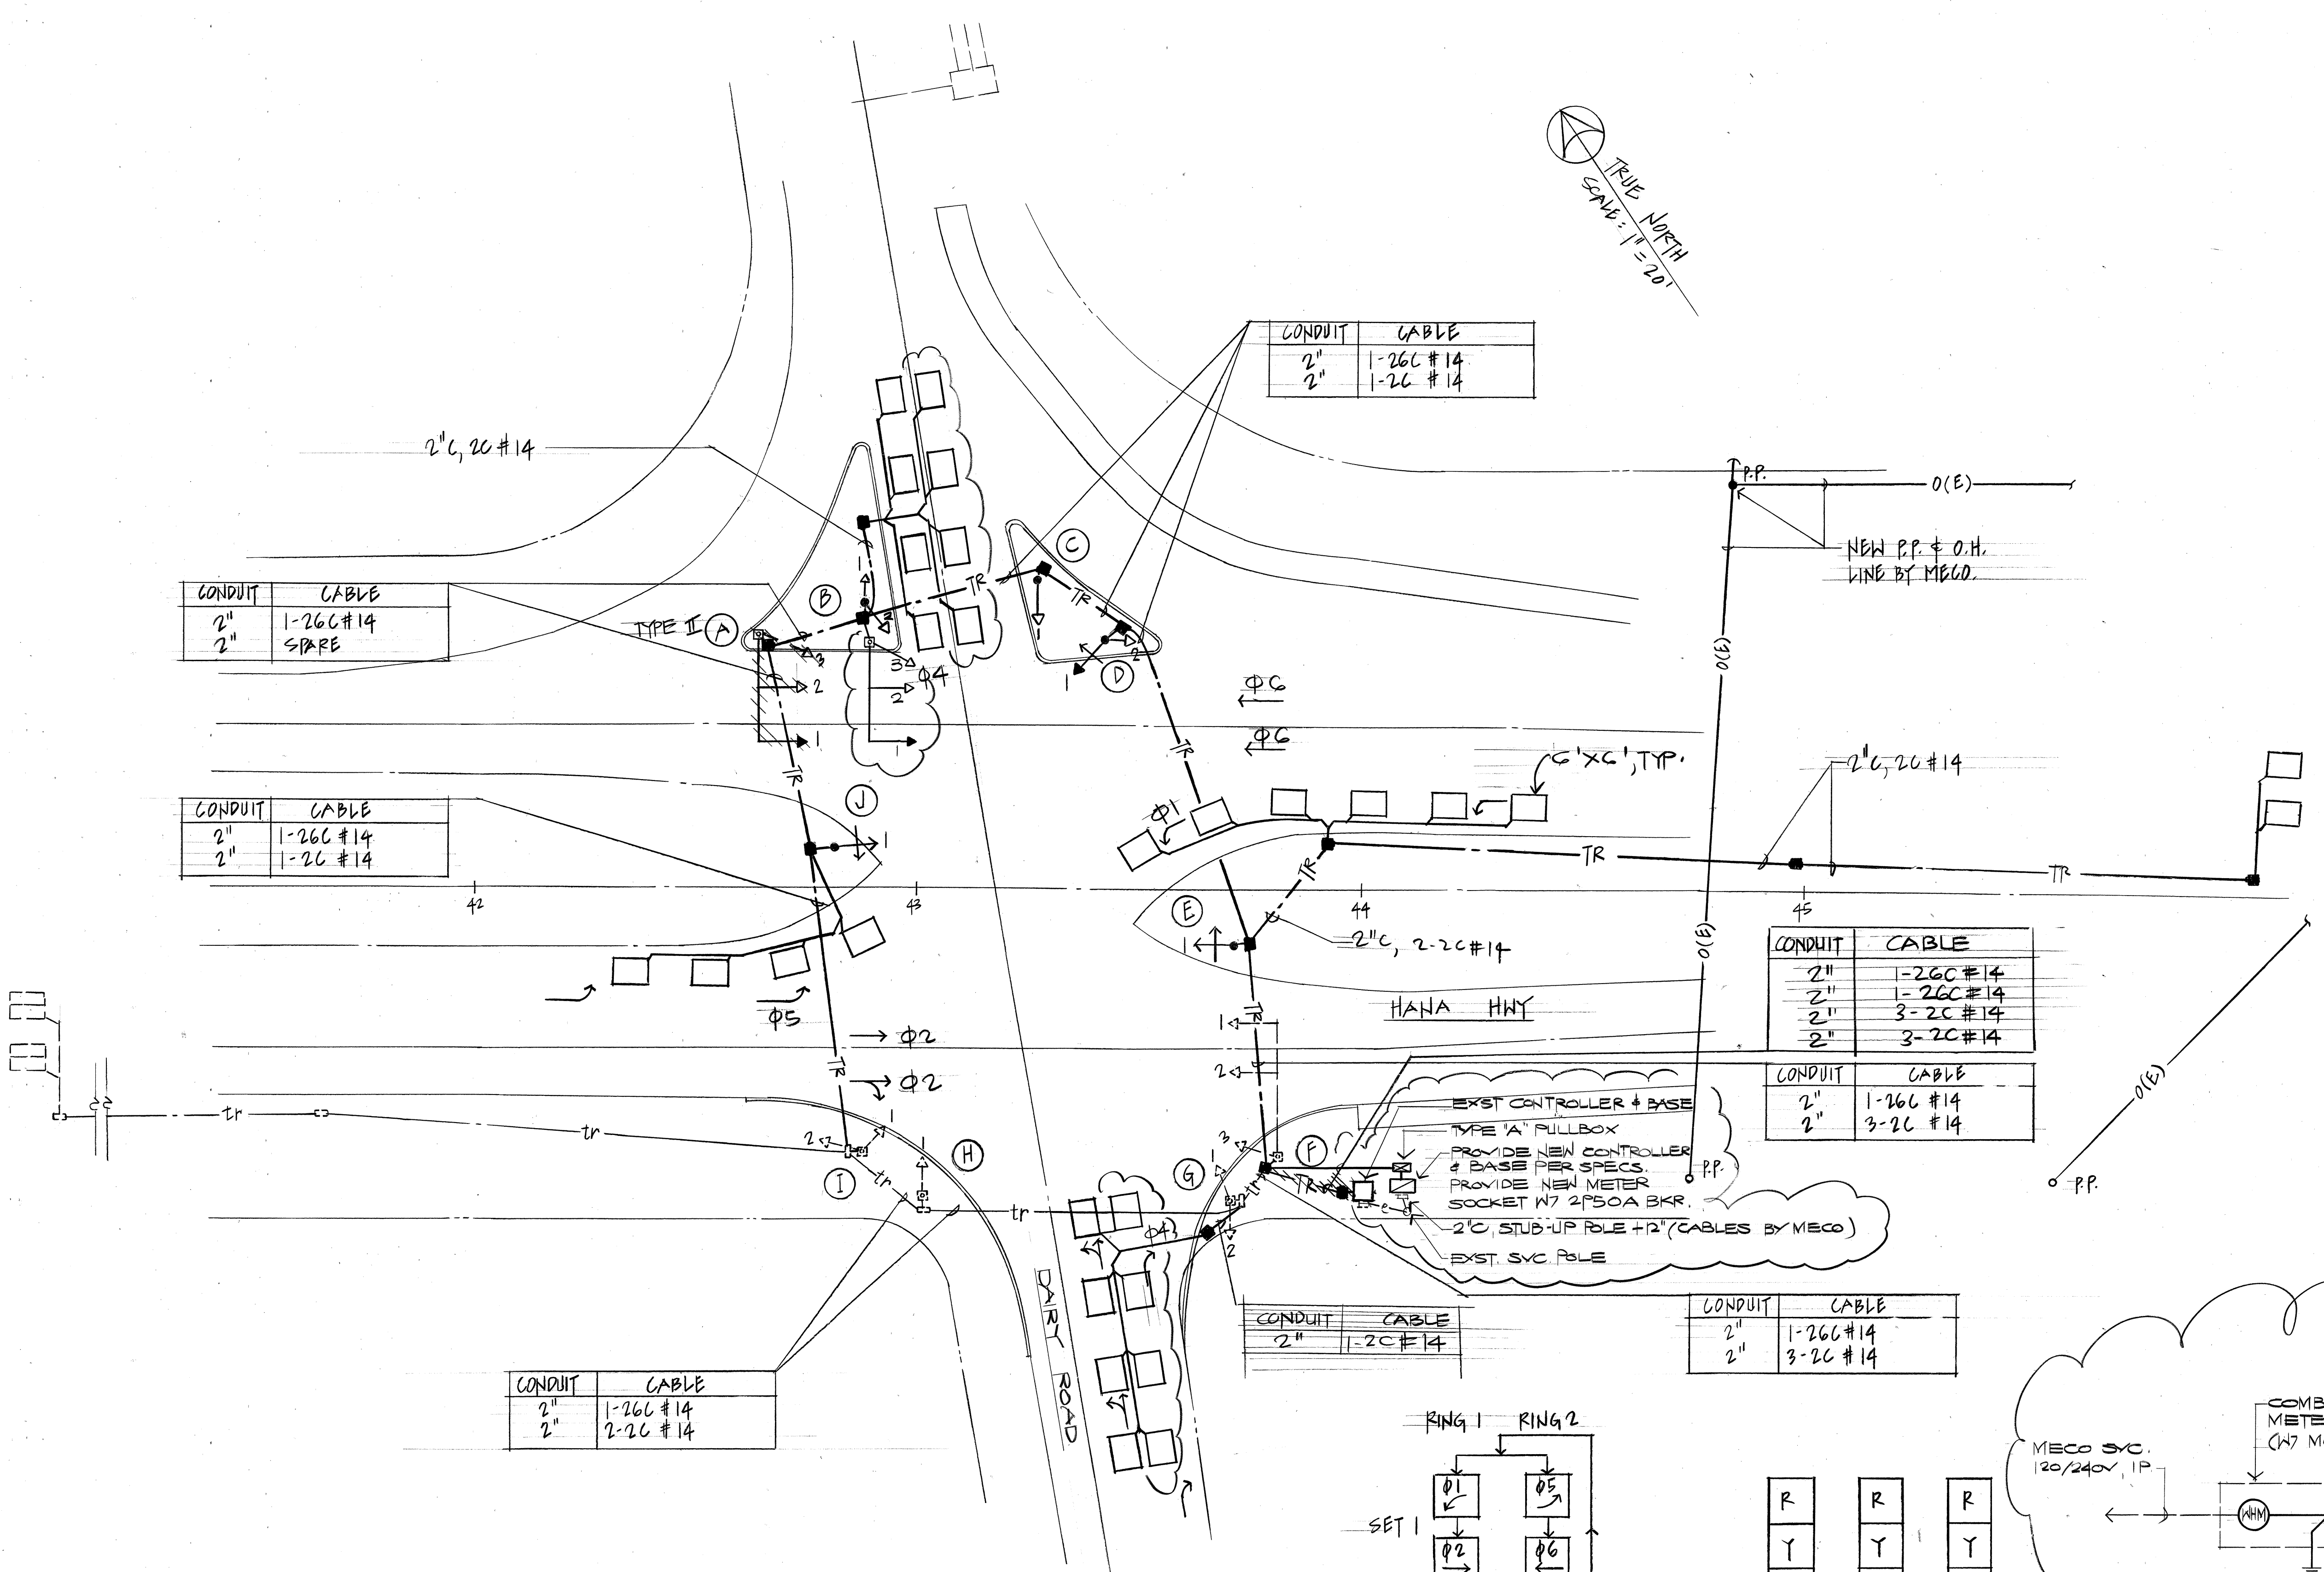


TRAFFIC SIGNAL PLAN

SCALE: 1"=20'


NOTE: SEE SHT. E-3 FOR DEMOLITION PLAN

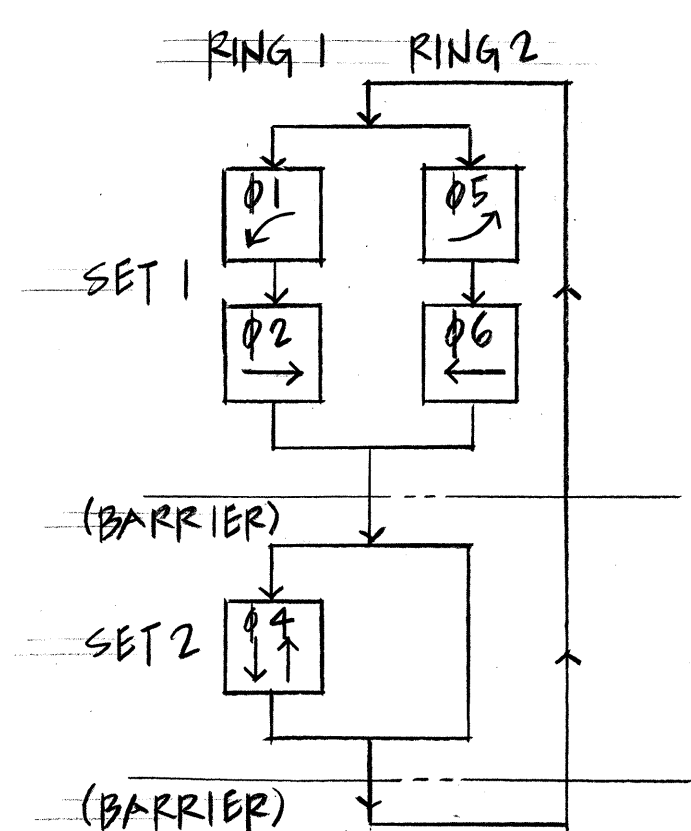


PHASE DIAGRAM
(EXST. & NEW)

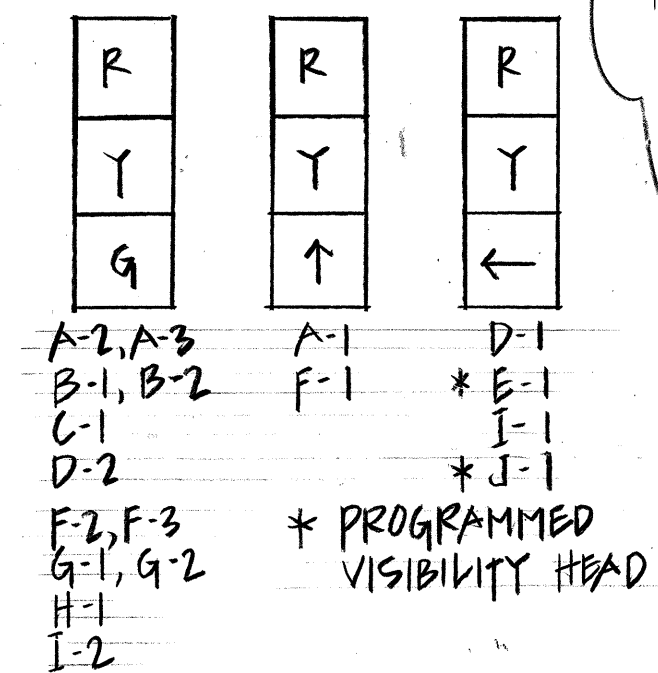

SIGNAL INDICATIONS

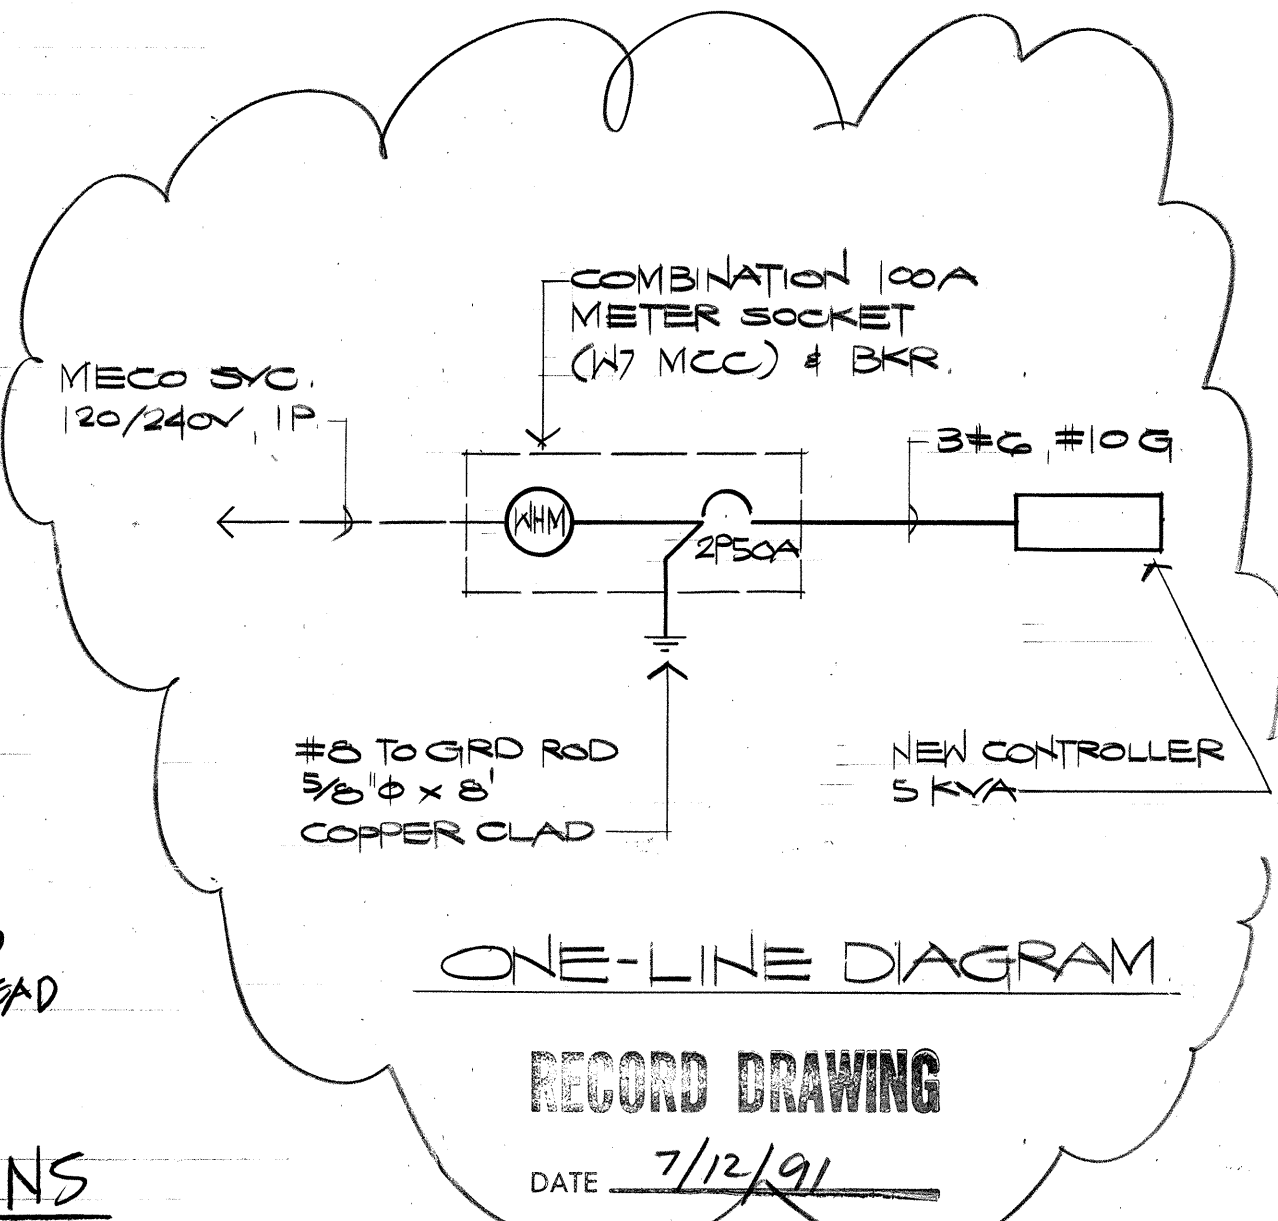

Airports Division
DEPARTMENT OF TRANSPORTATION
STATE OF HAWAII

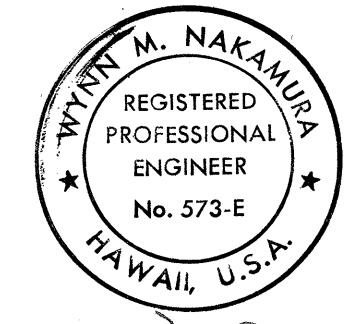

THIS WORK WAS PREPARED BY ME OR UNDER MY SUPERVISION.

WILLIAM M. NAKAMURA
NAKAMURA, OYAMA & ASSOC., INC.

DSGN. DRWN. CHKD. APPD.

KEY PLAN / NOTES :

NO. DATE REVISIONS

PROJECT TITLE :

HANA HIGHWAY IMPROVEMENTS

PROJECT NO. :

STATE NO. AM-1061-12
AIP NO. 3-15-0006-11

SHEET TITLE :

TRAFFIC SIGNAL PLAN
DAIRY ROAD INTERSECTION

DATE :

9-28-89

DWG. NO. :

E-2