



THIS WORK WAS PREPARED
ME OR UNDER MY SUPERVISION
Kenji M. Nakamura
NAKAMURA, OYAMA & ASSOC., INC.
CONSULTING ENGINEERS

KEY PLAN / NOTES :

	7-17-90	REPLACED EXISTING CONTROLLER PER DOT REQUIREMENTS
NO.	DATE	REVISIONS

PROJECT TITLE :

HANA HIGHWAY IMPROVEMENTS

PROJECT NO. :

STATE NO. AM-1061-12
AIP NO. 3-15-0006

SHEET TITLE :


TRAFFIC SIGNAL PLAN
HANA - HALEAKALA
HIGHWAY INTERSECTION

DATE : _____

9-28-80

DWG. NO.

E-G

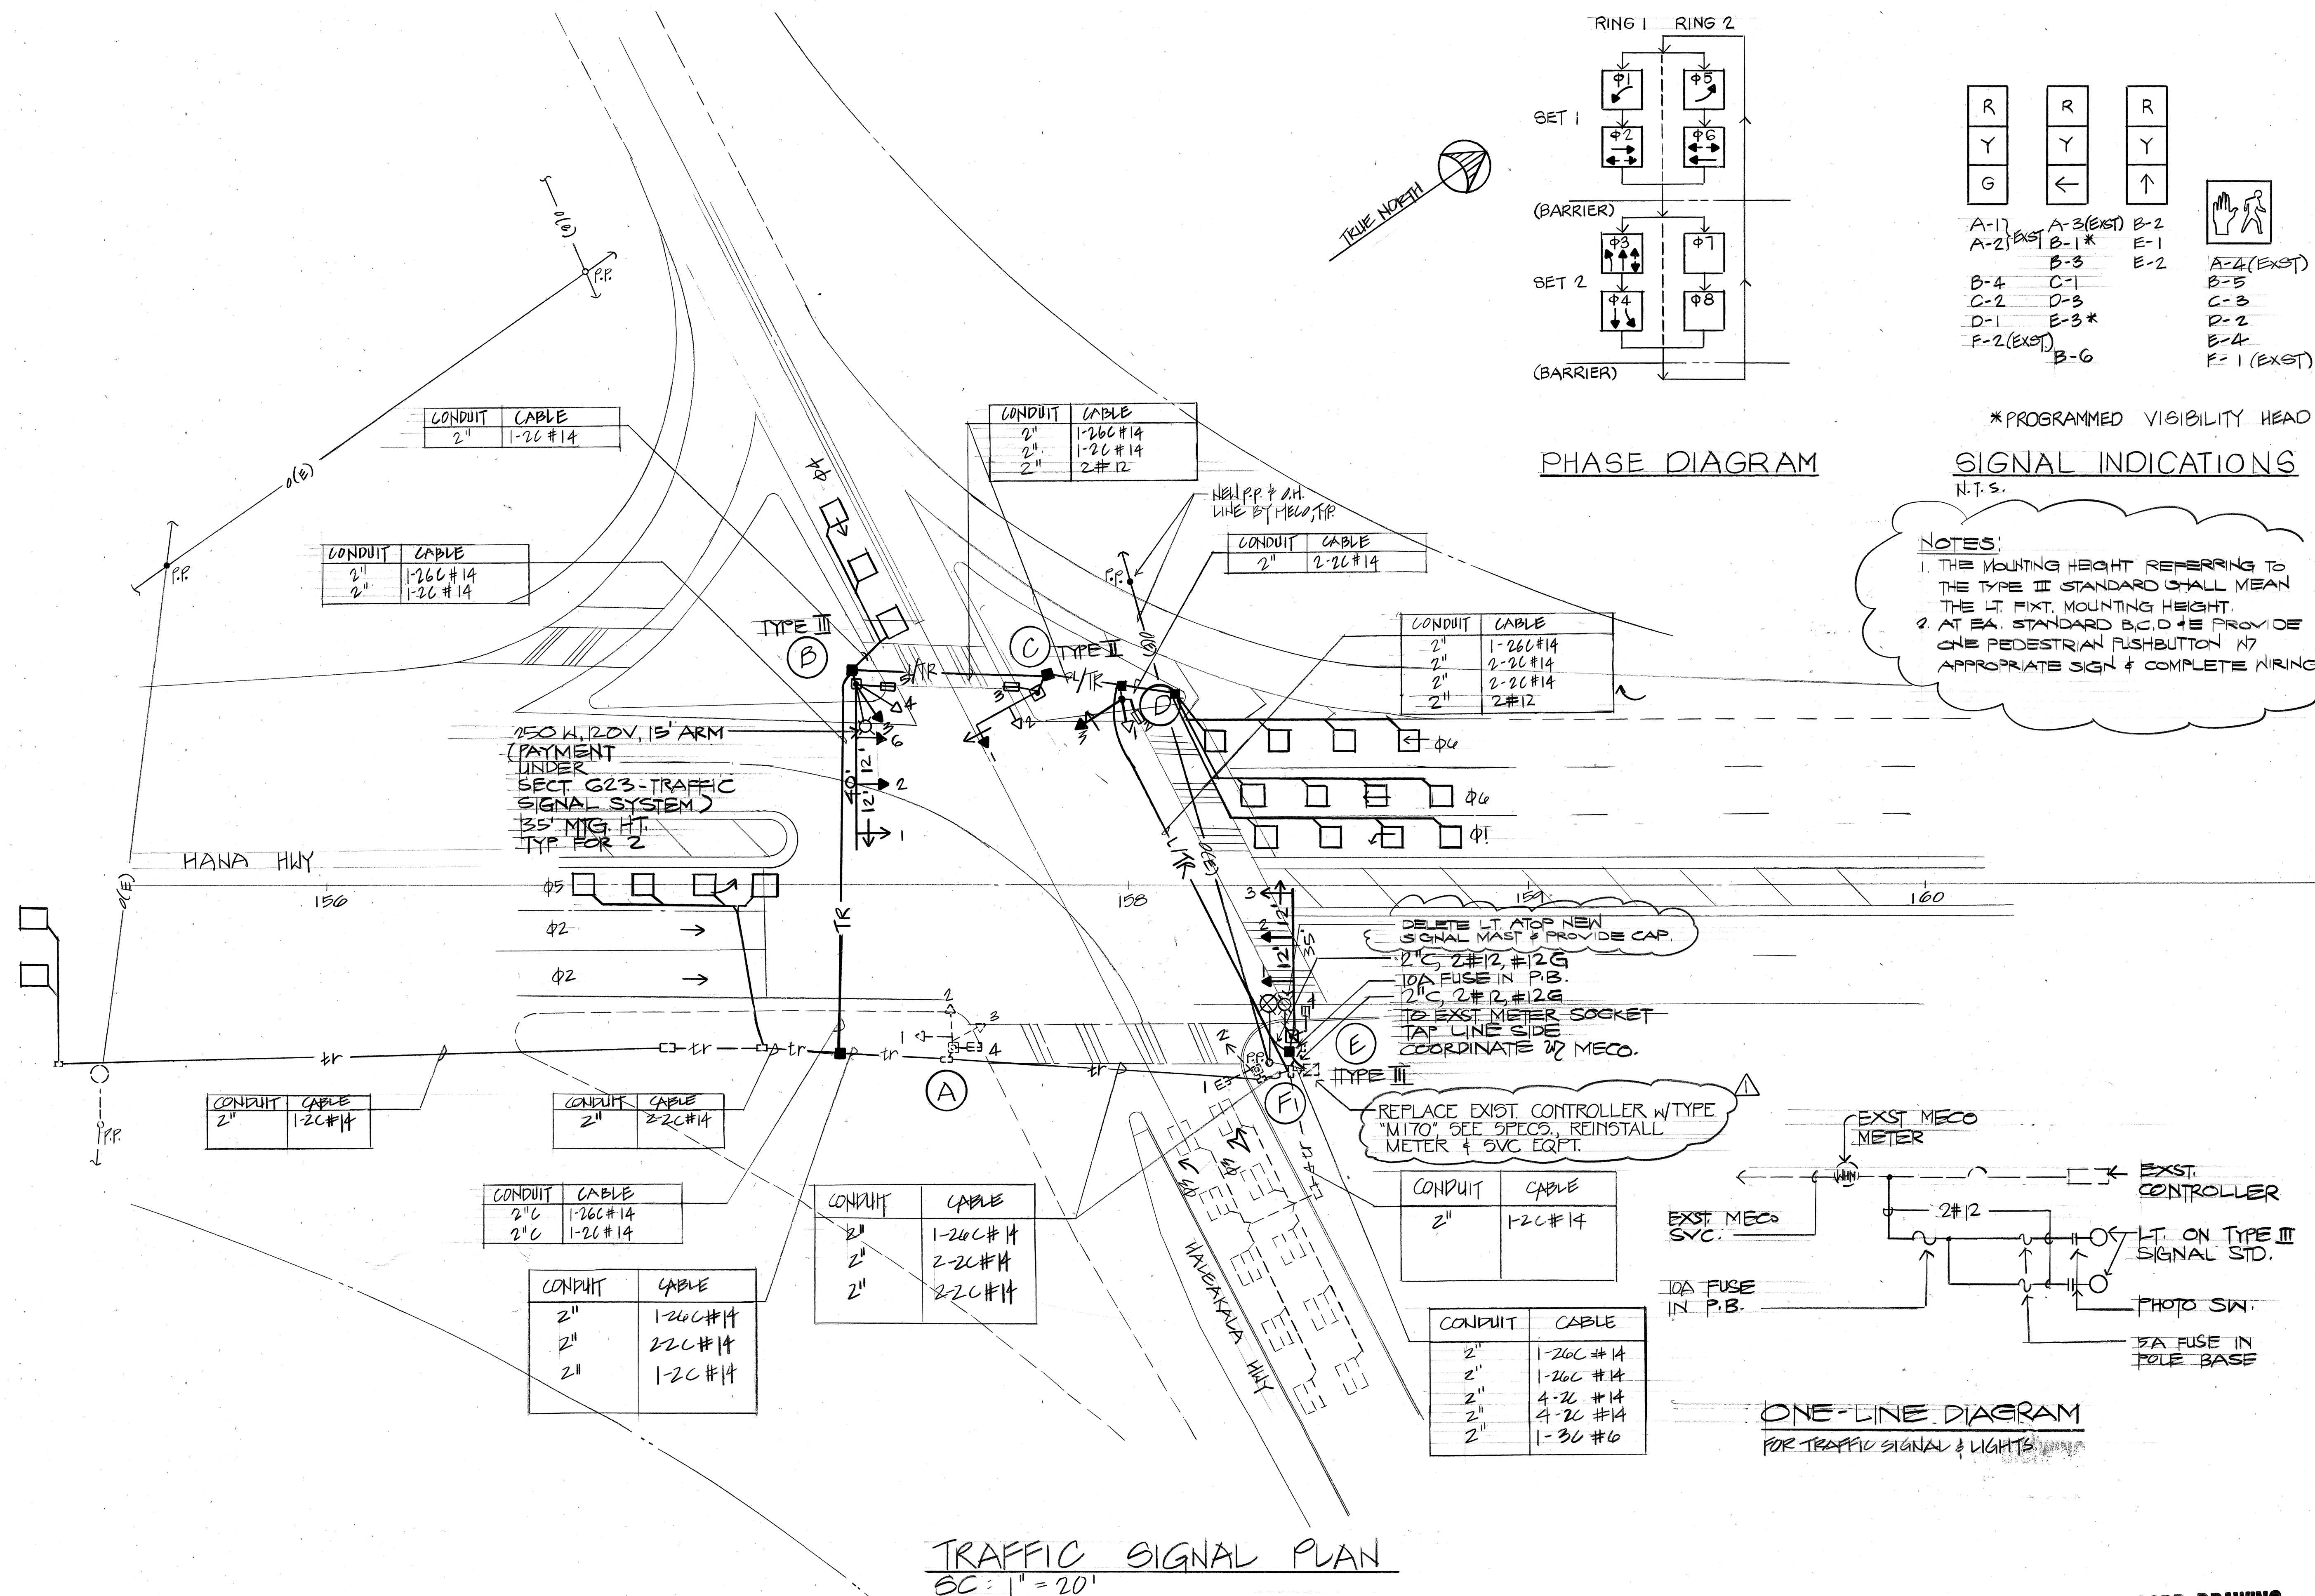

RECORD DRAWING

DATE 7/12/9