
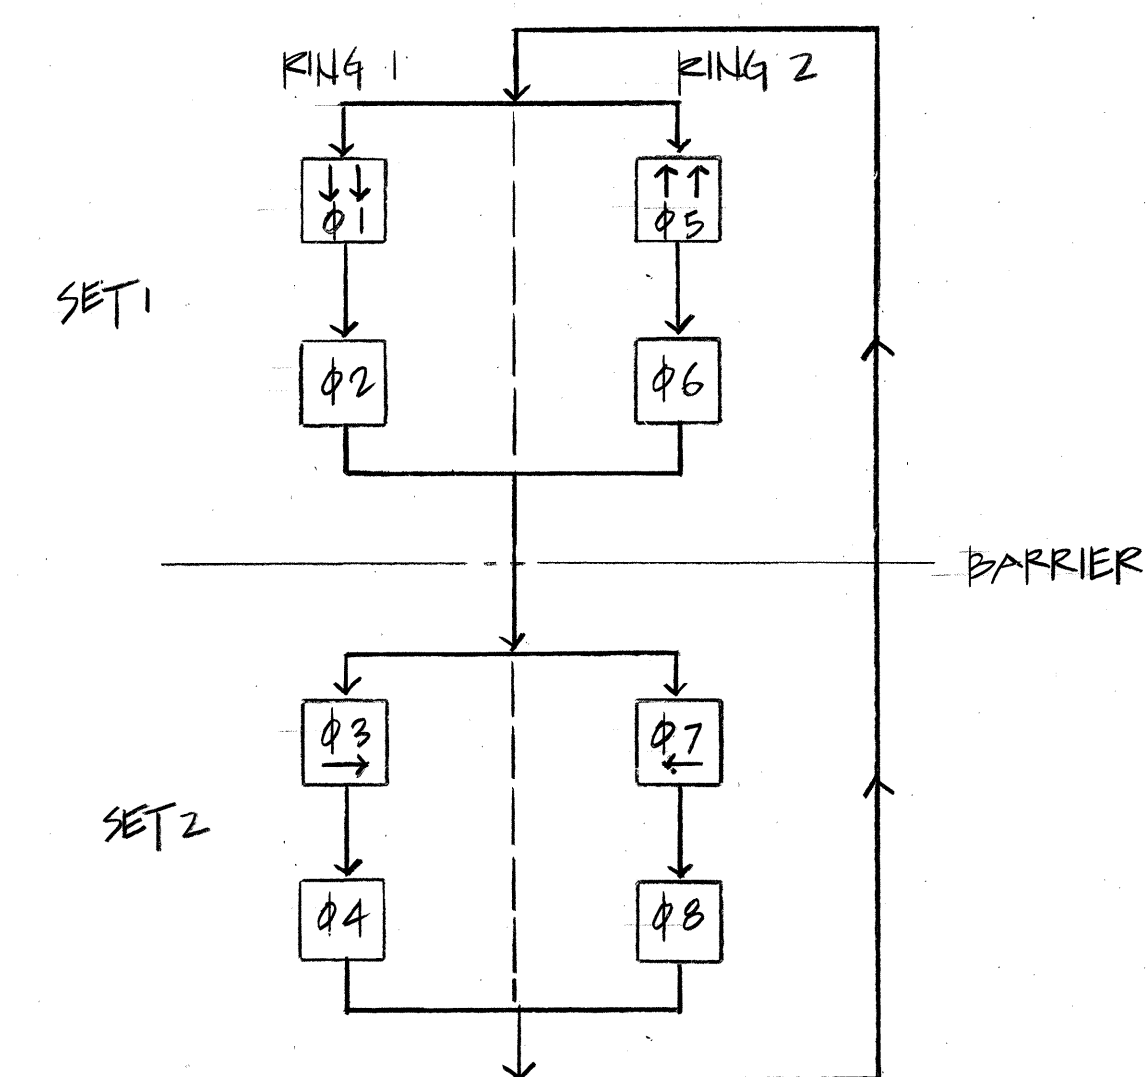
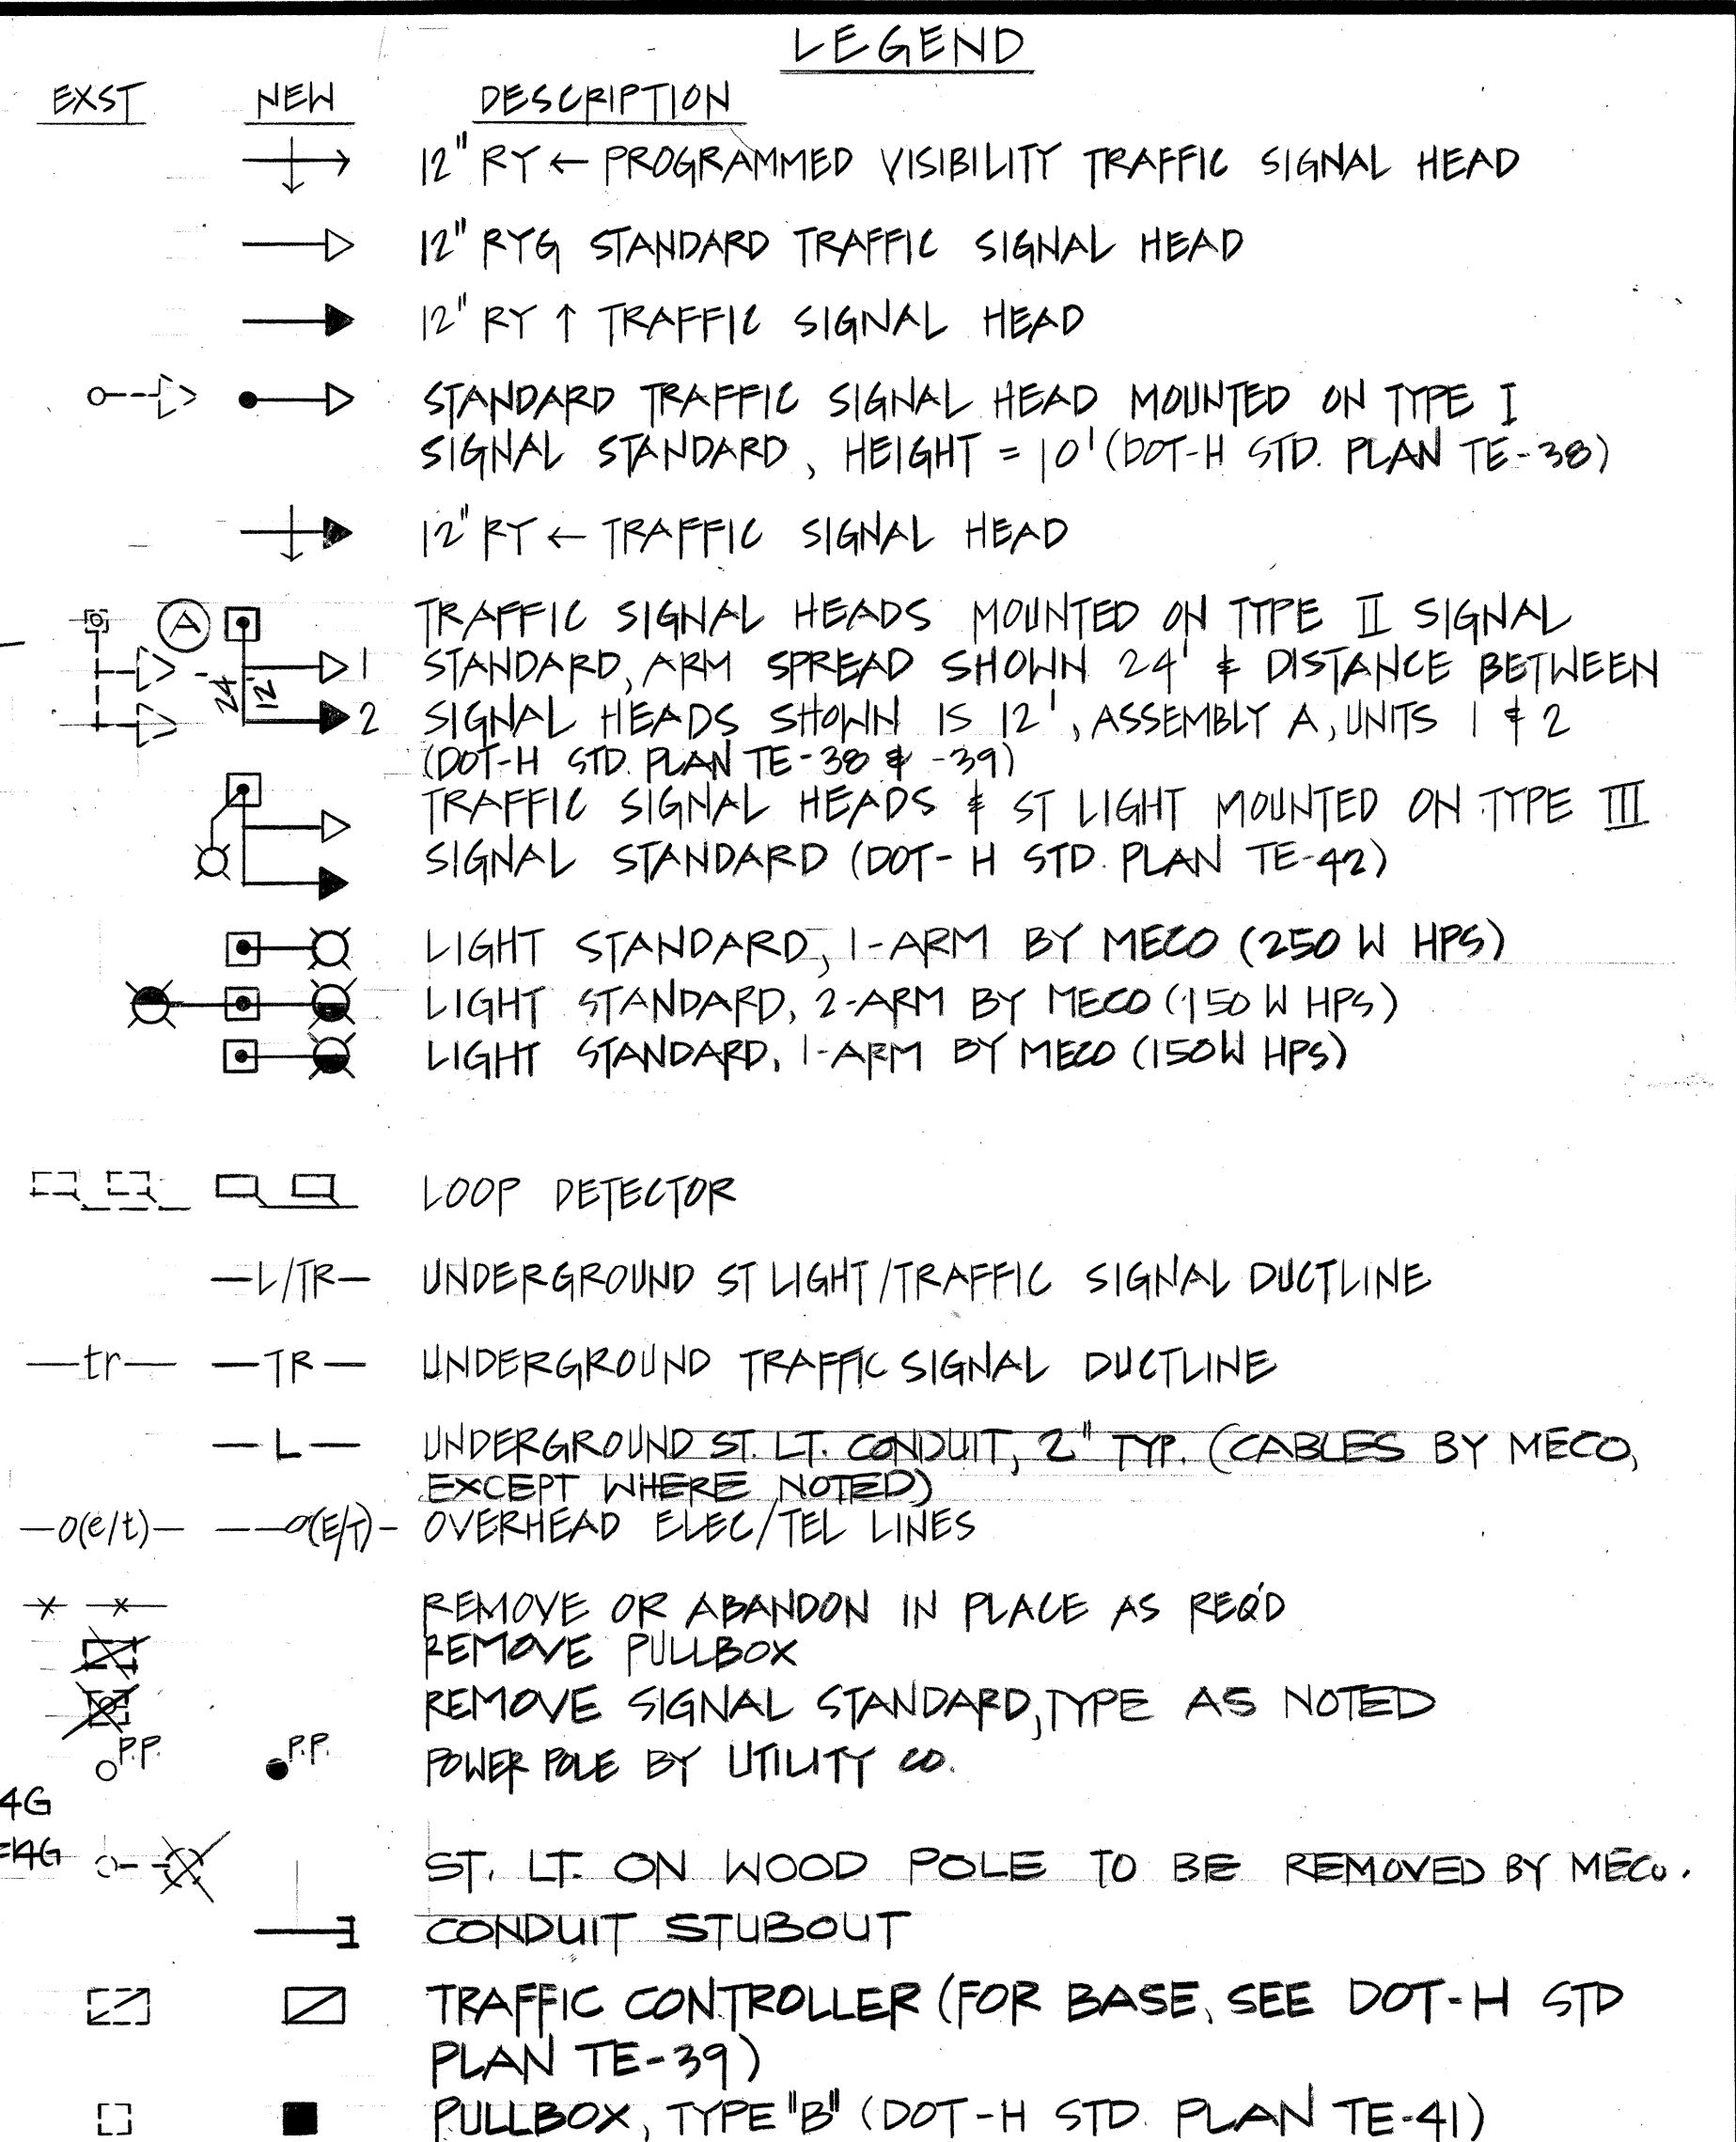


Airports Division
DEPARTMENT OF TRANSPORTATION
STATE OF HAWAII

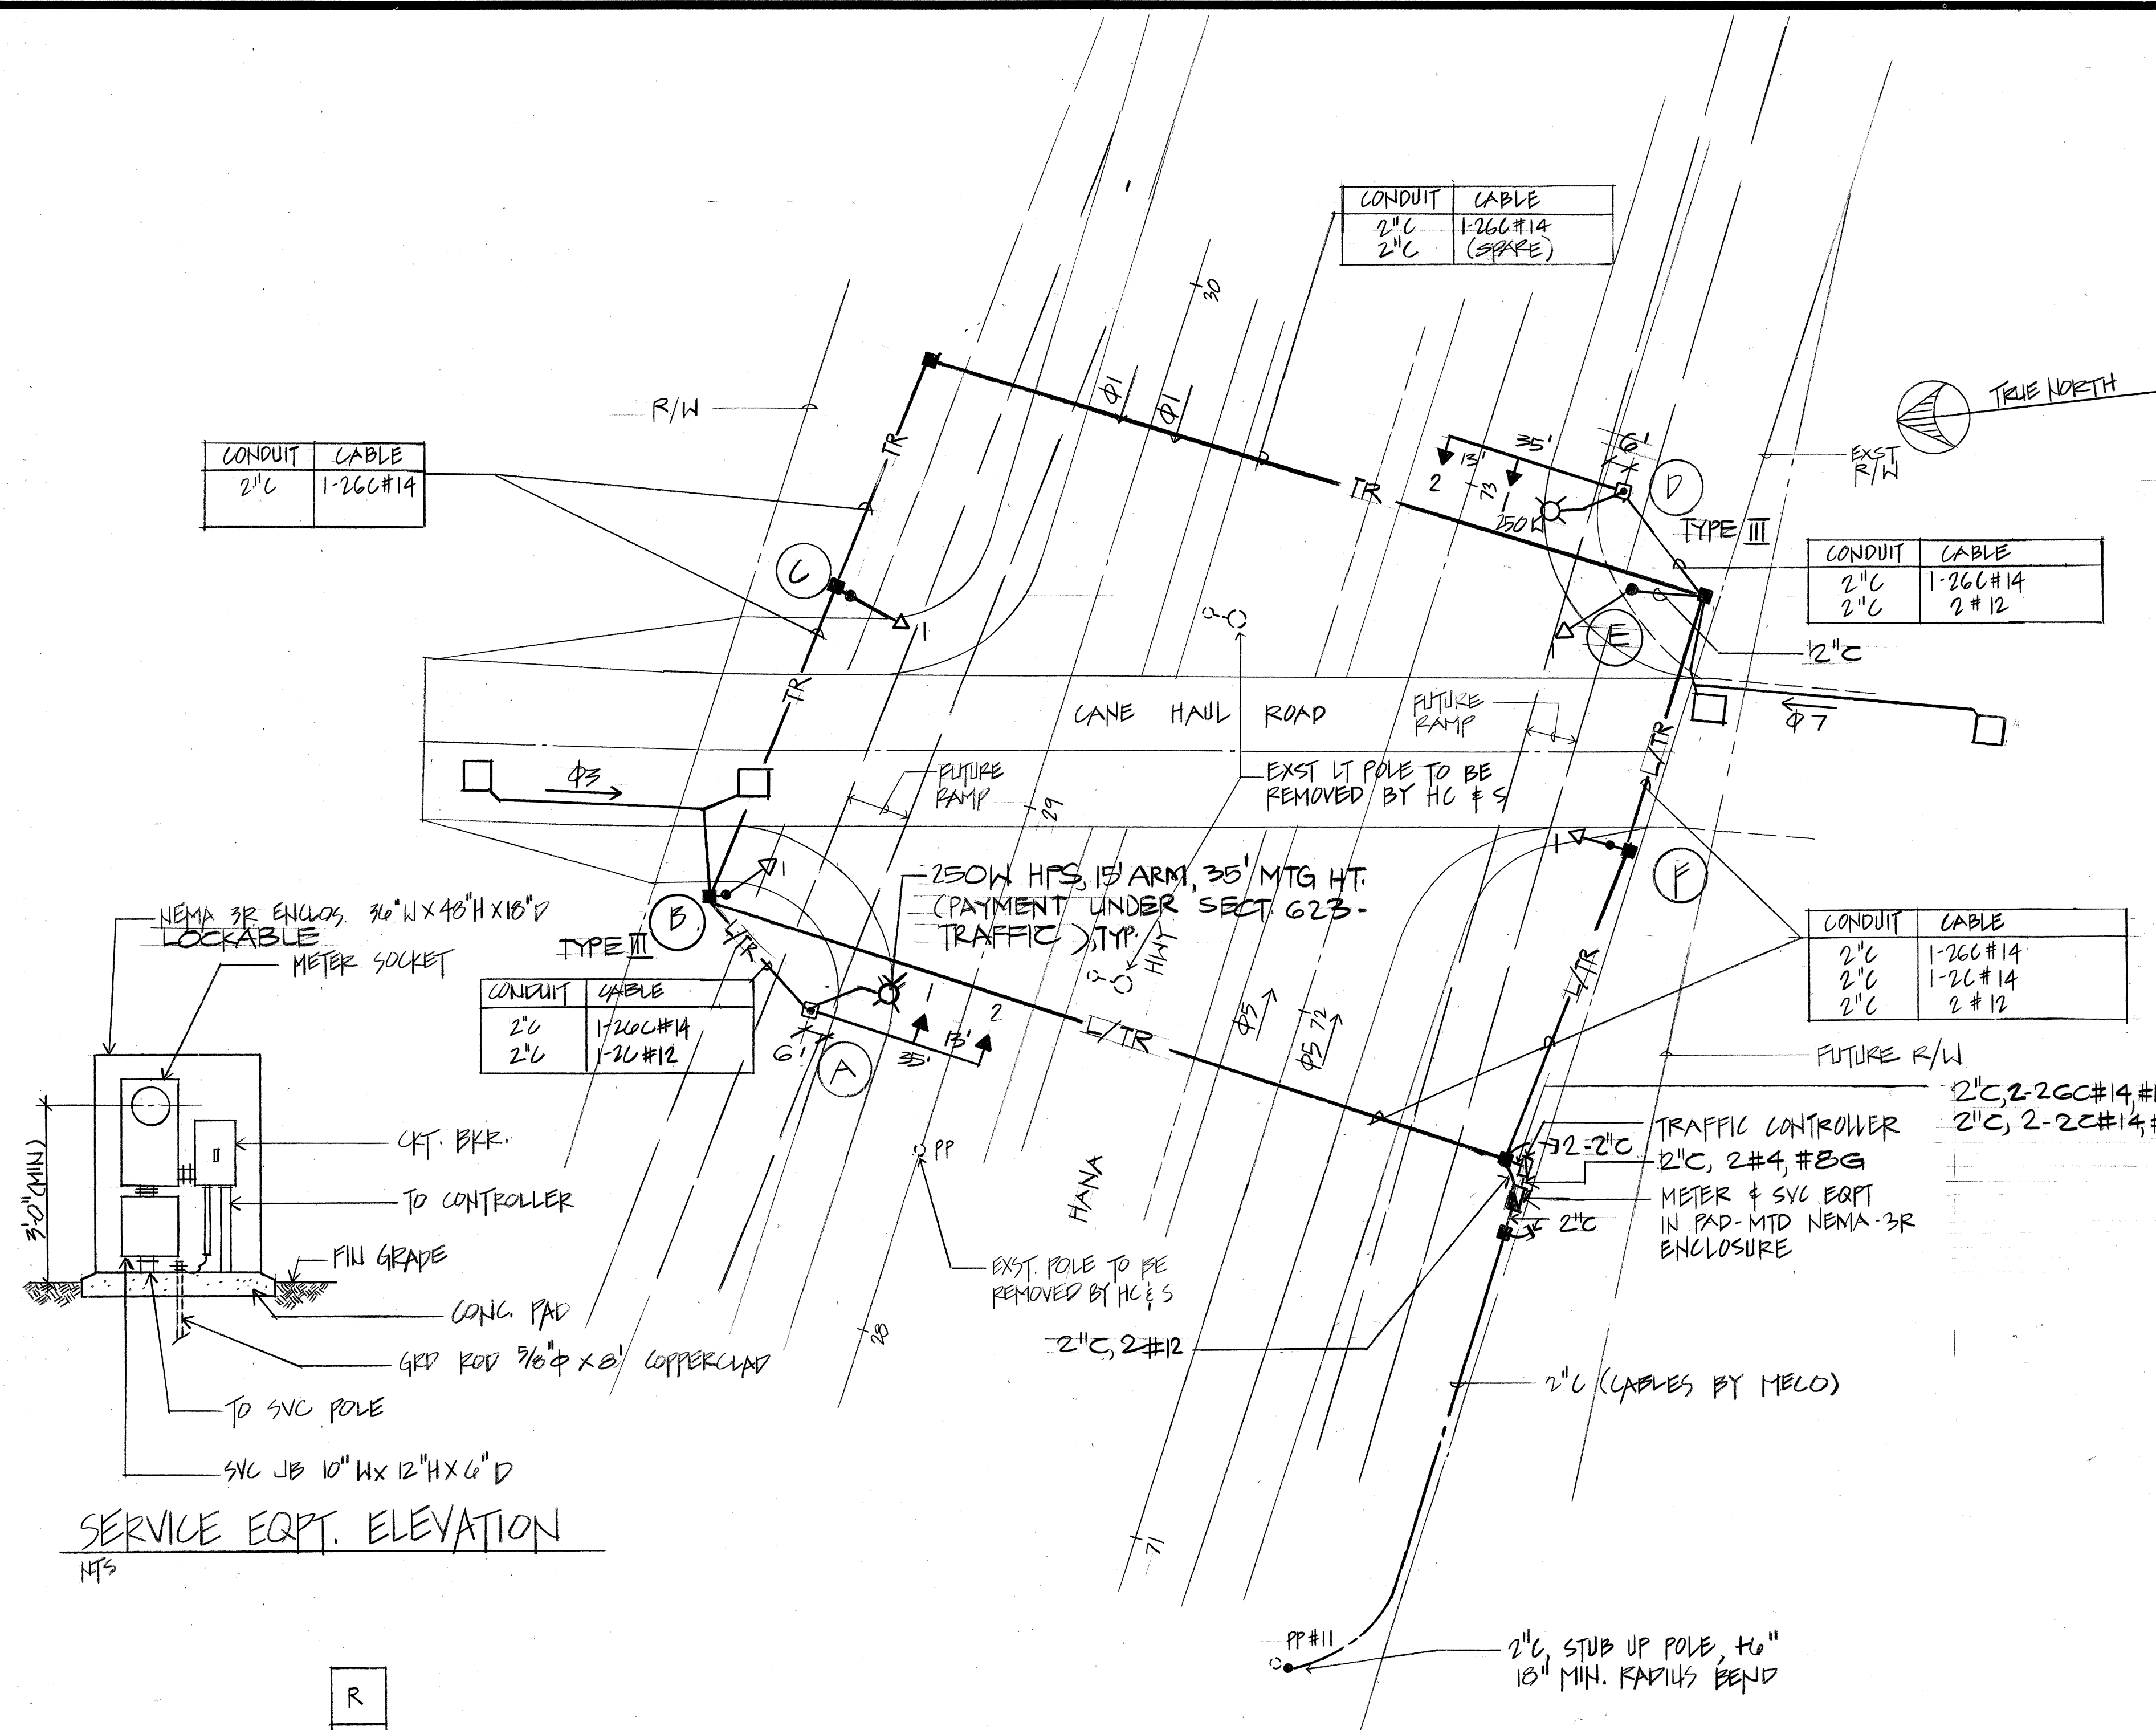

THIS WORK WAS PREPARED
ME OR UNDER MY SUPERVISION

NAKAMURA, OYAMA & ASSOC
CONSULTING ENGINEERS

DSGN.	DRWN.	CHKD.	APPD.
-------	-------	-------	-------

KEY PLAN / NOTES :

NO.	DATE	REVISIONS
-----	------	-----------

PROJECT TITLE :

HANA HIGHWAY IMPROVEMENTS

PROJECT NO. :

STATE NO. AM-1061-2

AIP NO. 3-15-0006-1

SHEET TITLE :

TRAFFIC SIGNAL PLAN

LEGEND

DATE : _____

9-28-80

DWG. NO. :

11