



ML	JS	WN
----	----	----

NO.	DATE	REVISIONS
-----	------	-----------


HANA HIGHWAY IMPROVEMENTS

STATE NO. AM-1061-12
AIP NO. 3-15-0006-11

TRAFFIC SIGNAL PLAN
DUCT SECTION

DWG. NO. :

C.O.E-4

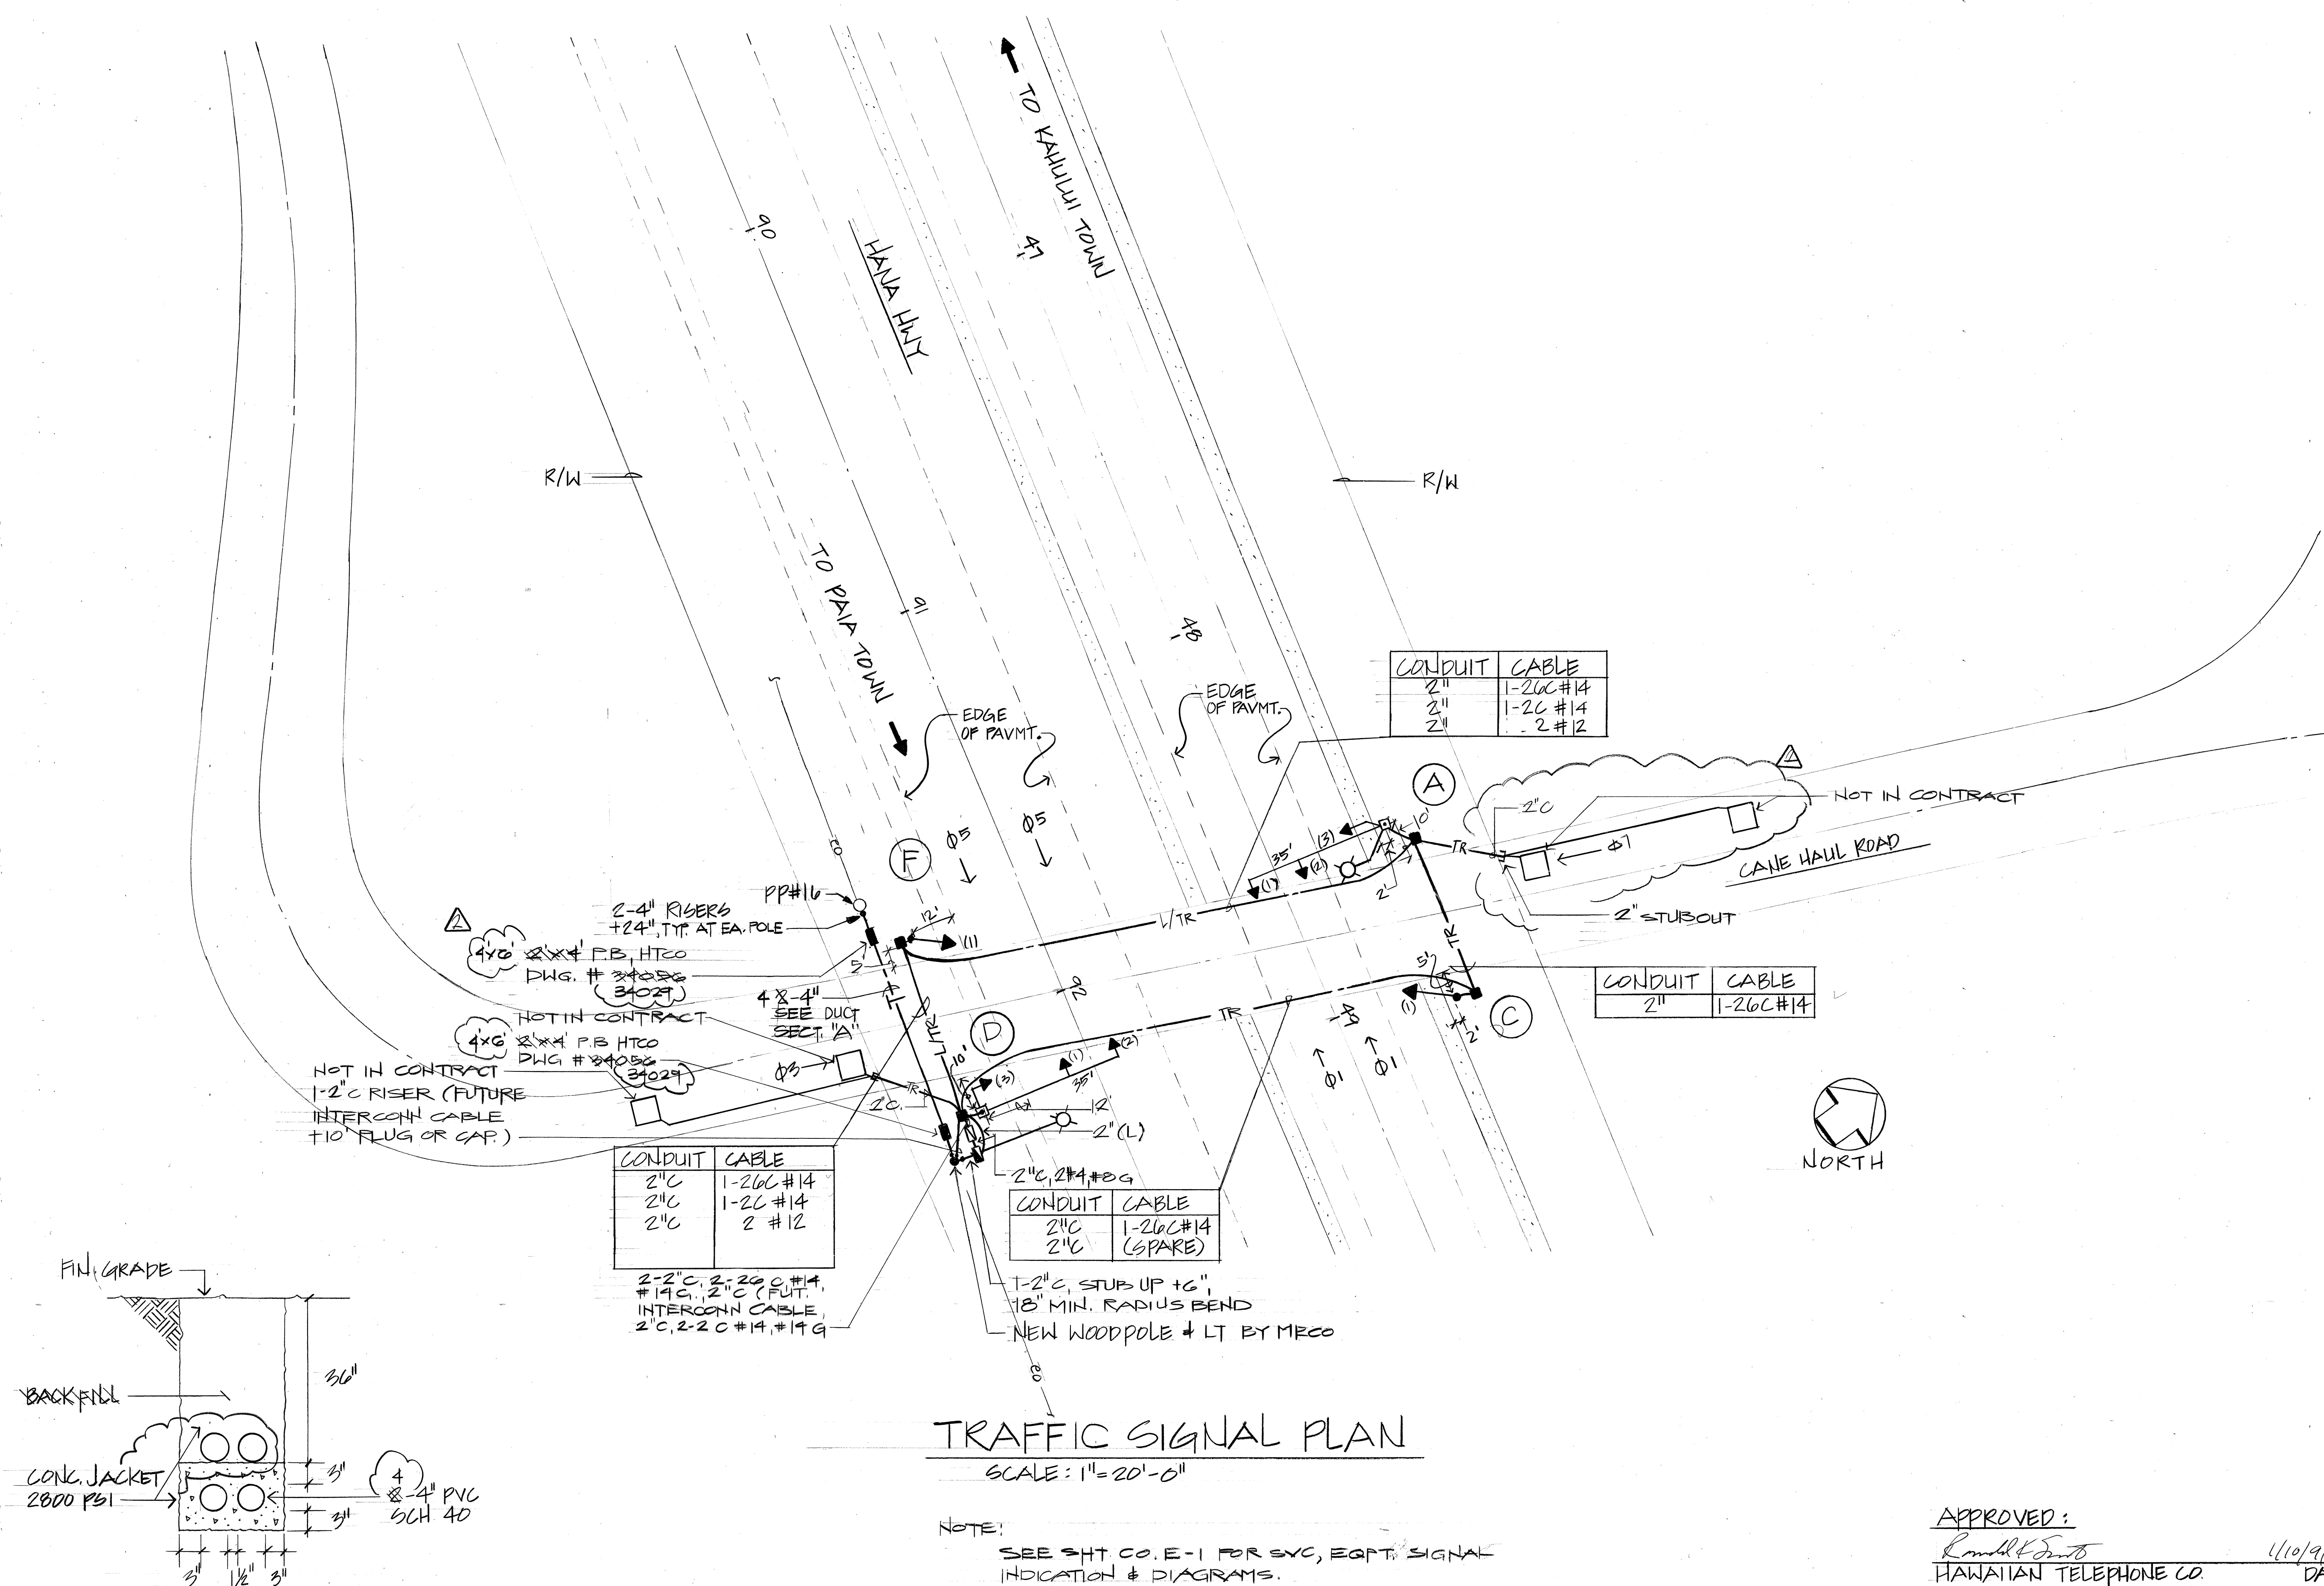

APPROVED: Donald K. Smith 1/10/91
HAWAIIAN TELEPHONE CO. DATE

RECORD DRAWING
DATE 7/12/91