
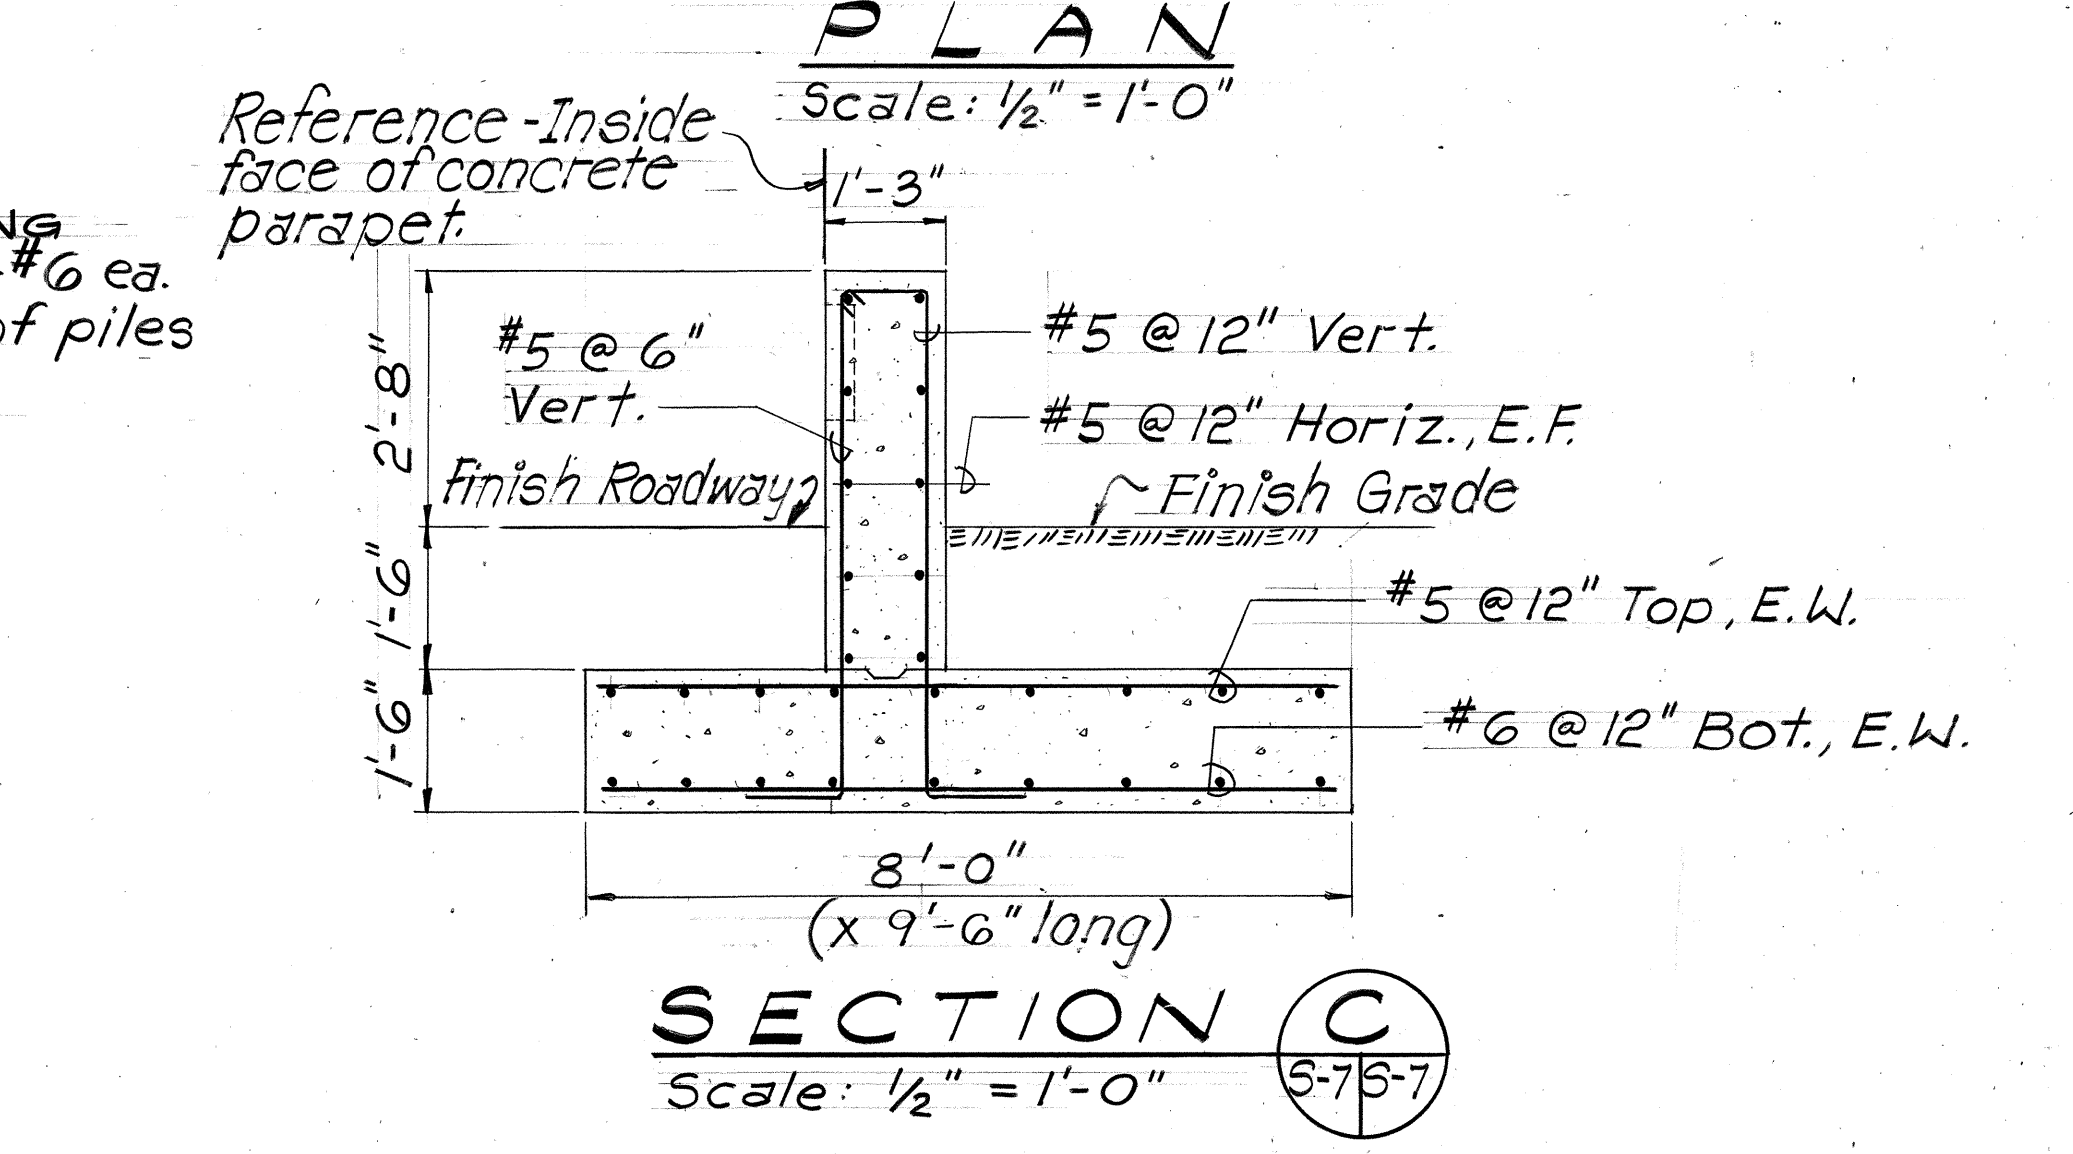
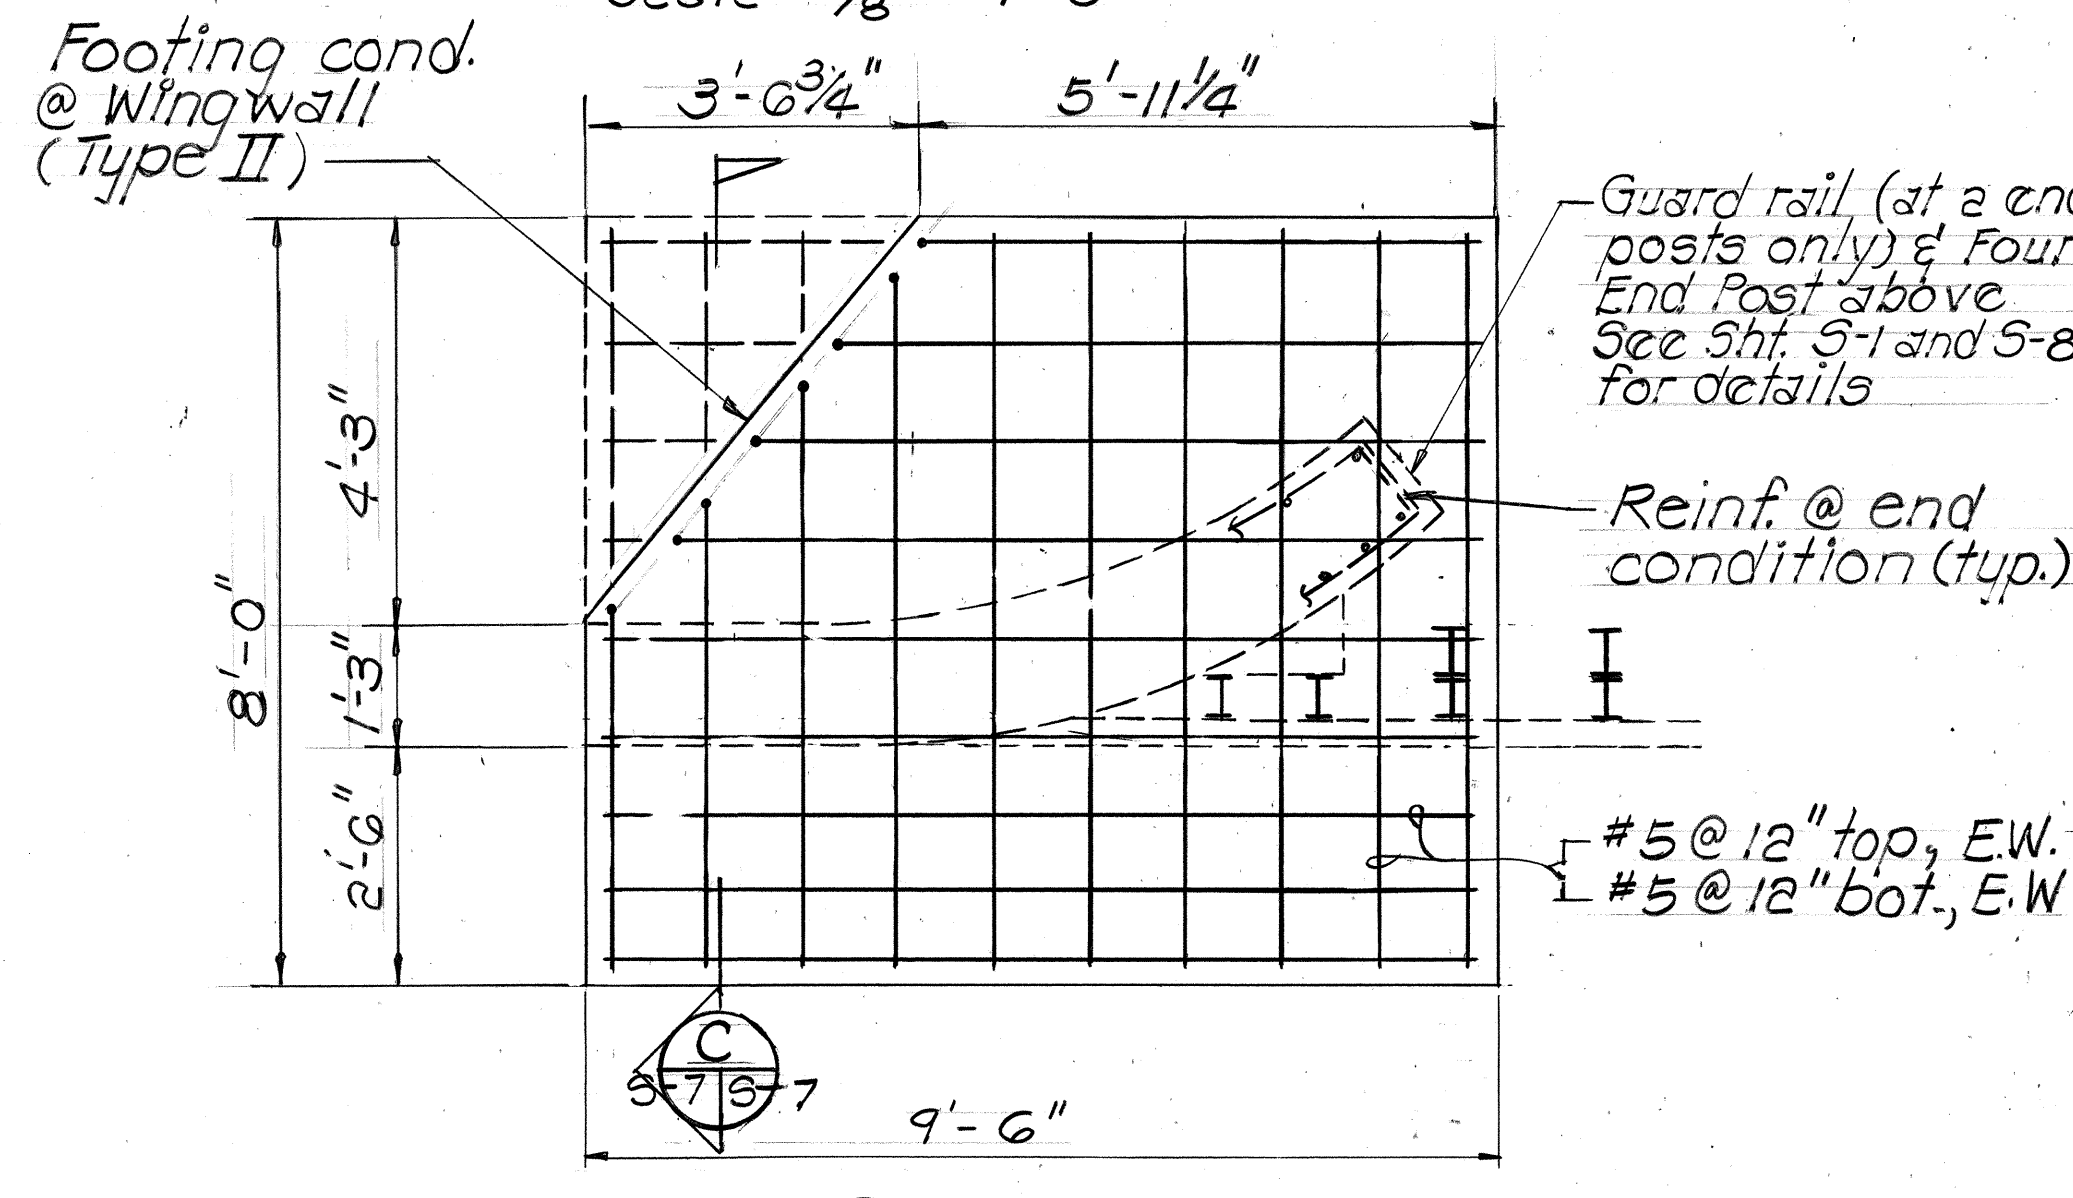
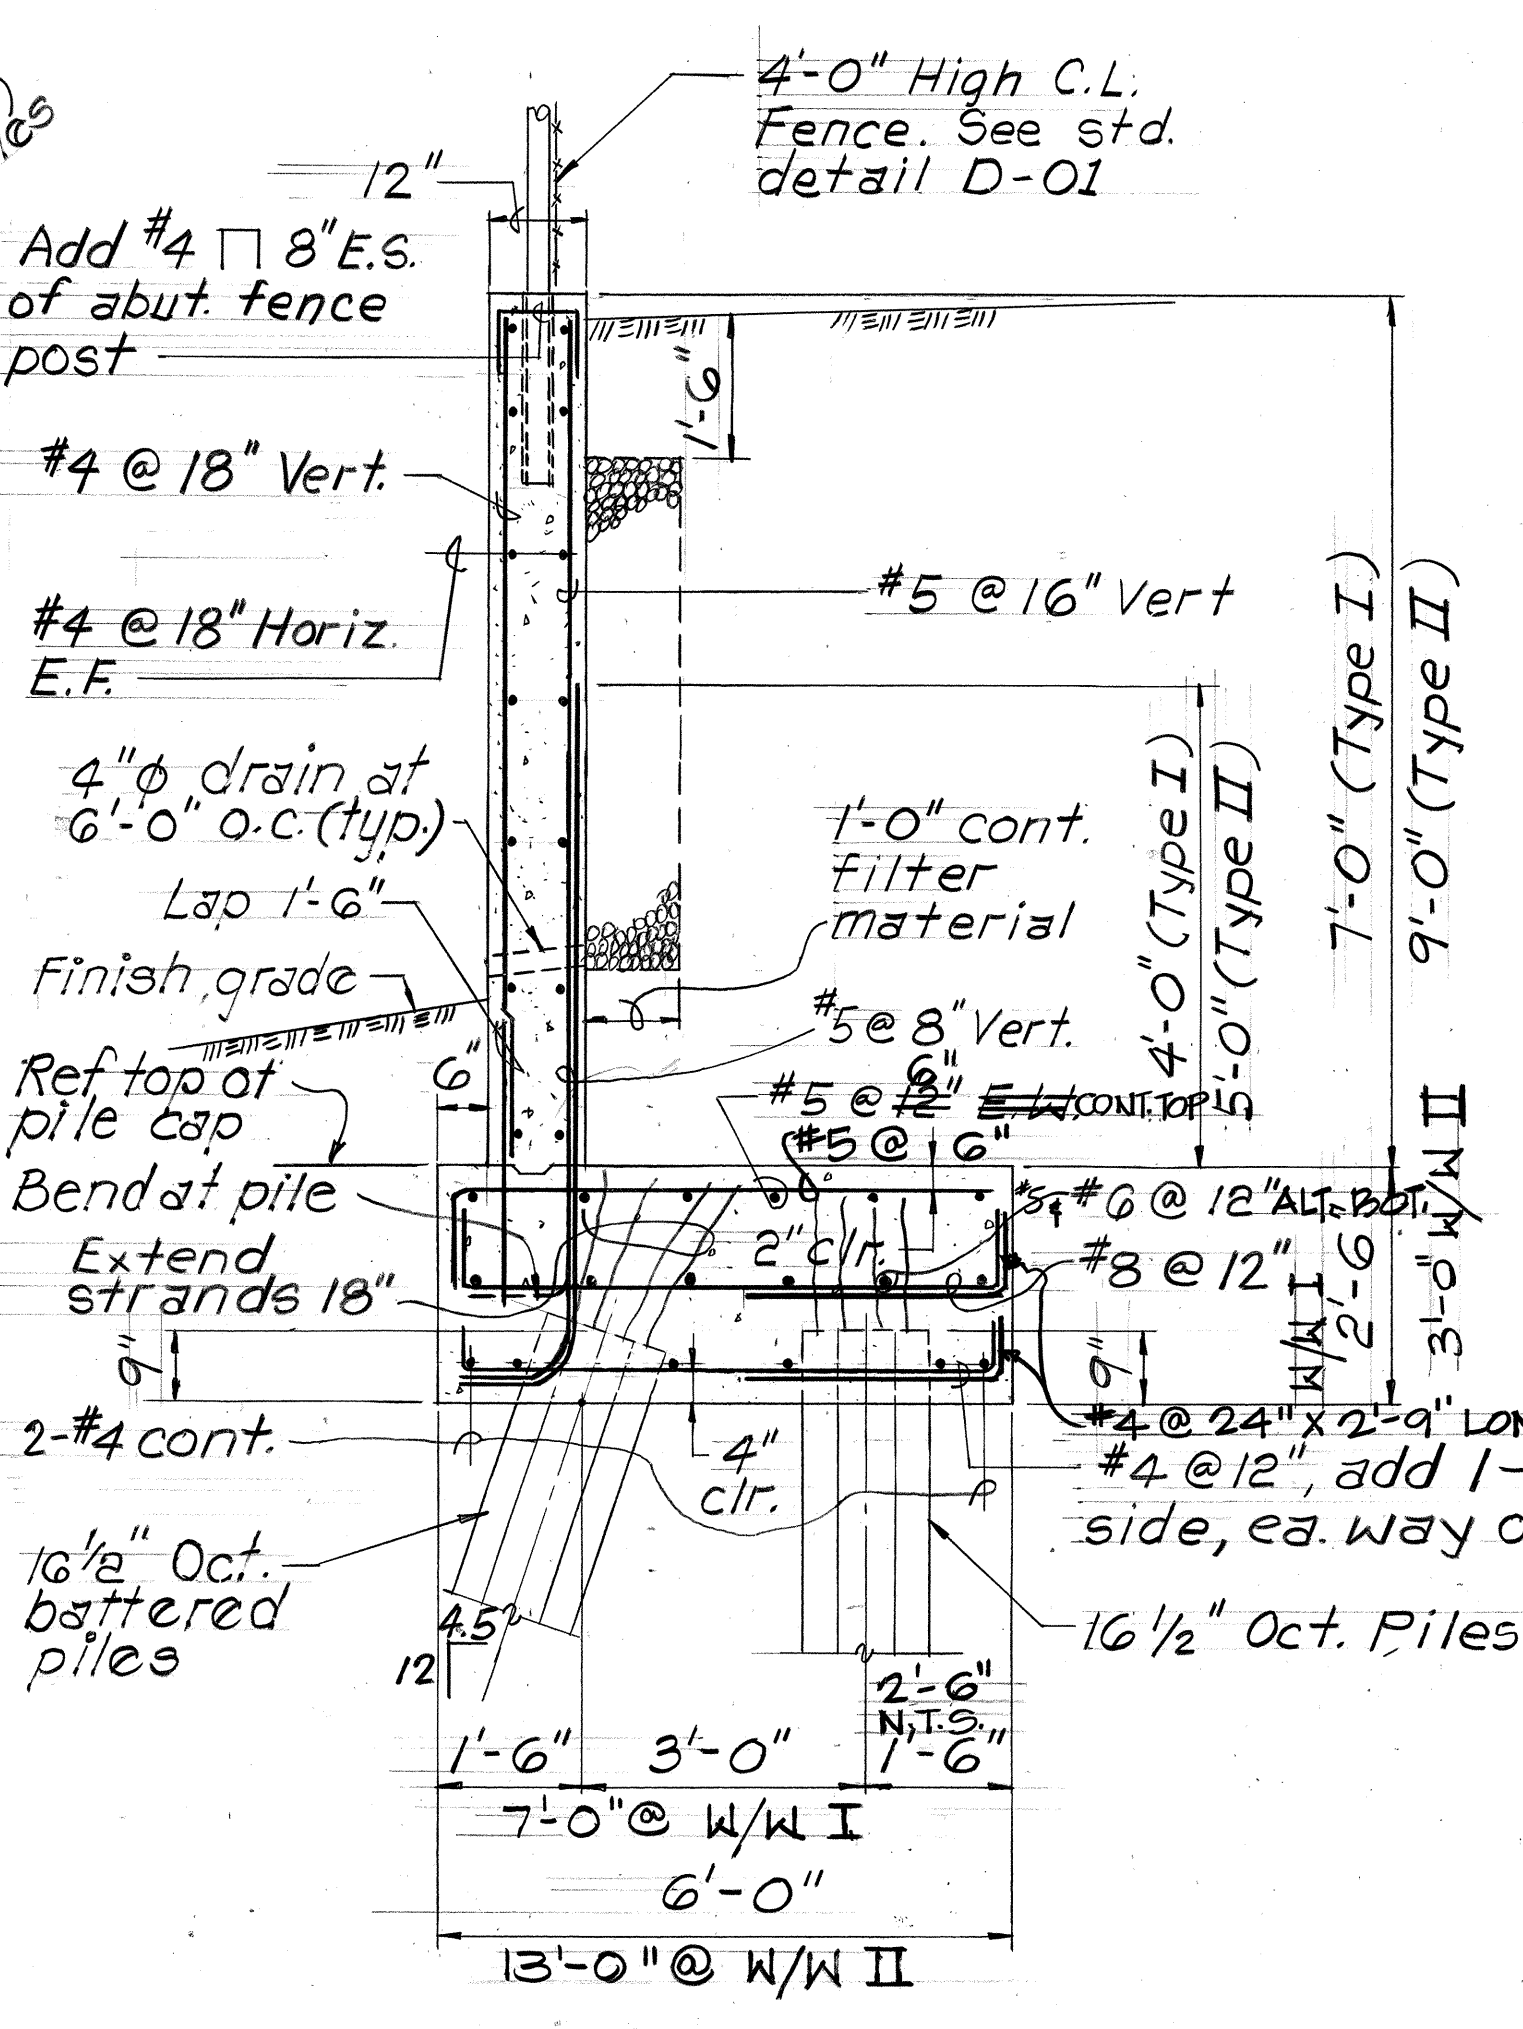
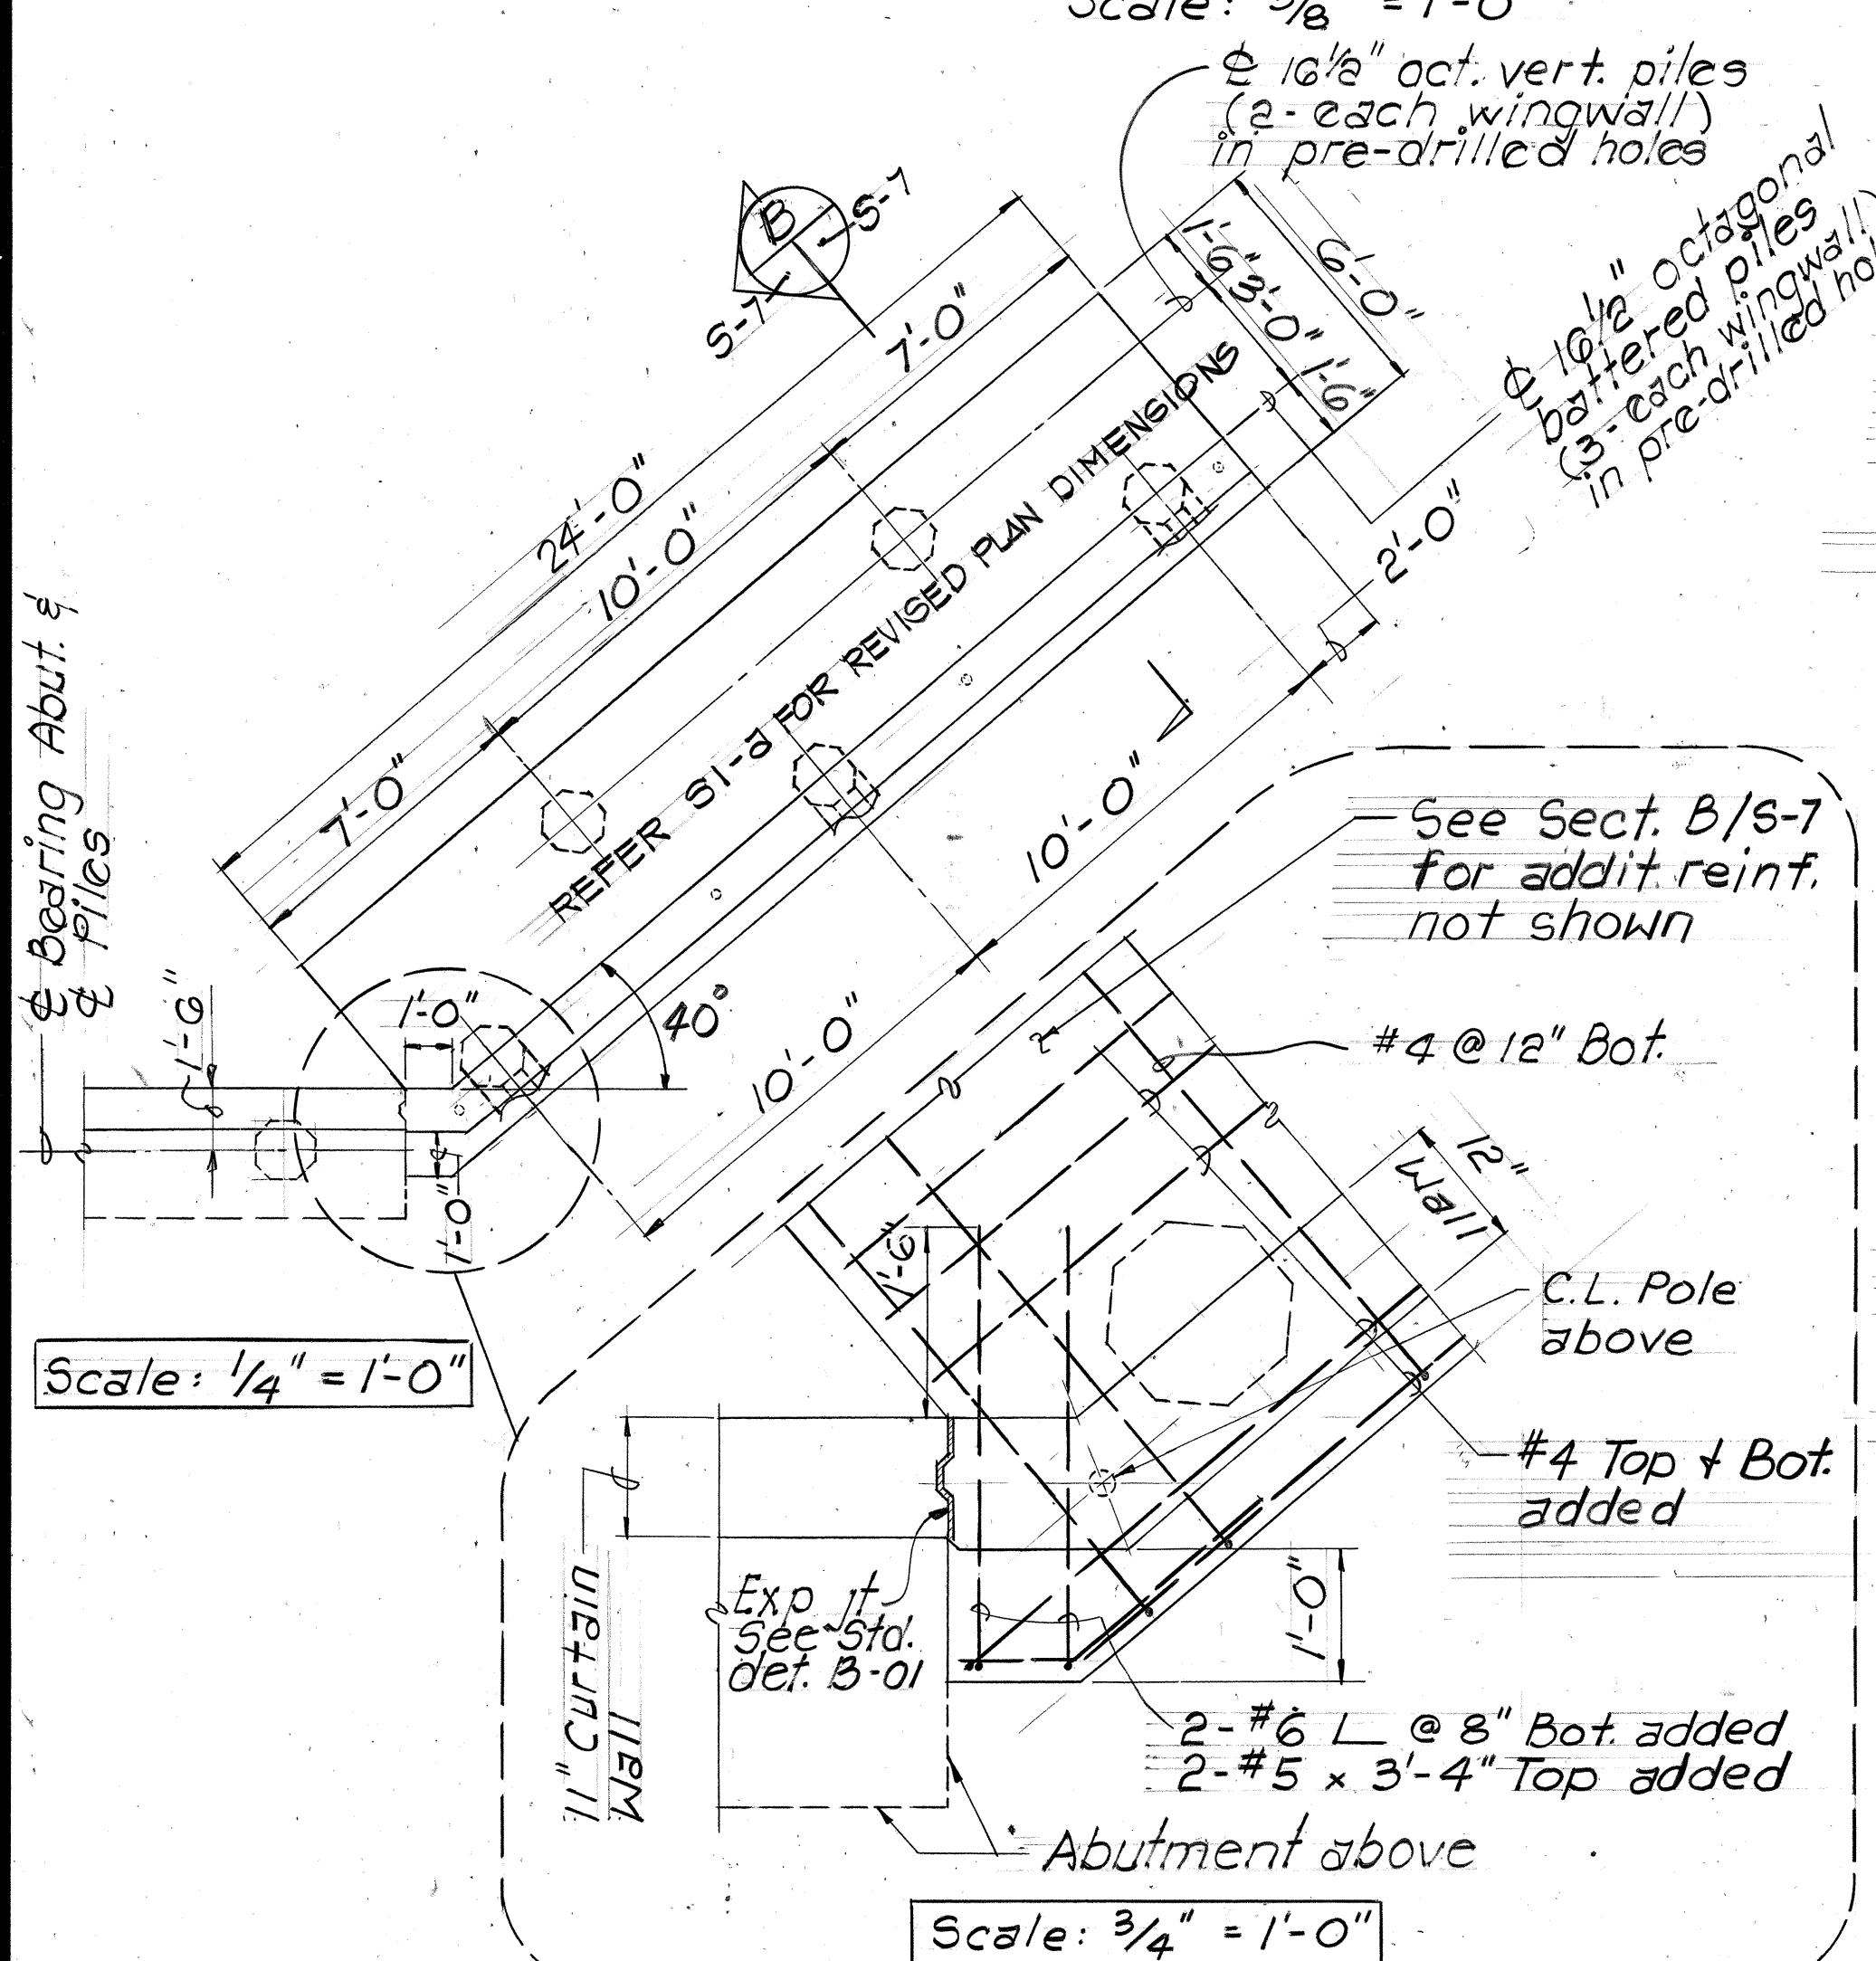
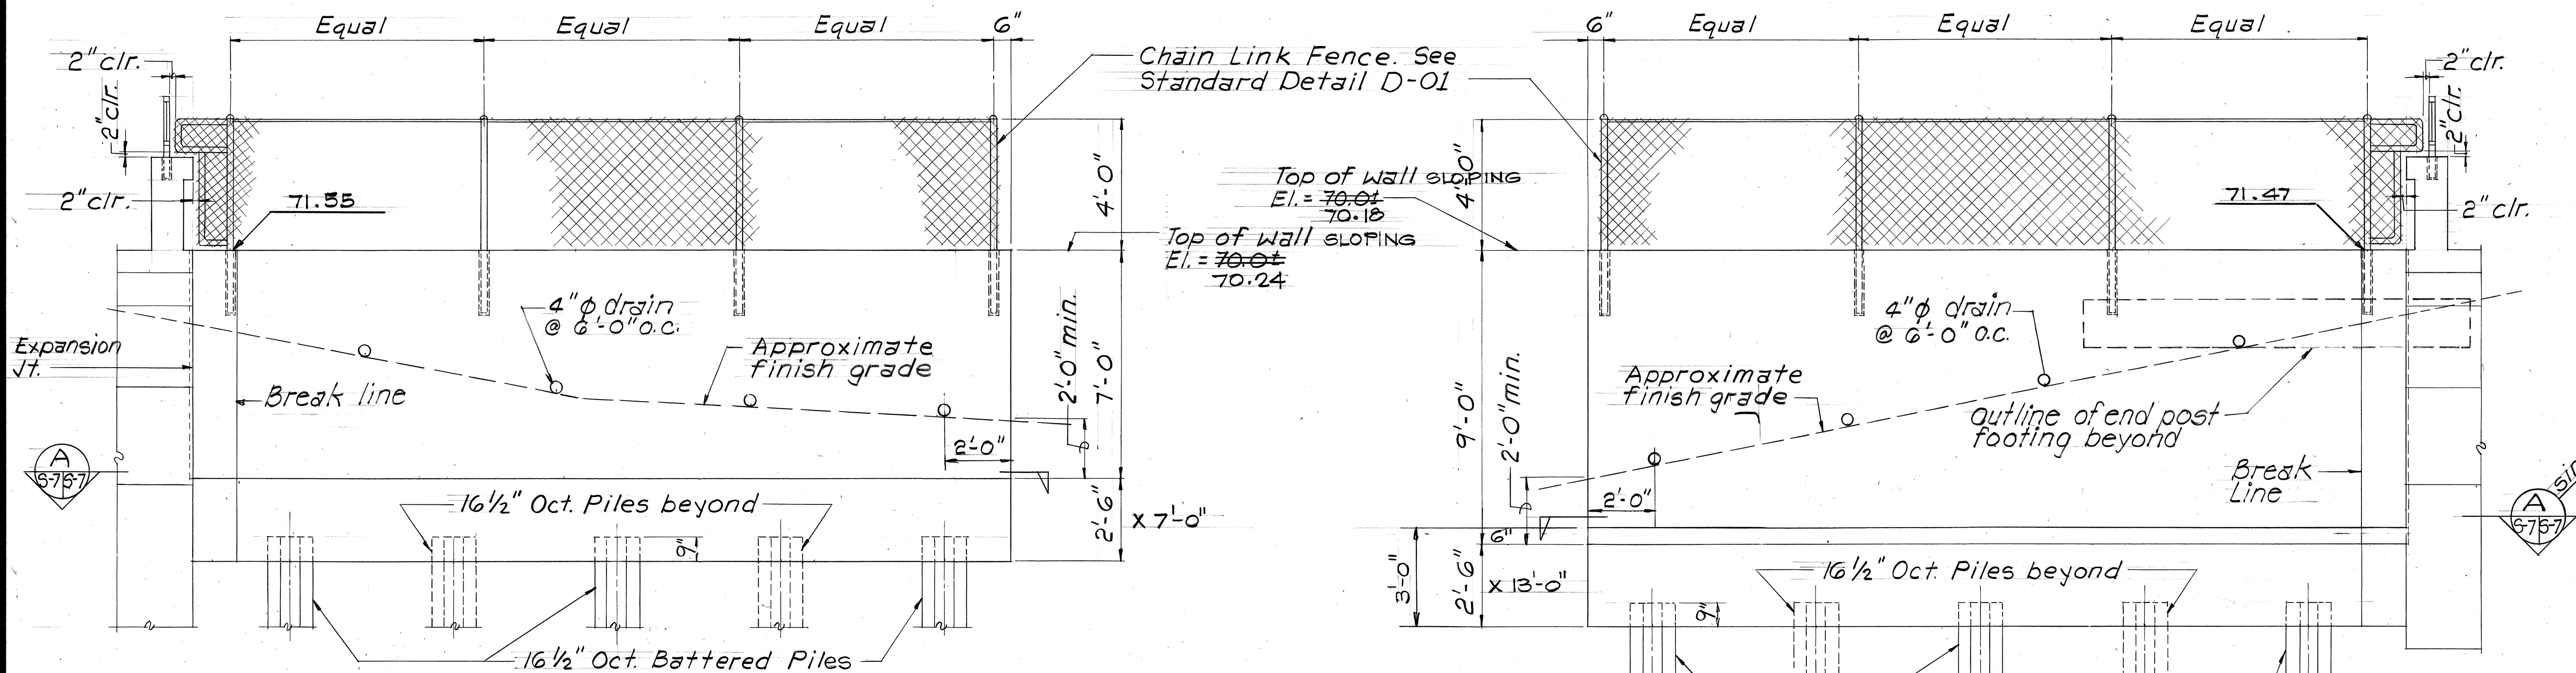


Airports Division
DEPARTMENT OF TRANSPORTATION
STATE OF HAWAII

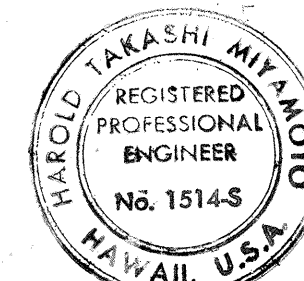

THIS WORK WAS PREPARED BY ME
OR UNDER MY SUPERVISION
Harold Takashi Miyamoto

DSGN. DRWN. CHKD. APPD.

L.S. G.K. V.C. H.T.M.

KEY PLAN / NOTES :

NO. DATE REVISIONS

RECORD DRAWINGS

This record drawing has been prepared, in part, based upon information furnished by others. The Engineer is thus not responsible for the accuracy of this record drawing or for any errors or omissions which may have been incorporated into it as a result.

Date: July 12, 1991

PROJECT TITLE :

HANA HIGHWAY
IMPROVEMENTS

PROJECT NO. :

STATE PROJ. NO. AM-1061-12
AIP PROJ. NO. 3-15-0006-11

SHEET TITLE :

WINGWALL ELEV.
AND DETAILS

DATE :

10-3-89

DWG. NO. :

5-7