

STATE OF HAWAII

DEPARTMENT OF TRANSPORTATION

HIGHWAYS DIVISION HONOLULU, HAWAII

"AS-BUILT" PLANS FOR


HANA HIGHWAY GUARDRAIL AND SHOULDER IMPROVEMENTS

HOOKIPA PARK TO VICINITY OF VALLEY ISLE MEMORIAL PARK

FED. AID PROJECT NO. STP-036-1(7)

FEDERAL-AID PROJECT NO. STP-036-1(7)

DISTRICT OF MAKAWAO
ISLAND OF MAUI

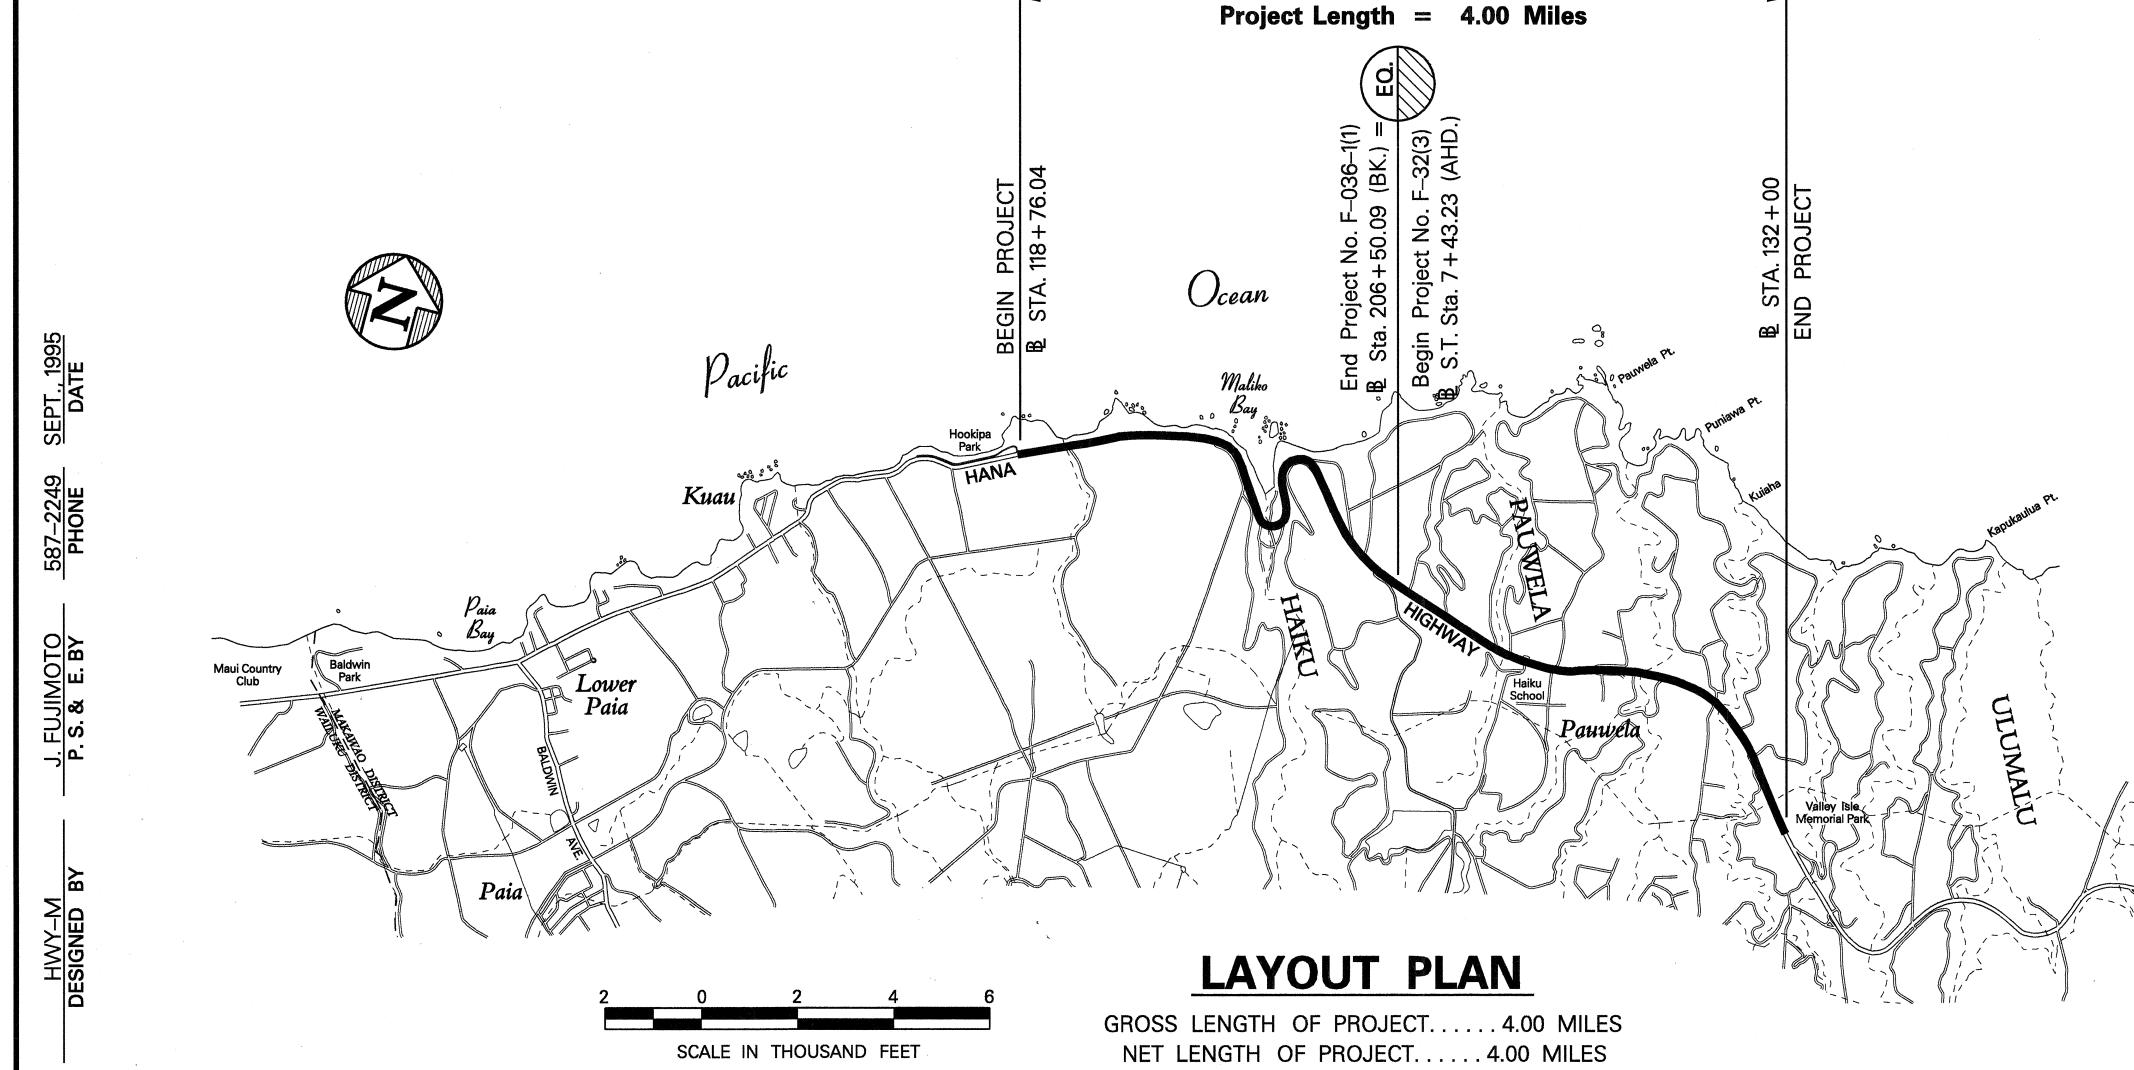

PARK

Regidua

Regidu

FED. ROAD DIST. NO. FED. AID PROJ. NO.

HAW. STP-036-1(7)

FISCAL SHEET YEAR NO.

SHEETS

32

FEDERAL AID PROJECTS PREVIOUSLY CONSTRUCTED OR UNDER CONSTRUCTION

MILE POST 8.93 ± TO MILE POST 12.93 ±

DESIGN DESIGNATION

ADT	(1995)		8,400
ADT	(2005)		10,400
DHV			1,000
D			65/35
T ₂₄			4.3 %
V		, .	50 M.P.

CHANGES MADE DURING CONSTRUCTION HAVE BEEN INCORPORATED ON THESE PLANS EXCEPT CHANGES IN THE ORIGINAL THEORETICAL QUANTITIES, FOR ACTUAL QUANTITIES, REFER TO PROJECT LEDGER AND/OR COMPUTATION BOOK.

MALL ACIES STRUCTS ACOLO	
Wha K aducho	3/25/99
RESIDENT ENGINEER	DATE

DEPARTMENT OF TRANSPORTATION STATE OF HAWAII APPROVED:

DIR. OF TRANSPORTATION DATE