


FED. ROAD DIST. NO.	STATE	PROJ. NO.	FISCAL YEAR	SHEET NO.	TOTAL SHEETS
HAWAII	HAW.	36A-01-96M	1996	6	13

CURVE DATA			
	1	2	3
Δ	63°25'00"	63°25'00"	7°29'20"
R	282.73'	296.81'	1912.57'
T	174.67'	183.37'	125.17'
L	312.93'	328.52'	249.98'
C	297.20'	312.00'	249.81'

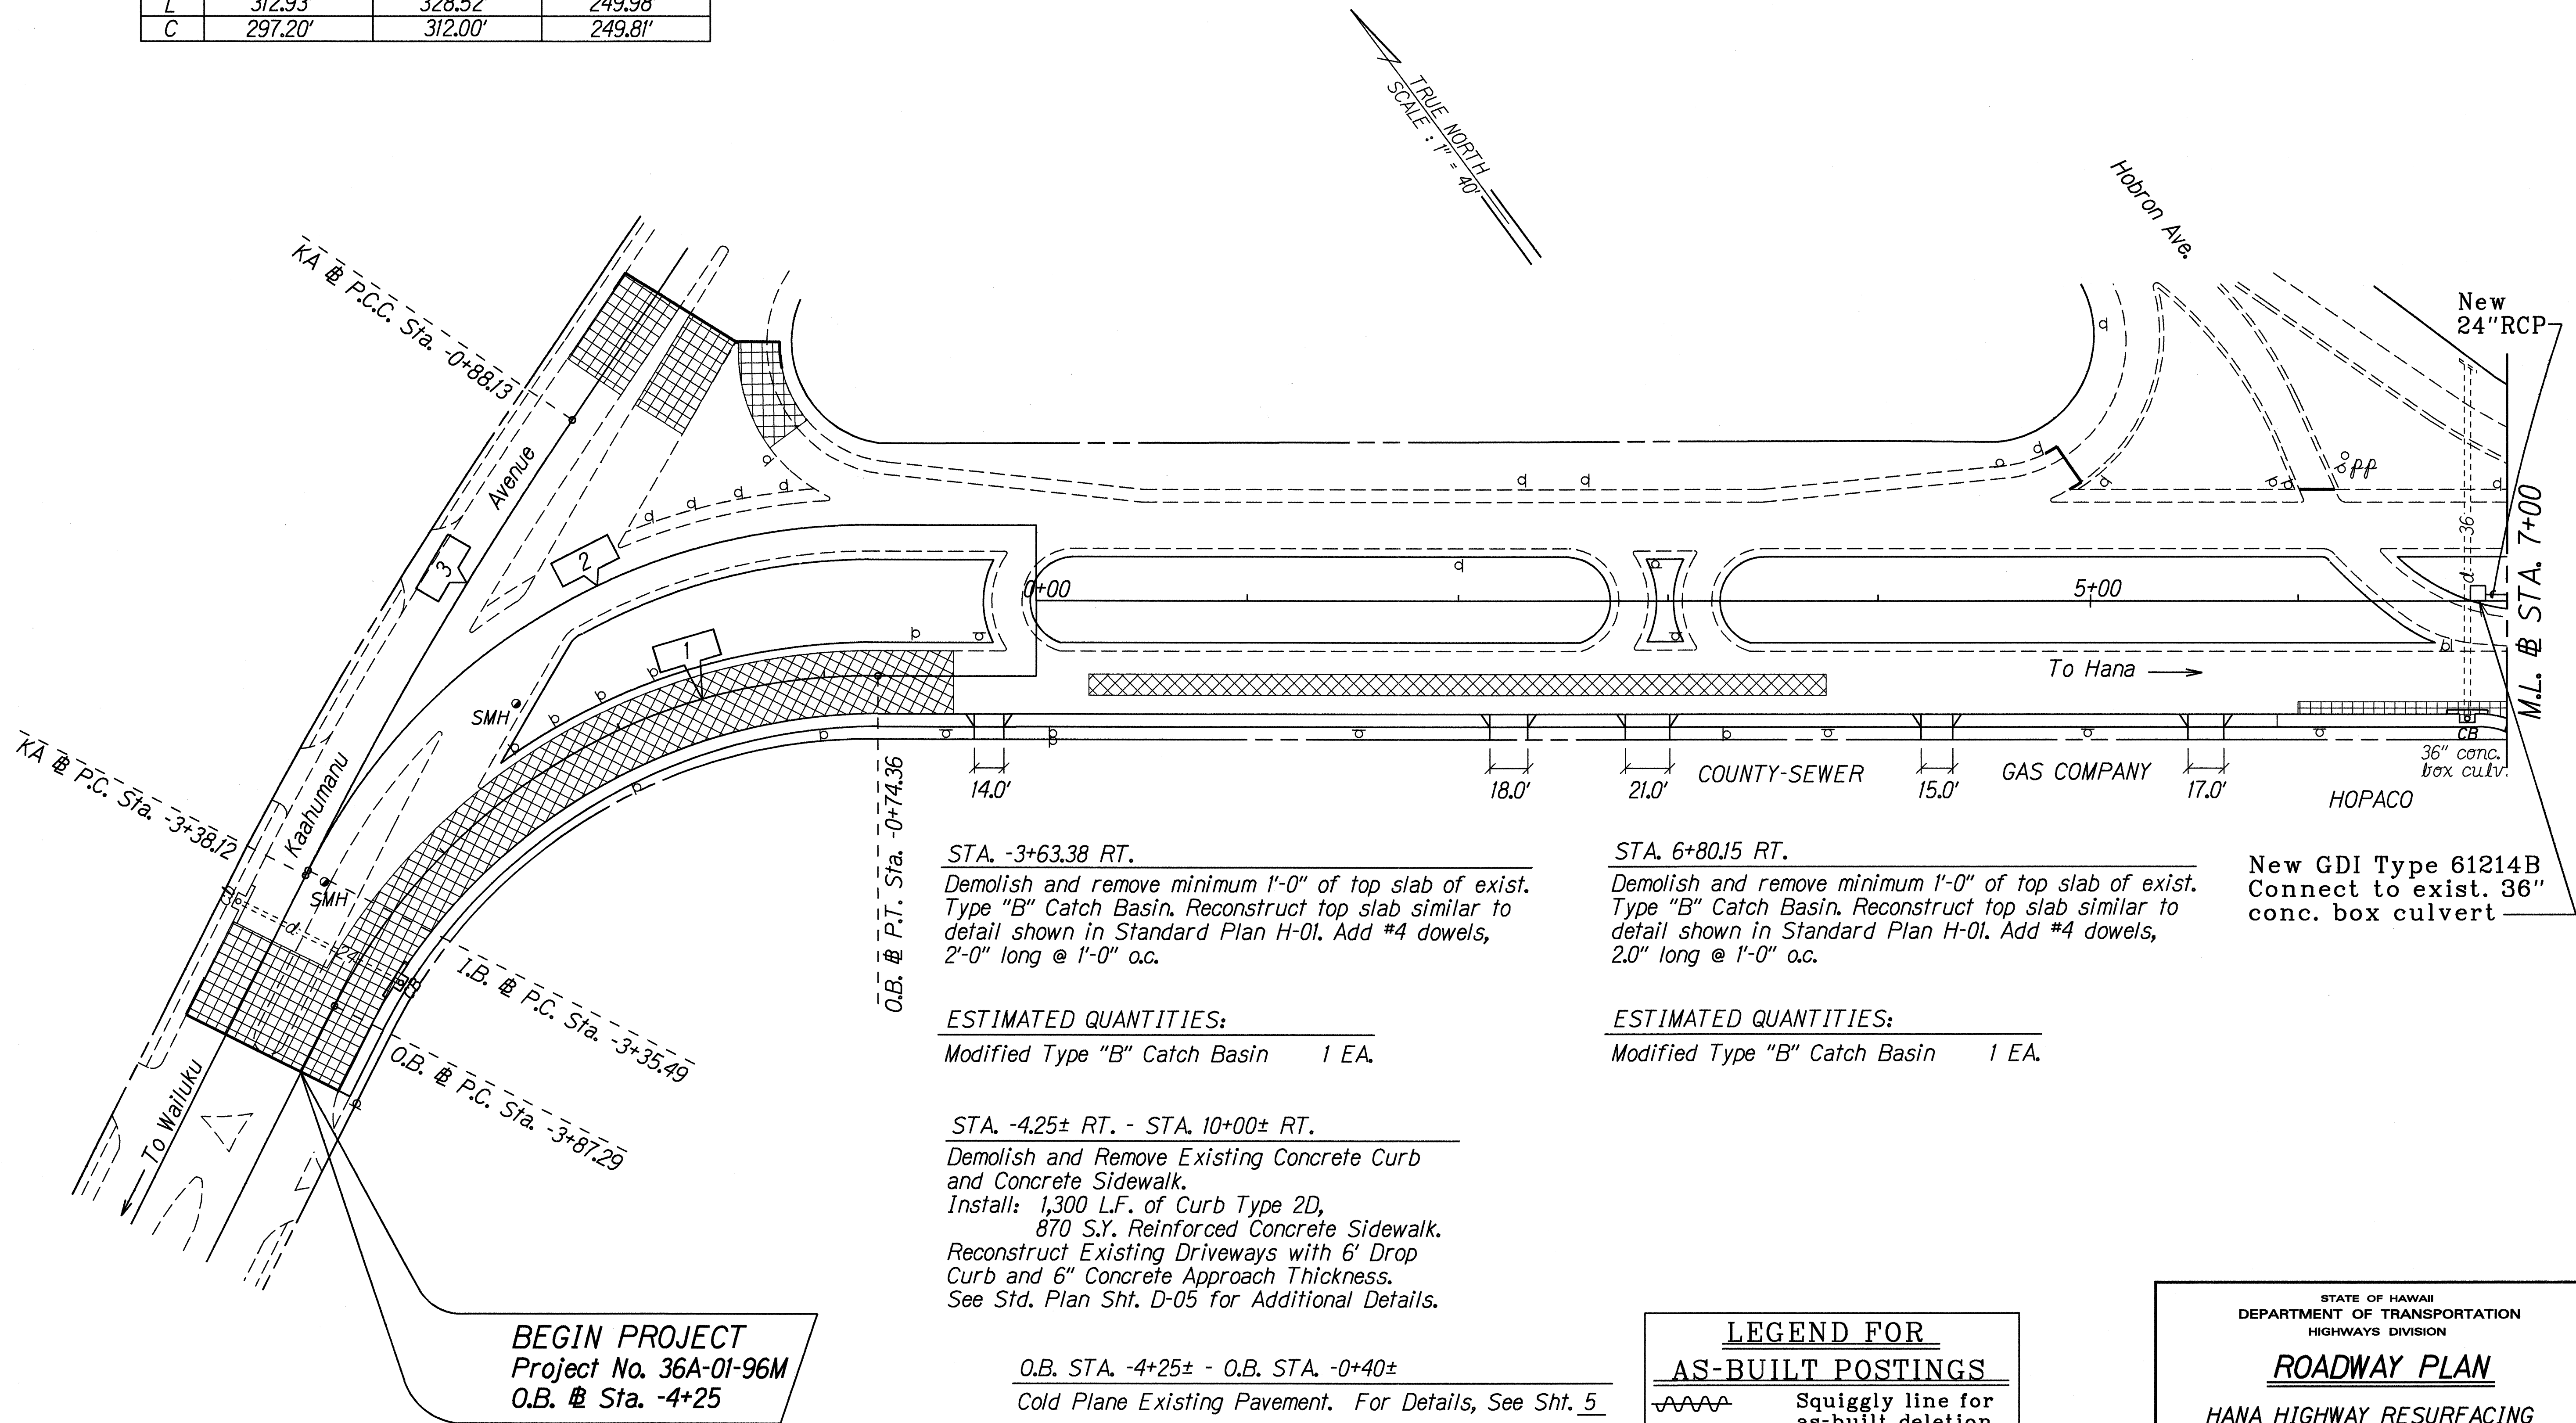

ORIGINAL PLAN	SURVEY PLOTTED BY	DATE
NOTED	DRAWN BY	5-24-96
DESIGNED BY	CHECKED BY	
DESIGNED BY	CHECKED BY	

LEGEND FOR AS-BUILT POSTINGS	
	Squiggly line for as-built deletion
	Double line for as-built deletion
Roadway	Text for as-built posting

STATE OF HAWAII
DEPARTMENT OF TRANSPORTATION
HIGHWAYS DIVISION


ROADWAY PLAN

HANA HIGHWAY RESURFACING
Kaahumanu Avenue to Dairy Road
Project No. 36A-01-96M

Scale: 1" = 40' Date: May 1996



SHEET No. 1 OF 3 SHEETS

FED. ROAD DIST. NO.	STATE	PROJ. NO.	FISCAL YEAR	SHEET NO.	TOTAL SHEETS
HAWAII	HAW.	36A-01-96M	1996	7	13

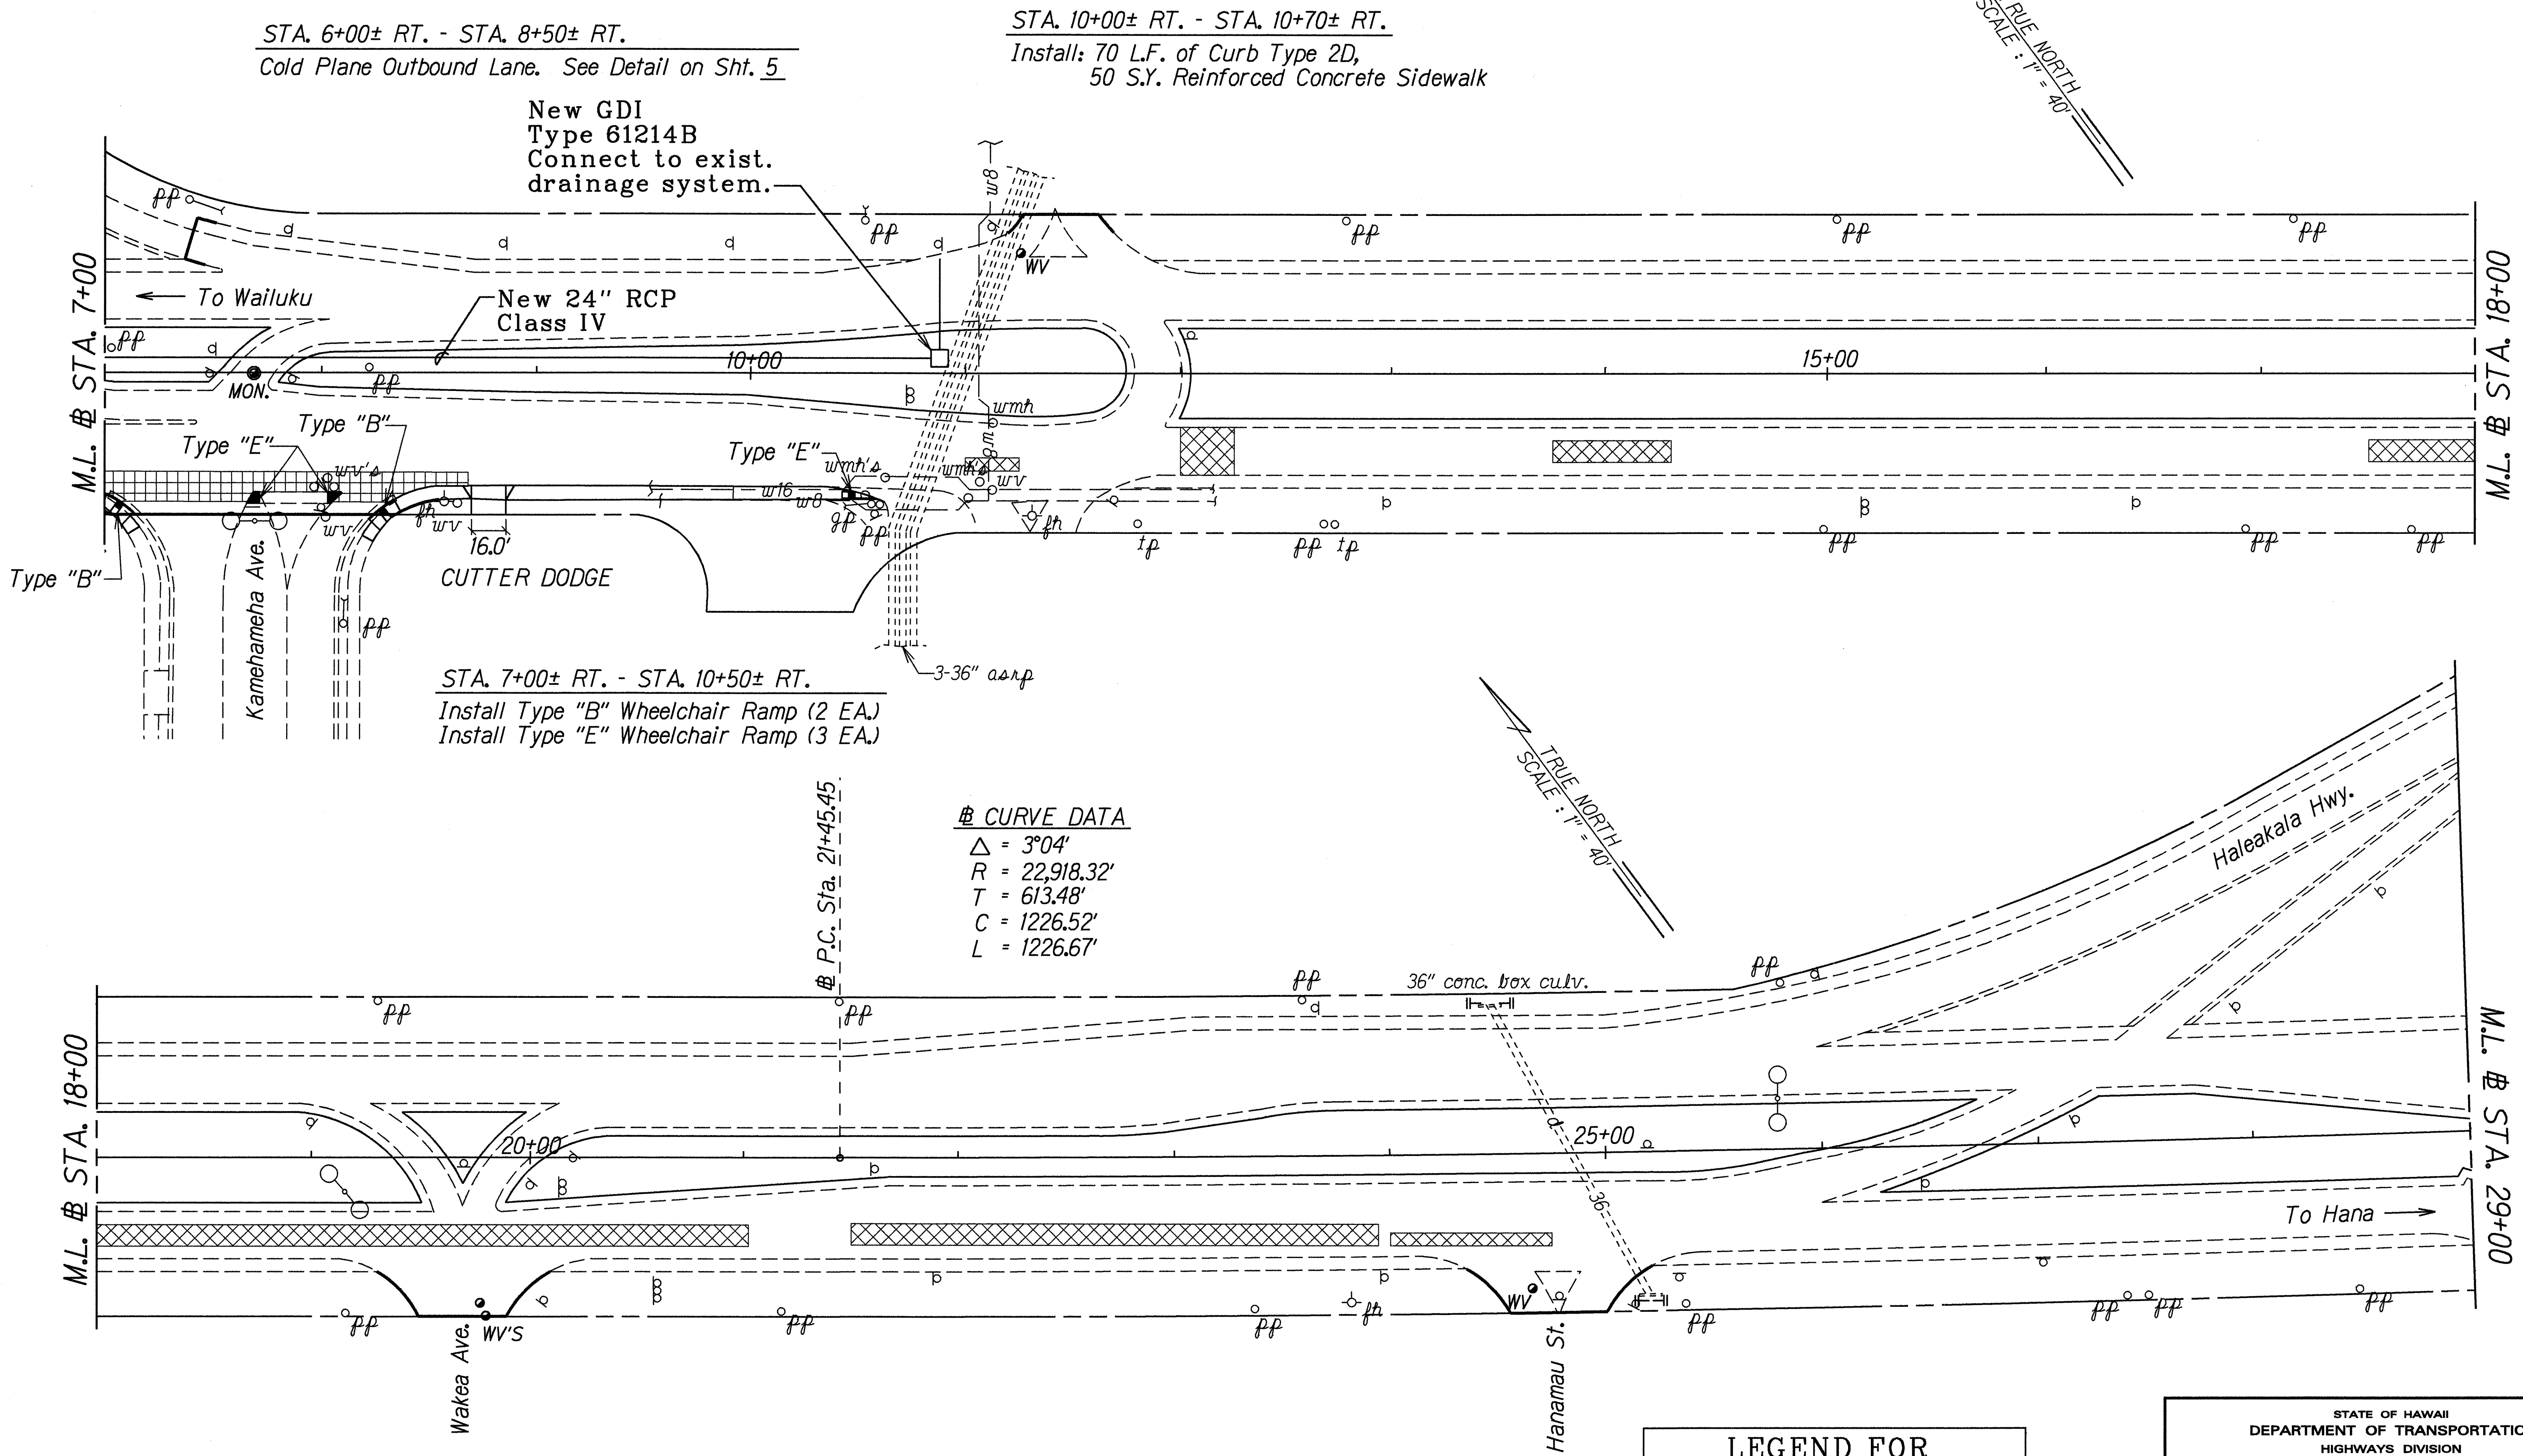

"AS-BUILT"

FED. ROAD DIST. NO.	STATE	PROJ. NO.	FISCAL YEAR	SHEET NO.	TOTAL SHEETS
HAWAII	HAW.	36A-01-96M	1996	8	13

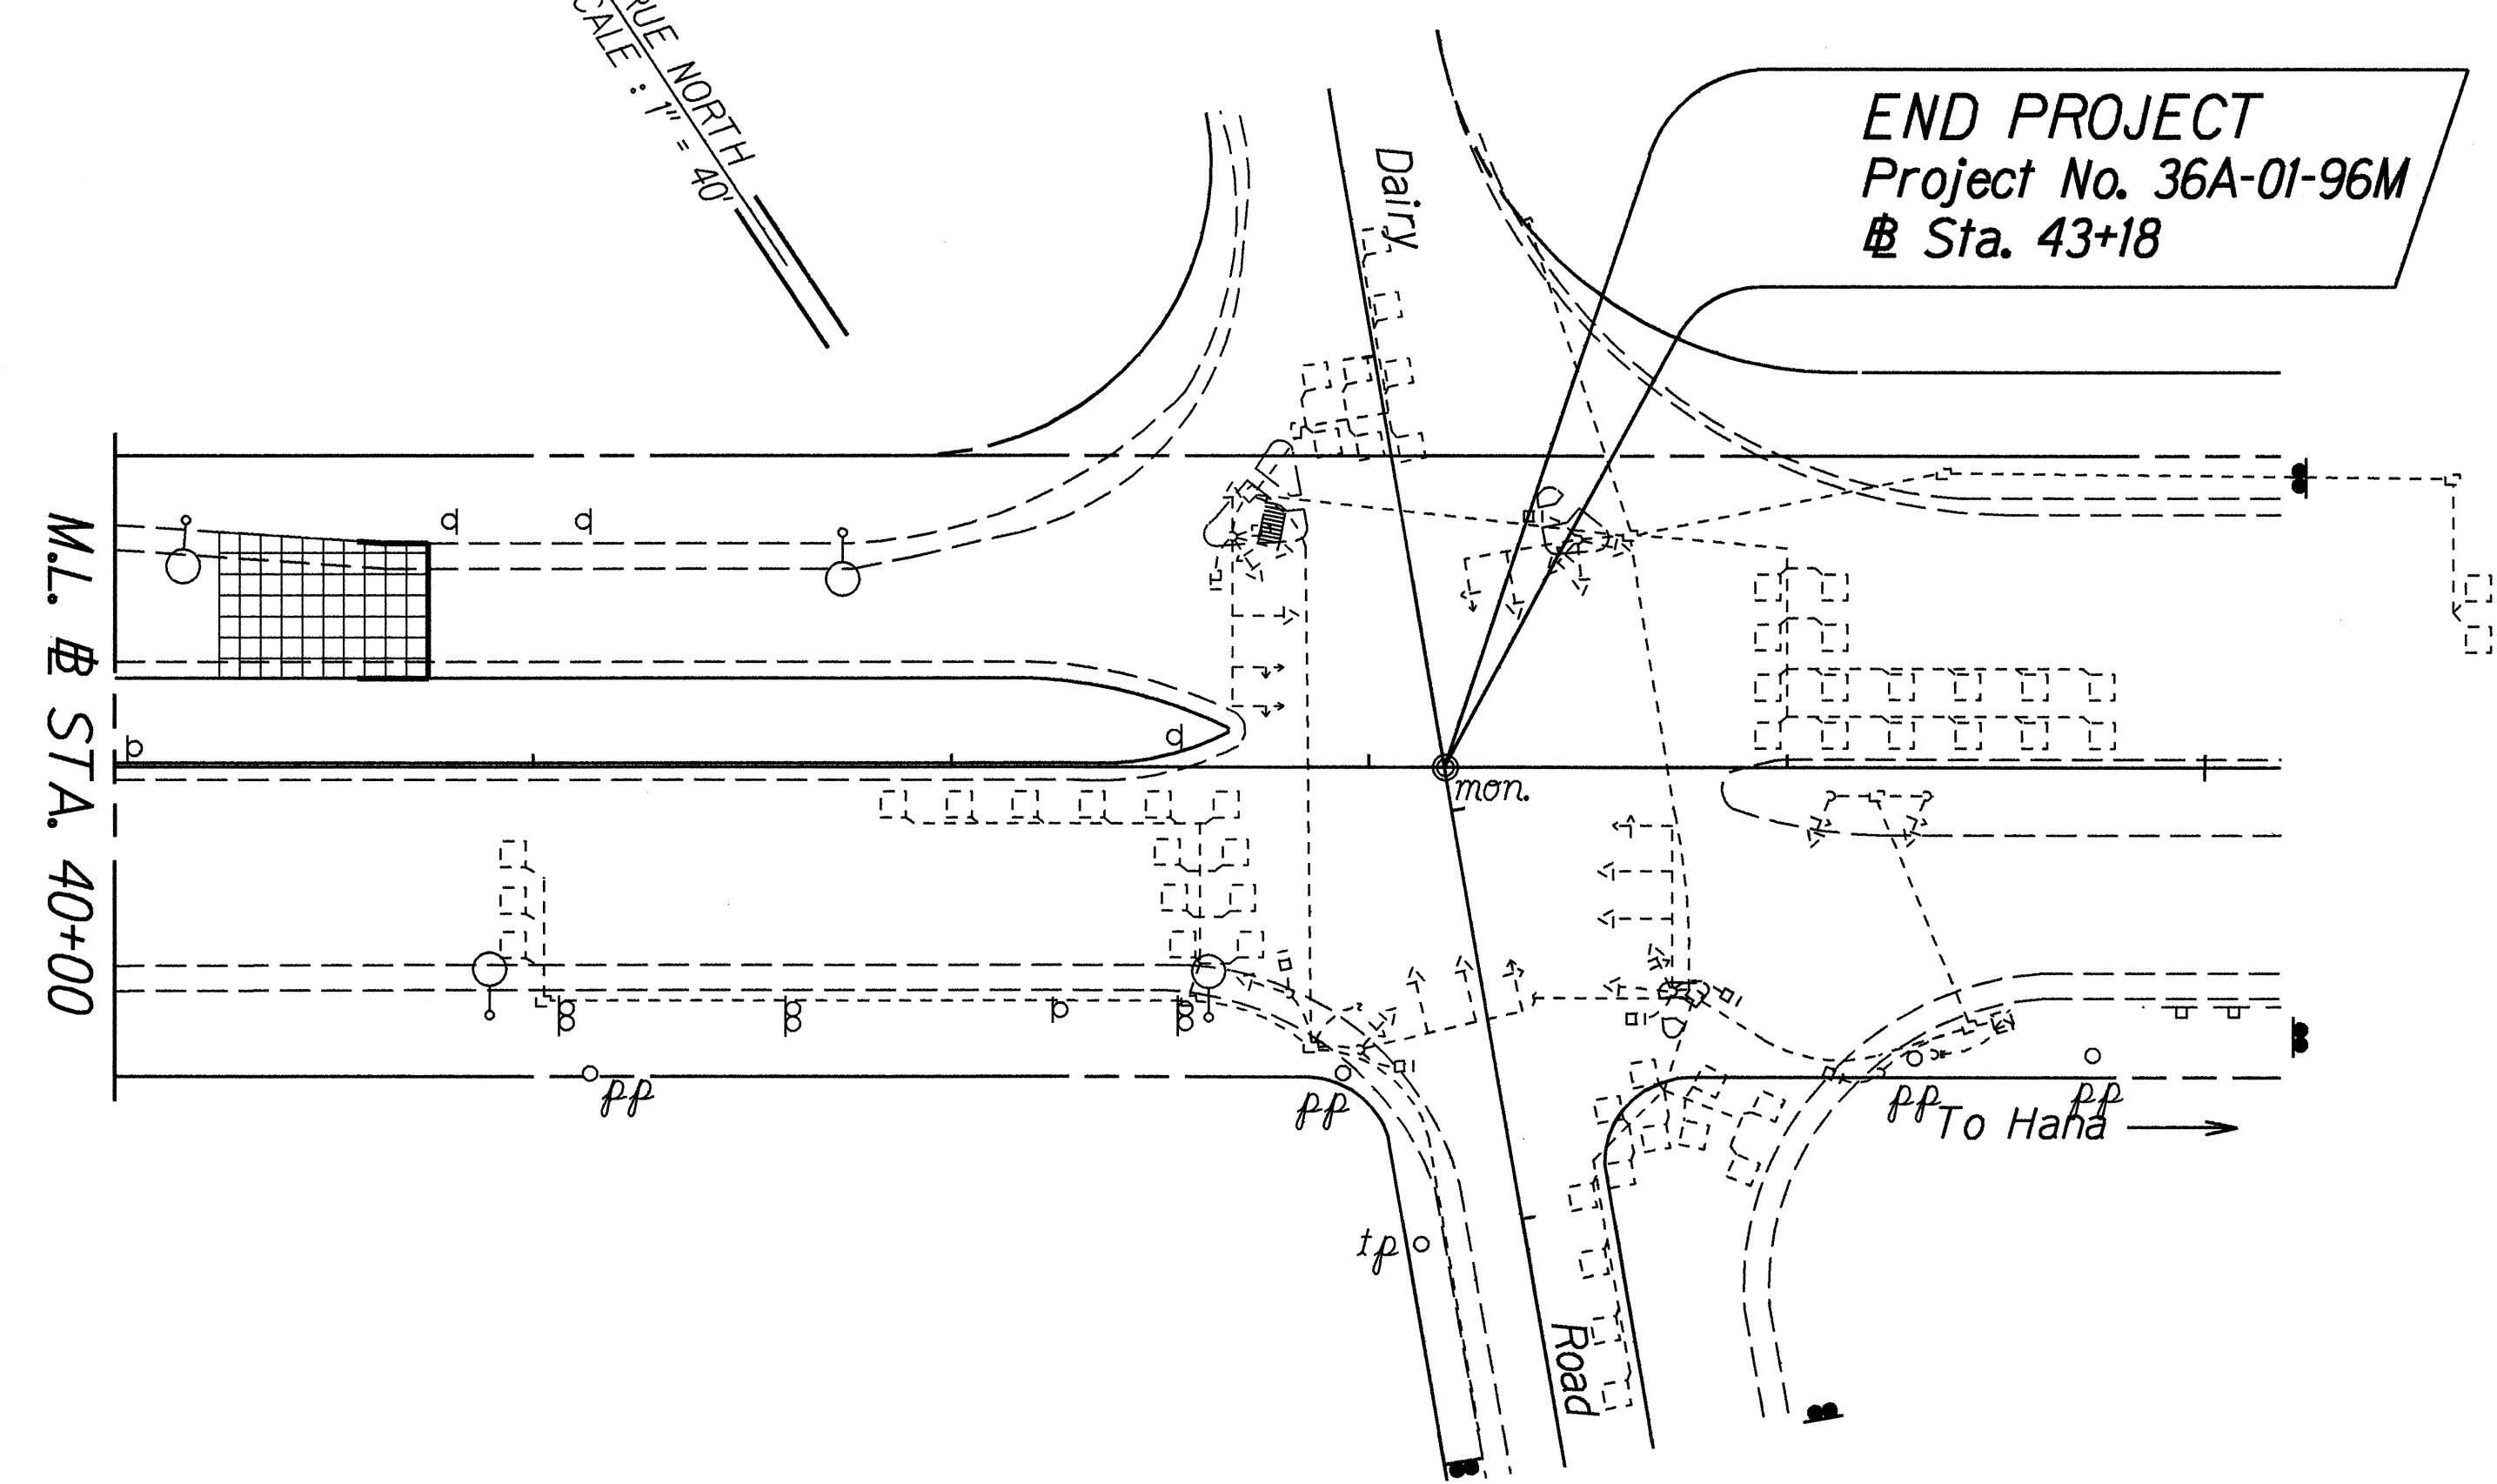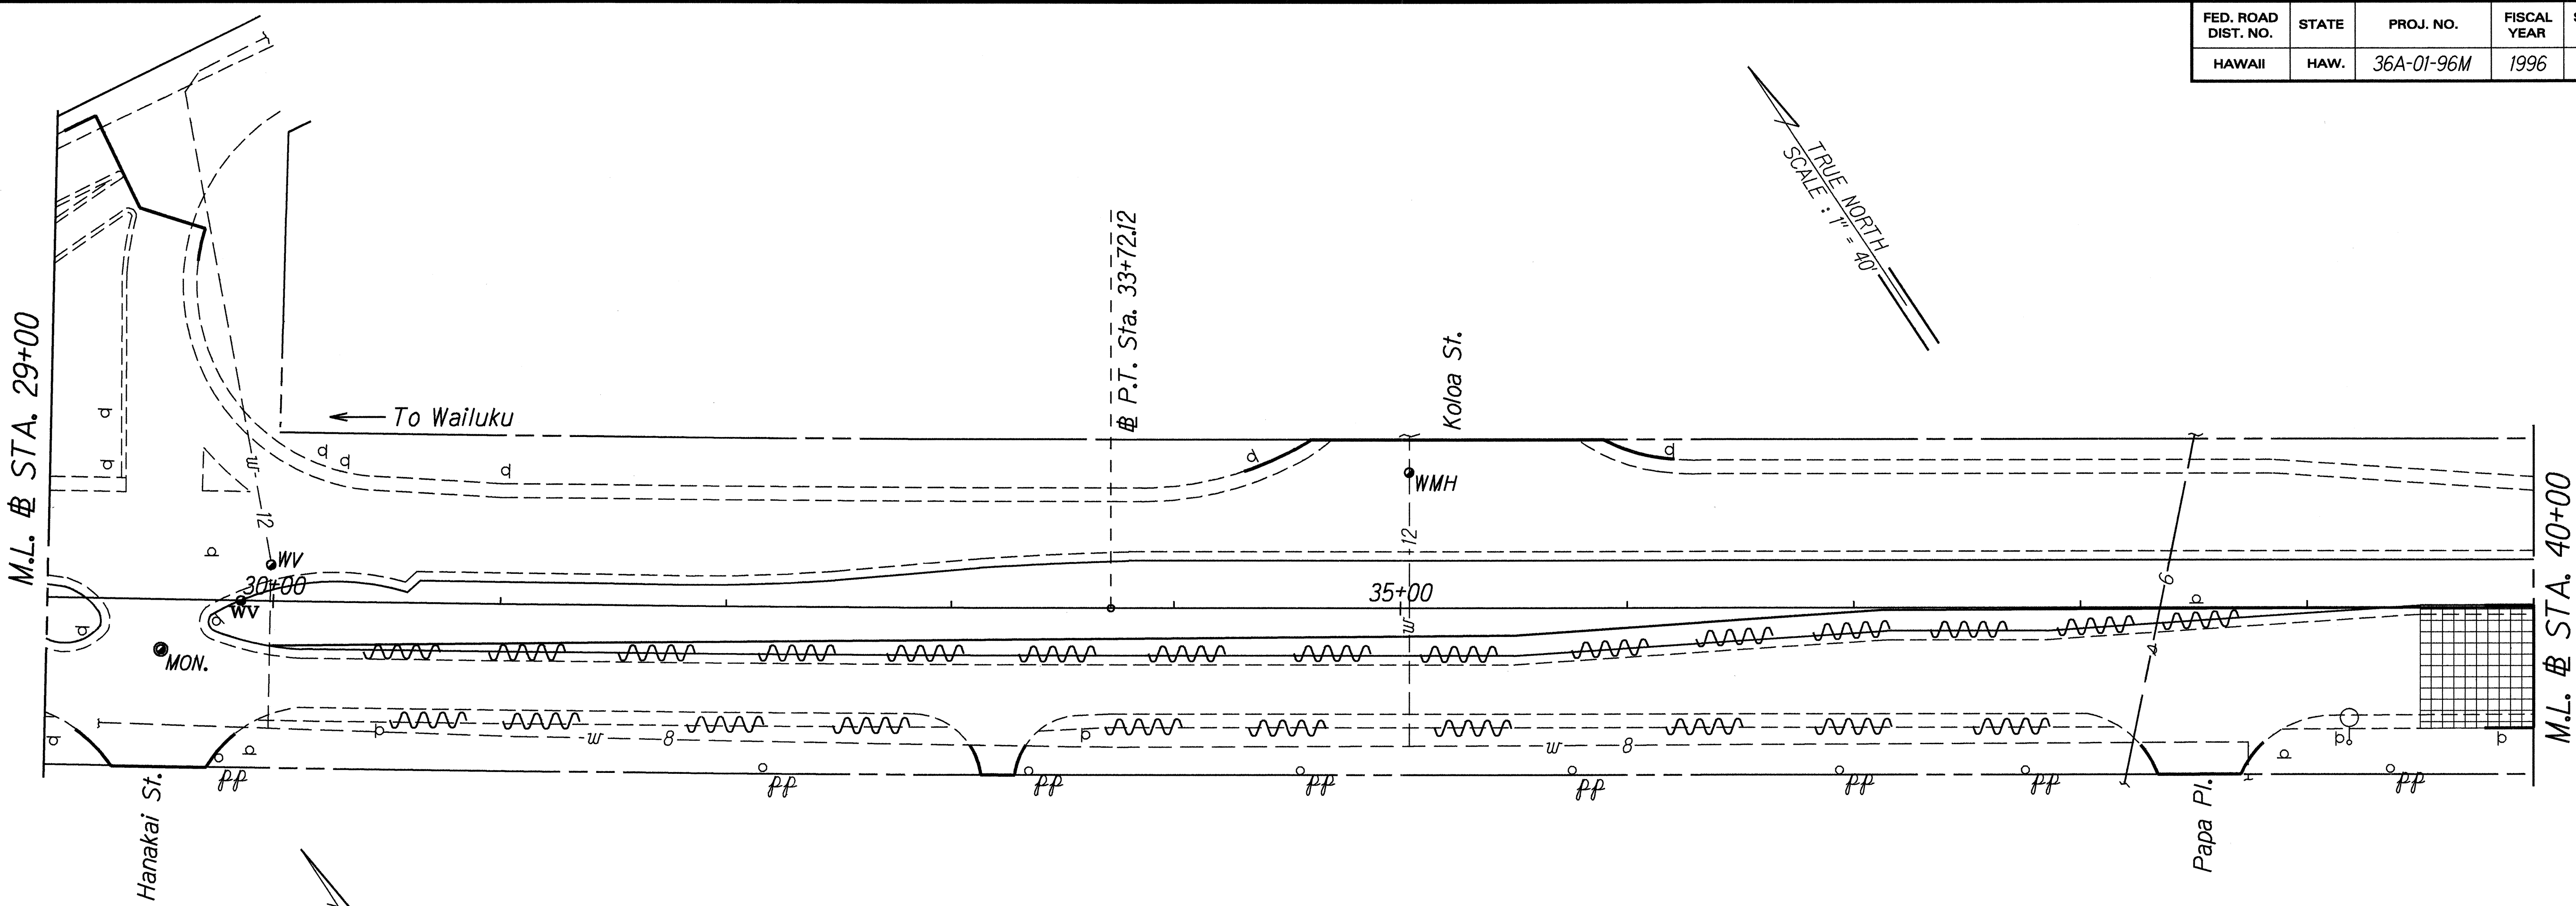

LEGEND FOR AS-BUILT POSTINGS	
	Squiggly line for as-built deletion
	Double line for as-built deletion
Roadway	Text for as-built posting

STATE OF HAWAII
DEPARTMENT OF TRANSPORTATION
HIGHWAYS DIVISION

ROADWAY PLAN

HANA HIGHWAY RESURFACING
Kaahumanu Avenue to Dairy Road
Project No. 36A-01-96M

Scale: 1" = 40' Date: May, 1996

SHEET No. 3 OF 3 SHEETS

ORIGINAL PLAN	SURVEY PLOTTED BY	DATE
NOTE BOOK	DRAWN BY	Nov. 1995
10/1/96	DESIGNED BY	
10/1/96	CHECKED BY	
10/1/96	CHECKED BY	

"AS-BUILT"